


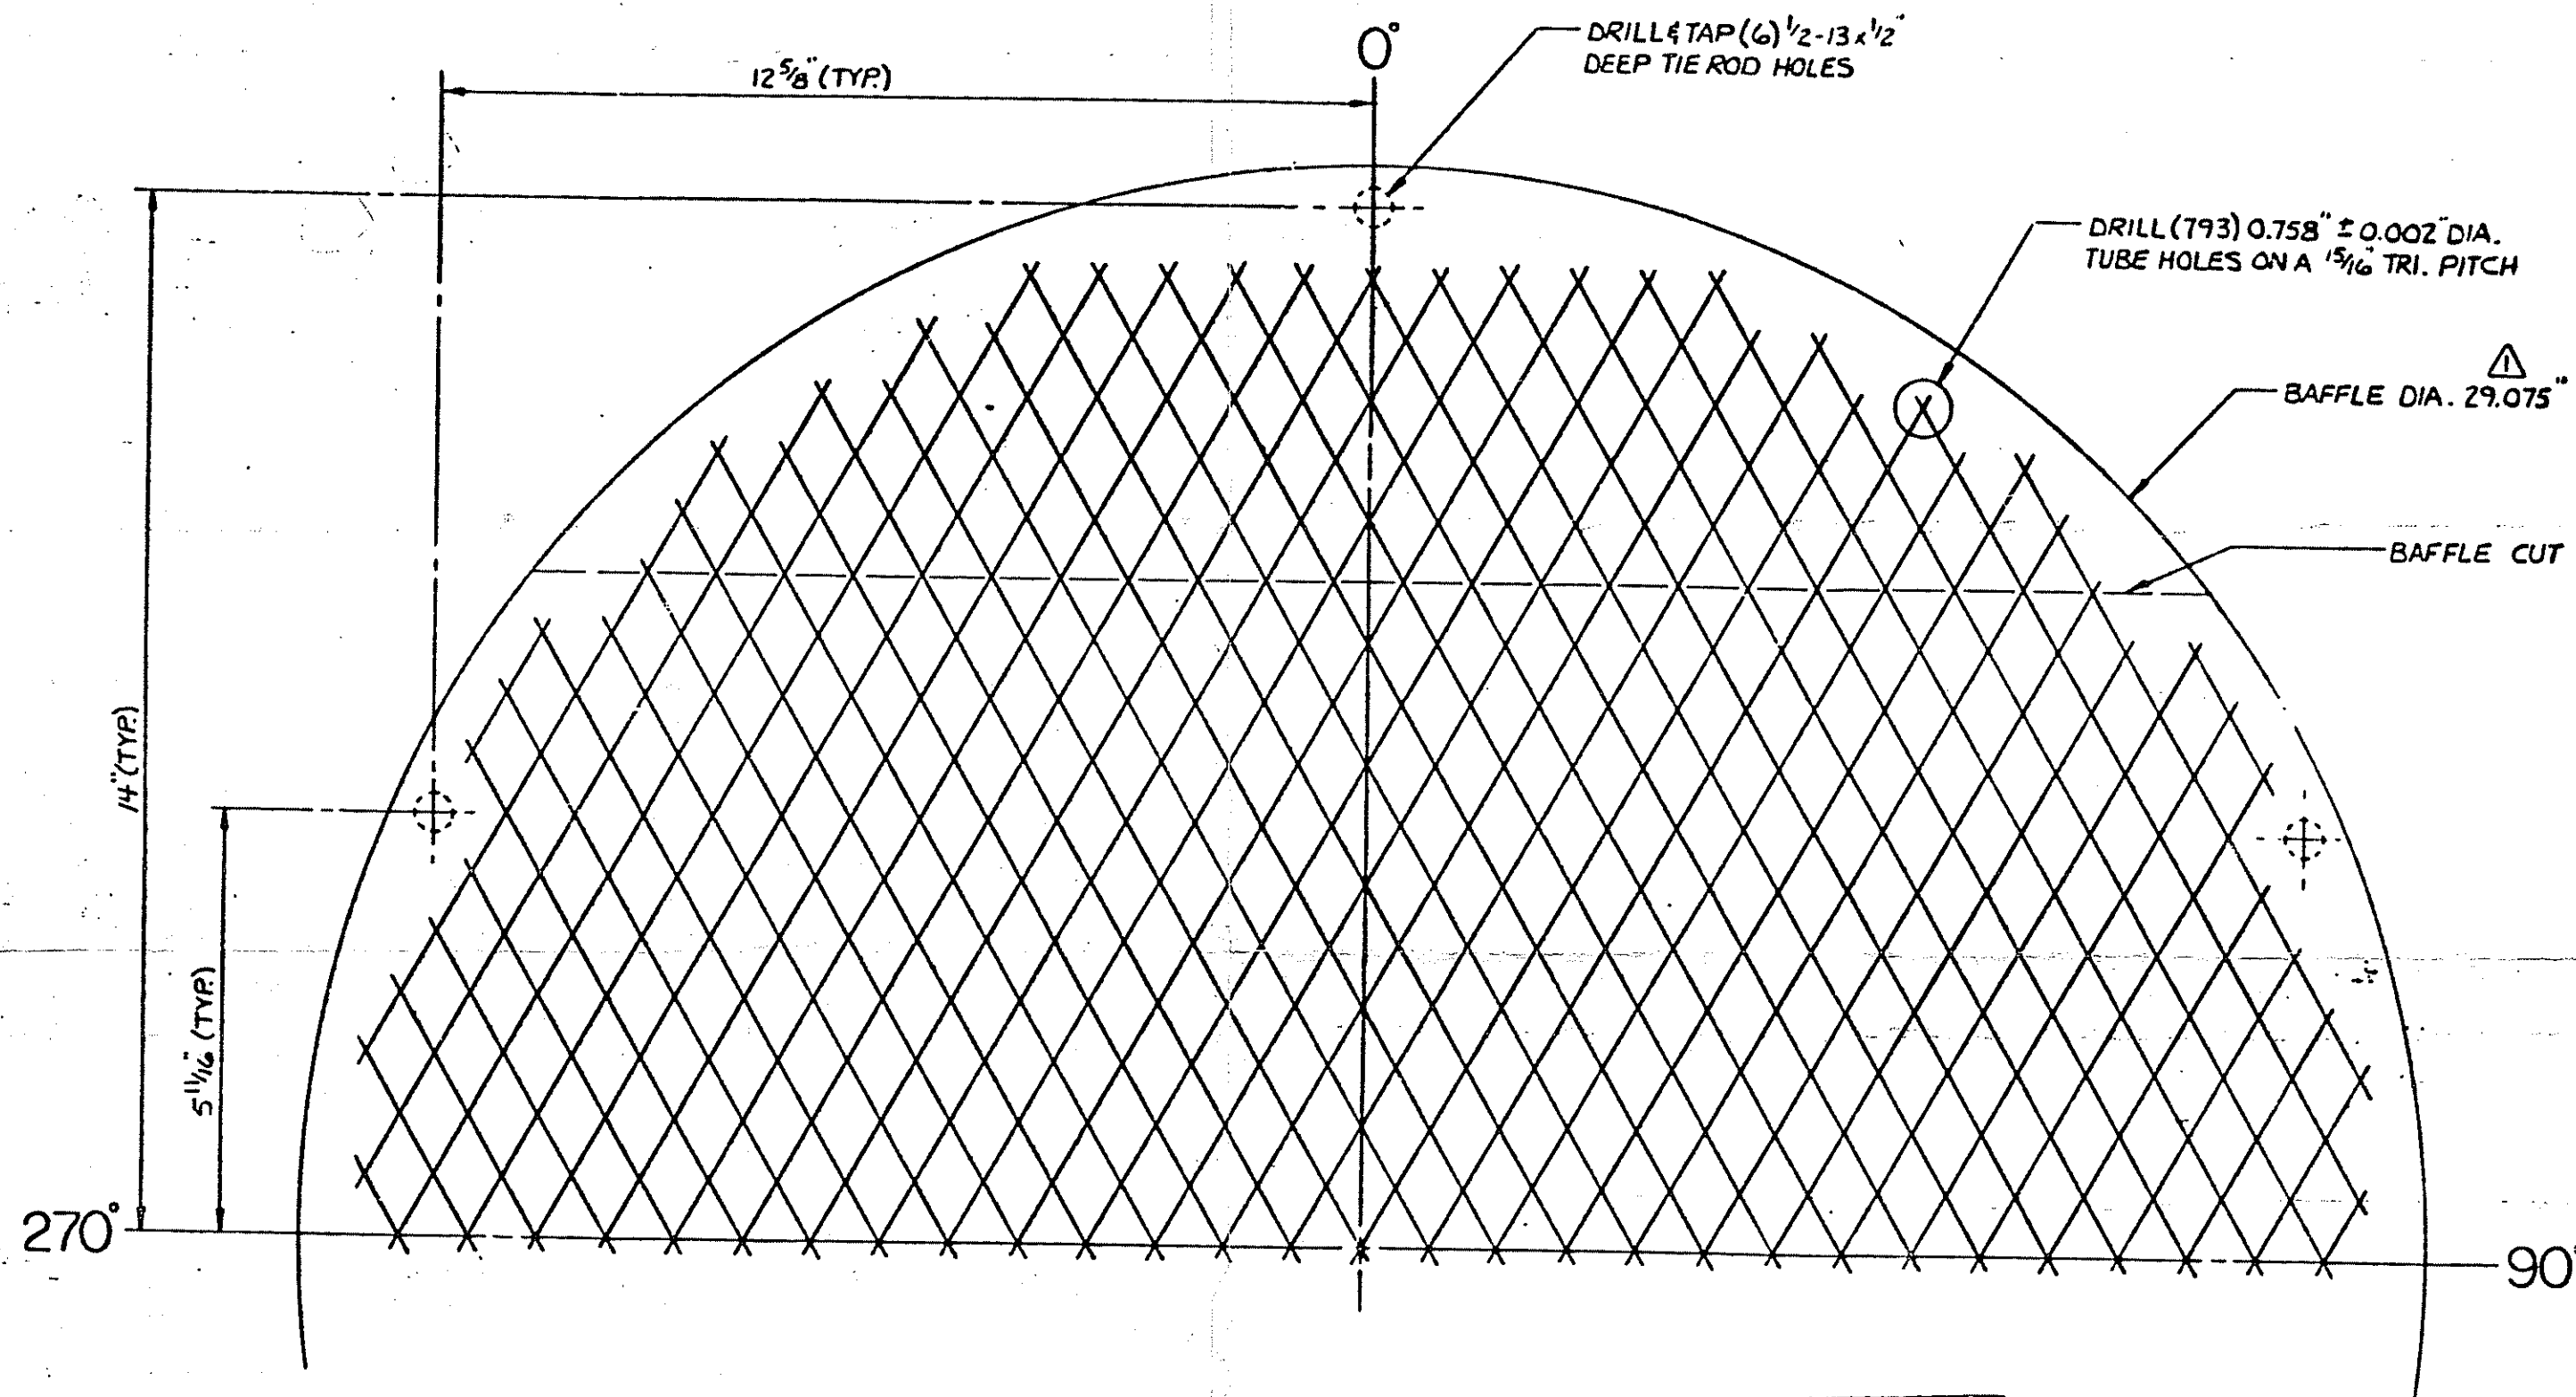

THIS DRAWING
CERTIFIED
 FOR CONSTRUCTION
J. Kessler 12-29-82
 CHIEF ENGINEER

NON-DISCRETIONARY
 UNTIL SUPER SEDED

ITEM NO 22-E-18
 SERVICE PURGE HEADER CONDENSER
 TITLE
 MODEL NO 1STW 30 TSLO
 CUSTOMER FOLGER COFFEE CO.
 CUSTOMER P O NO ENS-FT-X50013-TMH

VP-164687

1	REV. PER CUST. MK'D. PRINT	FM	12-20-82
NO	REVISION	BY	DATE

WELDON
 HEAT EXCHANGERS
 CLARK, N.J. 07066

MADE	FM	11-15-82	S.O.-2945-L
CHECKED	GK	11-15-82	
APPROVED	AB	11-15-82	
SCALE	1/2"=1"		C-4209

REV. 1

PV 8546 Sherman Plant
 # 100731