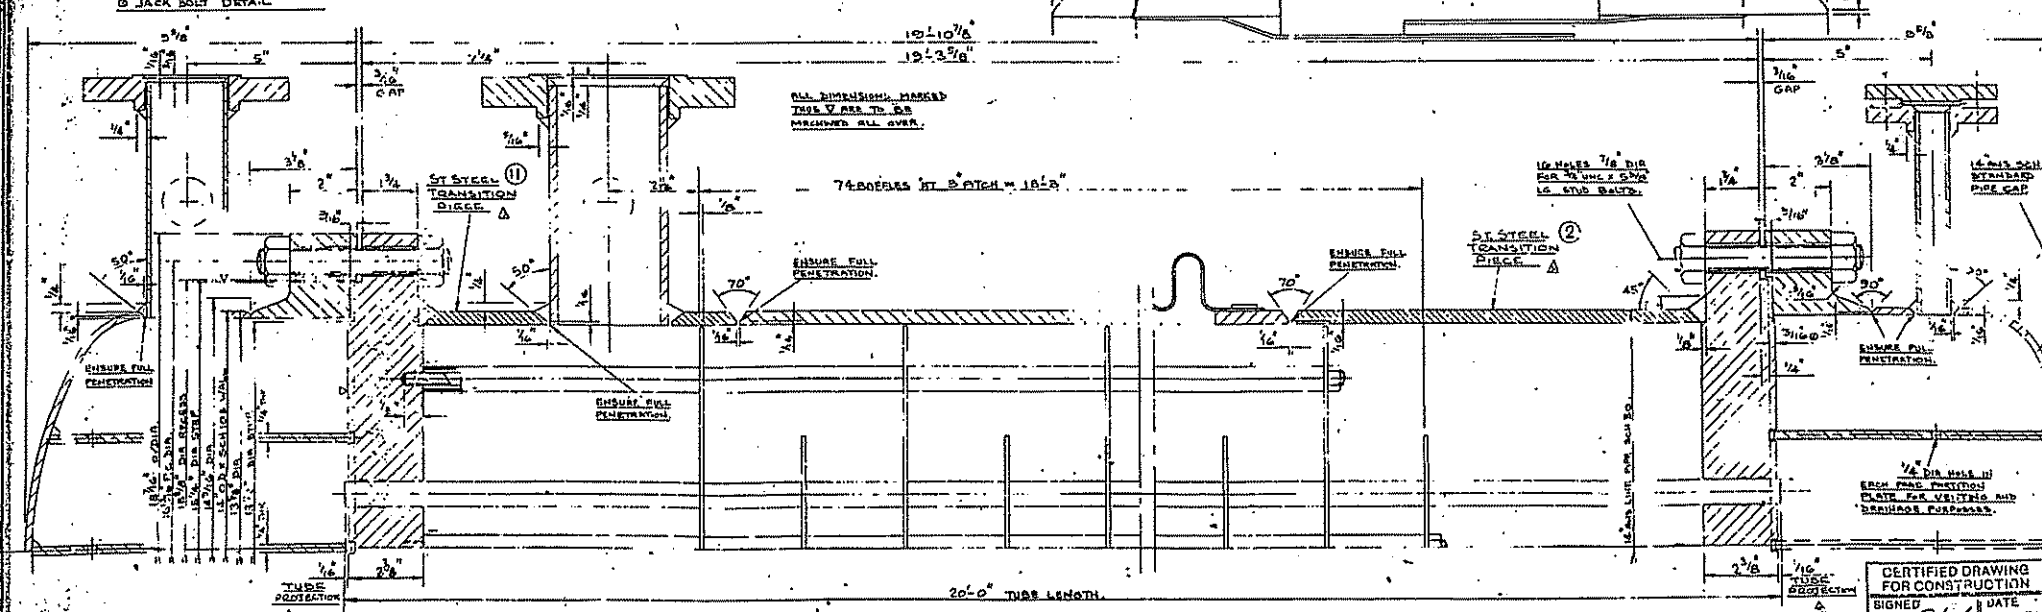
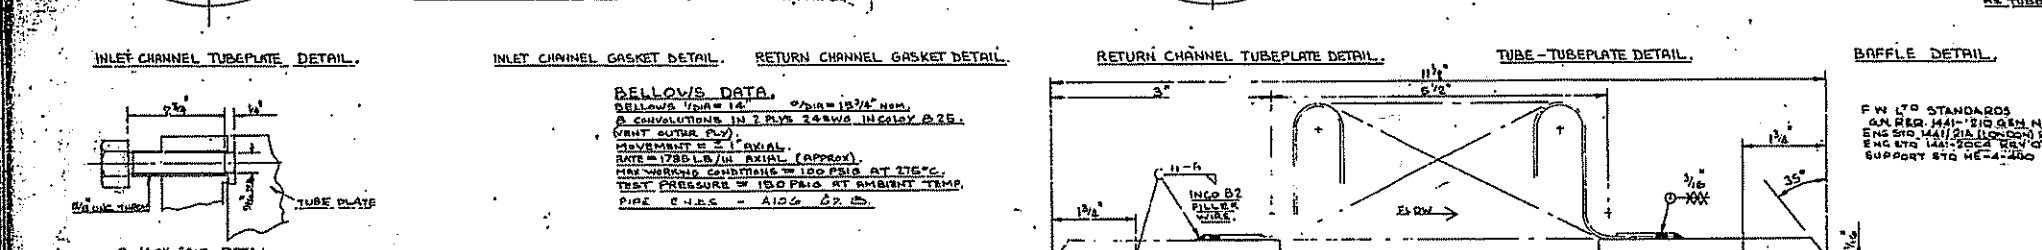
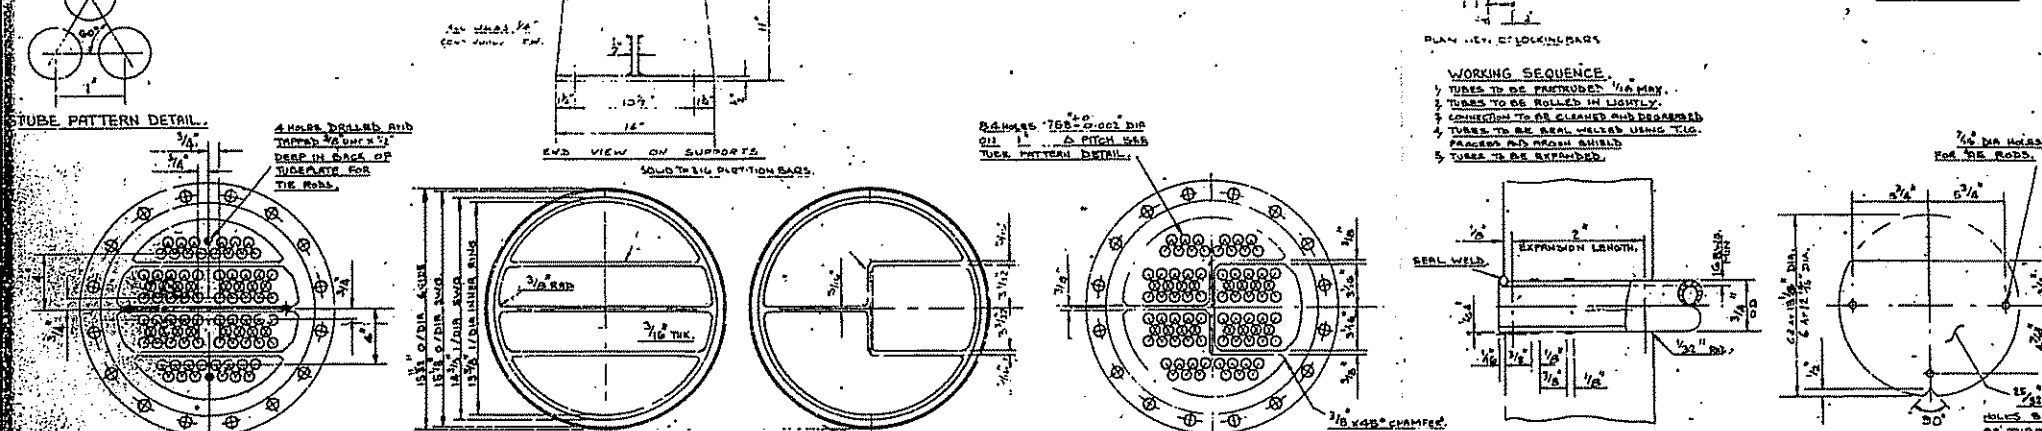


[illegible]

FOSTER WHEELER CONTRACT NUMBER: 1418-1448/1448Z
FOSTER WHEELER LTD REQUISITION NUMBER: 1441-1214/RVCEZ
TUBE
FOSTER WHEELER LTD ORDER NUMBER: 1441-1214/RVCEZ

THIS DOCUMENT IS A PRIVATE AND CONFIDENTIAL COMMUNICATION AND THE PROPERTY OF ICI, FIBRES LIMITED, HARBORFLEET, YORKSHIRE. IT MUST NOT BE COPIED OR LENT WITHOUT THE CONSENT OF ICI, FIBRES LIMITED AND MUST BE RETURNED WITH THE TENDERS AND/OR COMPLETION OF THE ORDER.

2	5-7-71	BLANK FLAMERS ADDED, FLAMERS INSTALLED AND TESTED	1
3	1-11-71	MODIFIED TO MEET CUSTOMER REQUIREMENTS	2
3	7-9-71	BLANK FLAMERS ADDED, 15" 243 GORTON GRS ADDED TURBULENCE WELD MODIFIED (RANS) ADDED	3
2	5-7-71	MODIFIED TO CUSTOMER REQUIREMENTS	4

ISSUE	DATE	MODIFICATION			
SCHEDULE OF BRANCHES					
BRANCH	DESCRIPTION	SIZE	FLUID	GOODING	STURGE
			X. R	SPOT	SPOT

		S.R.		NIL	NIL
WT EMPTY: 3000 LBS		WT FULL: 4200 LBS			
FINISH: CLEAN		ALL UN-MACHINED CARBON STEEL SURFACES			
INTERNAL: A RAY SYSTEM		ONE COAT RED OXIDE PRIMER			

DESIGN CODES:-	ADME VIII th TBMA 'R' 1988 EDITIONS	
INSPECTION BY:-	FOSTER WHEELER LIMITED	
CLIENT:-	FOSTER WHEELER LIMITED	CLIENT'S O/Ho 3018/1440

DRYER SCRUBBER COOLER: 1- OFF.

ITEM N° E511: 1 C I DRG N° F/X/A4098

MANAGERIAL PERSONNEL

HUNT HEAT EXCHANGERS LTD.,
HHE GRIMSHAW LANE MIDDLETON
MANCHESTER ENGLAND

SCALE: 1/4", 1/8", 1/2" & FULL SIZE		JOB. No. 696
DATE: 2-6-71	CHD: <i>L. L. Blunk</i>	DRG. No. 5X 13.17.153

DAN: D GREGG SPD: *10/11* SHEET: OF SHEET: 164