

 
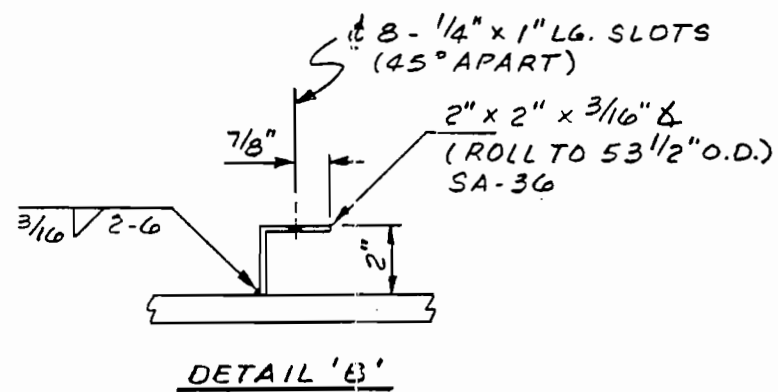


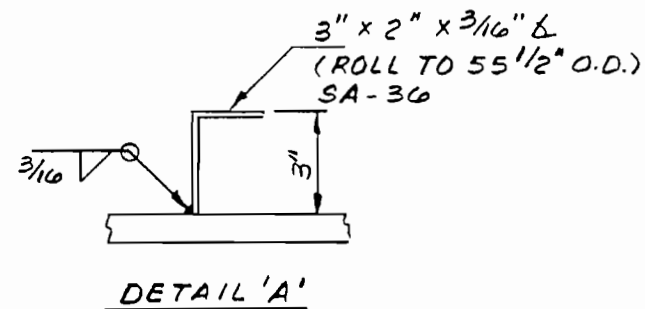

CERTIFIED
PRINT

MAY 17 1995
TEXAS METAL
FABRICATING CO.
A TRINITY INDUSTRIES CO.
HOUSTON, TEXAS

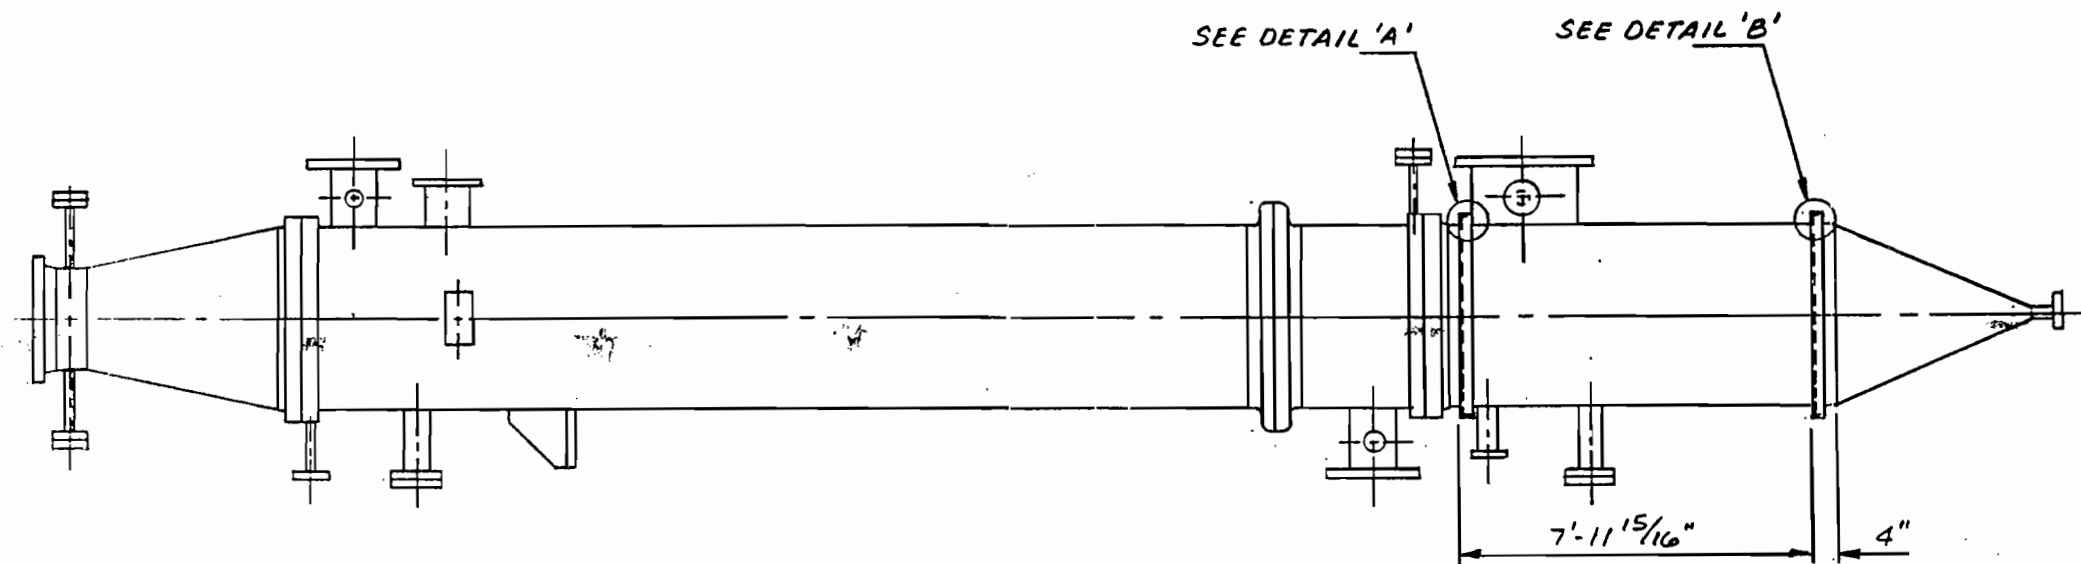

FABRICATION DETAIL - INSULATION SUPPORT RINGS

REFERENCE
94062


NO. 9458

SHEET 20

MADE	DATE	CHKD	DATE	APVD	DATE
DLT	12/21/94	JM	1-25-95	JM	1-25-95


REVISIONS

PHILLIPS SUMIKA POLYPROPYLENE COMPANY
PASADENA, TEXAS
M.W. KELLOGG P.O. NO. 6014-02D1-C210-01
ITEM NO. PS-2001-220000-41-5003
1ST REACTOR(R-102A)2ND GAS COOLER
MANUFACTURER'S SERIAL NO. 9458
WTT #41001026

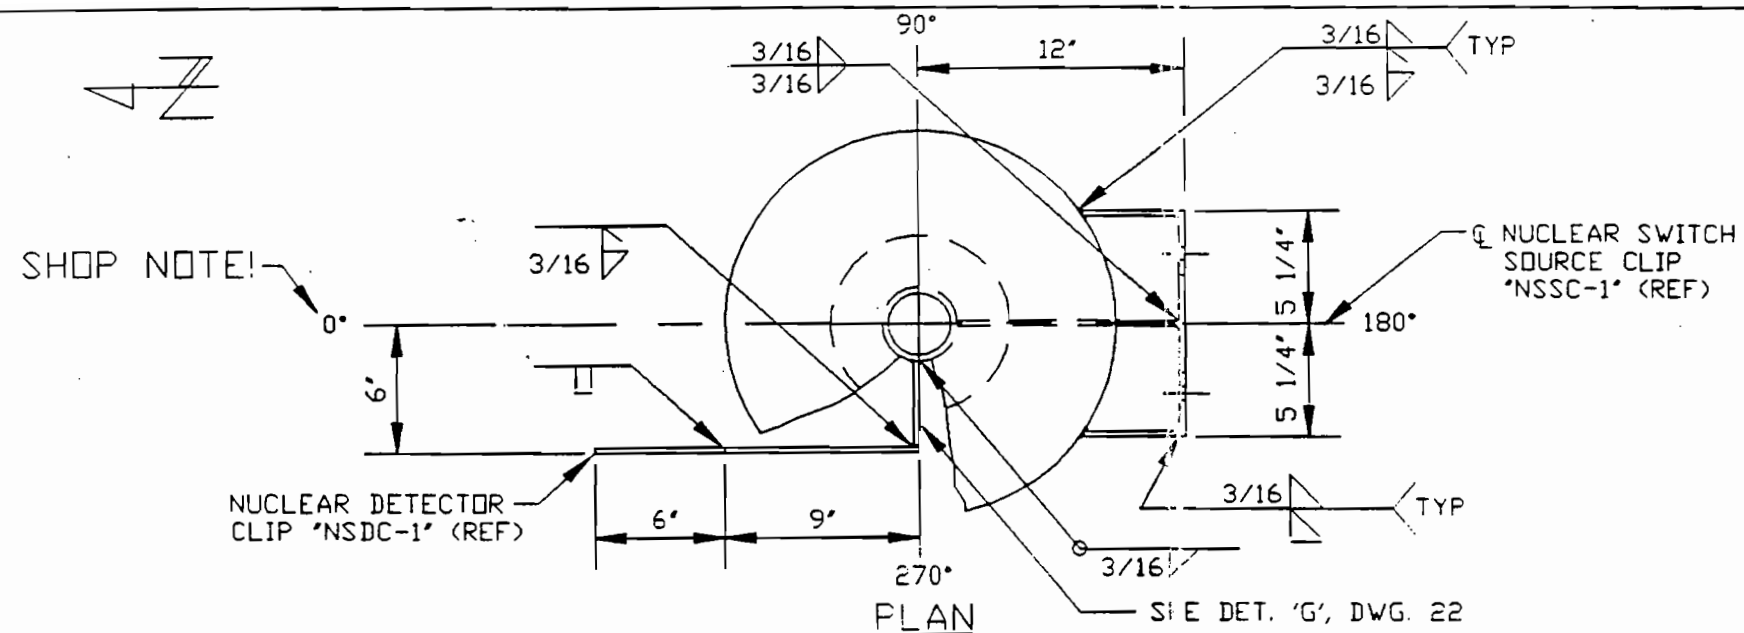

NOTES

- 1) ALL PLATE IS 1/4" THK. SA-516-70 UNLESS NOTED OTHERWISE.
- 2) FOR FABRICATION DETAILS OF PARTS SEE DWG. 22.
- 3) SLOTS TO BE MILLED, (DO NOT TORCH CUT)

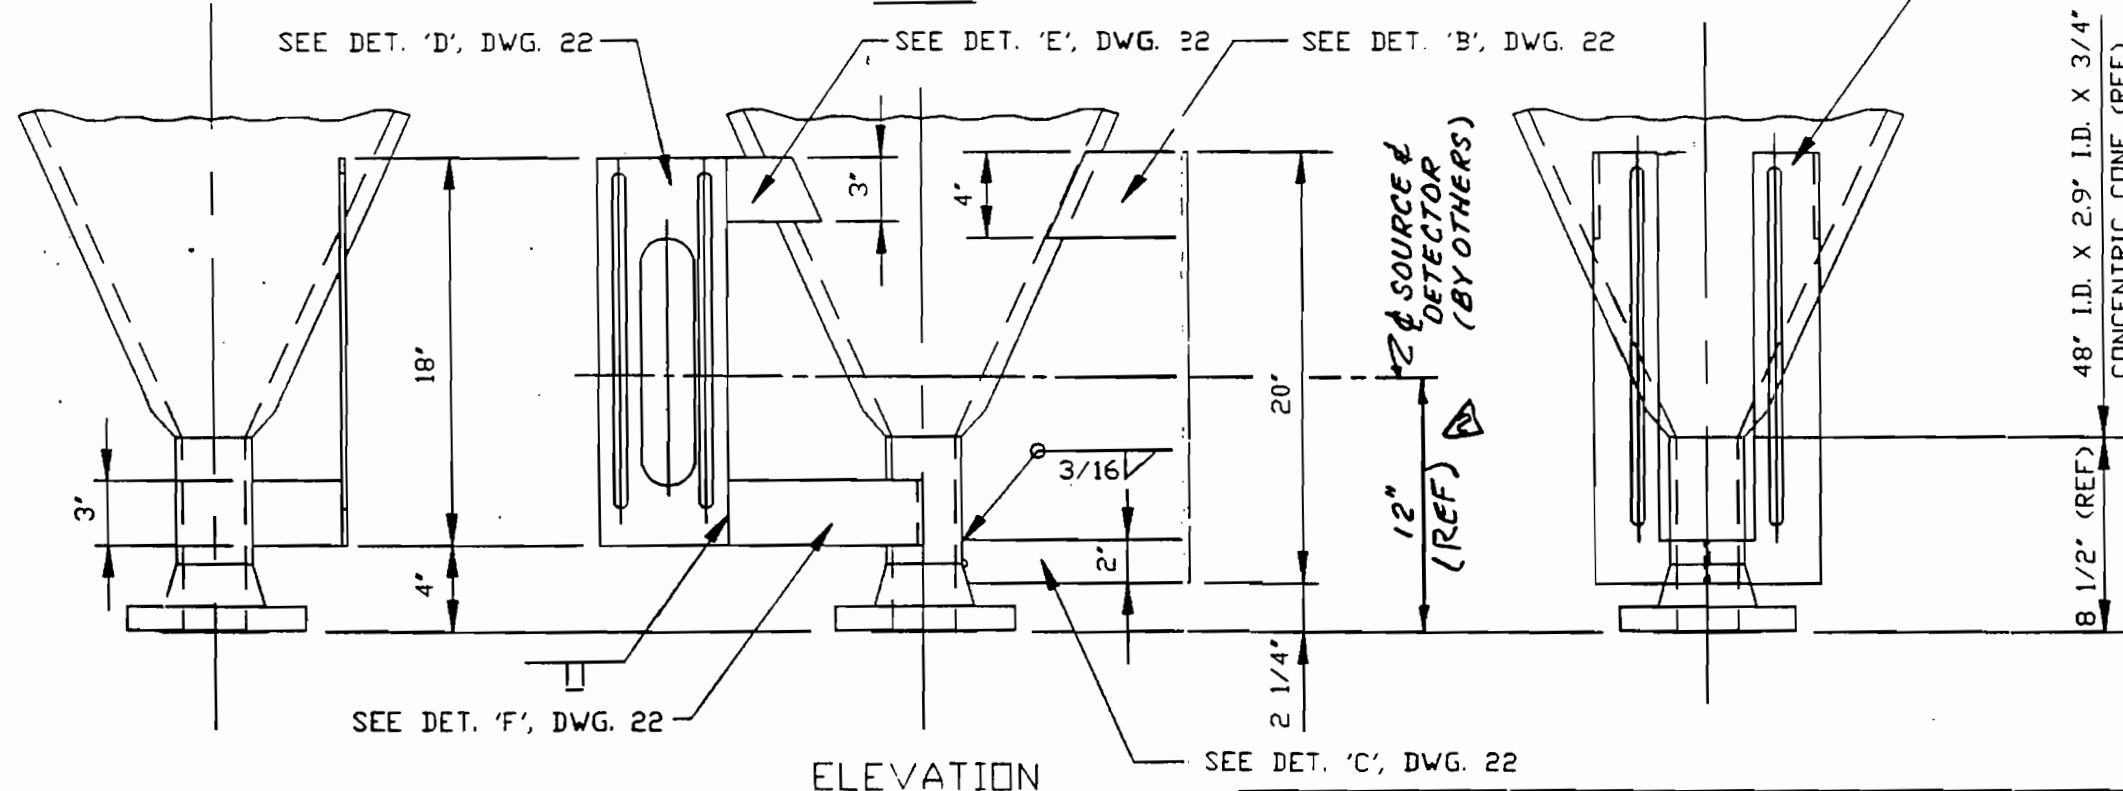

909T

ACCEPTANCE FOR ENGINEERING USE	
THIS DOCUMENT IS:	
ACCEPTED	(AC) ☒
ACCEPTED WITH COMMENTS	(AC-C) ☐
NOT REVIEWED-ACCEPTED	(NR) ☐
NOT ACCEPTED	(NAC) ☐
ACCEPTANCE DOES NOT RELIEVE VENDOR FROM FURNISHING MATERIAL IN CONFORMANCE WITH ORDER. REFER TO VDR-1 FOR FULL DEFINITION OF ACCEPTANCE CONDITIONS.	
DIVISION <i>VM</i>	SIGNED <i>RS</i> DATE <i>23 AUG 95</i>

No. 100.223

CERTIFIED PRINT

JUL 18 1995

TEXAS METAL FABRICATING CO.
A TRINITY INDUSTRIES CO.
HOUSTON, TEXAS

PHILLIPS SUMIKA POLYPROPYLENE COMPANY
PASADENA, TEXAS
M.W. KELLOGG P.O. NO. 6014-02D1-C210-01
ITEM NO. PS-2001-220000-41-5003
1ST REACTOR (R-102A) 2ND GAS COOLER
MANUFACTURER'S SERIAL NO. 9458
WTT #41001026

			ASSEMBLY NUCLEAR SWITCH SOURCE CLIP	
			NSSC-1 AND DETECTOR CLIP NSDC-1	
			DWN BY	 TEXAS METAL FABRICATING CO. HOUSTON, TEXAS JOB NO: 94062
			T.THOMAS	
			DATE	
			6-9-95	
			CKD. BY	DWG. NO.
			JMH	9458-21
				REV. 2

NO.	DATE	REVISIONS
2	7/17/95	ADDED REF. DIM.
1	6-9-95	ADDED THIS SHEET