
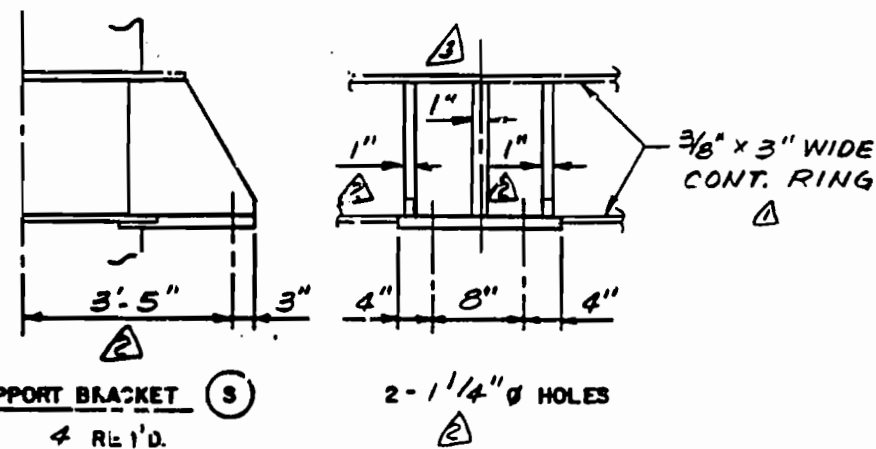


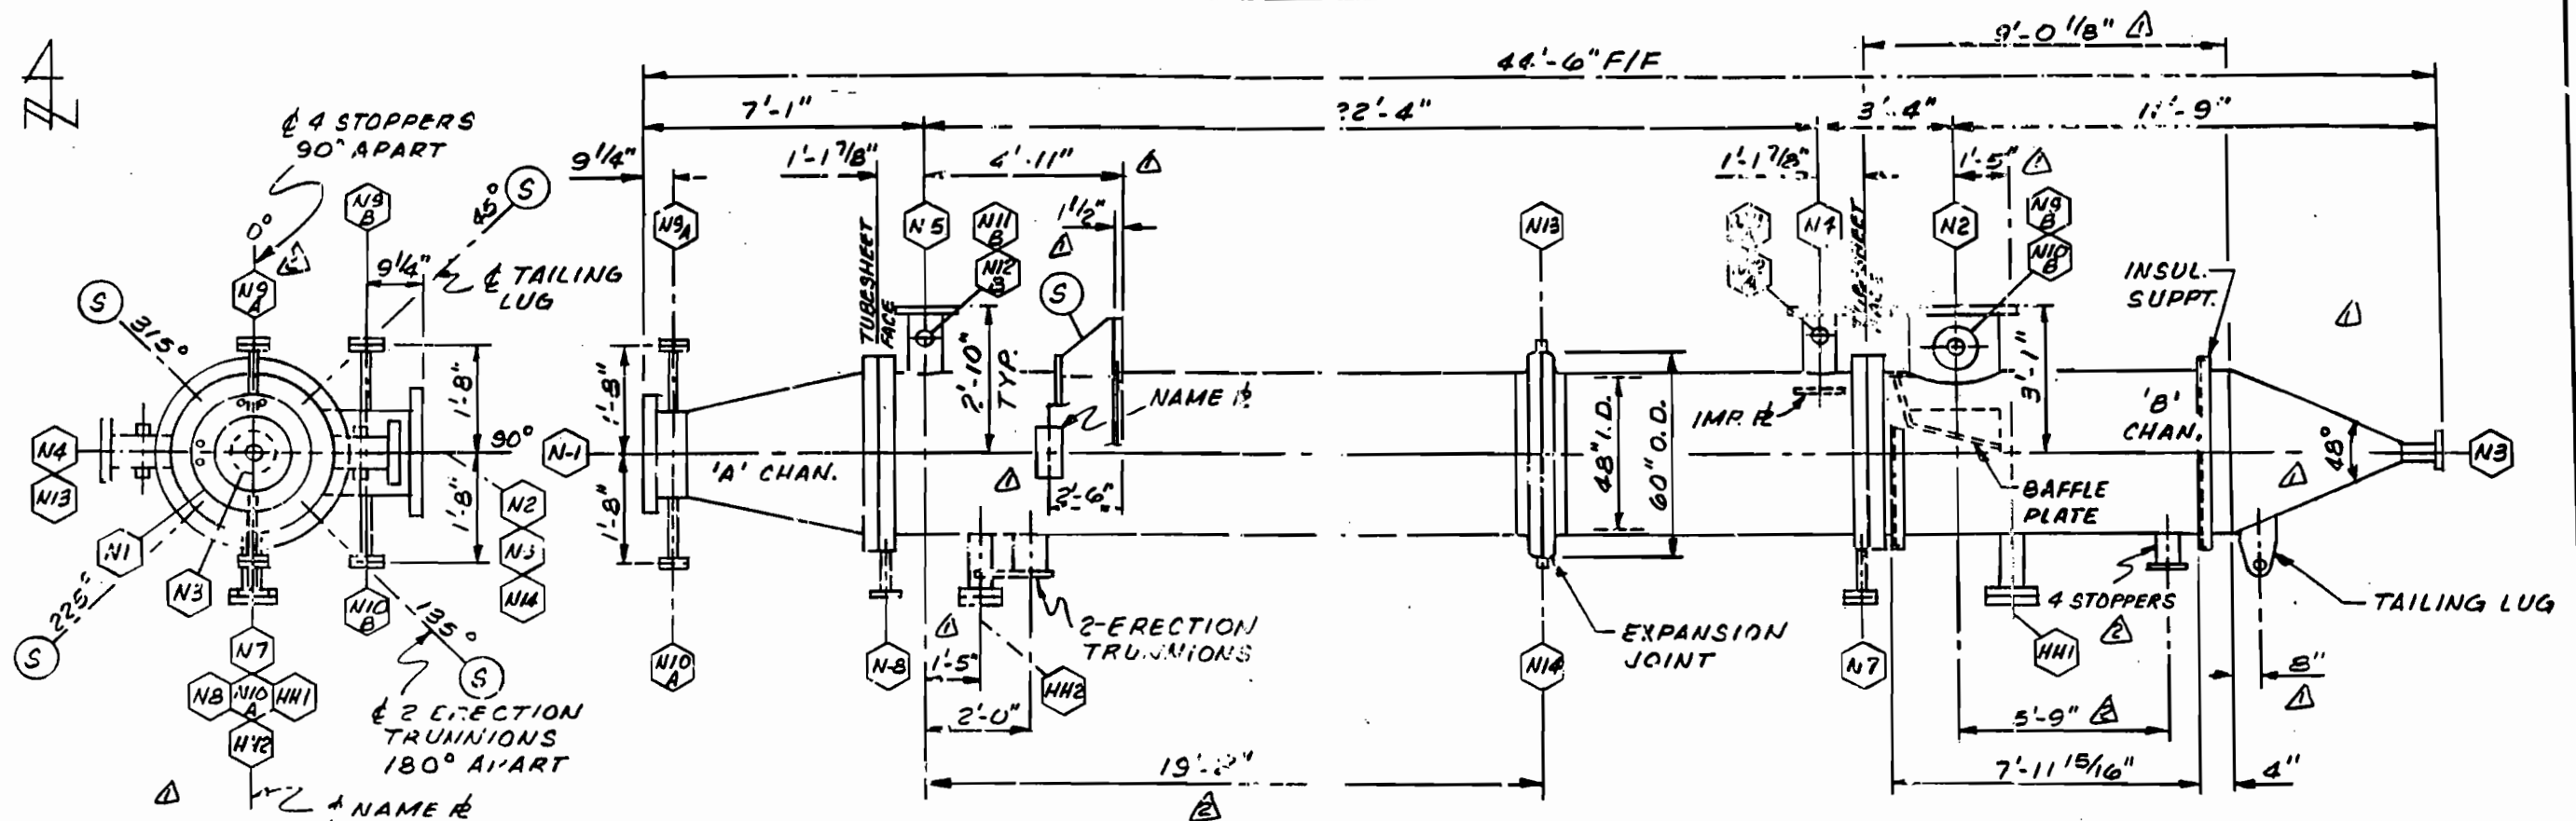

909T

ACCEPTANCE FOR ENGINEERING USE

THIS DOCUMENT IS:

ACCEPTED	(AC)	☒
ACCEPTED WITH COMMENTS	(AC-C)	☐
NOT REVIEWED-ACCEPTED	(NR)	☐
NOT ACCEPTED	(NAC)	☐

ACCEPTANCE DOES NOT RELIEVE VENDOR FROM FURNISHING MATERIAL IN CONFORMANCE WITH ORDER. REFER TO VDR-1 FOR FULL DEFINITION OF ACCEPTANCE CONDITIONS.

DIVISION 114 SIGNED RS DATE 23 AUG 94

No. 103 221

INSULATION THK:
 'A' CHAN. = PERSONNEL PROTECTION
 'B' CHAN. = 2"
 SHELL = NONE

CERTIFIED PRINT
 JUL 25 1995
 TEXAS METAL
 FABRICATING CO.
 A TRINITY INDUSTRIES CO.
 HOUSTON, TEXAS

*1 ASME B16.47 SERIES 'B'			*2 W7 BLIND		*3 W7 PLUG			
N15	10"-300# RF	WATER OUT	N10 A,B	1"-300# RF *2	PRESS. GAUGE			
N4	10"-300# RF	WATER IN	N9 A,B	1"-300# RF *2	THERM.			
N3	3"-300# RF	STEAMER OUT	HH2	6"-300# RF *2	HANDHOLE	N14	3/4"-6000# NPS *3	DRAIN
N2	26"-300# RF *1	GAS OUTLET	HH1	6"-300# RF *2	HANDHOLE	N13	3/4"-6000# NPS *3	VENT
N1	26"-300# RF *1	GAS INLET	N2	3/4"-300# RF	VENT	N12 A,B	1"-6000# NPS *3	PRESS. GAUGE
			N1	3/4"-300# RF *2	DRAIN	N11 A,B	1"-6000# NPS *3	THERM.

SCHEDULE OF CONNECTIONS

FABRICATION DETAIL - OUTLINE & ASSEMBLY

REFERENCE
94062

NO. 9458

MADE	DATE	CHKD	DATE	APVD	DATE
DLT	10/24/94	DM	10-26-94	DM	10-26-94

SHEET 2

PHILLIPS SUMIKA POLYPROPYLENE COMPANY
 PASADENA, TEXAS
 M.W. KELLOGG P.O. NO. 6014-02D1-C210-01
 ITEM NO. PS-2001-220000-41-5003
 1ST REACTOR(R-102A) 2ND GAS COOLER
 MANUFACTURER'S SERIAL NO. 9458
 WIT #41001026

APPROV'D
 DLT/12-15-94
 REV. SUPPT.
 BRKT.
 DLT/4-12-95
 ADD CTR. L.S.
 To SUPPT. JND 12-24-95