

6 1/4"

RECEIVED
 FOR ENGINEERING USE
 THIS DOCUMENT


ACCEPTED (AC) ☒
 REJECTED WITH COMMENTS (AC-C) ☐
 REVIEWED AND ACCEPTED (INAC) ☐
 REJECTED (INAC) ☐

ALL INFORMATION CONTAINED HEREIN IS UNCLASSIFIED
 DATE 03/12/95 BY 60322 JRS

VM **JRS**
 03/12/95



8.2137

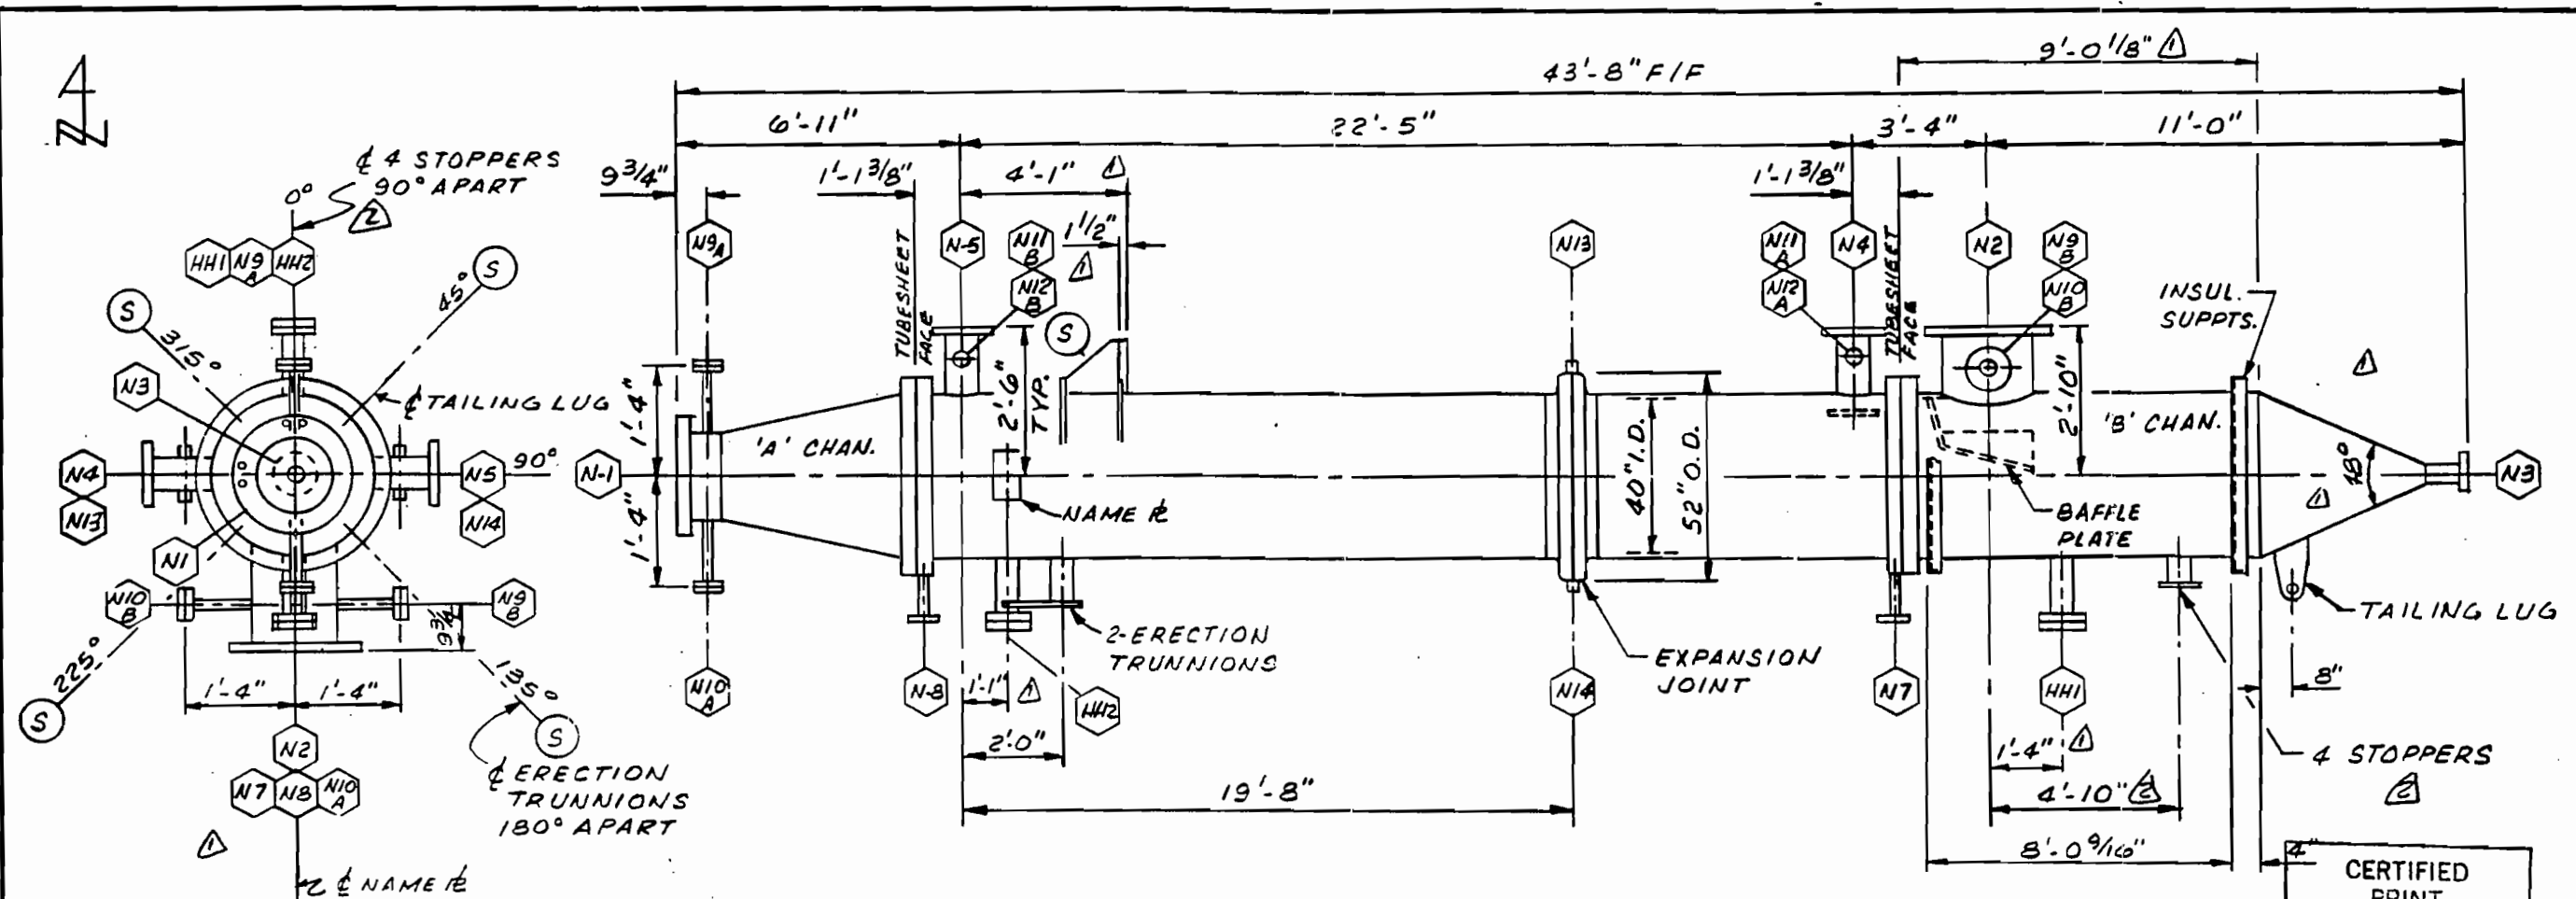

INSULATION THK. :
 'A' CHAN. = PERSONNEL PROTECTION
 'B' CHAN. = 2"
 SHELL = PERSONNEL PROTECTION

CERTIFIED
 PRINT
 APR 25 1995
 TEXAS METAL
 FABRICATING CO.
 A TRINITY INDUSTRIES CO.
 HOUSTON, TEXAS

*1 W/ BLIND		*2 W/ PLUG					
			N10 A,B	1"-300#RF *1	PRESS. GAUGE		
N5	12"-300#RF	WATER OUT	N9 A,B	1"-300#RF *1	THERM.		
N4	12"-300#RF	WATER IN	HN2	6"-300#RF *1	HANDHOLE	N14	3/4"-6000#NPS *2 DRAIN
N3	3"-300#RF	POWDER OUT	HH1	6"-300#RF *1	HANDHOLE	N13	3/4"-6000#NPS *2 VENT
N2	18"-300#RF	GAS OUTLET	N8	3/4"-300#RF	VENT	N12 A,B	1"-6000#NPS *2 PRESS. GAUGE
N1	18"-300#RF	GAS INLET	N7	3/4"-300#RF 	DRAIN	N11 A,B	1"-6000#NPS *2 THERM.

SCHEDULE OF CONNECTIONS

						FABRICATION DETAIL - OUTLINE & ASSEMBLY						REFERENCE 94062		REVISIONS A REV. PER CUST DLT/12-5-94 4 MOVED STOPPERS & REV. SUPPTS. DLT/4-13-95	PHILLIPS SUMIKA POLYPROPYLENE COMPANY PASADENA, TEXAS M.W. KELLOGG P.O. NO. 6014-02D1-C210-01 ITEM NO. PS-2001-220000-41-5005 2ND REACTOR GAS COOLER MANUFACTURER'S SERIAL NO. 9460 WTT #41001028	
						NO. 9460										
						SHEET 2										
MADE	DATE	CHKD	DATE	APVD	DATE											
DLT	10/24/94	JM	10-26-94	ETM	10-26-94											