

VP # 490012 - Y 4210-1C

APPROVED
 APPROVED AS NOTED
 RETURNED FOR CORRECTION

LIFE SCIENCES, INC.

10/13/92

Harold Dixon

THE RESPONSIBILITY
 OF FABRICATION. THIS
 APPROVAL DOES NOT RELIEVE VENDOR OF THE OBLIGATION
 TO MEET SPECIFICATIONS AND ALL OTHER TERMS AND
 CONDITIONS OF THE SUBCONTRACT OR PURCHASE ORDER.

Rohrverlauf / lead angle of pipes:
 30.70 243.4

1 : mm


APPROVED
 APPROVED AS NOTED
 RETURNED FOR CORRECTION

LIFE SCIENCES, INC.

DATE

SIGNATURE

ALL DETAILS AND DIMENSIONS ARE THE RESPONSIBILITY
 OF THE VENDOR. PROCEED WITH FABRICATION. THIS
 APPROVAL DOES NOT RELIEVE VENDOR OF THE OBLIGATION
 TO MEET SPECIFICATIONS AND ALL OTHER TERMS AND
 CONDITIONS OF THE SUBCONTRACT OR PURCHASE ORDER.

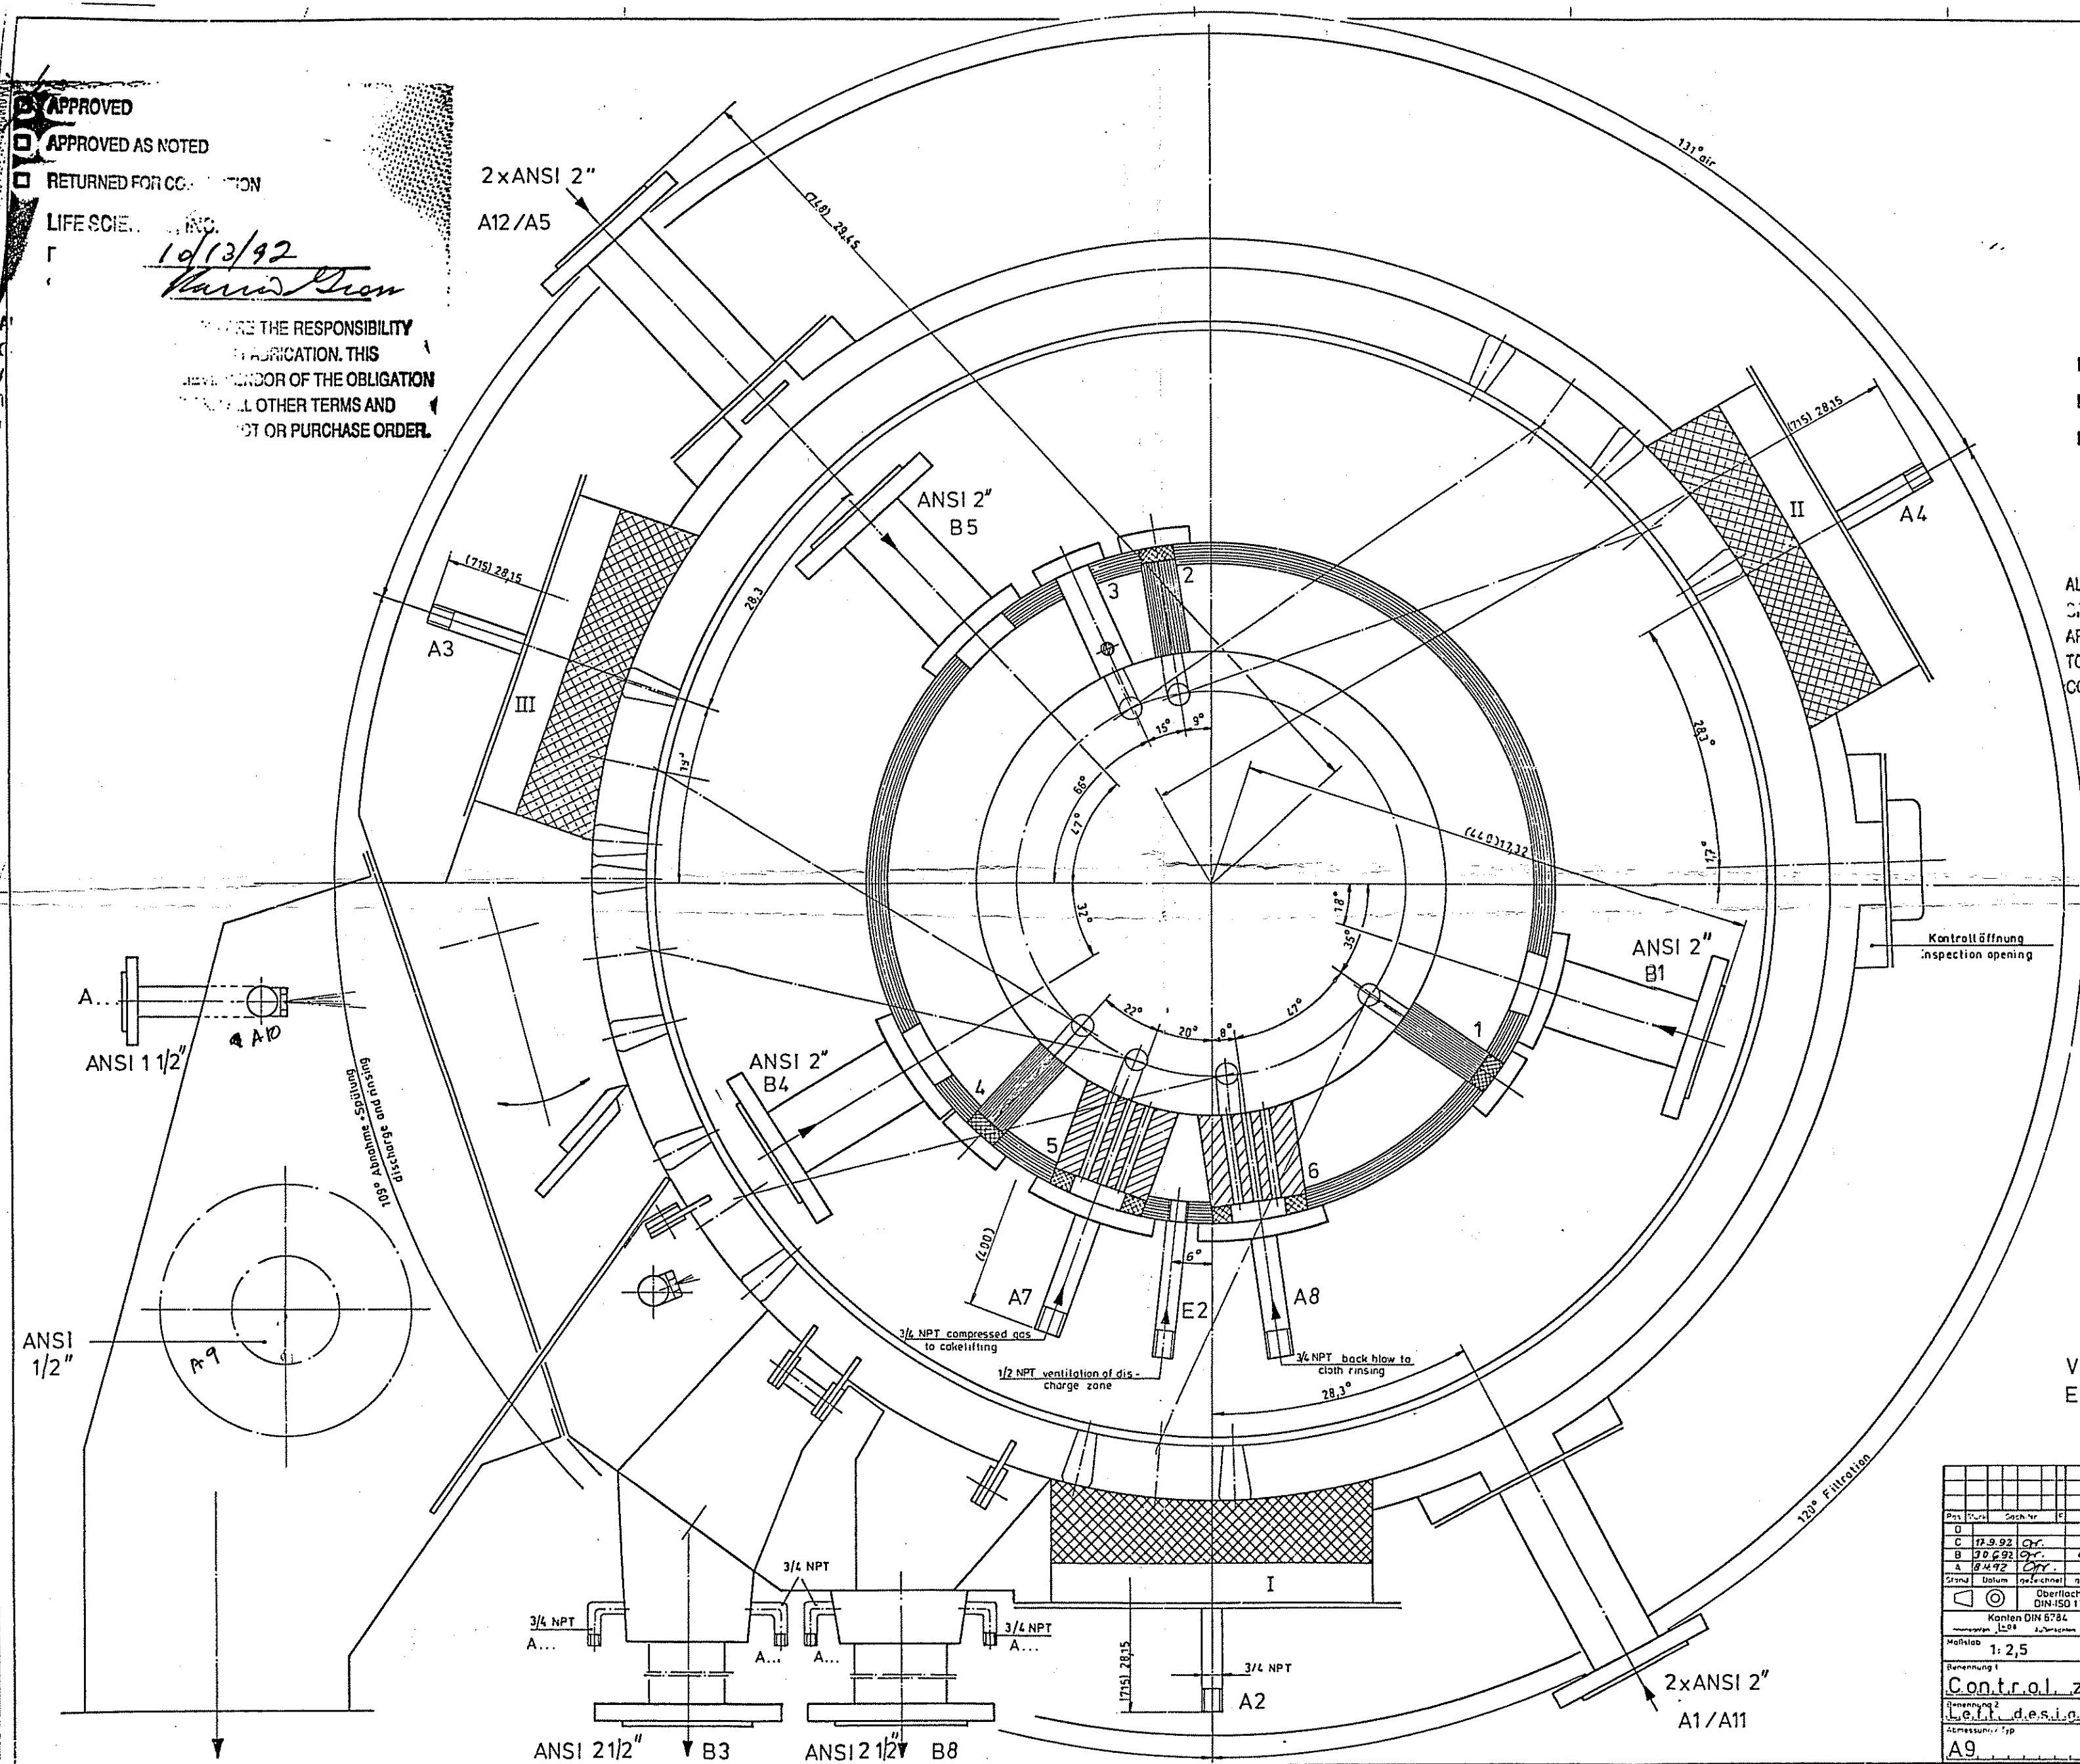

Kontrollöffnung
 inspection opening

VP#8549 - 490012-3R1
 EQUIP. Y4210

Pos.	Truck	Sech.	Tr.	Benennung	Abmessungen	Verstärkt	DIN	Druck
Q								
C	17.9.92	Dr.						
B	30.6.92	Dr.						
A	8.4.92	Dr.						
VP#490012-Y4210 -3C