
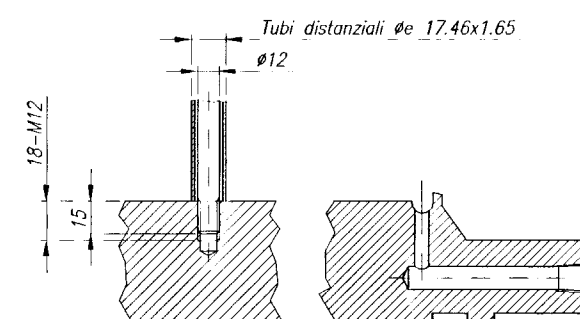
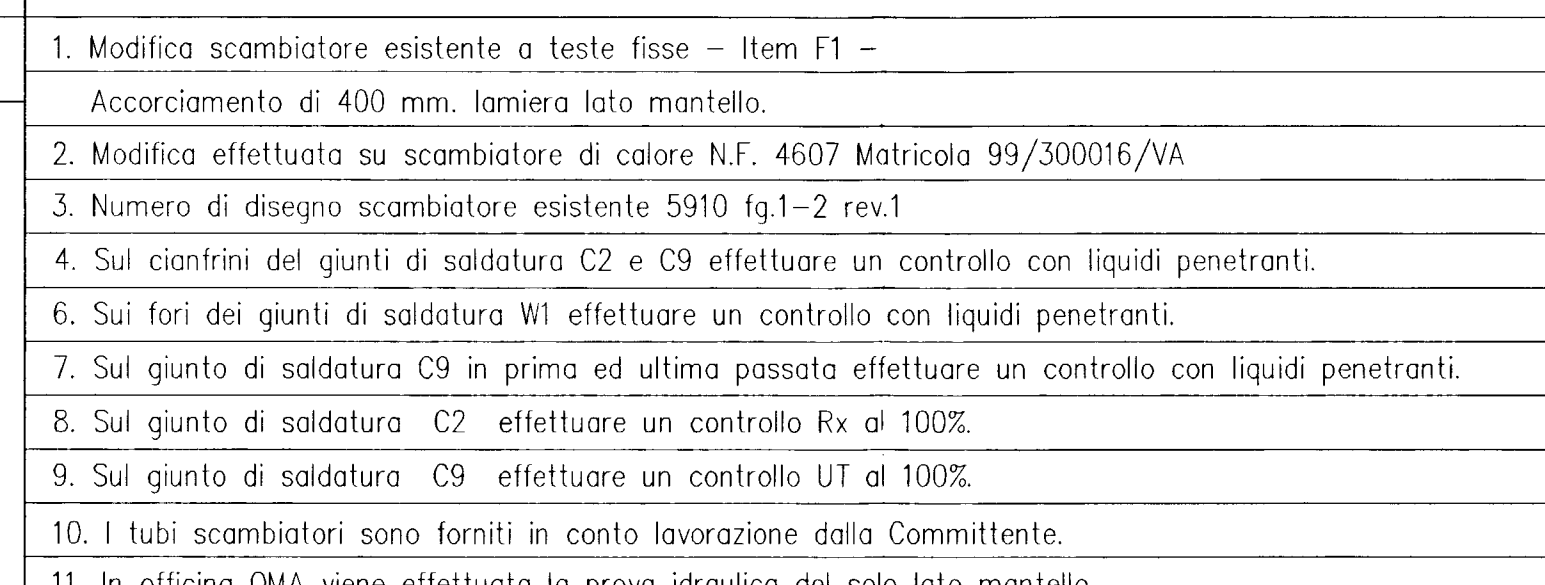


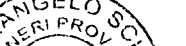




[illegible]