

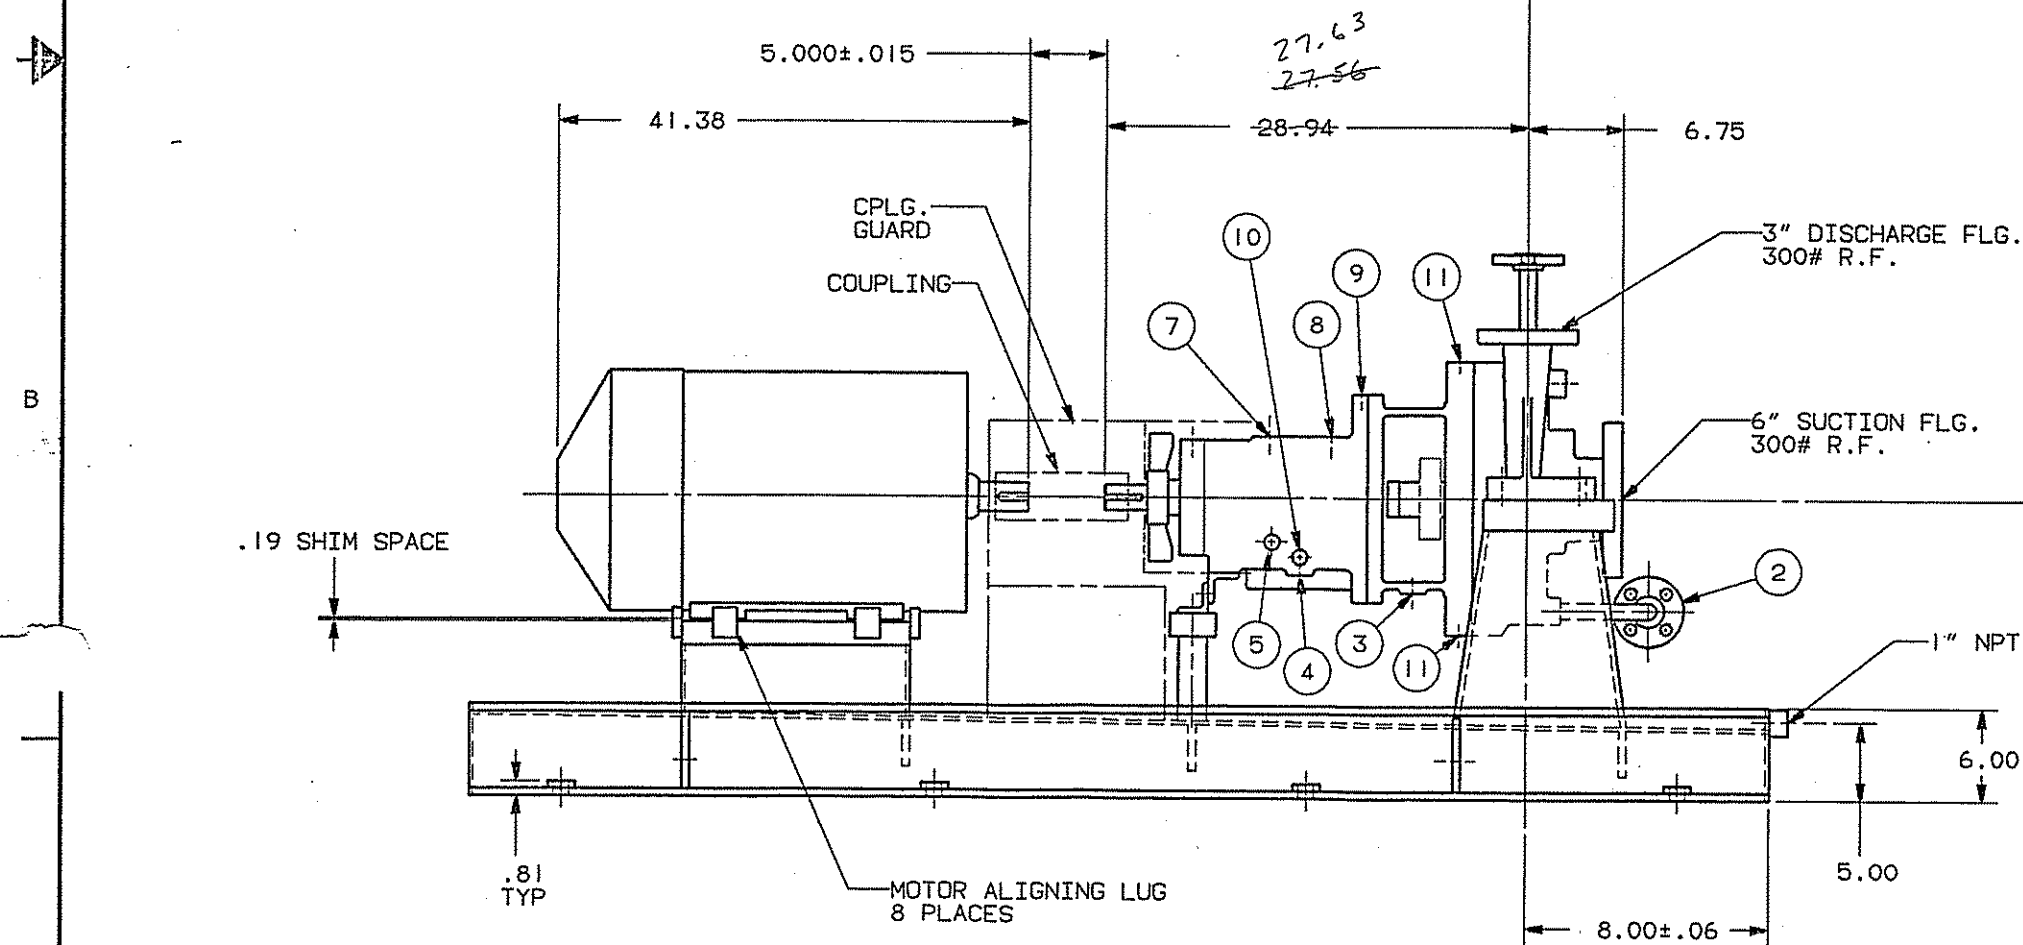


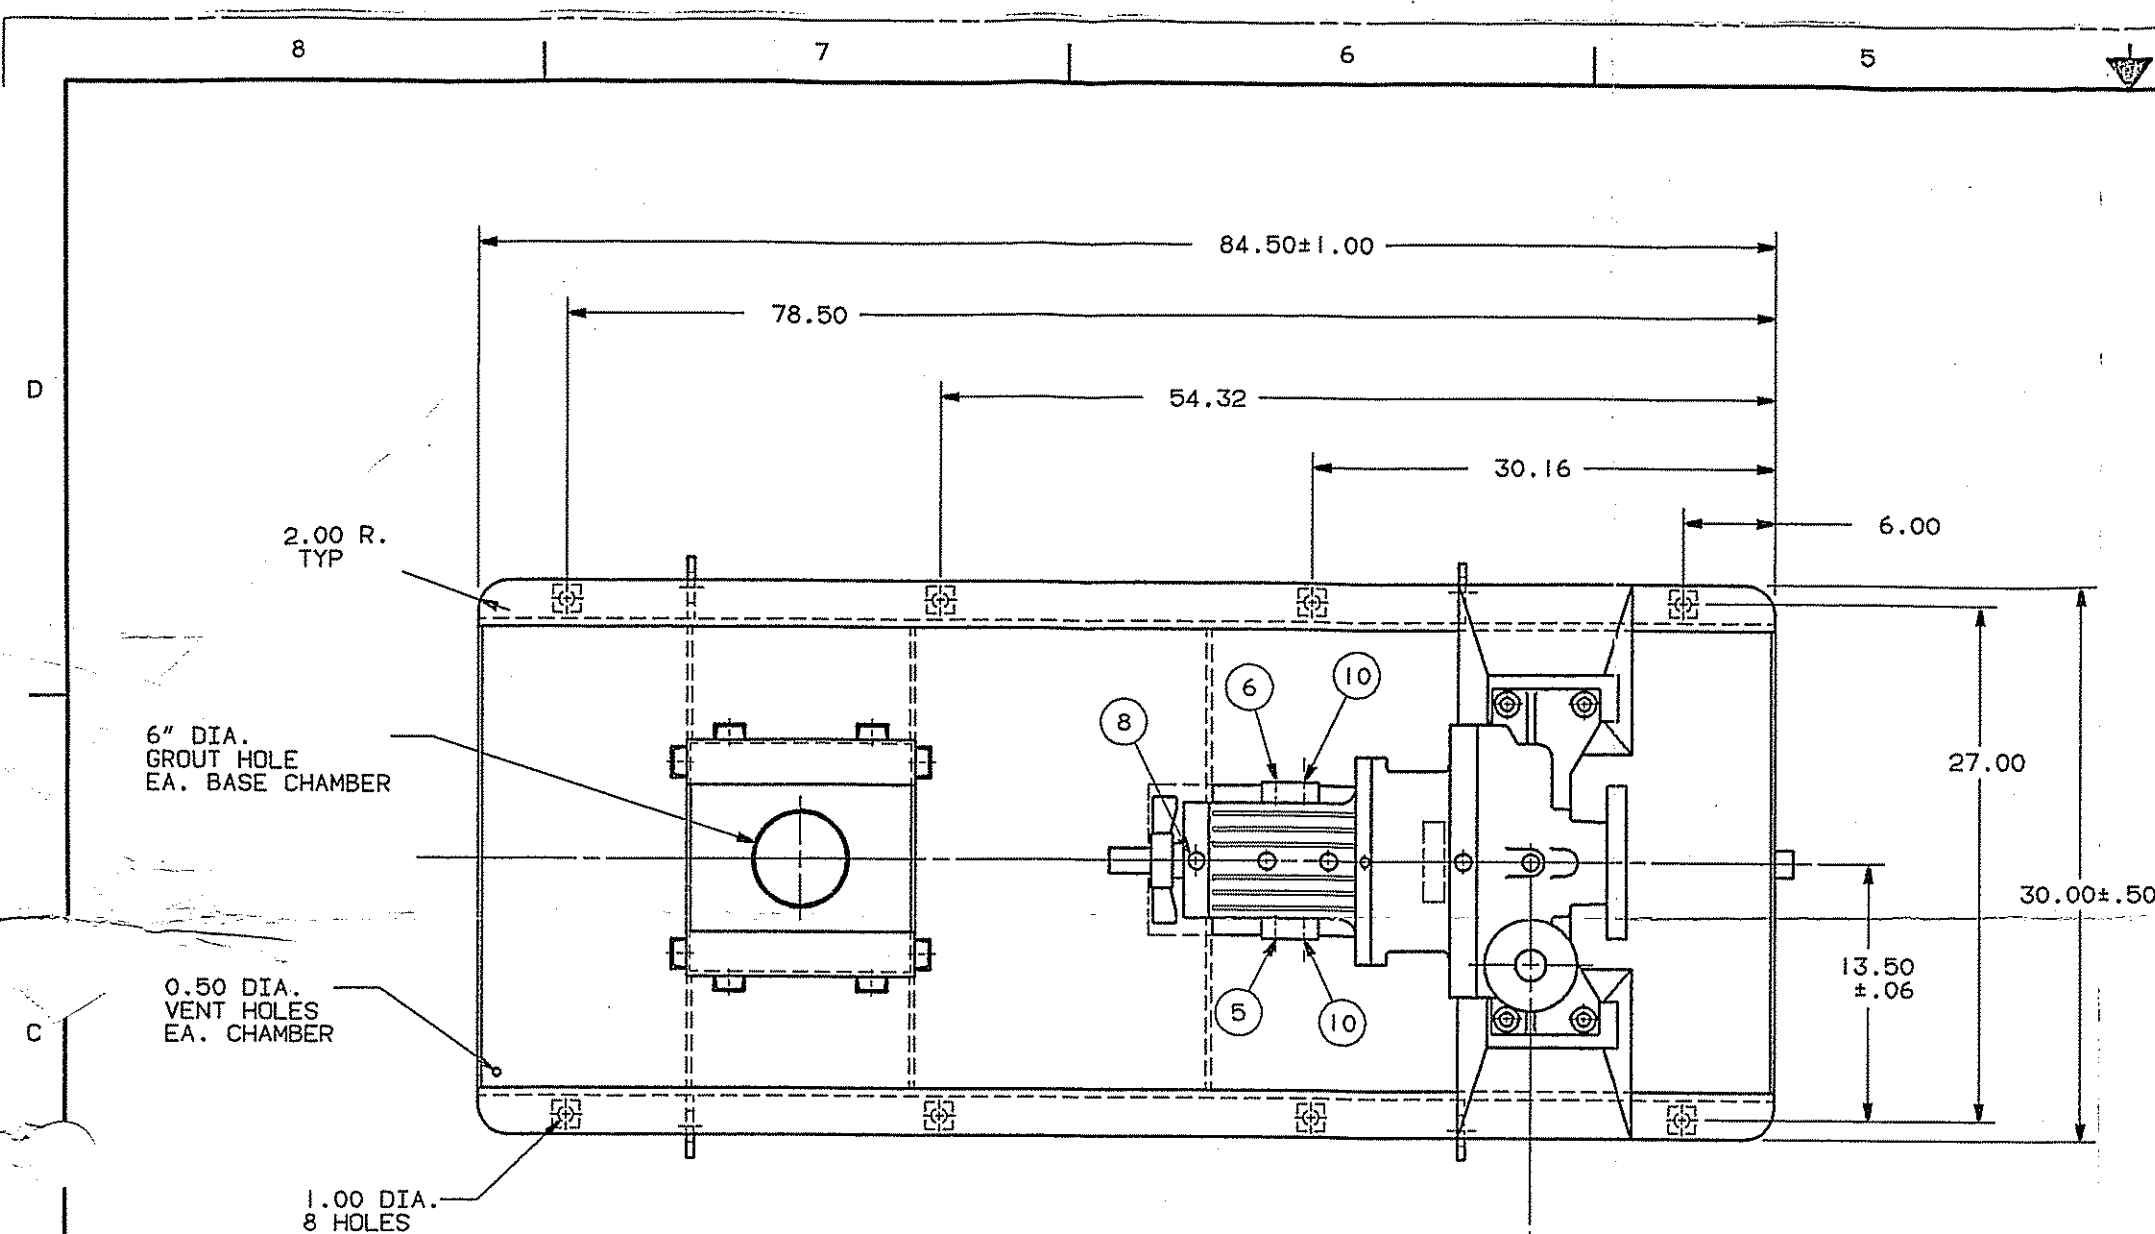

CONN	NPT	DESCRIPTION
①	---	VENT - 3/4-300# R.F. FLG.
②	---	DRAIN, VALVED - 3/4-300# R.F. FLG.
③	3/4	DRAIN, DRIP POCKET - OPEN
④	3/4	DRAIN, BEARING HSG. OIL - PLUGGED
⑤	3/4	OIL LEVEL INDICATOR - PLUGGED
⑥	3/8	CONSTANT LEVEL OILER - PLUGGED FOR SHIPMENT
⑦	3/4	VIEW PORT / BREATHER
⑧	3/4	VIEW PORT / OIL MIST - PLUGGED
⑨	1/4	OIL MIST - PLUGGED
⑩	3/4	COOL WATER, BRG. HSG. - PIPED
⑪	3/4	COOL WATER, SEAL CHAMBER - PIPED
⑫	3/4	COOL WATER, PEDESTAL - PIPED

MOTOR	
MFG.	SIEMENS
H.P.	125
FRAME	444TS
VOLTAGE	460
ENCLOSURE	TEFC
RPM	3600
WEIGHTS	
PUMP	590 LBS.
MOTOR	1800 LBS.
BASE	1027 LBS.
TOTAL	3417 LBS.

- NOTES:
- ALL DIMENSIONS ARE IN INCHES.
 - UNSPECIFIED TOLERANCES ARE ±.25.
 - ANCHOR BOLT HOLE LOCATION DIMS. ARE ±.13 AND FLANGES ARE ANSI STD.

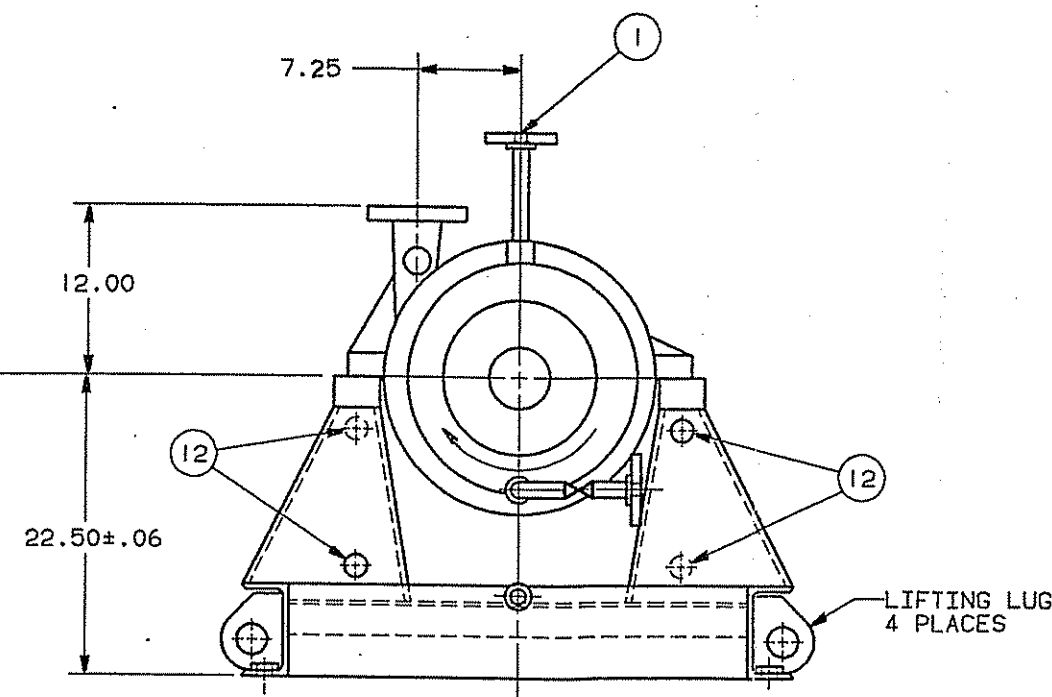

CUSTOMER: AMOCO OIL CO.
LOCATION: GRAFTON, VA.
P.O. NO: 8941-805
ITEM NO: J-115
SERVICE: RESIDE (HYDROCARBON)
PPD NO.: P54524
PUMP S/N: P54524-01
SIZE/TYPE: 3 X 13 SVCN 7 STGS.: 1

PACIFIC®

DRESSER PUMP
DIVISION



TITLE				
PUMP AND MOTOR OUTLINE				
DWN: ROW	CERTIFIED: <i>Scott McChesney</i>	DATE: 5-4-89		
CKD: .	SIZE	DWG. NO	SHEET	REV
SCALE: NTS	D	300-P54524	1 OF 1	0

102873