
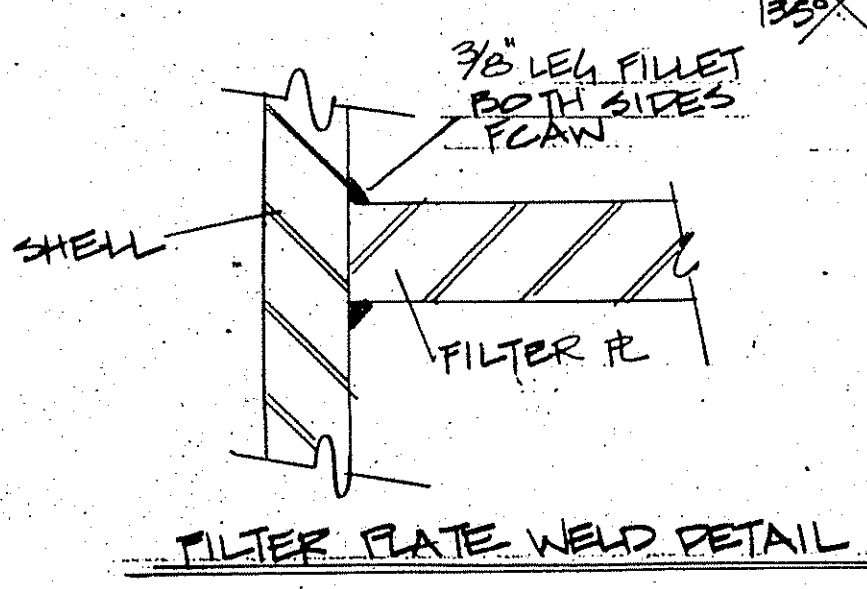


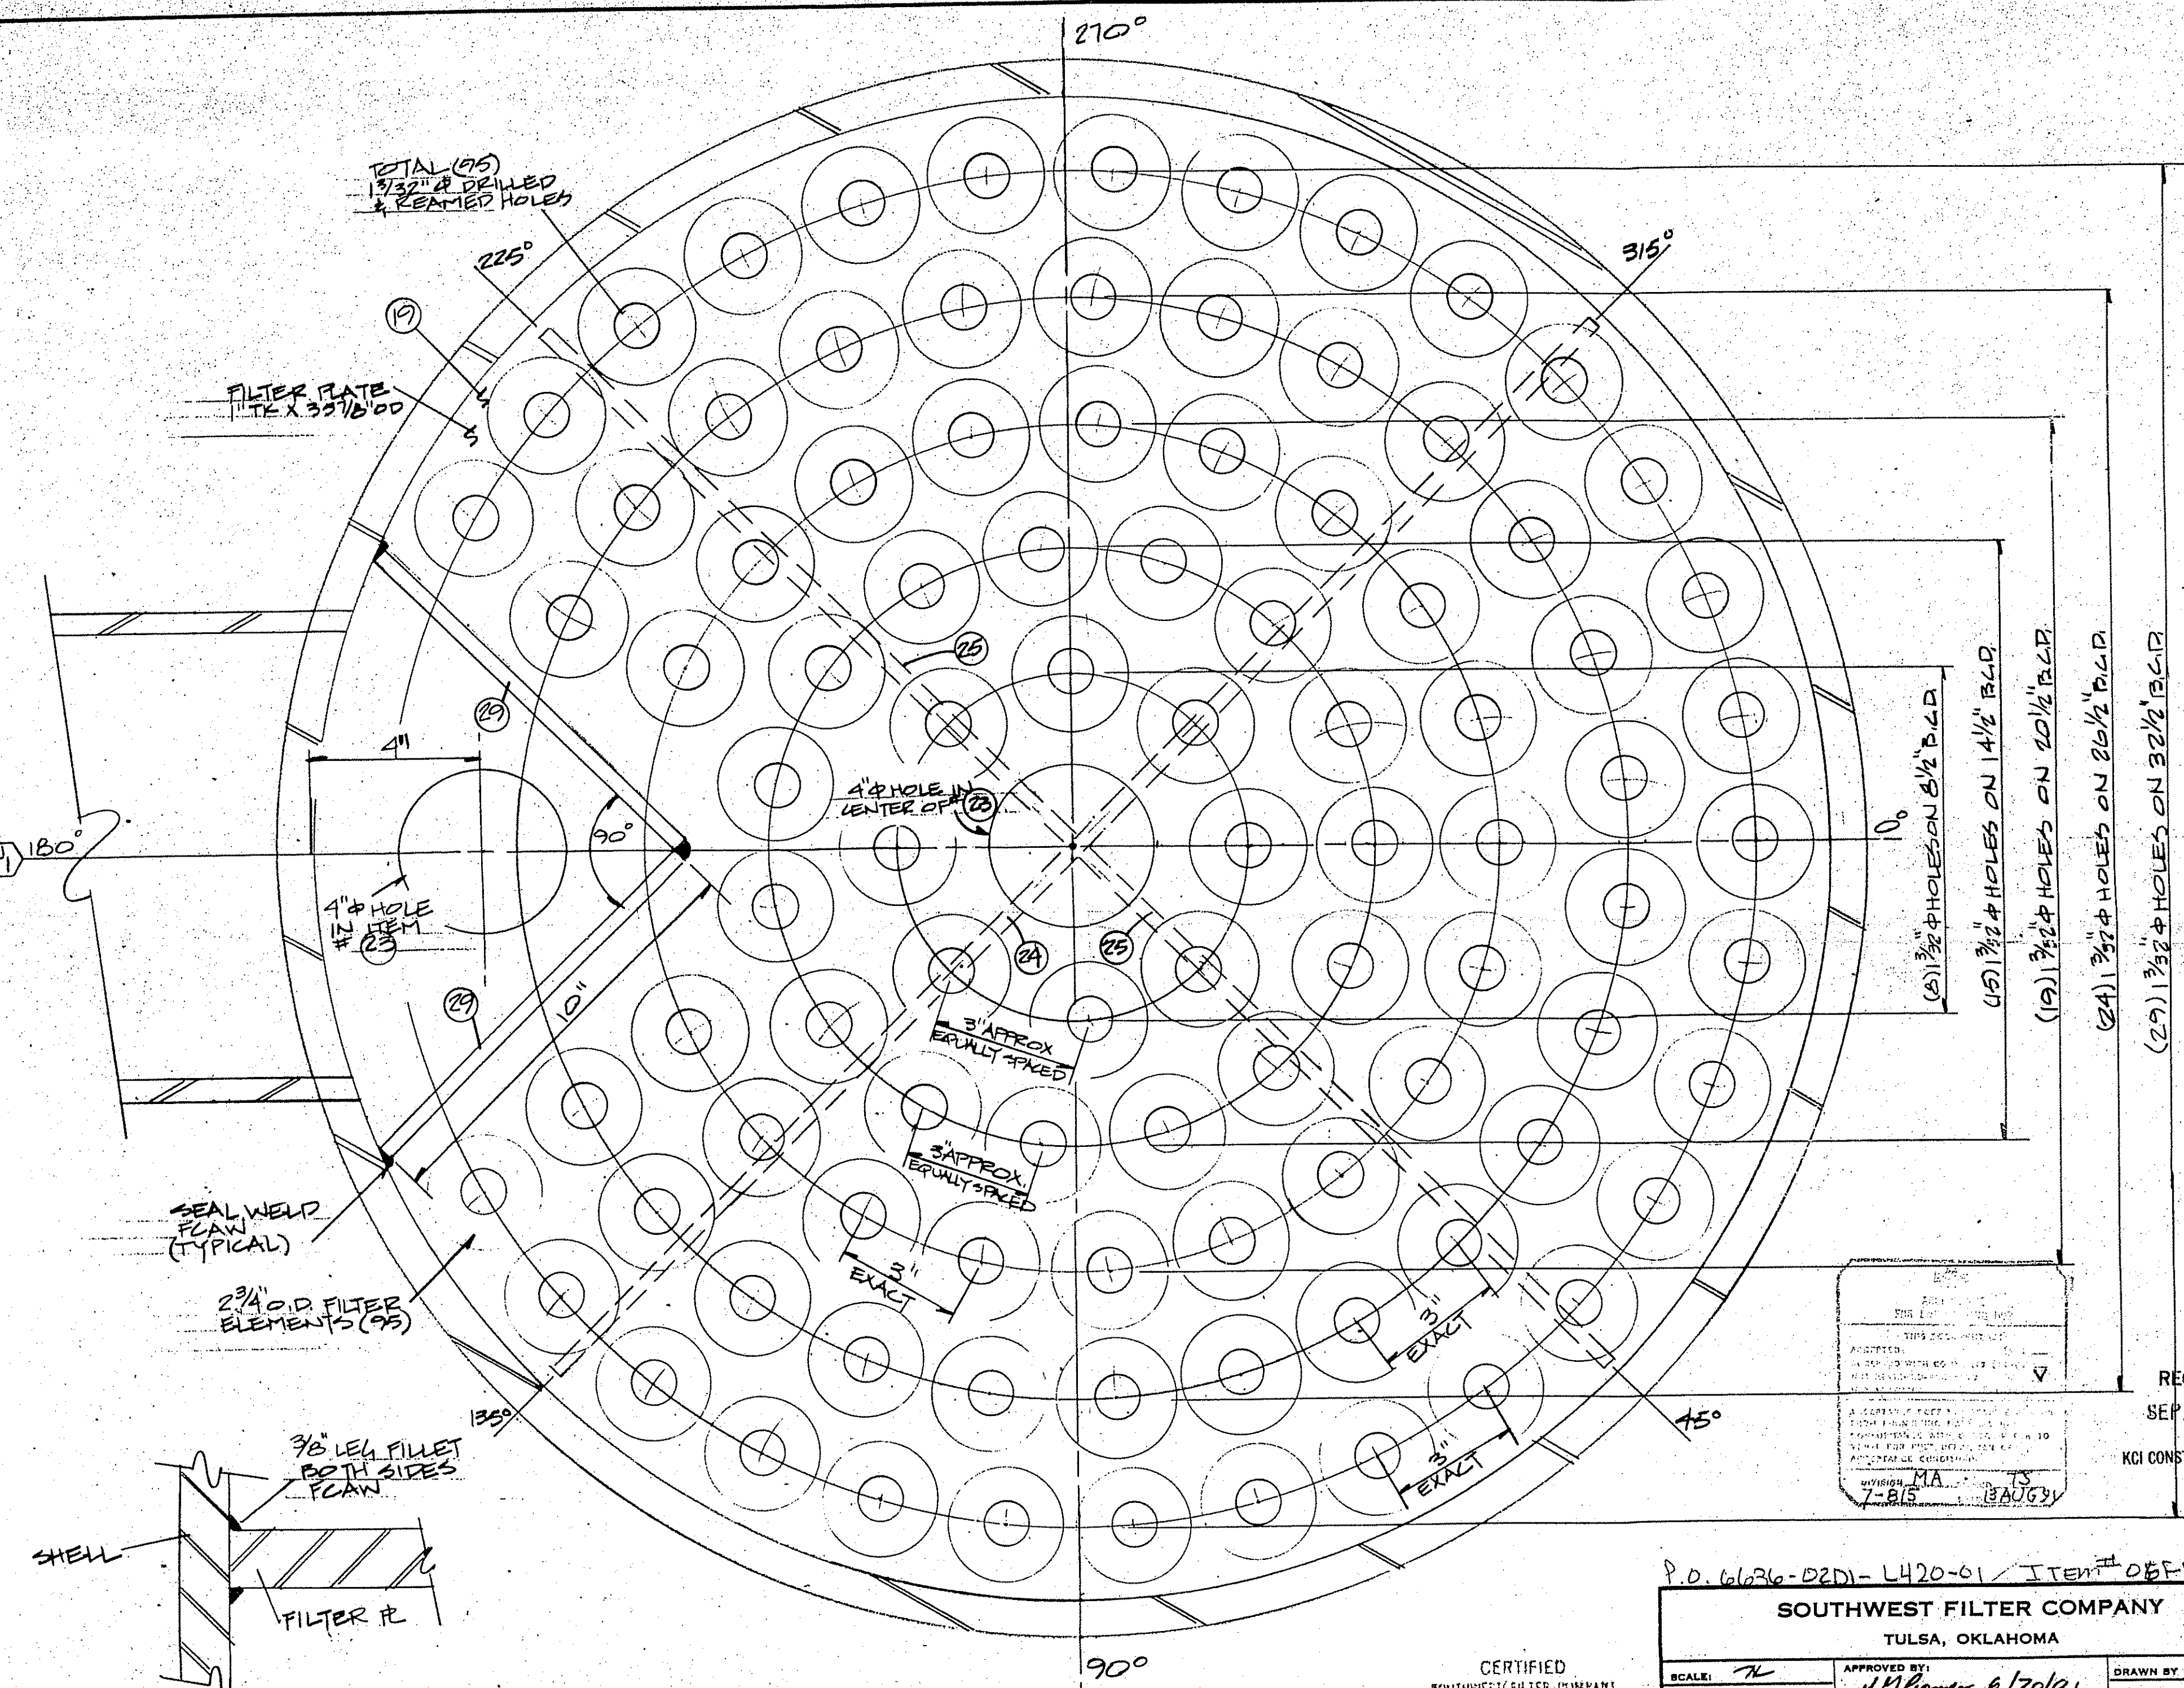

FILTER PLATE LAYOUT

CERTIFIED
SOUTHWEST FILTER COMPANY
7/3/91

RECEIVED	
SEP 03 1991	
KCI CONSTRUCTORS, INC.	

P.O. 6636-D2D1-L420-01 Item# 08F101A13

SOUTHWEST FILTER COMPANY		
TULSA, OKLAHOMA		
SCALE: 7/2	APPROVED BY: <i>[Signature]</i> 6/20/91	DRAWN BY: TEA
DATE: 6-91	REVISED	
FILTER PLATE DETAILS		
MODEL 351 VFL FILTER		DRAWING NUMBER: C6551 SHG

#103378