



EXCISE SHEET
DO NOT REMOVE FROM
LIFE BOOK

BILL OF MATERIALS


ITEM	QTY	DESCRIPTION	MATL	DET
------	-----	-------------	------	-----

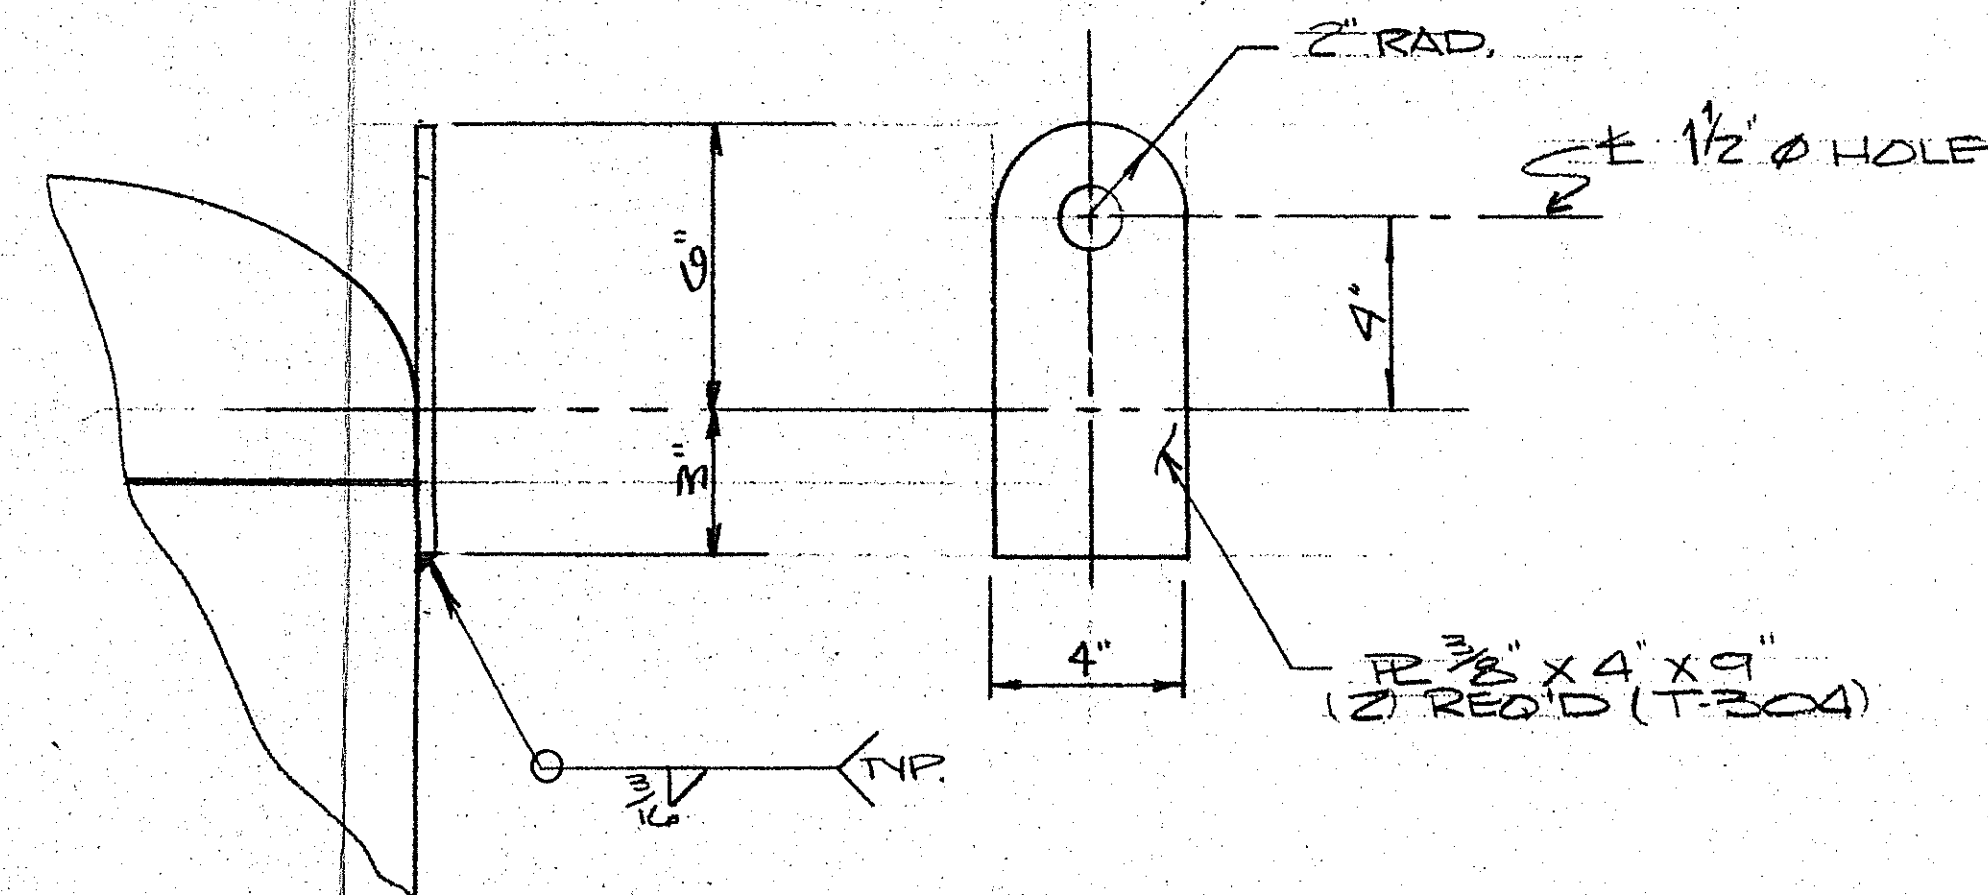


LIFT LUG DET.
(2) REQ'D

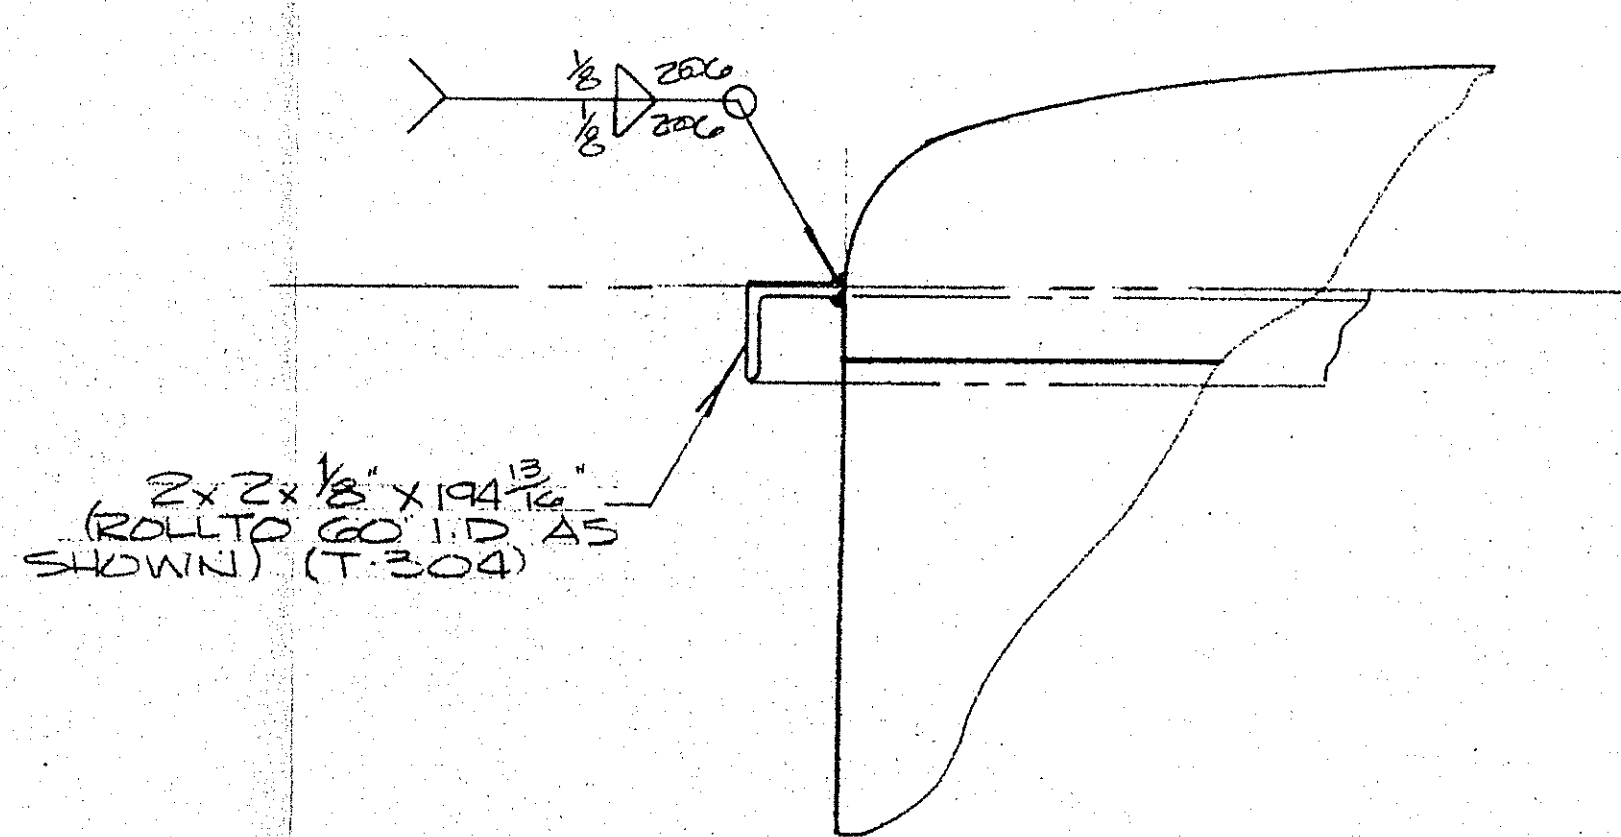


TANK ANGLE RING
(DETAIL # 2)

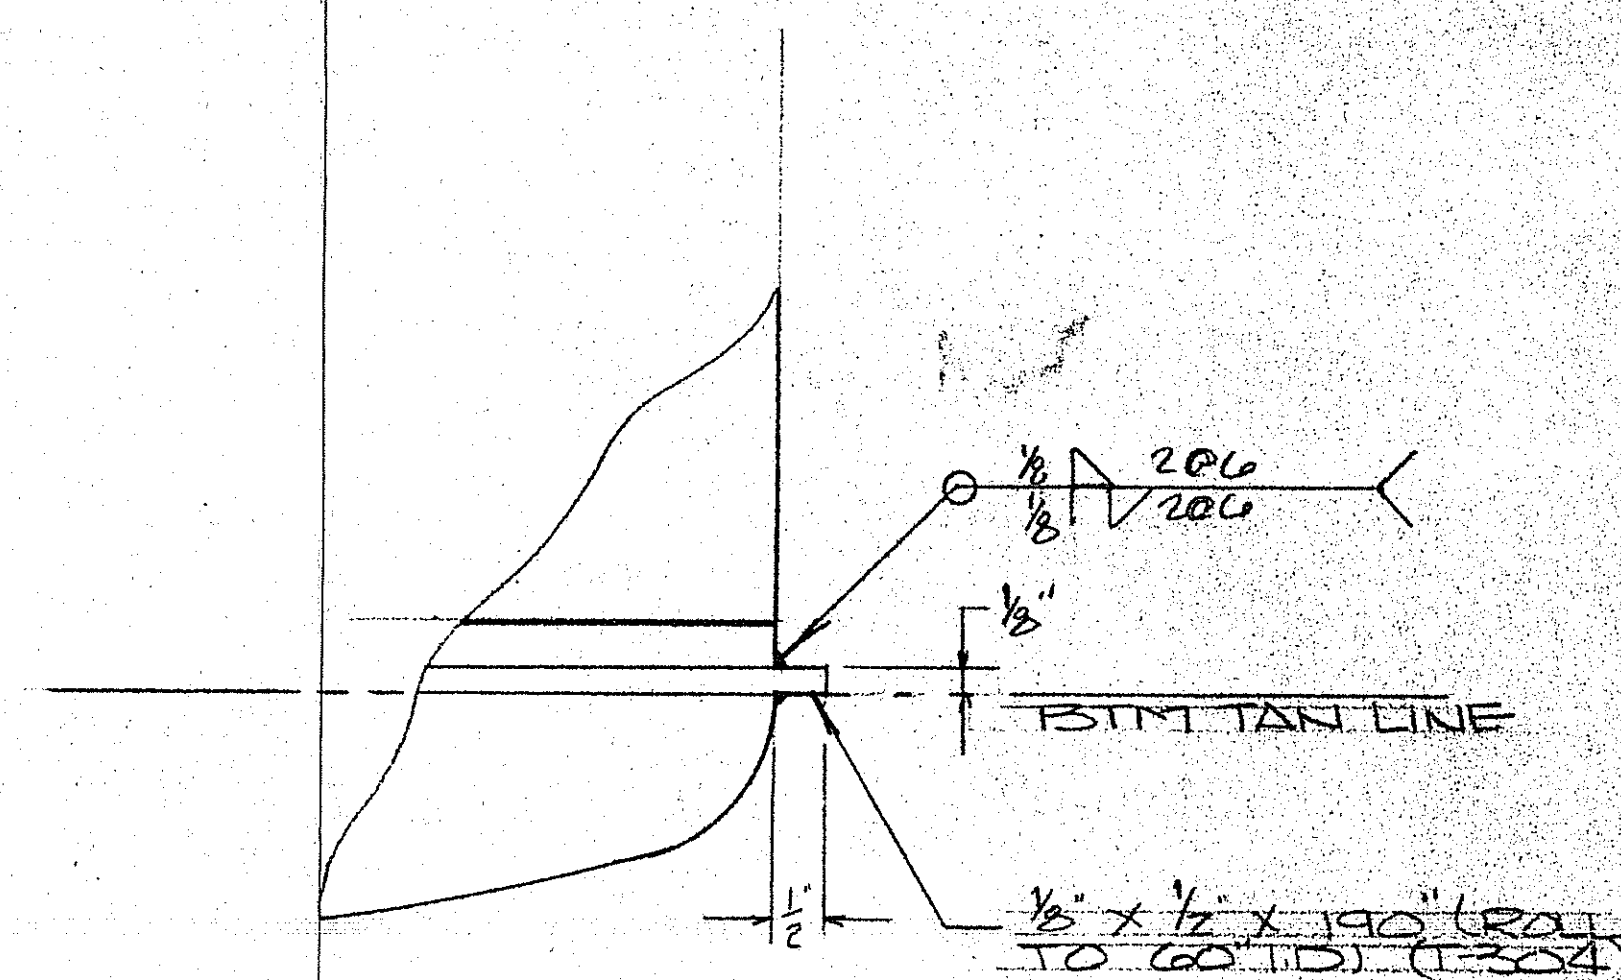


INSULATION RING DET.
(DETAIL # 1)

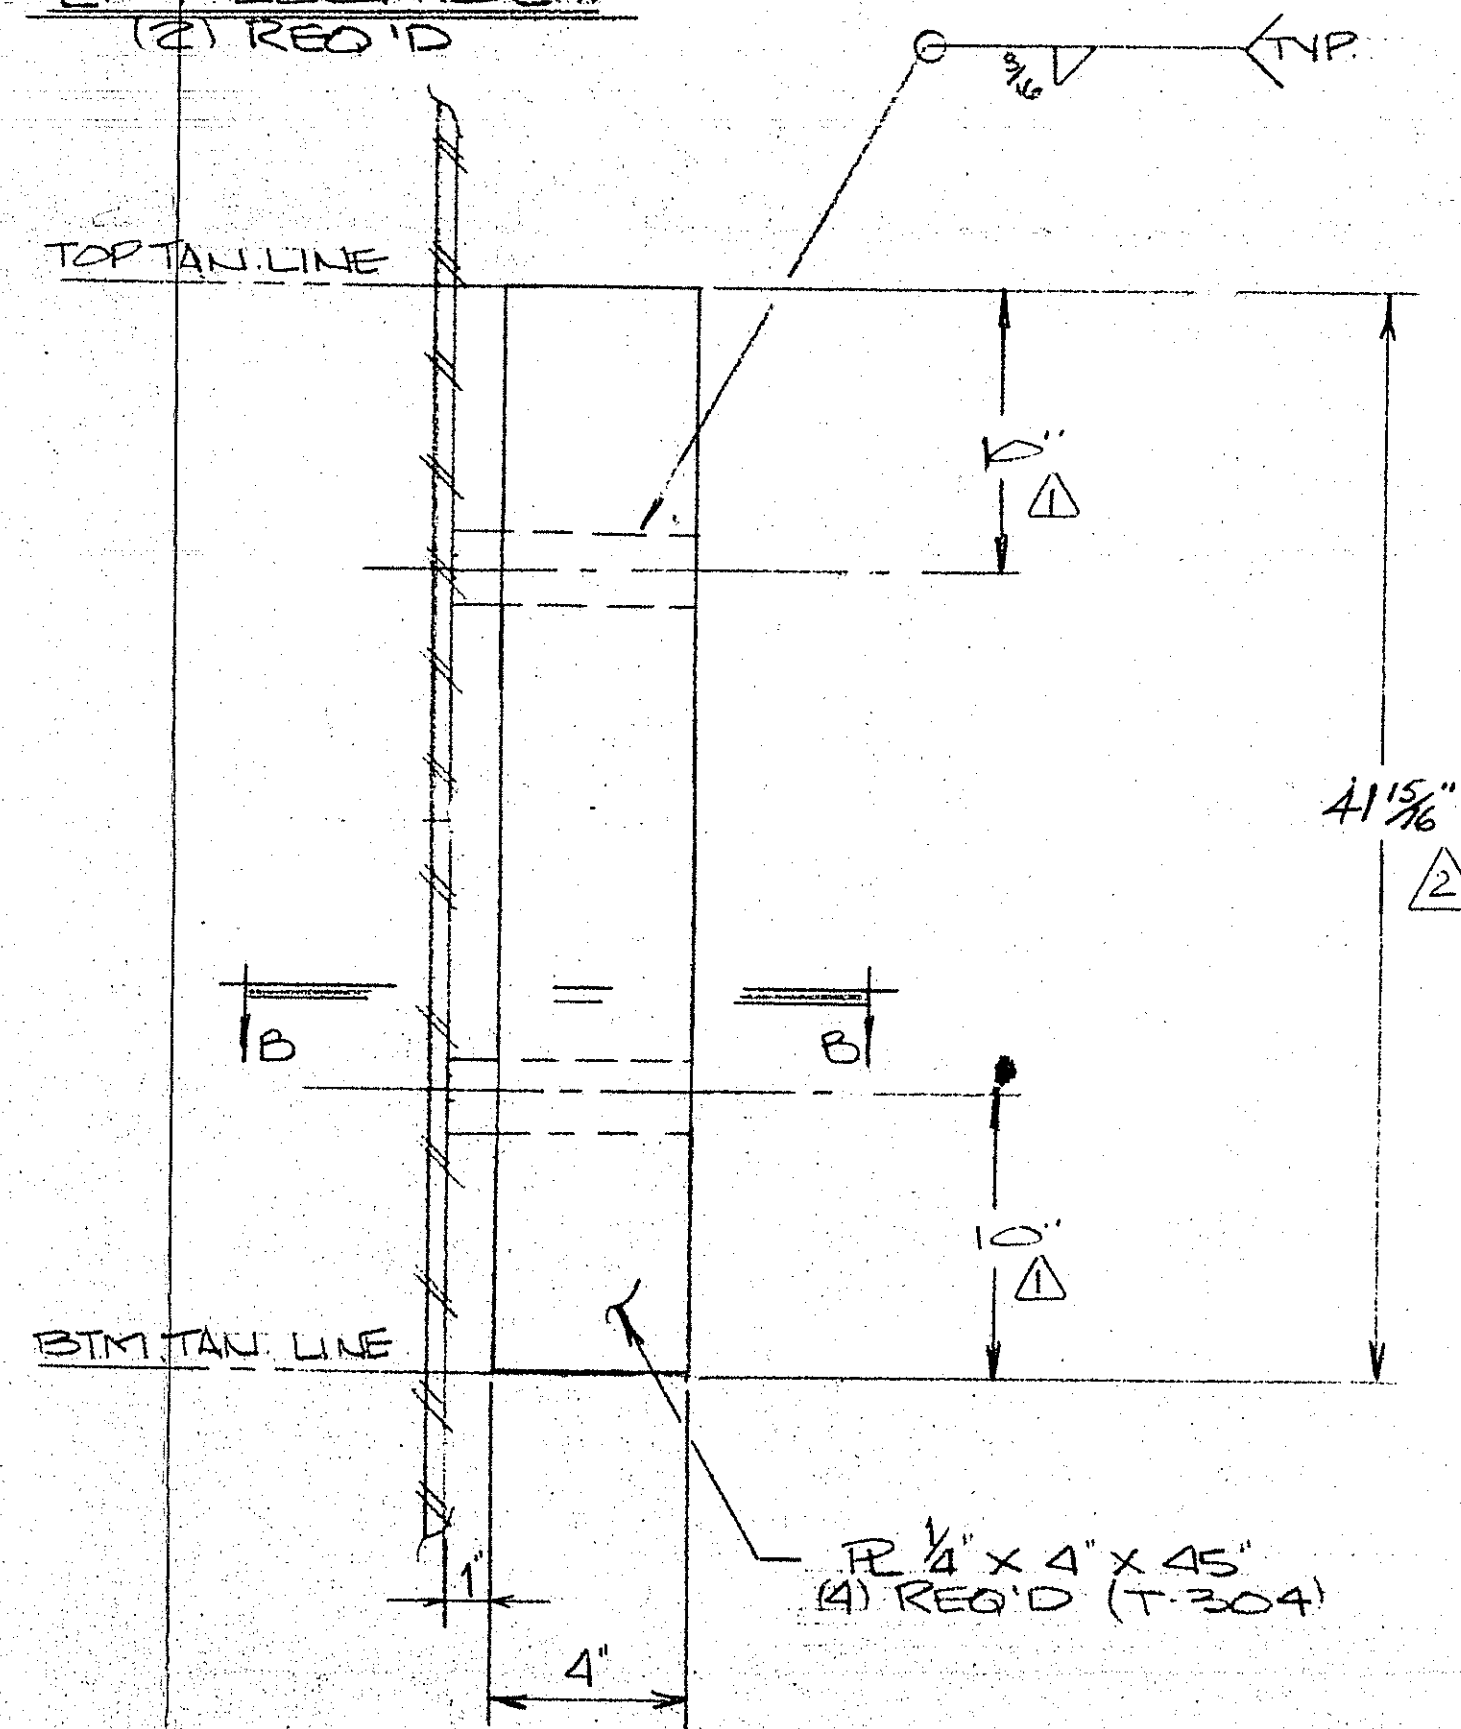


BAFFLE DETAIL
(4) REQ'D

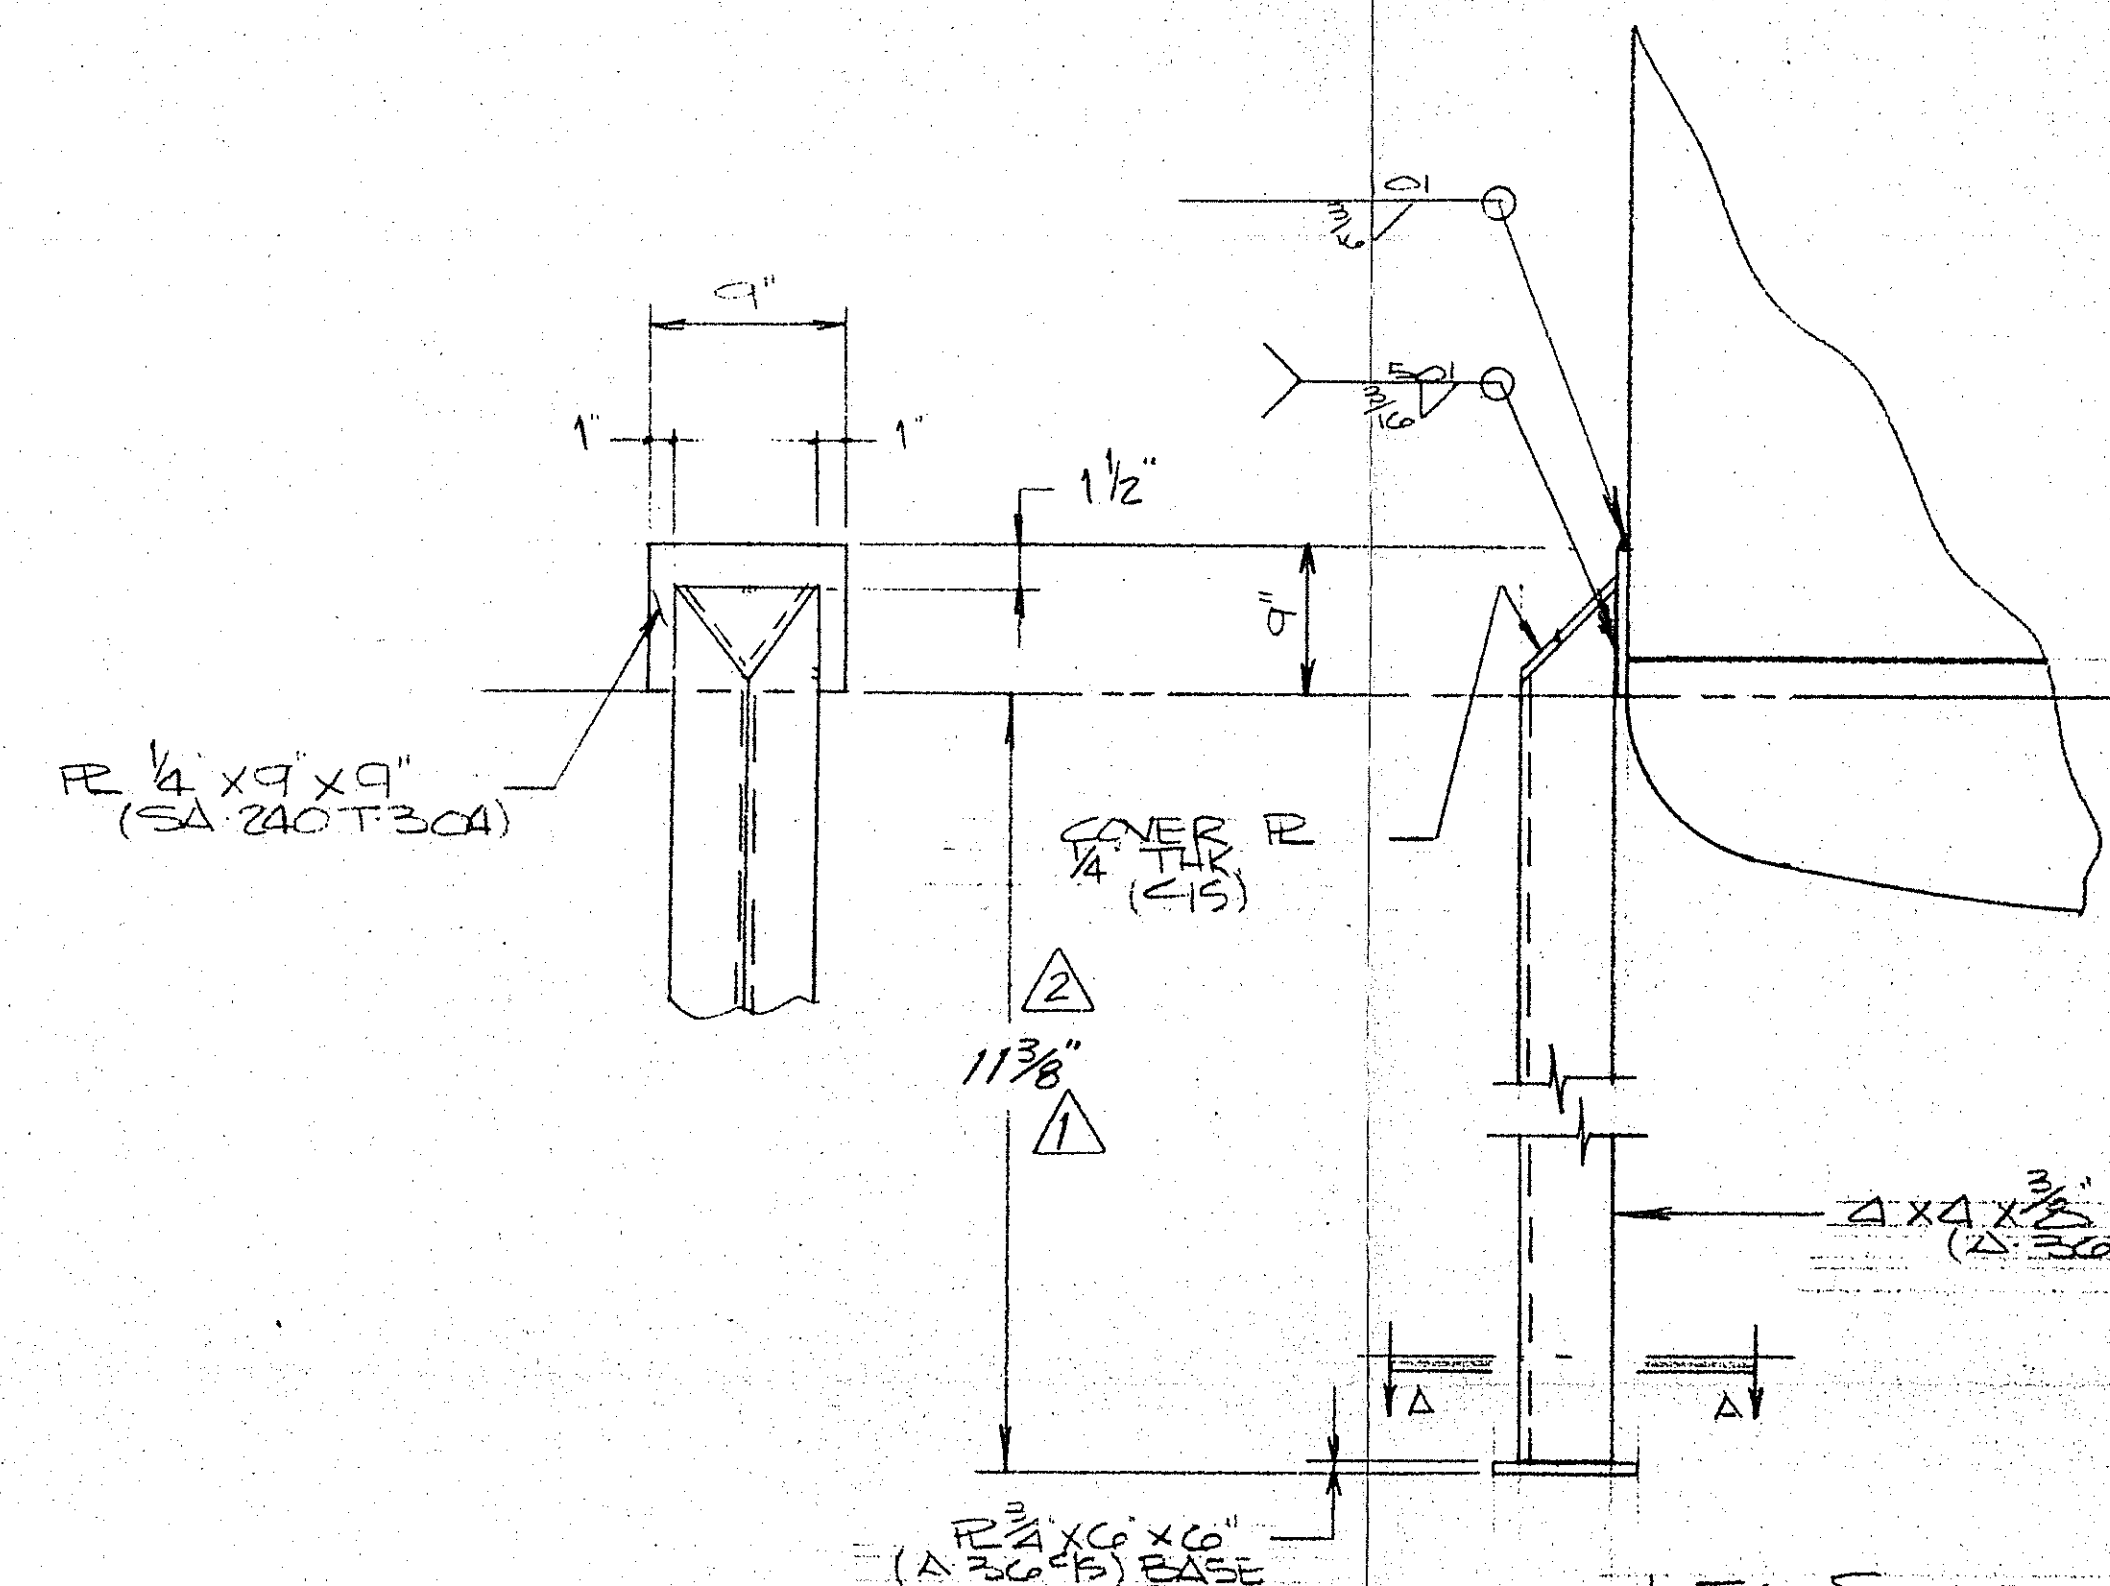

LEG SUPPORT DETAIL
(1) REQ'D

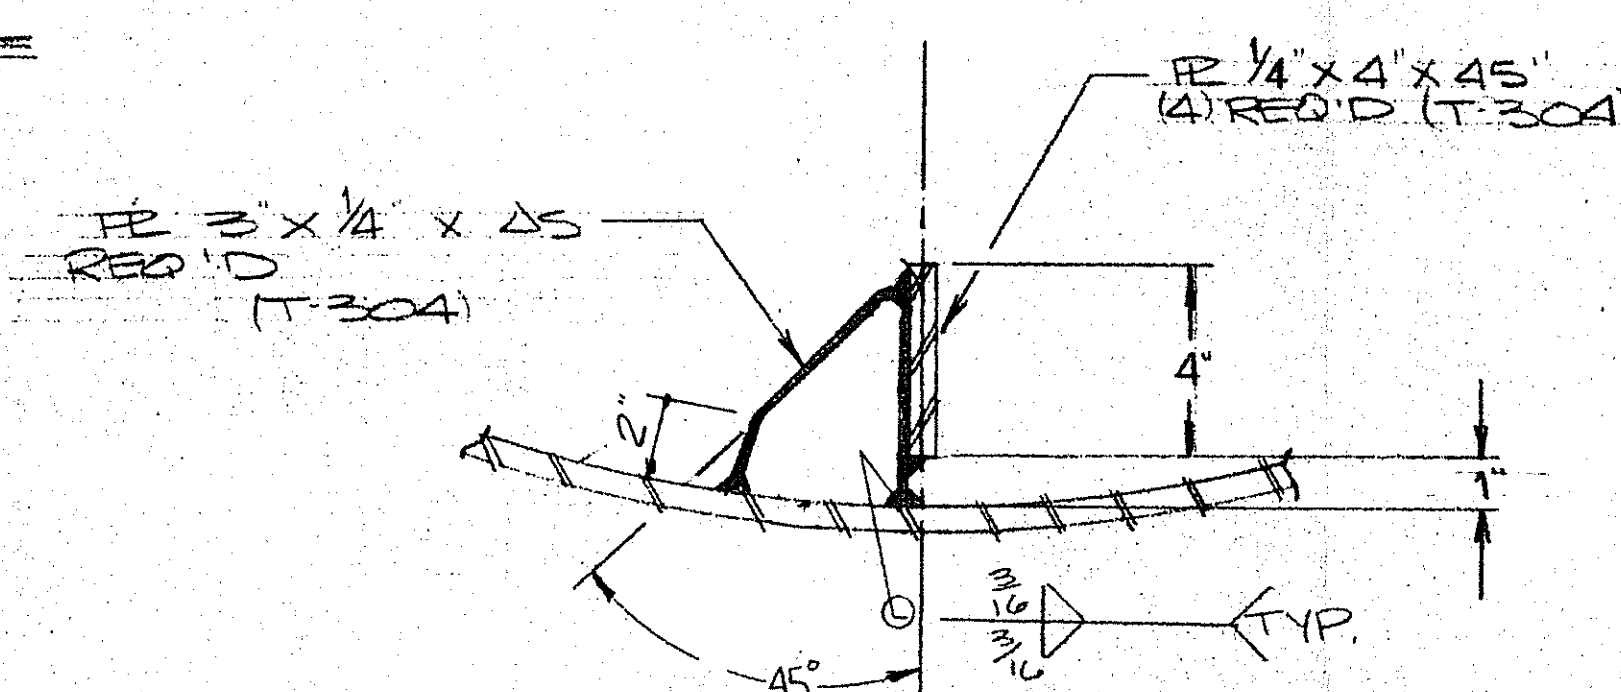

SECTION 'A-A'

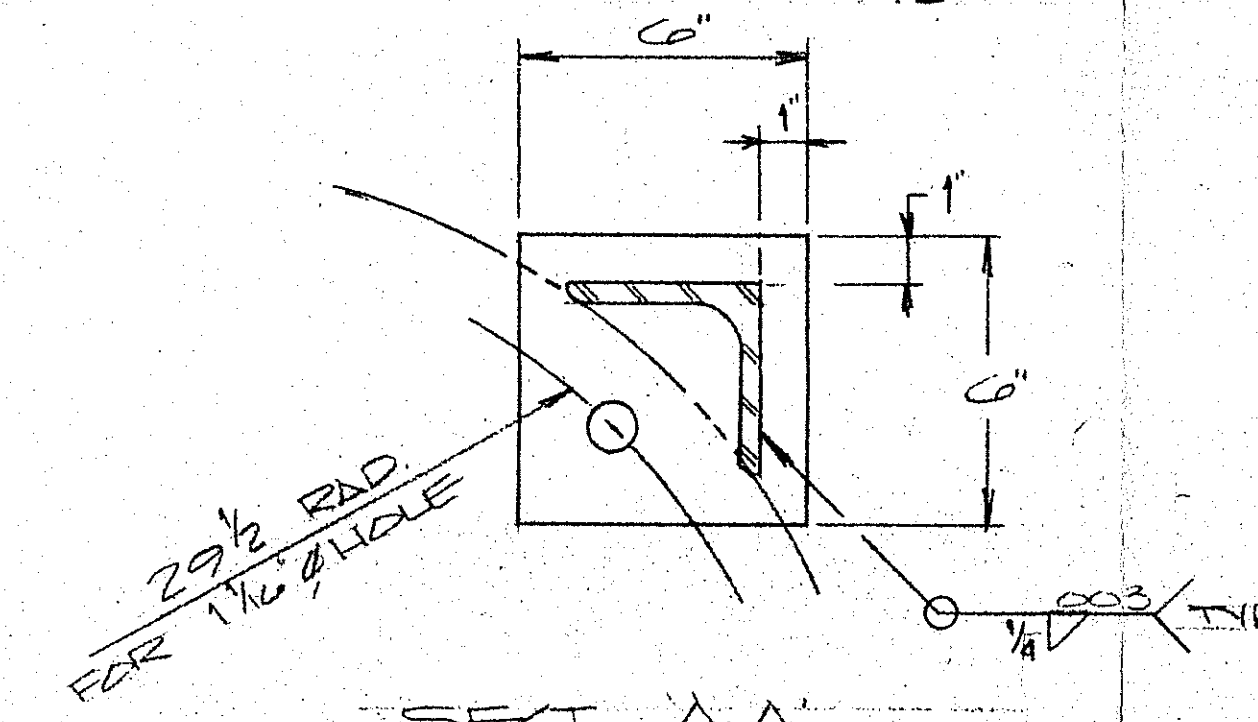

SECT 'A-A'

CERTIFIED PRINT
IPSCO FABRICATORS
DIVISION OF SYNALLOY CORPORATION
DATE: 2/3/87
SIGNED: [Signature]

ipSCO VPF #37627WN	
Quality Fabricators of Alloy Vessels, Division of Synalloy Corp. IPSCO Street N.W., Decatur Industrial Park, P.O. Box 1328, Decatur, Alabama 35602 (205) 355-7810, TWX 910-724-1104 (IPSCO-DTU)	
MISC. SHOP DETAILS	
CENTRIFUGAL WASH RECYCLE TANK	
DWN. BY: DJ CADE INDUSTRIES	
DATE: 11-8-86	
CHKD. BY: K.S. WILMINGTON, N.C.	
DATE: 11-21-86	
JOB NUMBER: 60651	SHT. OF: 2 4
ENGR. DEPT. MAR 10 1987	REVISION NUMBER: 2

REVISIONS	APPROL CHGS JAN 2 87	Dim. ADJUSTMENTS 2/3/87 AKS
-----------	-------------------------	--------------------------------