


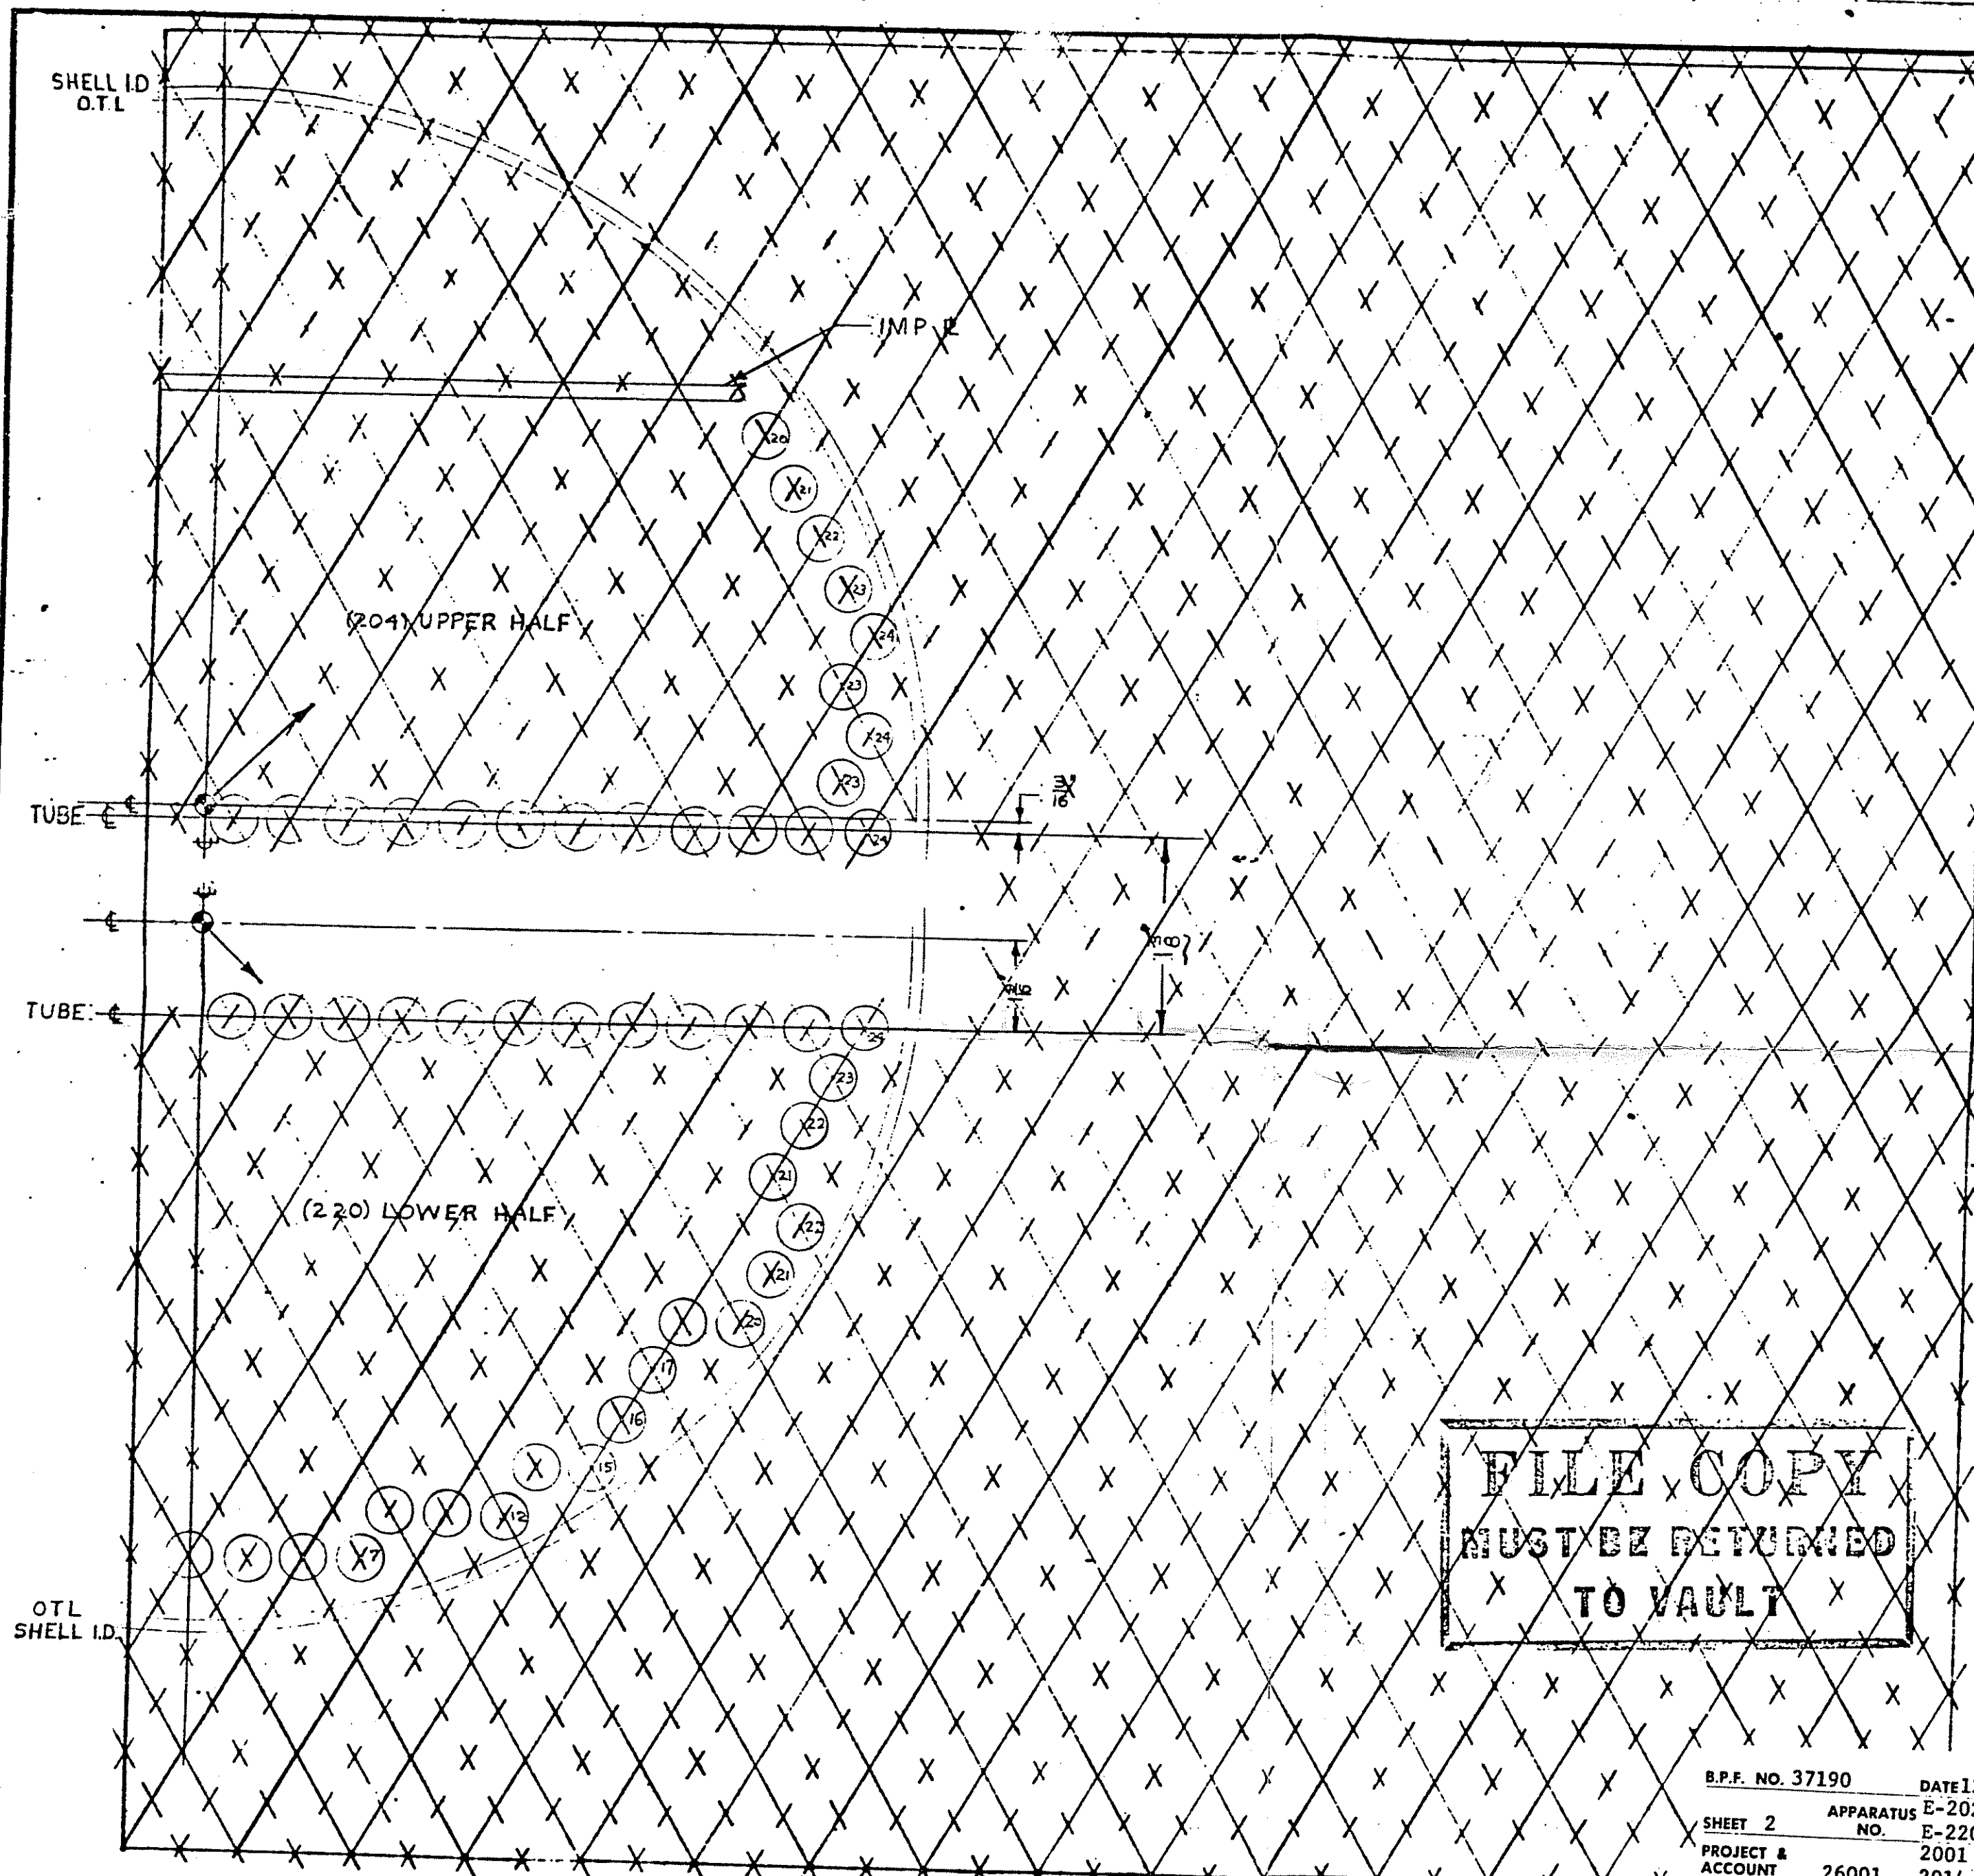

NR TUBES	424 S	OD.	3/4"
UNIT SIZE	24"	I.D. (UNIT)	23 5/8"
OTL (MAX)	—	OTC (MAX)	—
OTL (ACT)	23 1/4"	IMP NOZZ	14
TUBE PASSES	2	TUBES/PASS	204/220
SHELL PASSES	1	BAF. CUT	% (V)(M)
TIE ROD SIZE	3/8"	T.R. NR	6

USE 18" BUFILE PITCH & 45% CUT

CUSTOMER: HERCULES INC
 CUST. ITEM NR: E-202-4 — E 2202-4
 INQ. NR:
 JOB NR: 16371-4
 BY: D.A.R. DATE: 12.15.66
 SCALE: HALF

B.P.F. NO. 37190 DATE 12/21/66
 SHEET 2 APPARATUS E-202-4
 NO. E-2202-4
 PROJECT & ACCOUNT 26001 2001 2014

ORDER NO. 336-026-01092

PLANT HANDOVER — WILM., N. C.
 APPROVED as noted H.G. Schuber

REV.	BY	DATE
MANNING & LEWIS ENGINEERING CO. UNION, N. J.		
GRID TUBE LAYOUT 1 5/16" Δ PITCH		
MAX O.T.C. MAX O.T.C.		
O 1/2" SCALE: ED O 1/2" SCALE: 30"		
SCALE	MADE	ED
AS NOTED	DAR	7
		7
		11/22/66
		C-16371-4