

FORM U-1 MANUFACTURER'S DATA REPORT FOR UNFIRED #104061 PRESSURE VESSELS E-412-2

As Required by the Provisions of the ASME Code Rules

1. Manufactured by **STRUTHERS WELLS GULFPORT, INC., Gulfport, Mississippi 94-0223**
(Name and address of Manufacturer)
2. Manufactured for **HERCULES, INC. WILMINGTON, DEL. P.O. 336-026-01090-11000-FCO Eqp. #412-2**
(Name and address of Purchaser)
3. Type **VERT.** Kind **HEAT EXCH.** Vessel No. **4-6223** (Mfr's Serial) (State & State No.) Nat'l Bd. No. **516** Yr. Built **1967**

Items 4-9 incl. to be completed for single wall vessels such as air tanks, jackets of jacketed vessels, or shells of heat exchangers.

4. Shell: Material **SA-285-C** T. S. **55,000** Nominal **7/16** Corrosion **1/16** Thickness **5-7/8** in. Allowance **8-3/16** in. Diam. **3** ft. Length **15** ft. in.
(Kind and Spec. No.) (Fig. or P. B. & lowest T. S.)
5. Seams: Longitudinal **WELDED** H. T. **NO** X. R. **SPOT** Sectioned **NO** Efficiency **85** %
(Welded, Dbl., Single, Lap, Butt) (Yes or No) (Spot or Complete) (Yes or No)
Girth **SING. LAP WELD** H. T. **NO** X. R. **SPOT** Sectioned **NO** No. of Courses **3**

If riveted describe seams fully on reverse side of form.

6. Heads: (a) Material **T. S.** (b) Material **T. S.**
(Top, bottom, ends) Thickness Crown Radius Knuckle Radius Elliptical Ratio Conical Apex angle Hemispherical Radius Flat Diameter Side to Pressure (Convex or Concave)
(a) **ENDS - SEE TUBE SHEETS**
(b)

If removable, bolts used **Other fastening**
(Material, Spec. No., T. S., Size, Number) (Describe or Attach Sketch)
7. Staybolts: **If hollow** Attachment **Pitch** **X** Diam. **Diam.**
(Material) (Size of Hole) (Threaded, Welded) (Moris) (Vert.) (Nominal)

8. Jacket Closure: (Describe as edges & weld, bar, etc. If bar, give dimensions. If bolted, describe or sketch.)

9. Constructed for **Int.** pressure of **200** psi. Max. Temp. **600** °F. Subzero **°F.** Hydrostatic Test **300** psi.

Items 10 and 11 to be completed for tube sections.

10. Tube Sheets: Stationary. Material **SA-249** Diam. **42** in. Thickness **2** in. Attachment **WELDED**
(Kind & Spec. No.) (Subject to Pressure) (Welded, Bolted)
Floating. Material **SA-249** Diam. **42** in. Thickness **2** in. Attachment **WELDED**

11. Tubes: Material **TP-316** O. D. **1** in. Thickness **16** inches or gage. Number **500** Type **STRAIGHT**
(Kind & Spec. No.) (Straight or U)

Items 12-15 incl. to be completed for inner chambers of jacketed vessels, or channels of heat exchangers.

2-EACH **SA-240** T. S. **75,000** Nominal **1** Corrosion **1/16** Thickness **1** in. Allowance **1** in. Diam. **3** ft. Length **5** ft. 2-in.
(Kind and Spec. No.) (Fig. or P. B. & lowest T. S.)

12. Shell: Material **TP-316** T. S. **75,000** Nominal **1** Corrosion **1/16** Thickness **1** in. Allowance **1** in. Diam. **3** ft. Length **5** ft. 2-in.
(Kind and Spec. No.) (Fig. or P. B. & lowest T. S.)
13. Seams: Longitudinal **SING. BUTT WELD** H. T. **NO** X. R. **SPOT** Sectioned **NO** Efficiency **85** %
(Welded, Dbl., Single, Lap, Butt) (Yes or No) (Spot or Complete) (Yes or No)
Girth **SING. LAP WELD** H. T. **NO** X. R. **NO** Sectioned **NO** No. of Courses **1 EA.**

If riveted describe seams fully on reverse side of form.

14. Heads: (a) Material **T. S.** (b) Material **T. S.** (c) Material **T. S.**
(Top, bottom, ends) Thickness Crown Radius Knuckle Radius Elliptical Ratio Conical Apex angle Hemispherical Radius Flat Diameter Side to Pressure (Convex or Concave)

(a) Top, bottom, ends **COVER SIDE FLG'D.** SA-105-11 2-15/16" THK. x 46" O.D. x 41-5/8" I.D. WITH

(b) Channel **TP-316 T & B RING 3/8" THK.**

(c) Floating **2 1/2" FBX SA-212-B WITH 1/2" THK. LINER TP-316 S.S.**

TOP & BOTTOM COVERS (a) **(48) 3/4" x 7-7/8" STUDS SA-193-B7** (b) **(48) 3/4" x 7-7/8" STUDS SA-193-B7**

If removable, bolts used (a) **(48) 3/4" x 7-7/8" STUDS SA-193-B7** (b) **(48) 3/4" x 7-7/8" STUDS SA-193-B7**

(c) **W/2-HEX NUTS EA. SA-194-2H** Other fastening (Describe or Attach Sketch)

15. Constructed for **Int.** pressure of **50** psi. Max. Temp. **500** °F. Subzero **°F.** Hydrostatic Test **75** psi.

Items below to be completed for all vessels where applicable.

16. Safety Valve Outlets: Number **2** Size **2** Location **Top**

17. Nozzles:
Purpose (Inlet, Outlet, Drain) Number Diam. or Size Type Material Thickness Reinforcement Material How Attached
1-EA. SHELL INLET **2** **8"-300# RFSP** **FLG.** **SA-181-1** **SA-285-C** **WELDED**
& OUTLET **8" X-HVY (1,500) PIPE** **SA-106-B** **WELDED**

18. Inspection Manholes, No. **2** Size **24"** Location **Top**

Openings: Handholes, No. **2** Size **24"** Location **Top**

Threaded, No. **2** Size **24"** Location **Top**

19. Supports: Skirt **NO** Lugs **2** Legs **2** Other **Attached WELDED TO SHELL**
(Yes or No) (Number) (Number) (Describe) (Where & How)

20. Remarks: *** SHELL INCLUDES TP-304 S.S. BELLOW EXPANSION JOINT.**

**** TP-316 S.S. CLAD ON FBX SA-212-B BACKING (THK. INCLUDES 3/8" THK. CLAD)**

(Brief description of purpose of the vessel, as Air Tank, After Cooler, Jacketed Cooler, etc. State contents of each part.)
(Over)

Form No. 314 PURE DMT STILL REBOILER
FLUID SHELL SIDE - 15" STEAM FLUID TUBESIDE - "C" HOTTER LIQUOR

1 EA. SHELL	2	3/4" 3000# COUPL.	SA-103	WELDED
VENT & DRAIN				
CHAN. INLET	1	10"-150# LAP JT. FLG.	SA-181-1	
		T & B RING 3/8" THK.	SA-240-316	WELDED
		10" SCH. 10 (.165") PIPE	SA-312-316	WELDED
CHAN. OUTLET	1	24"-150# LAP JT. FLG.	SA-181-1	
		T & B RING 3/8" THK.	SA-240-316	WELDED
		24" SCH. 10 (.250") PIPE	SA-240-316	WELDED
CHAN. VENT	1	1"-150# R.F.W.N. FLG.	SA-182-F-316	WELDED
		1" SCH. 40 (.133") PIPE	SA-312-316	WELDED
CHAN. DRAIN	1	2"-150# R.F.W.N. FLG.	SA-182-F-316	WELDED
		2" SCH. 40 (.154") PIPE	SA-182-F-316	WELDED
CHAN. SPARE	2	3/4" 3000# COUPLING	SA-182-F-316	WELDED
CONN.				


We certify that the statements made in this report are correct and that all details of design, material, construction, and workmanship of this unfired pressure vessel conform to the ASME Code for Unfired Pressure Vessels.

Date 9-26-1967 Signed Struthers Wells Gulfport, Inc. By Edwin M. Miller
(Manufacturer)

Certificate of Authorization Expires December 31st 1978
(7847)

CERTIFICATE OF SHOP INSPECTION	
VESSEL MADE BY	STRUTHERS WELLS GULFPORT, INC. at Gulfport, Mississippi
I, the undersigned, holding a valid commission issued by the National Board of Boiler and Pressure Vessel Inspectors and/or the State of _____ and employed by HARTFORD STEAM BOILER INSP. & INS. CO. of HARTFORD, CONN., have inspected the pressure vessel described in this manufacturer's data report on 1967 and state that to the best of my knowledge and belief, the manufacturer has constructed this pressure vessel in accordance with the applicable sections of the ASME Boiler and Pressure Vessel Code.	
By signing this certificate neither the Inspector nor his employer makes any warranty, expressed or implied, concerning the pressure vessel described in this manufacturer's data report. Furthermore, neither the Inspector nor his employer shall be liable in any manner for any personal injury or property damage or a loss of any kind arising from or connected with this inspection.	
Date 9-26-1967	Inspector's Signature <u>P. Derrall</u> Commissions NB#907 Nat'l Board or State and No.

CERTIFICATE OF FIELD ASSEMBLY INSPECTION	
I, the undersigned, holding a valid commission issued by the National Board of Boiler and Pressure Vessel Inspectors and/or the State of _____ and employed by _____ have compared the statements in this manufacturer's data report with the described pressure vessel and state that parts referred to as data items _____ not included in the certificate of shop inspection have been inspected by me and that to the best of my knowledge and belief the manufacturer has constructed and assembled this pressure vessel in accordance with the applicable sections of the ASME Boiler and Pressure Vessel Code. The described vessel was inspected and subjected to a hydrostatic test of _____ psi.	
By signing this certificate neither the Inspector nor his employer makes any warranty, expressed or implied, concerning the pressure vessel described in this manufacturer's data report. Furthermore, neither the Inspector nor his employer shall be liable in any manner for any personal injury or property damage or a loss of any kind arising from or connected with this inspection.	
Date _____ 19 _____	Inspector's Signature _____ Commissions _____ Nat'l Board or State and No.

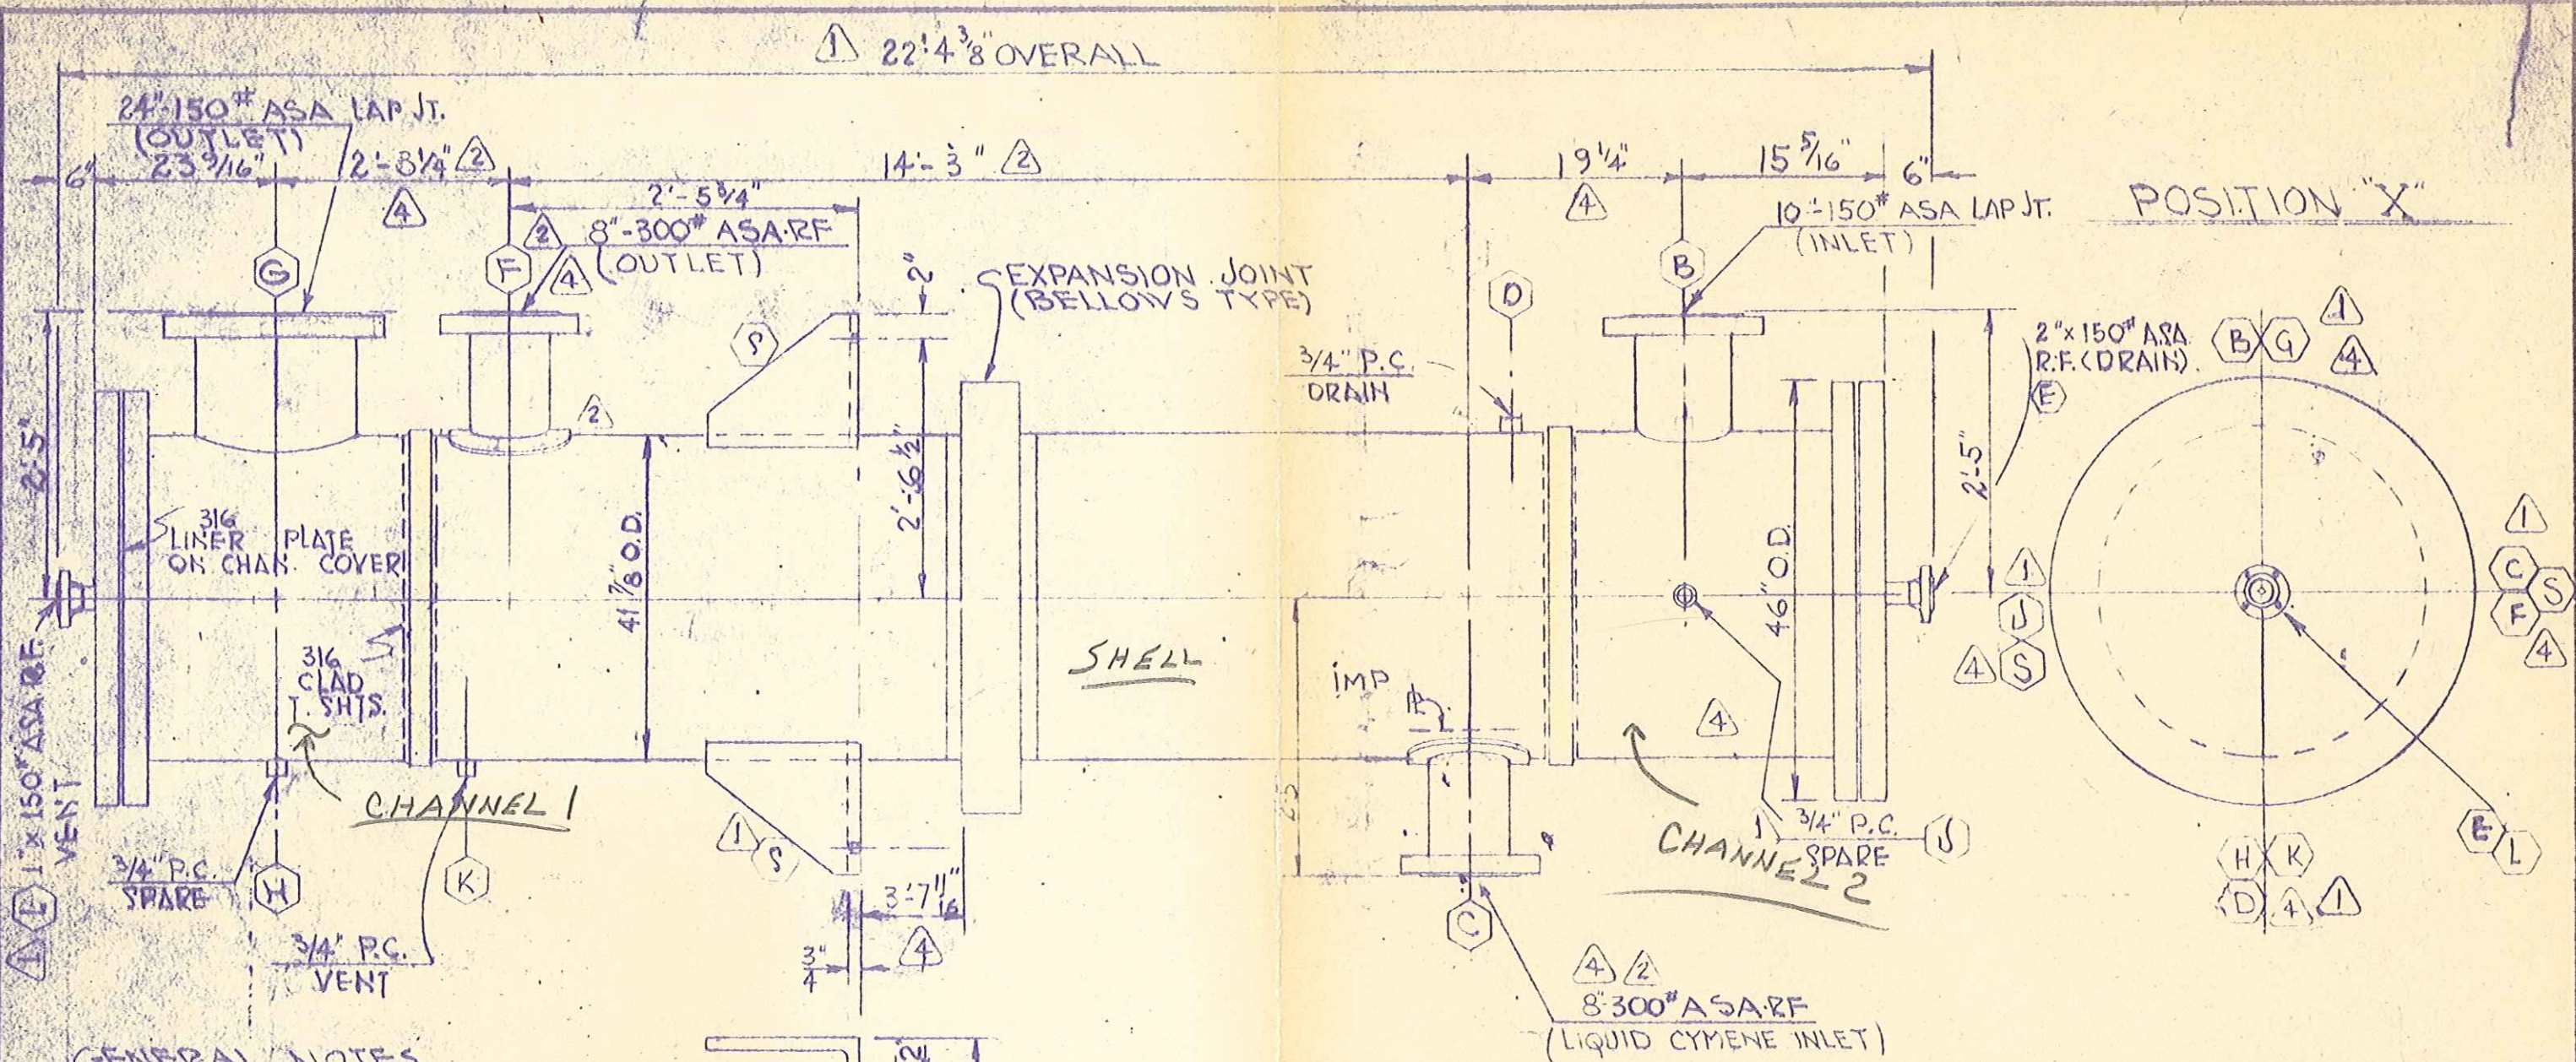

GENERAL NOTES

ALL NOZZ BOLT HOLES TO STR. 4's.
ALL P.C. ARE 3000# SCREWED.

DRY WT. = 23000#
FLOODED WT. = 34600#

	SHELL SIDE	TUBE SIDE	
DESIGN PRESS	200#	FULL VAC	② ④
TEST PRESS	300#	75#	② ④
MAX TEMP.	600°F	500°F	② ④
CORR. ALLOW.	1/16 ON G.S.	—	

(2) 3/8" φ HOLES
EA. SUPPT.

HERCULES INC.	
CUST. ORD. NO. 336-026-01090-11-000-FCO	EQUIP. NO. E-412:2
③ PURE DMT STILL REBOILER (ITEM F)	S.W. ORD. NO. 66-94-6223
ONE UNIT REQ'D.	

BOTTOM VIEW

REV. ③ CKD:	REV. ④ CKD: 11/1/27
CHANGED TITLE & EQUIP. NO. PER CUST. BOSKO 4-10-67	REV. PER CUST. MKD. PRINT DTD. 4-18-67 H.R.B. 427-67
REV. ① CKD: 2-8	REV. ② CKD: 2/1/3-15
REV. PER CUST. MKD. PRINT T.C.B. 2-8.	REV. PER CUST. T.C.B. 3-15
SETTING PLAN OF HEAT EXCHANGER 4-16NXII-8V	
DRAWN: H.R.B. 12/15	66-94-6223B1
CHECKED: 12-27	GULFPORT MISS.
APPROVED:	
SCALE: CHD DATE	