




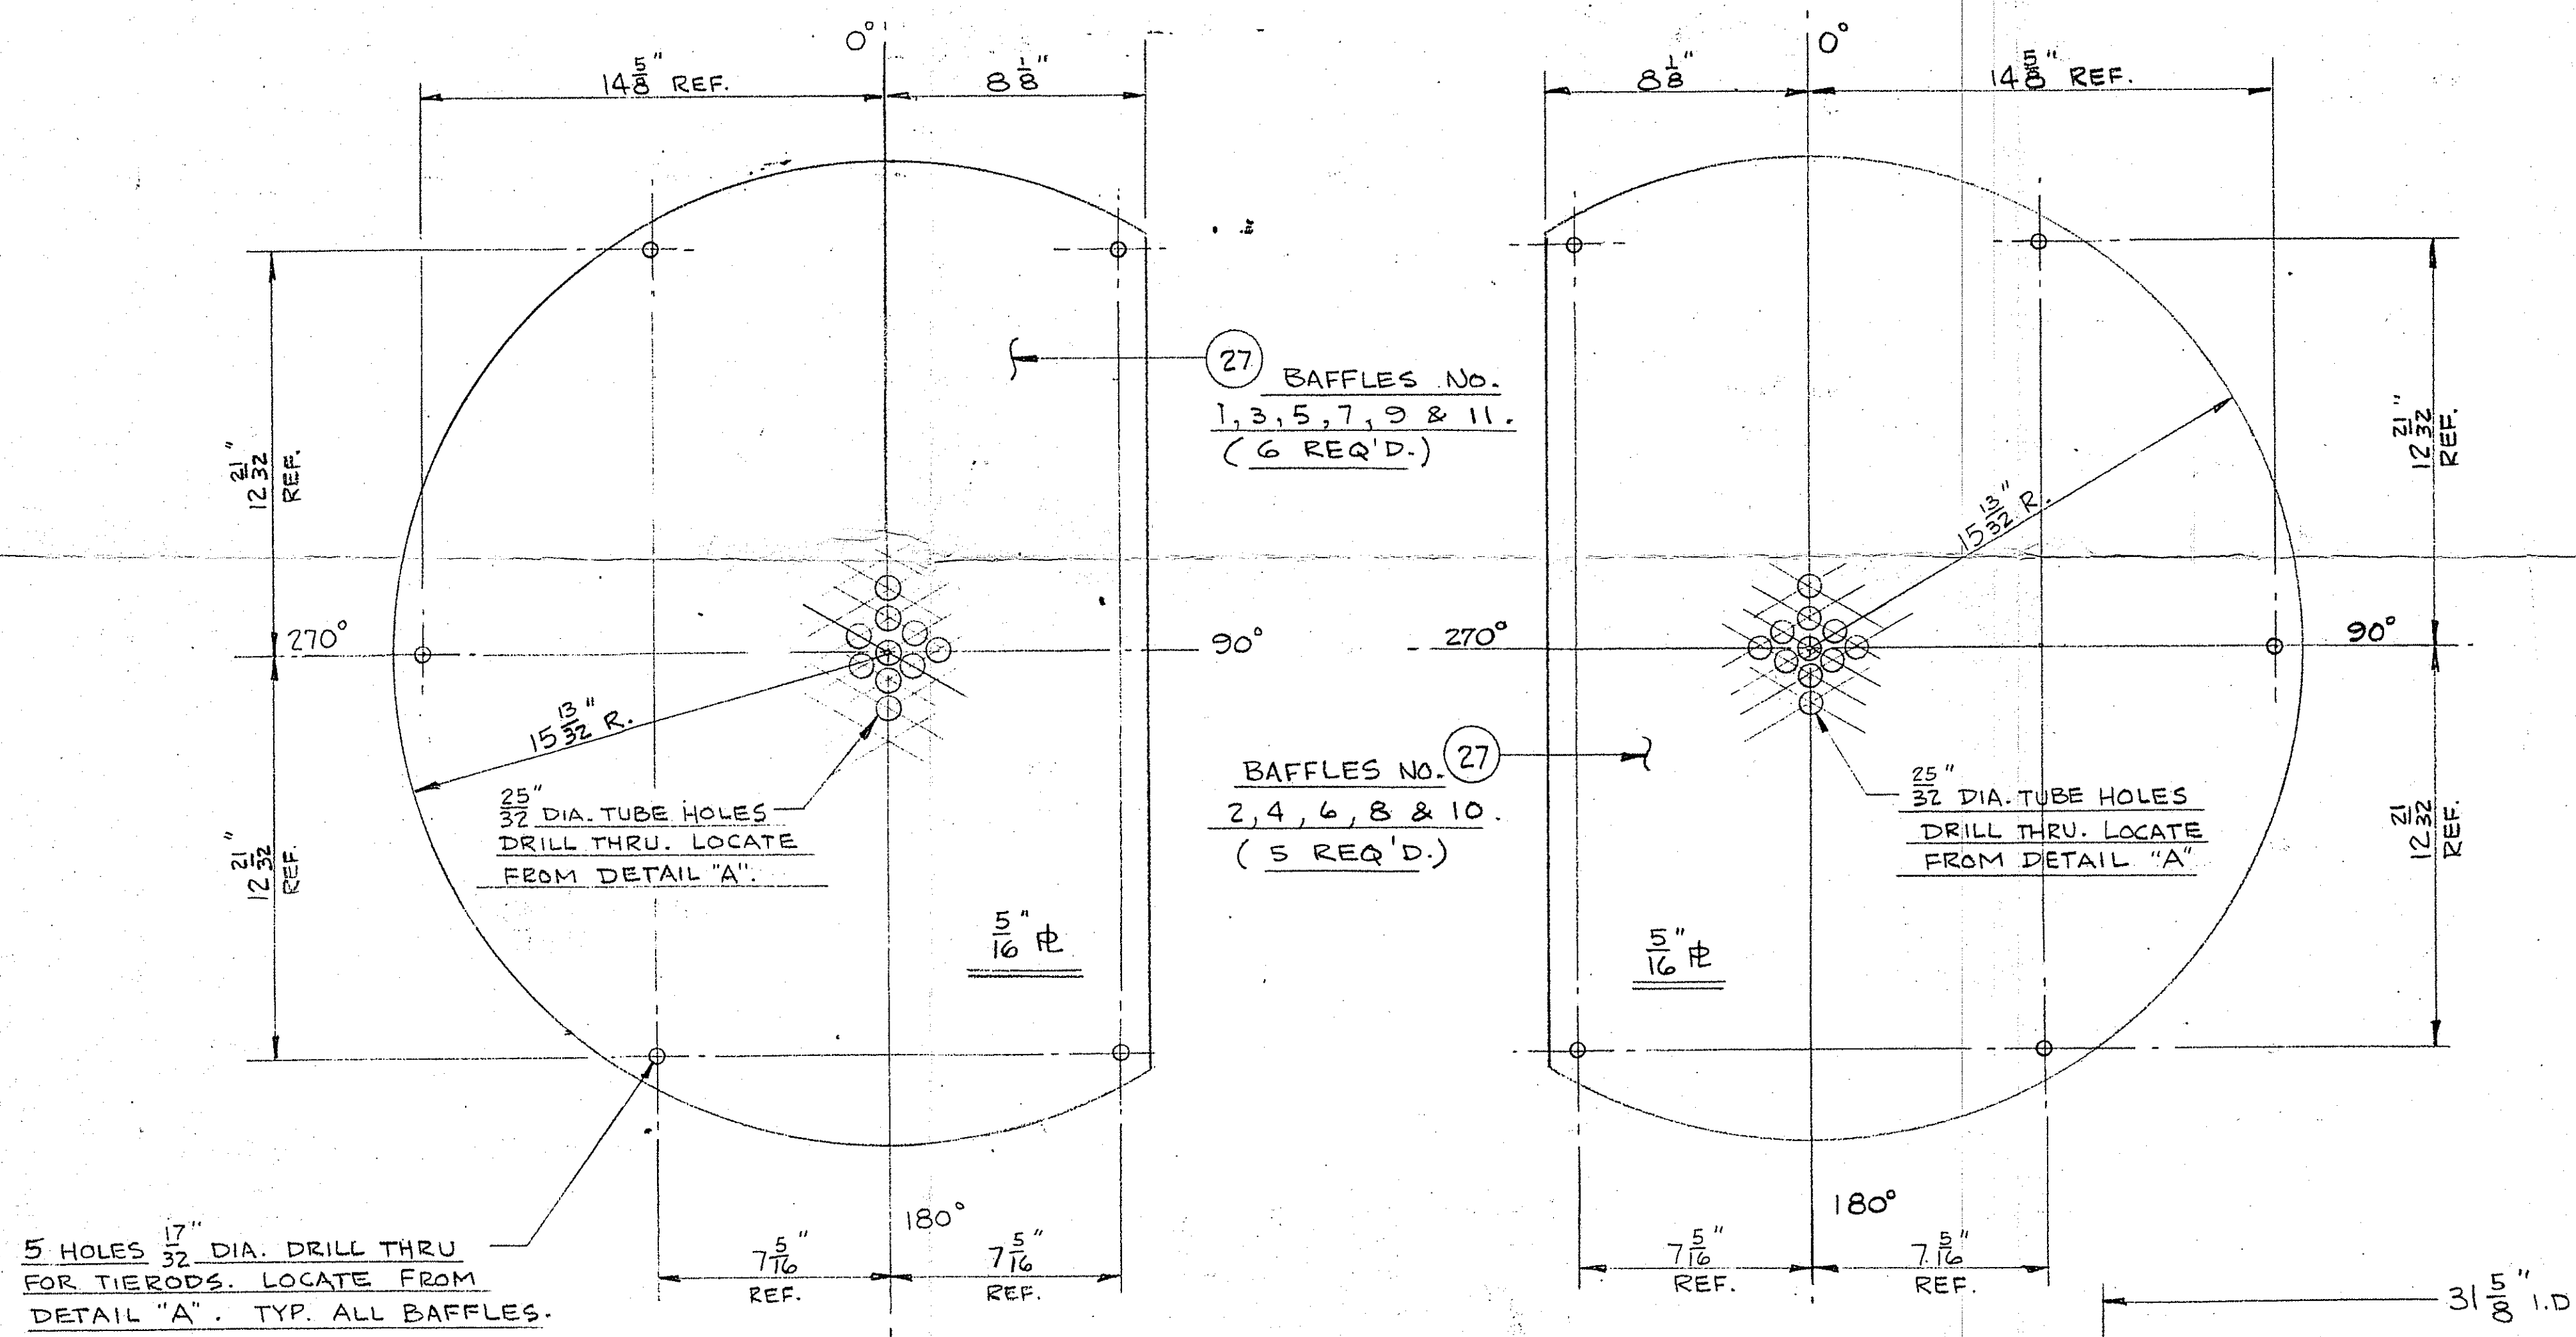


DETAIL "G" BAFFLES
SCALE - 3" = 1 FT.

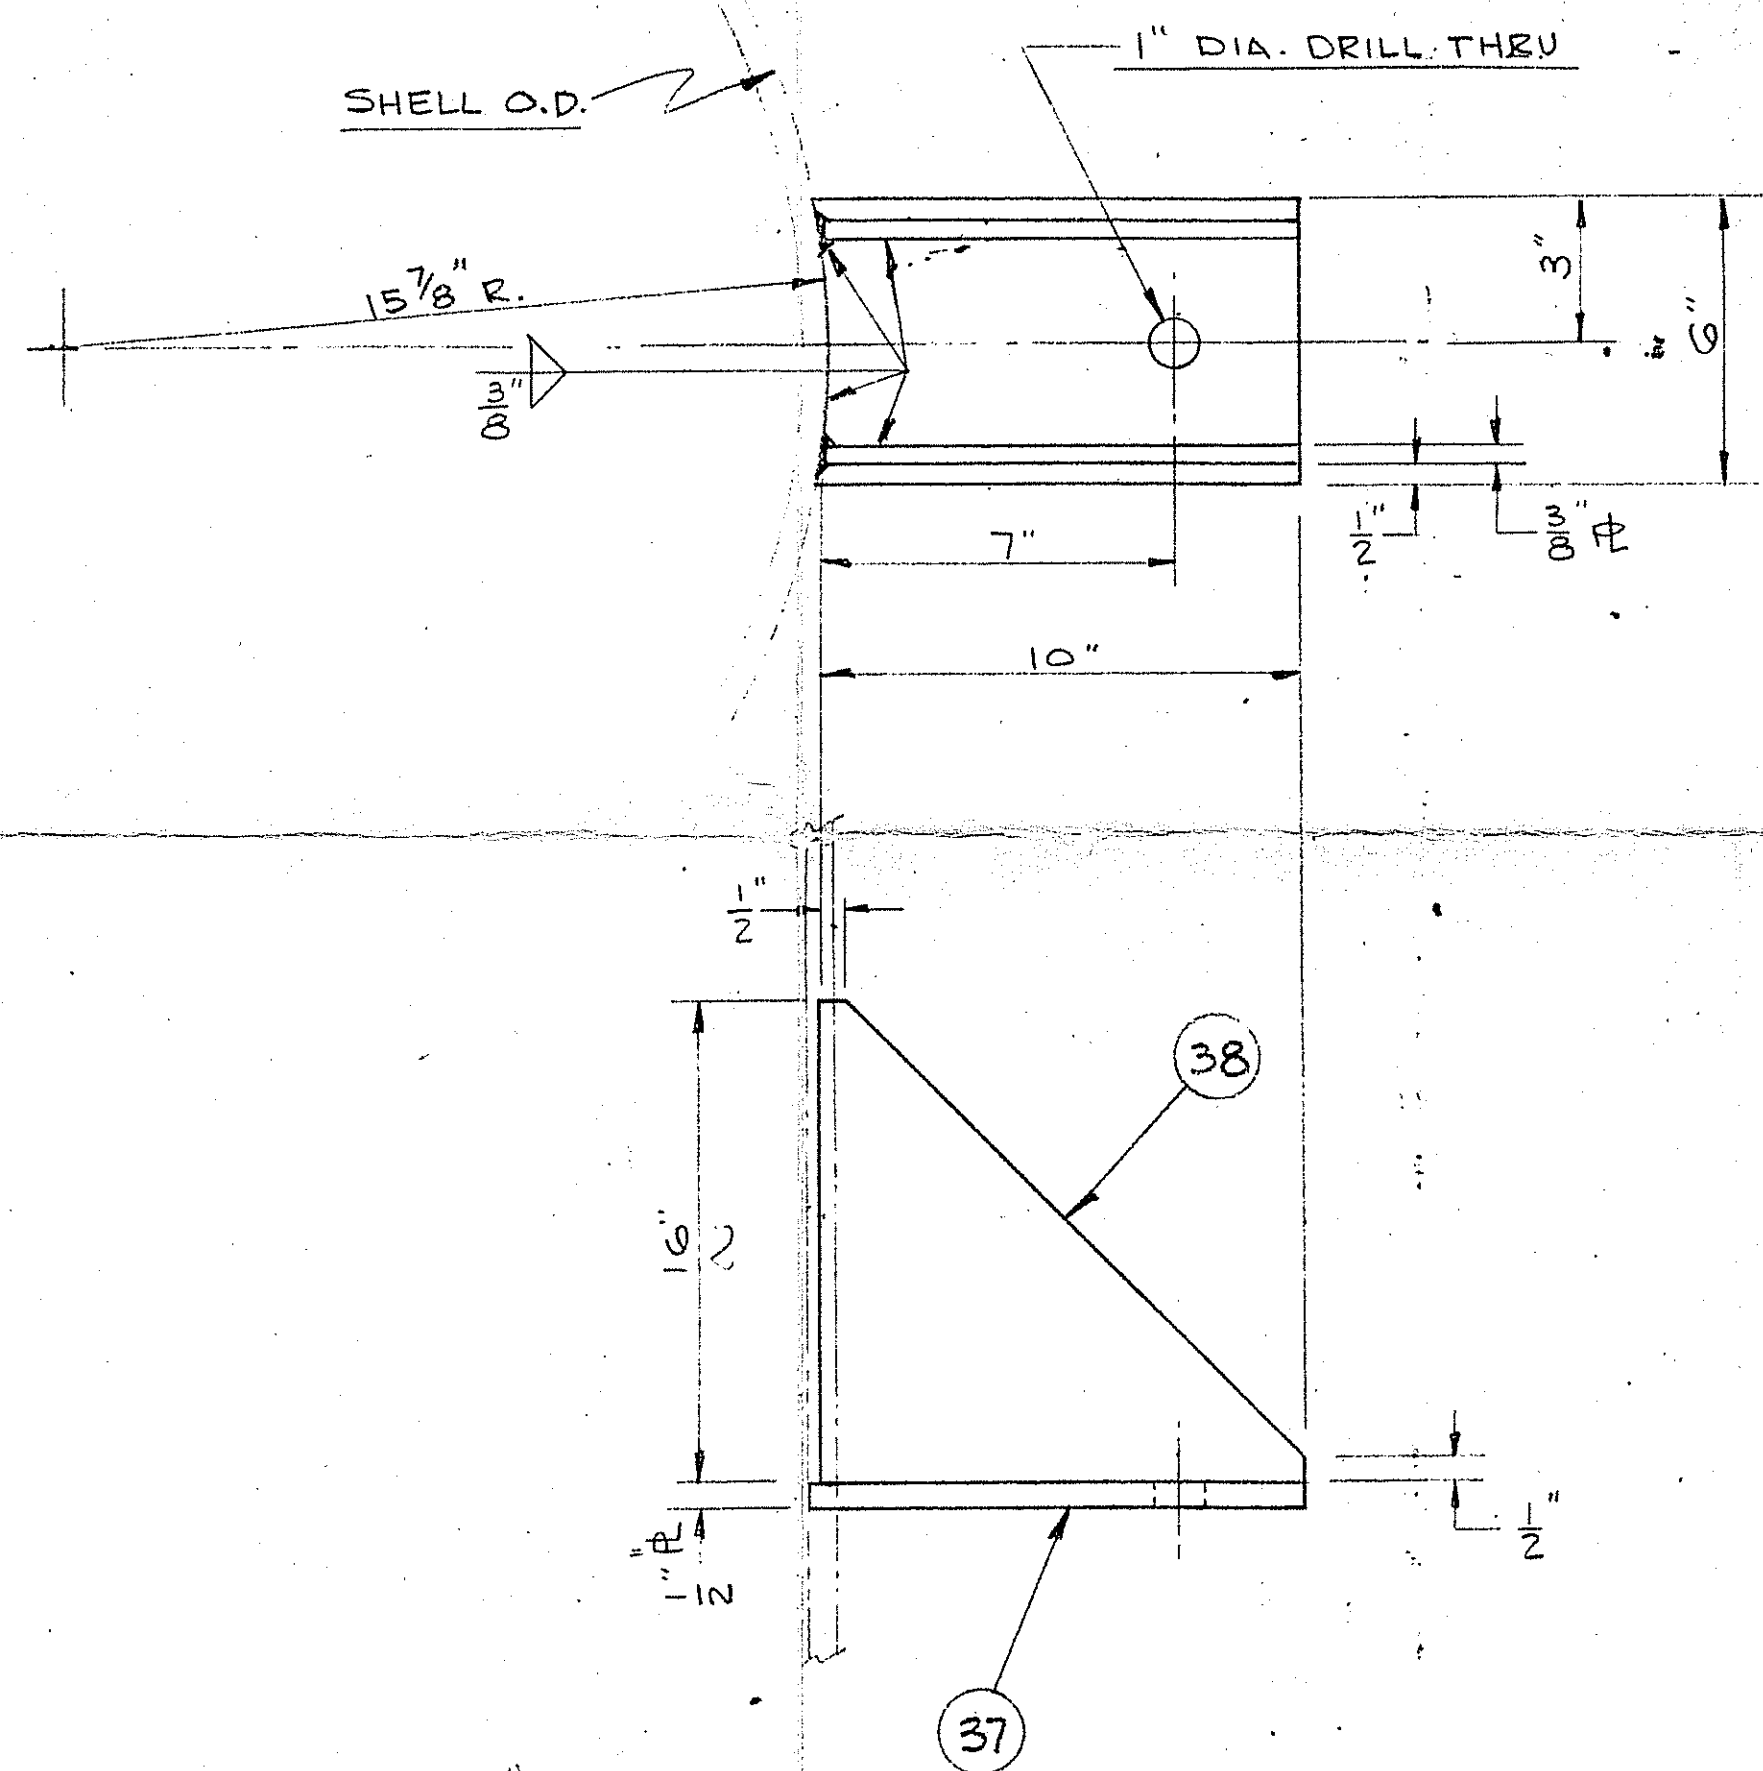


DETAIL "H" MOUNT PAD
SCALE - NONE

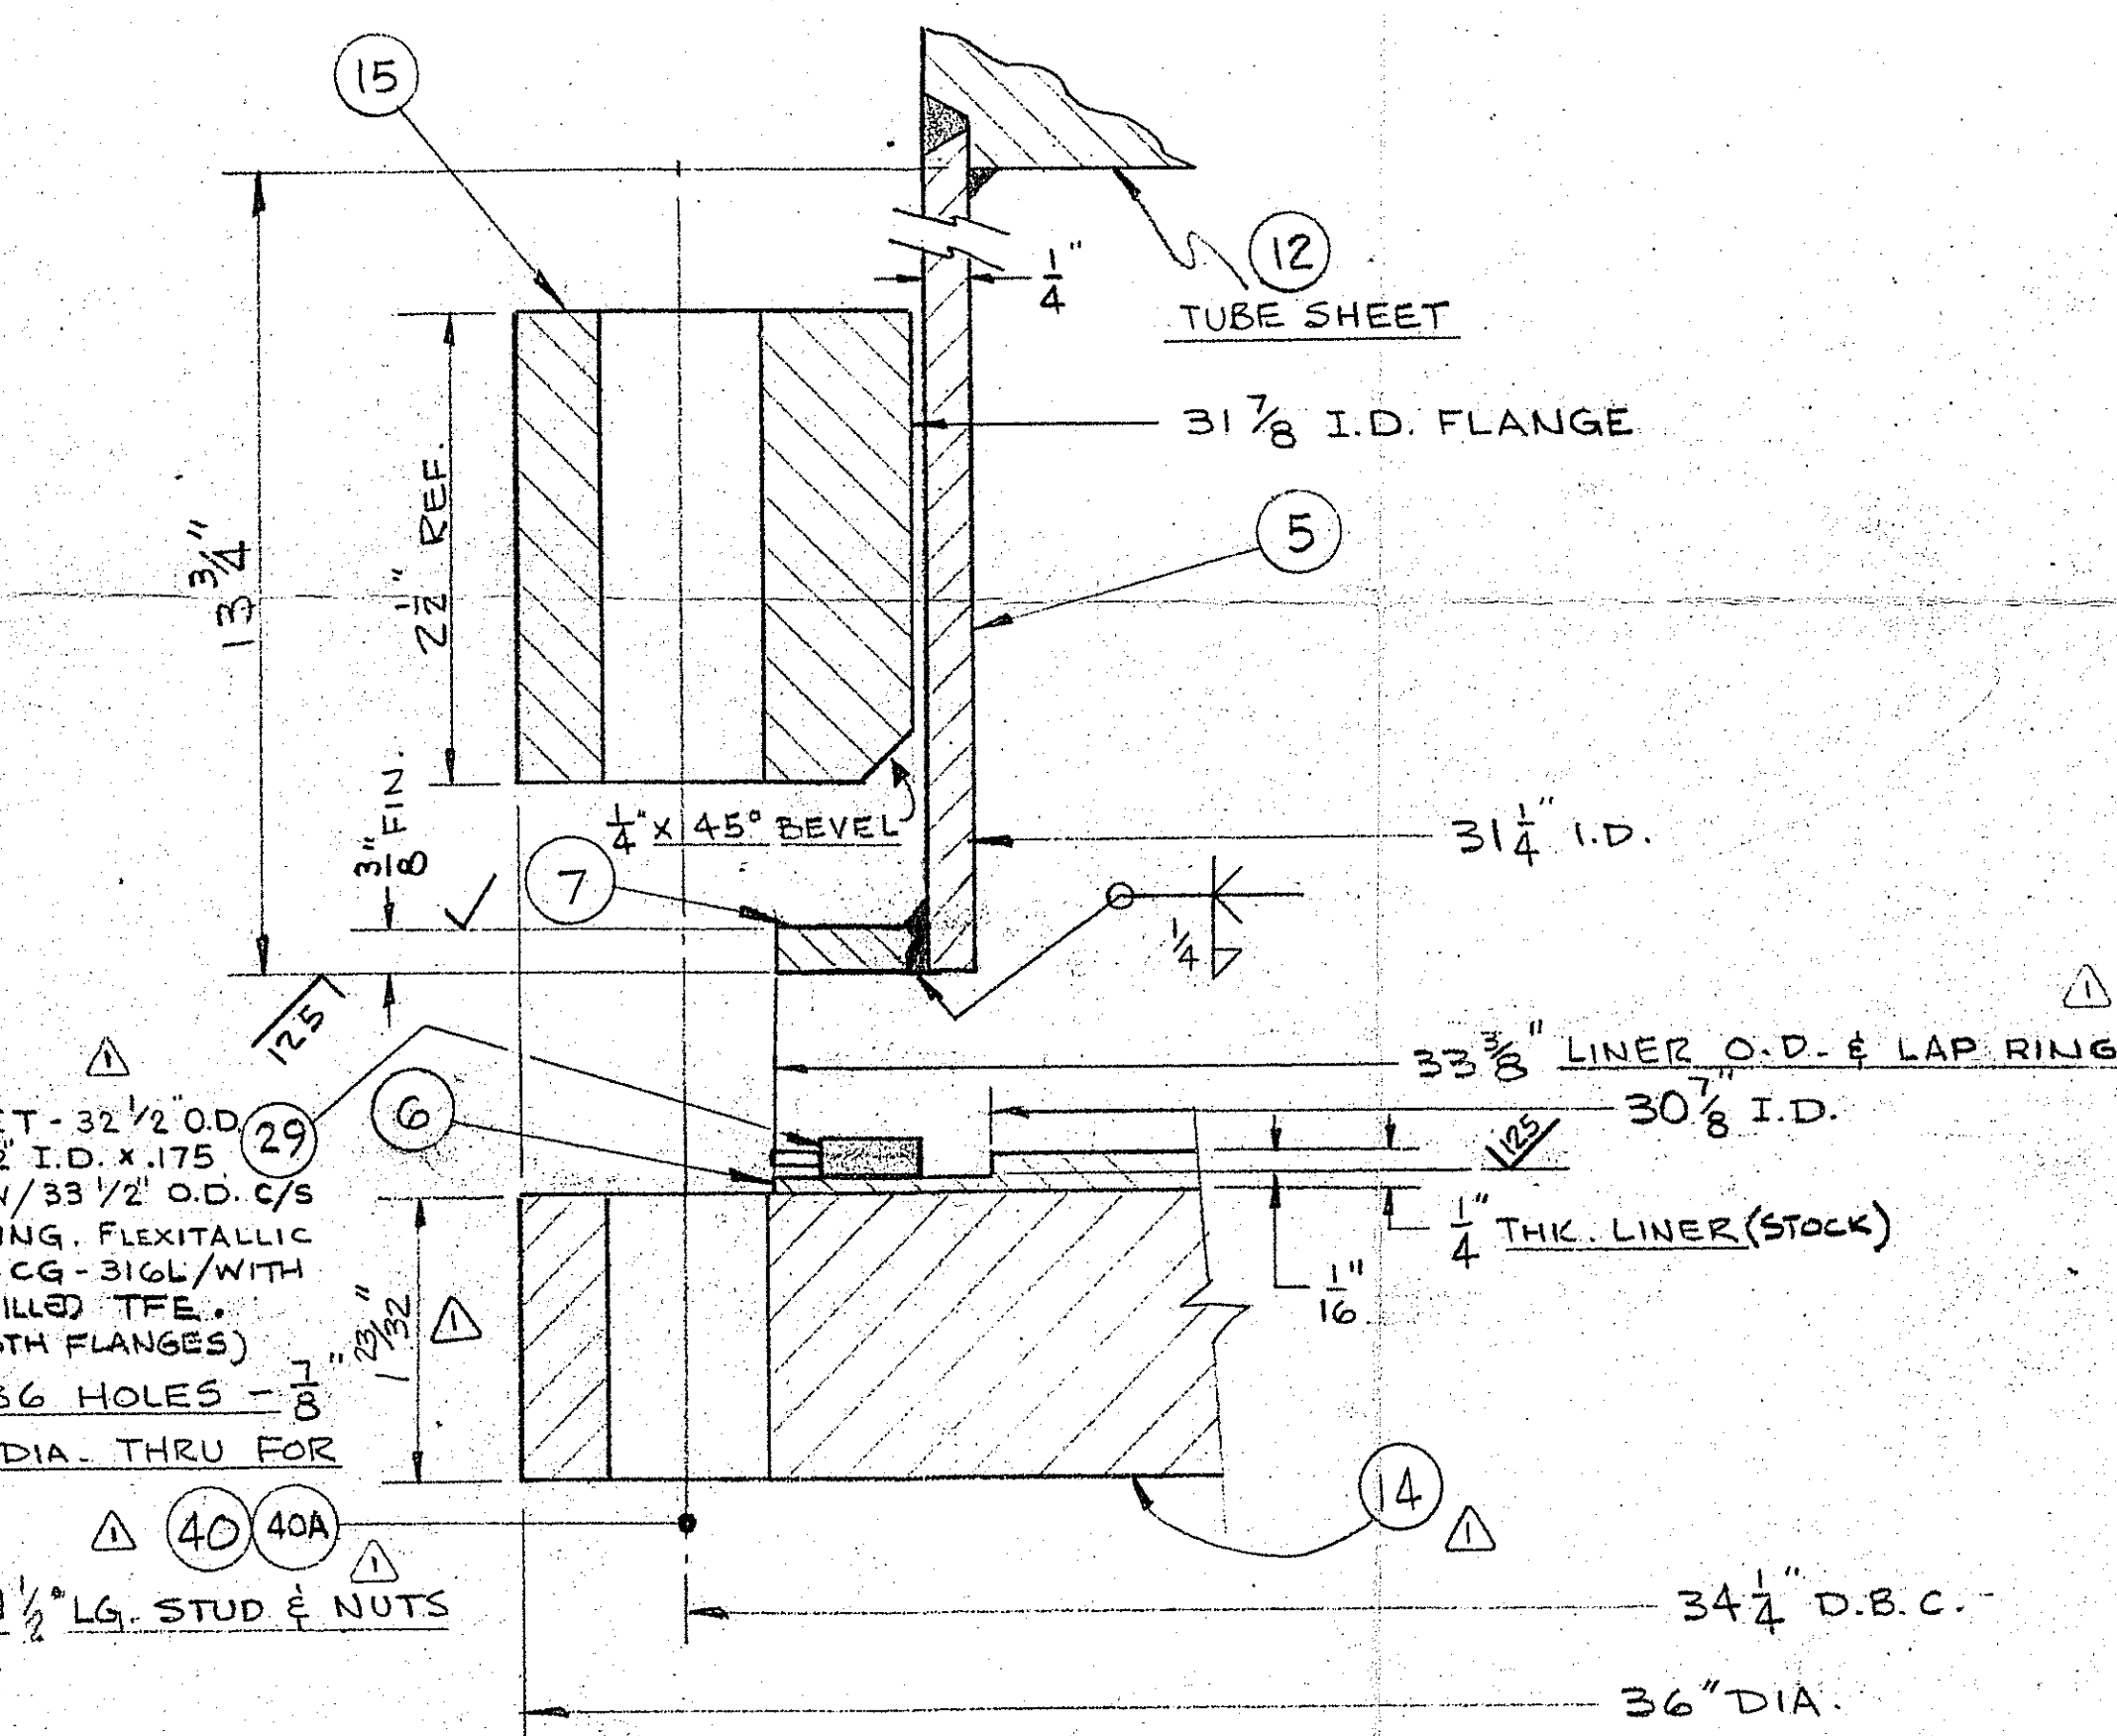

DETAIL "E"
SCALE - NONE

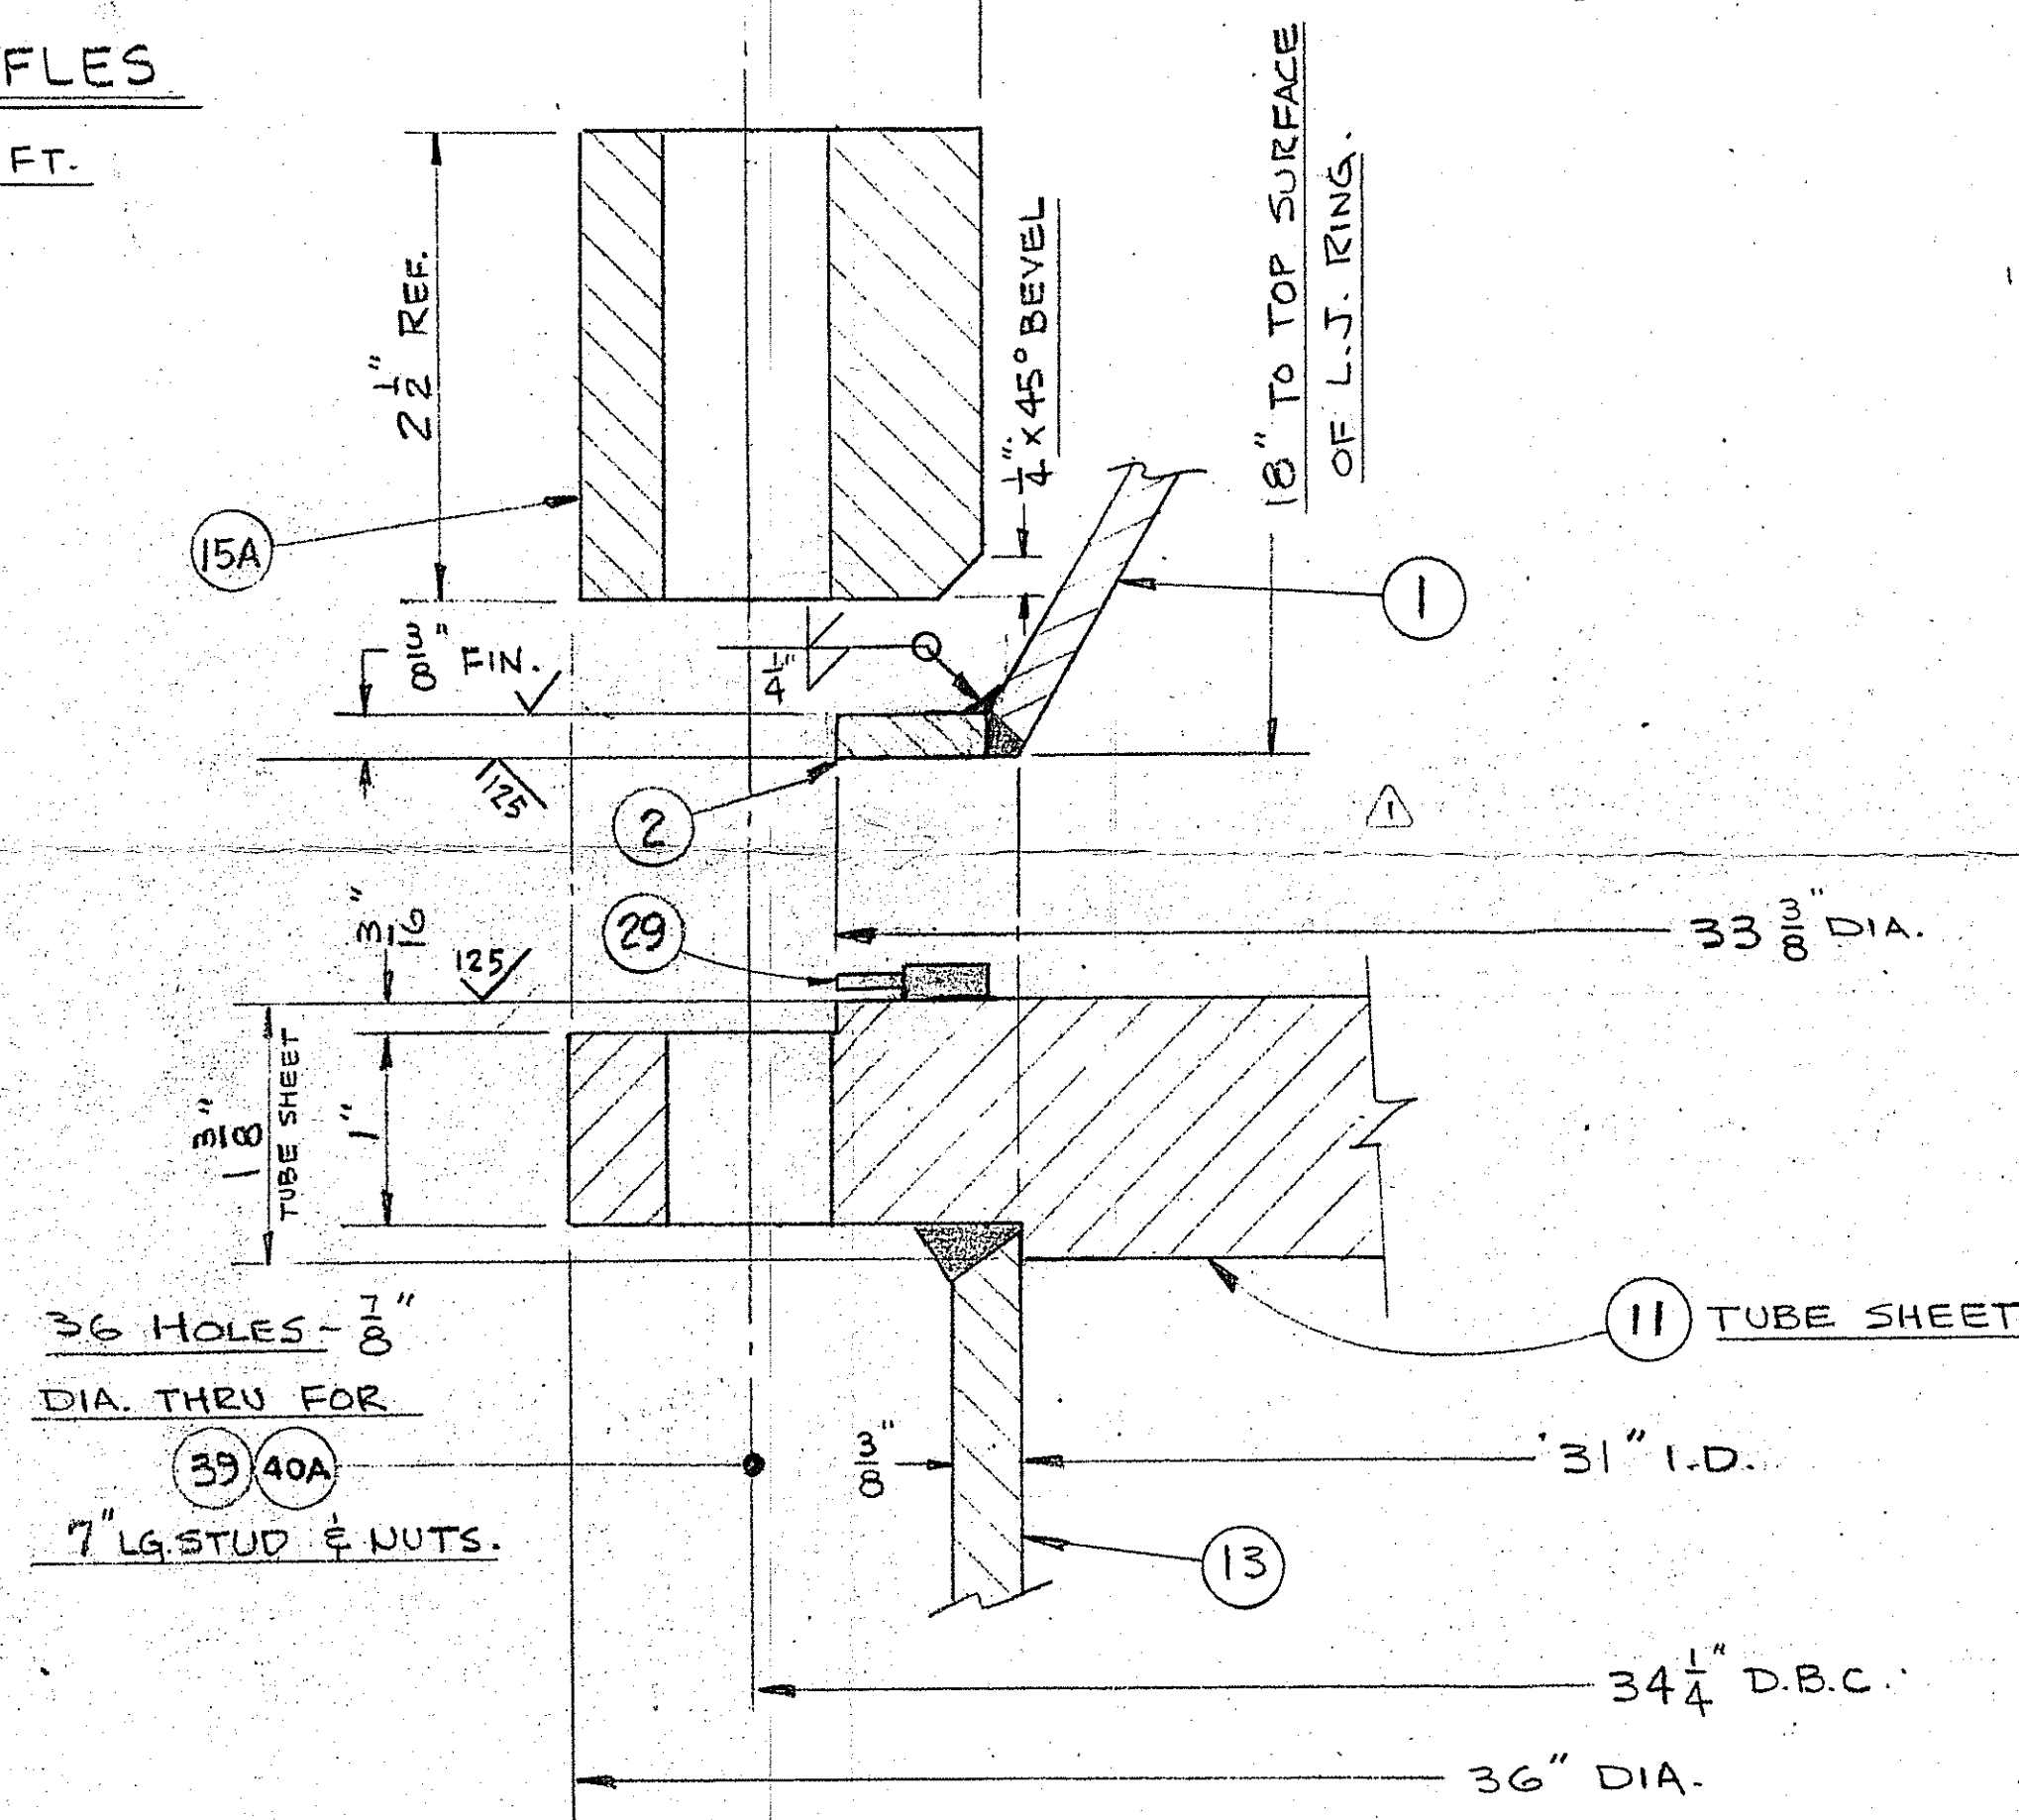

DETAIL "F"
SCALE - NONE

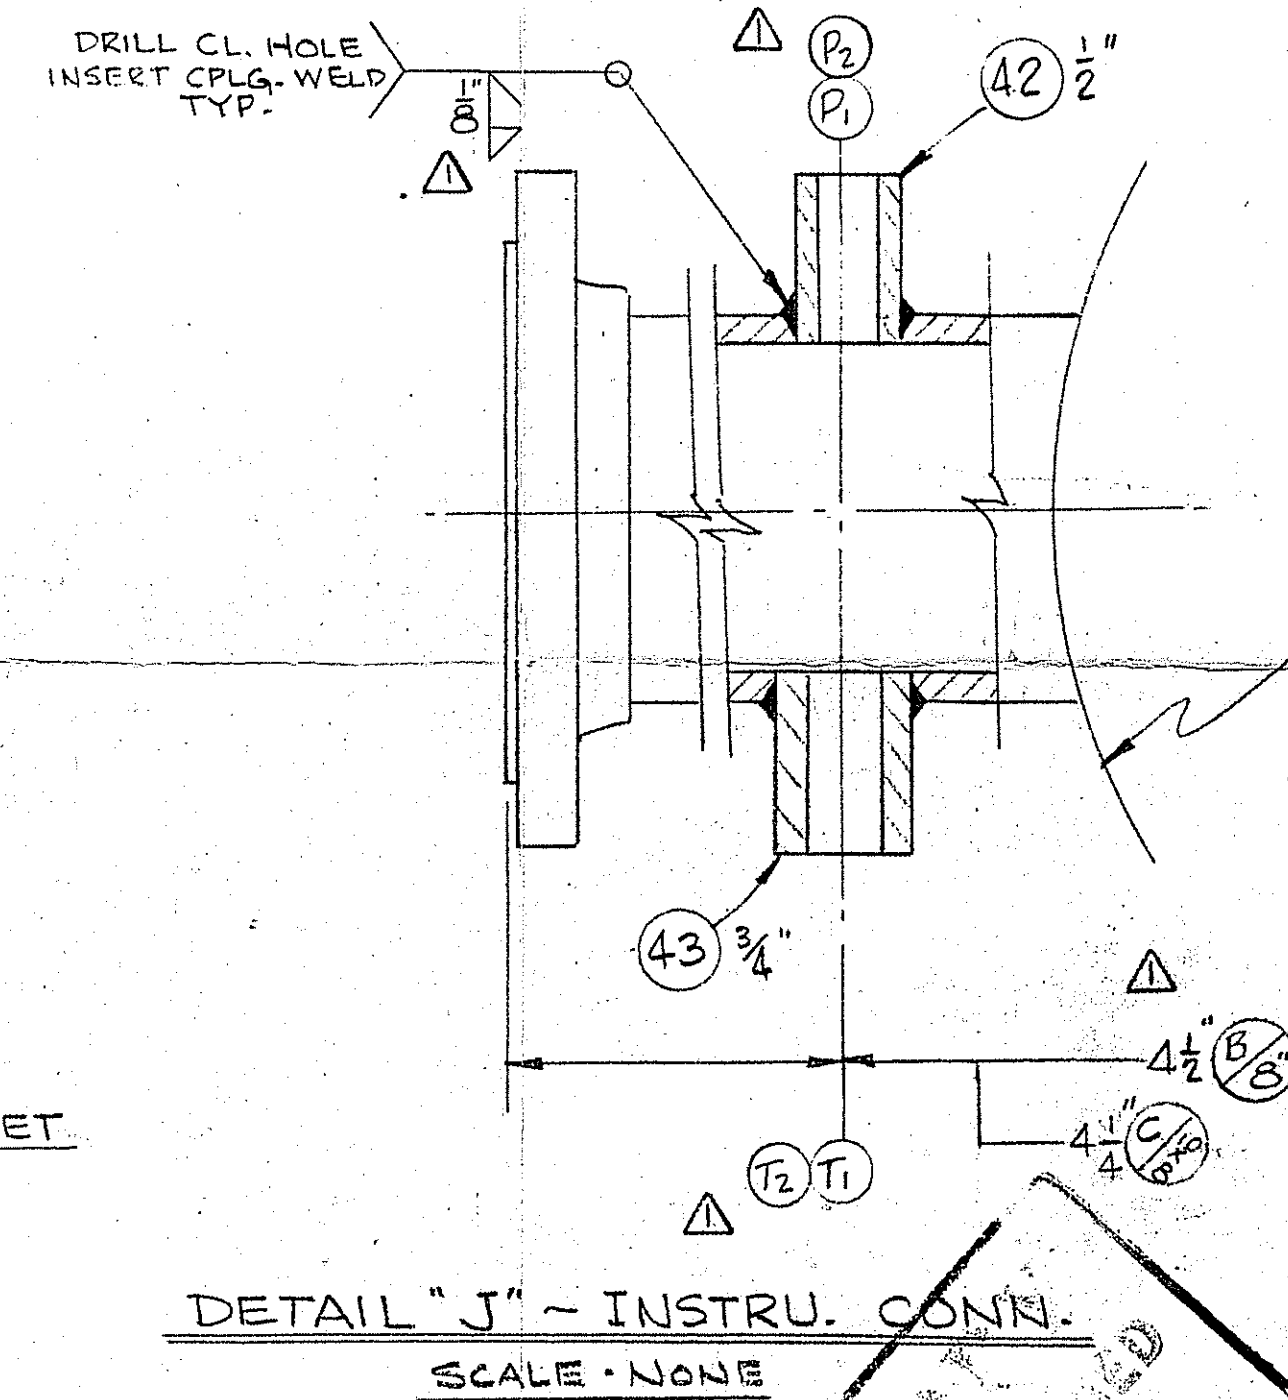

DETAIL "J" - INSTR. CONN.
SCALE - NONE

B.P.F. NO. 42358	DATE 6/14/72
SHEET 3	APPARATUS NO. E-4201-2
PROJECT ACCOUNT NO. 26035	2027
ORDER NO. 33072	26-35066
PLANT APPROVED	HANOVER
APPROVED	J. G. Scholtz

NOTE - ALL CPLG'S. ARE HALF CPLG'S. - 3000# - THD.					
T _{1,2}	3/4"	3000#	CPLG. W/PLUG	THERMOMETER	NPT
P _{1,2}	1/2"	3000#	CPLG. W/PLUG	PRESS. GAUGE	NPT
E	4"	40	L.J.	LIQUID	150#
D	6"	40	L.J.	VENT	150#
C	10x8"	40	SORF	SHELL CON.	150#
B	8"	80	SORF	SHELL CON.	150#
A	20"	1/4"	L.J.	CHANNEL IN	150#
MARK	SIZE	SCH.	FLANGE TYPE	PURPOSE	REMARKS

ISSUED FOR FABRICATION. ADDED P. 1-2 + T. 1-2. DELETED G & F. COMPLETELY REVISED DETAILS E & F. IN DET. H 16" DIA. WAS 10". ADDED DET. J 3-30-72. ISSUED FOR APPROVAL				DATE	REVISION	BY
JOSEPH OAT & SONS, INCORPORATED CHEMICAL ENGINEERS/DESIGNERS/FABRICATORS ESTABLISHED 1960 CAMDEN, NEW JERSEY 08104						
OXIDATE STRIPPER CONDENSER 31 3/4" O.D. X 15-3 3/8" O.A.L. ONE PASS C/S 316 STN. STL. CONSTR. ITEM NO. E-4201-2 DETAILS						
HIBRUCLES INCORPORATED HANOVER PLANT WILMINGTON, N.C.						
PURCHASE ORDER NO. 02G-35066				NO. REQ'D. ONE		
JOB NO. J-2079-2	DRAWN R. Hines	DATE 3-28-72	DRAWING NO. 5241	REV. 1		

#104196