
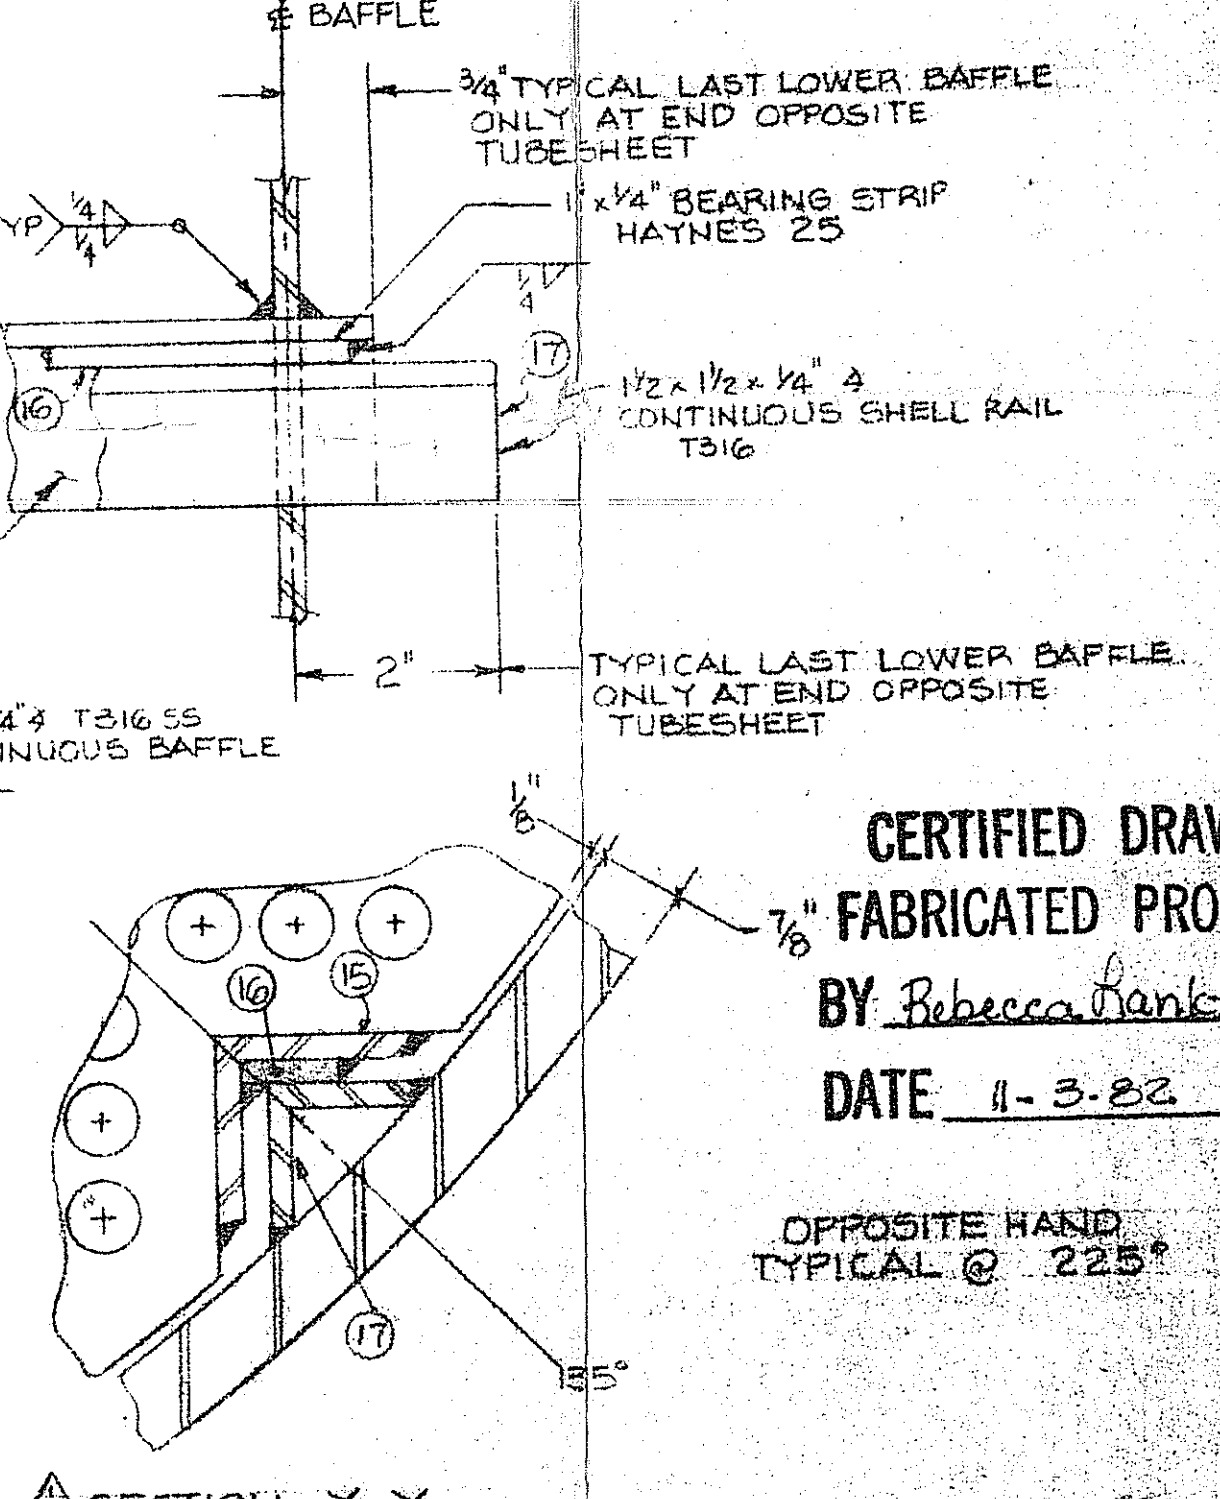
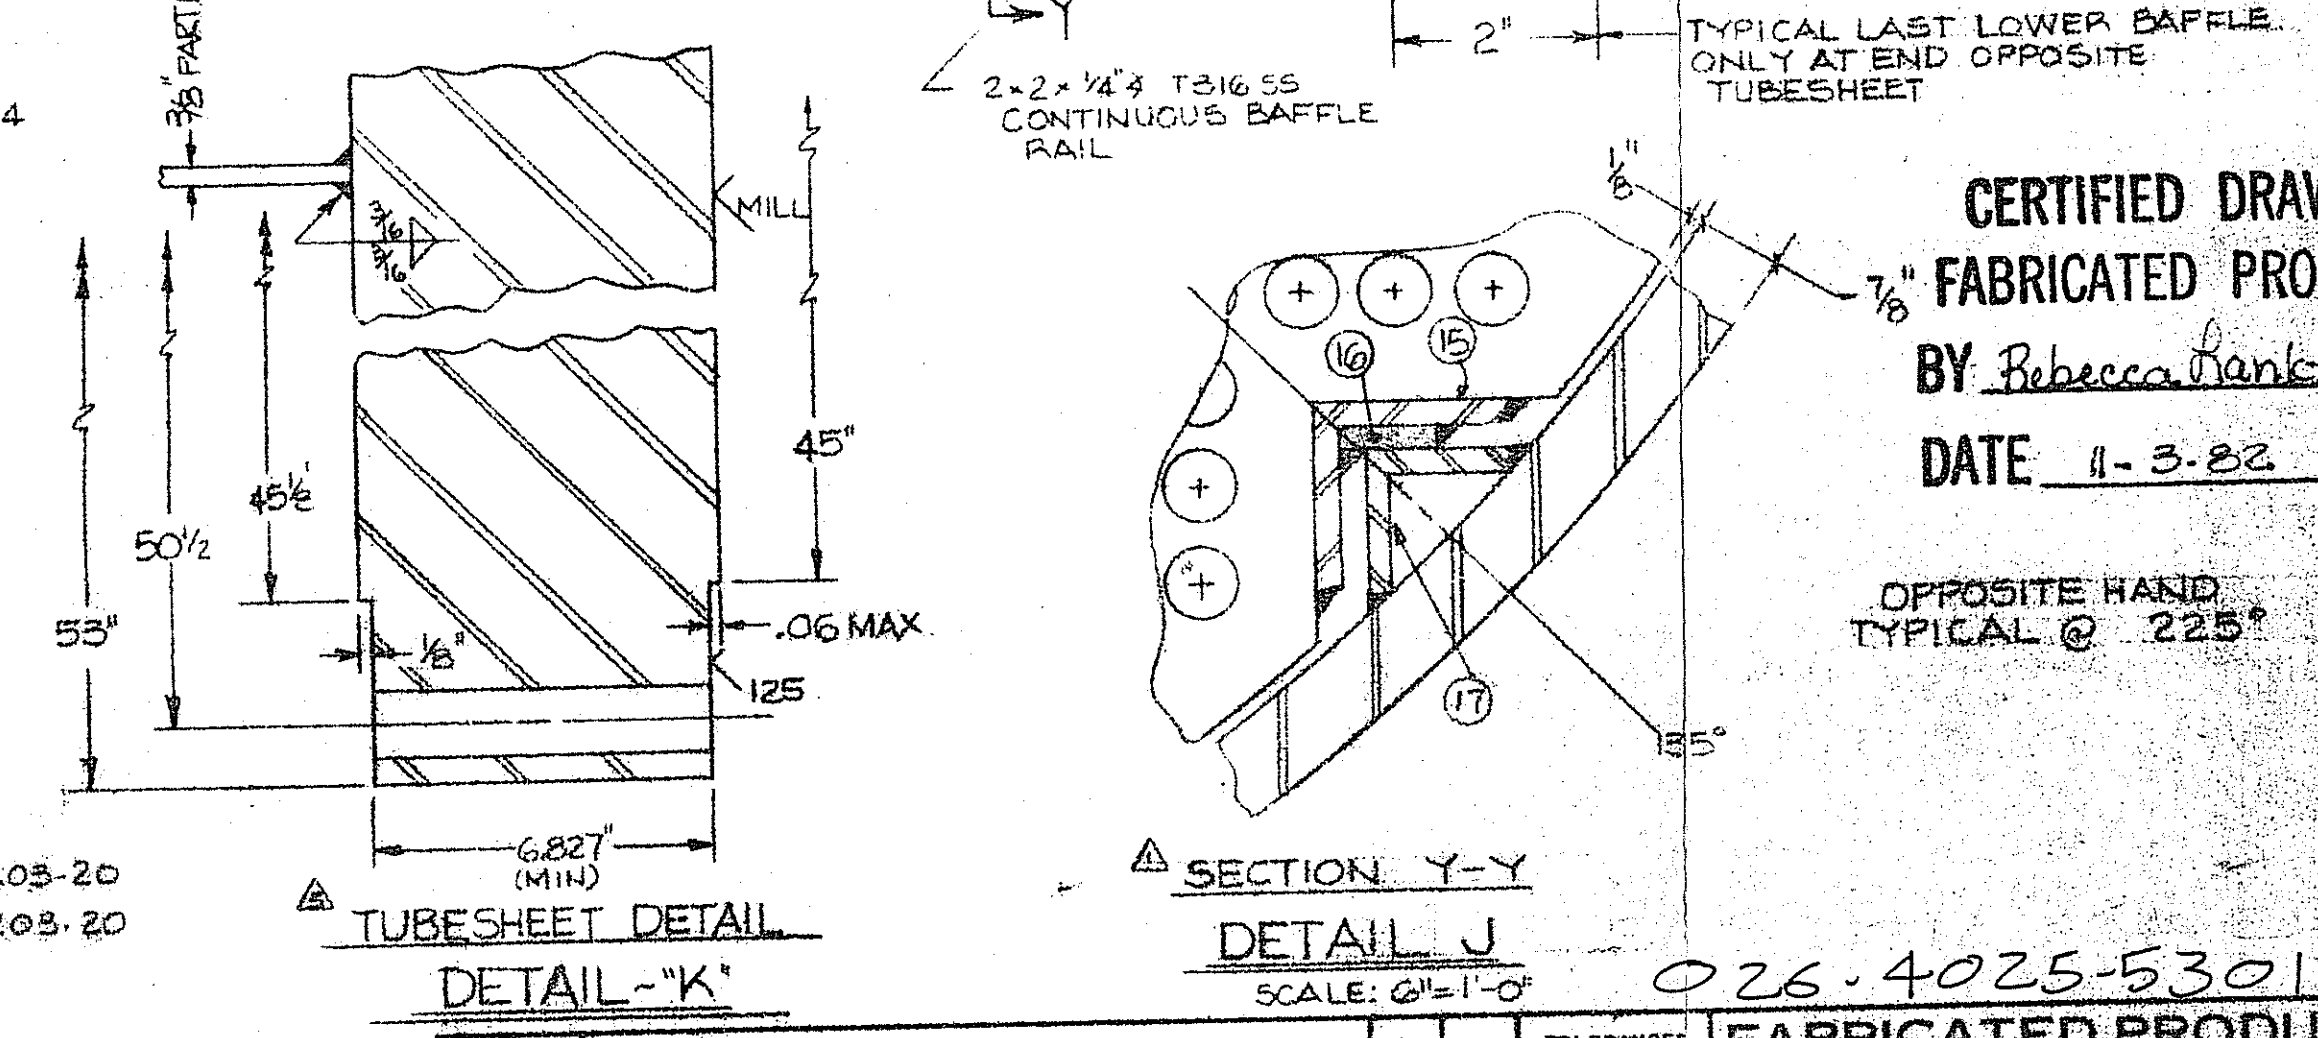
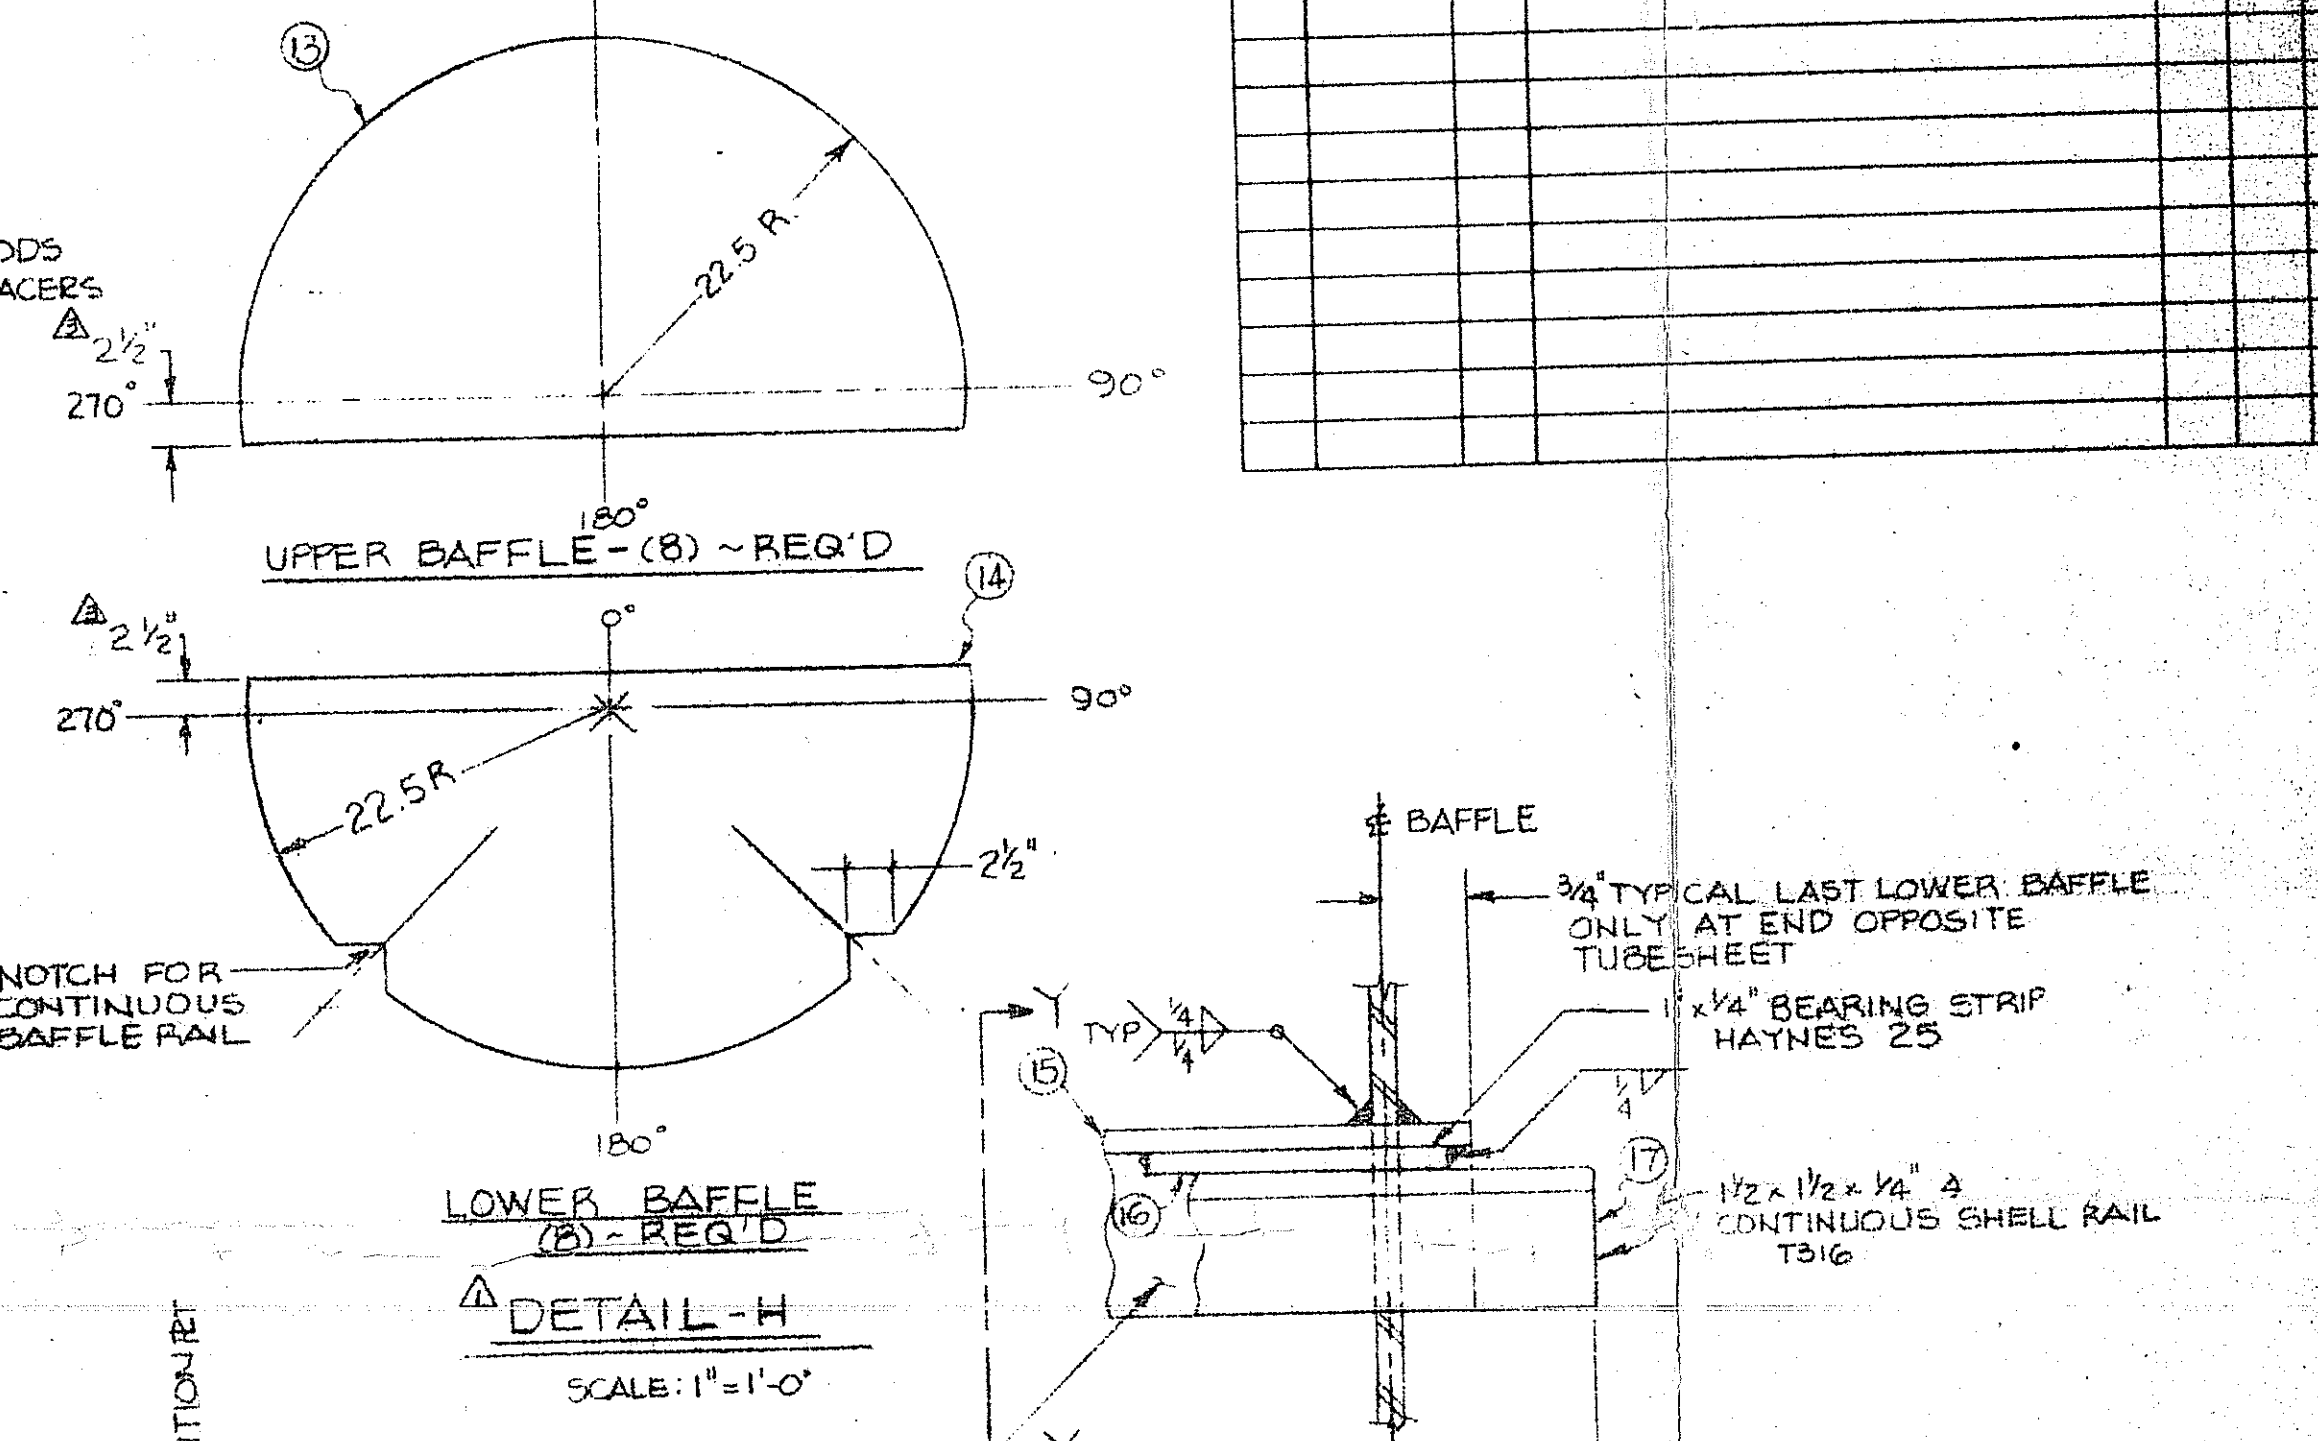
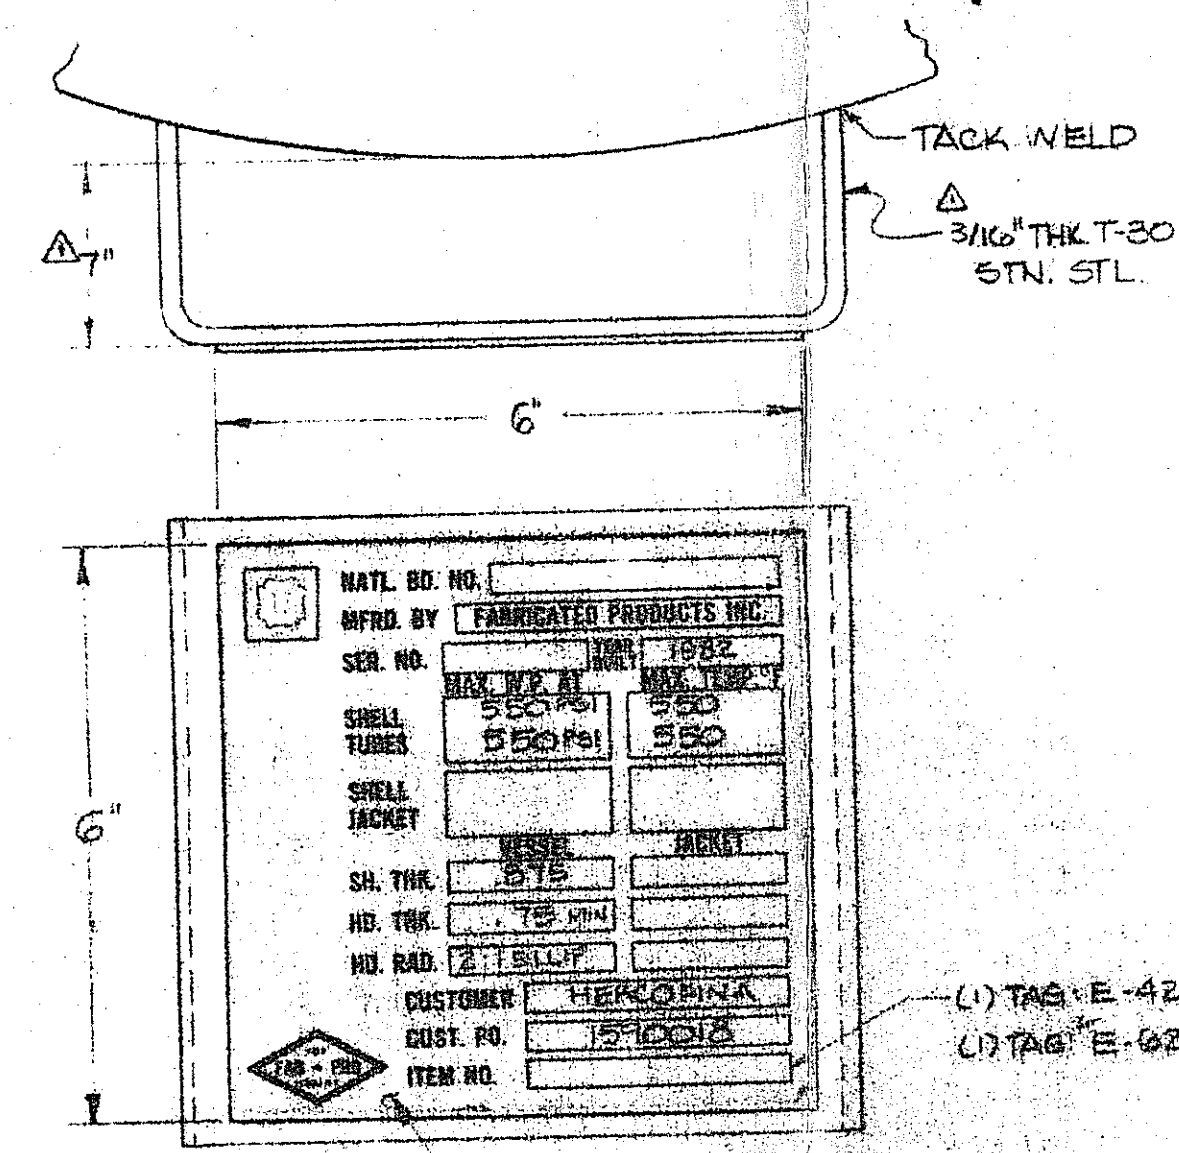
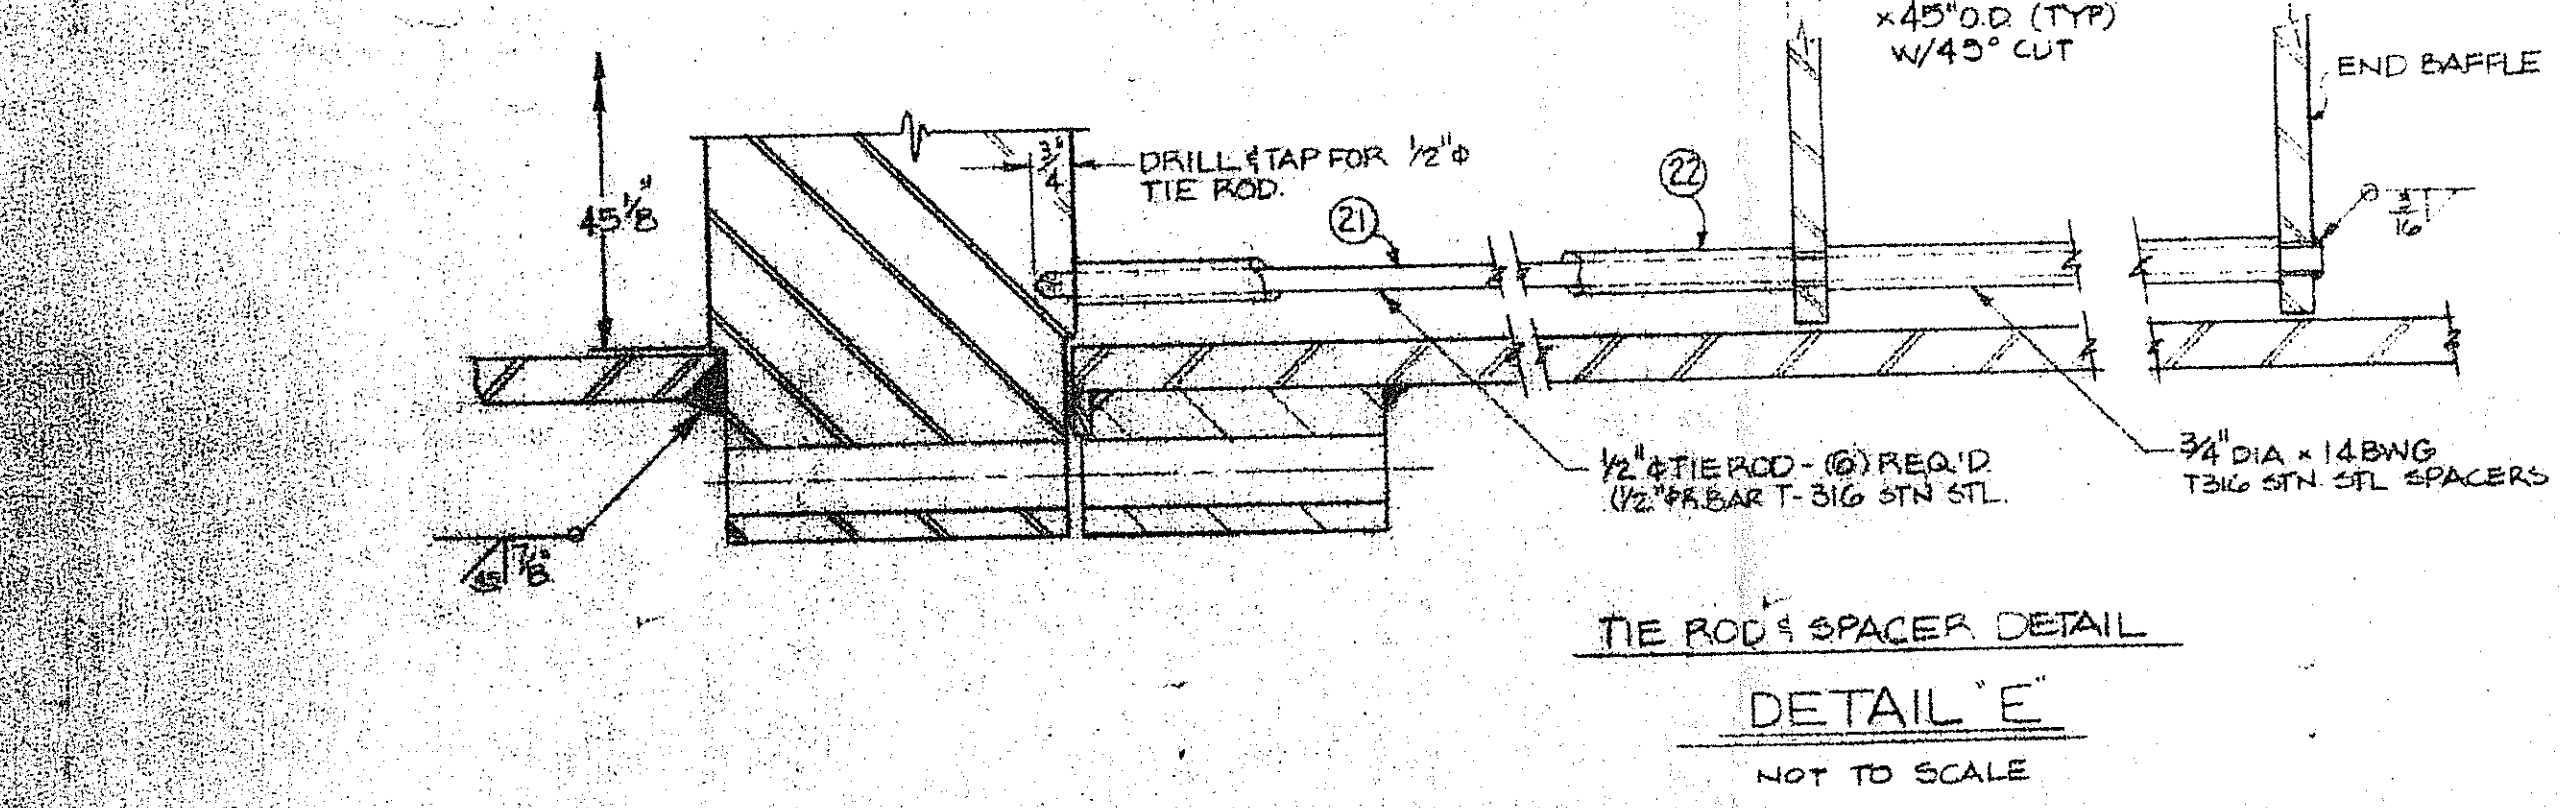
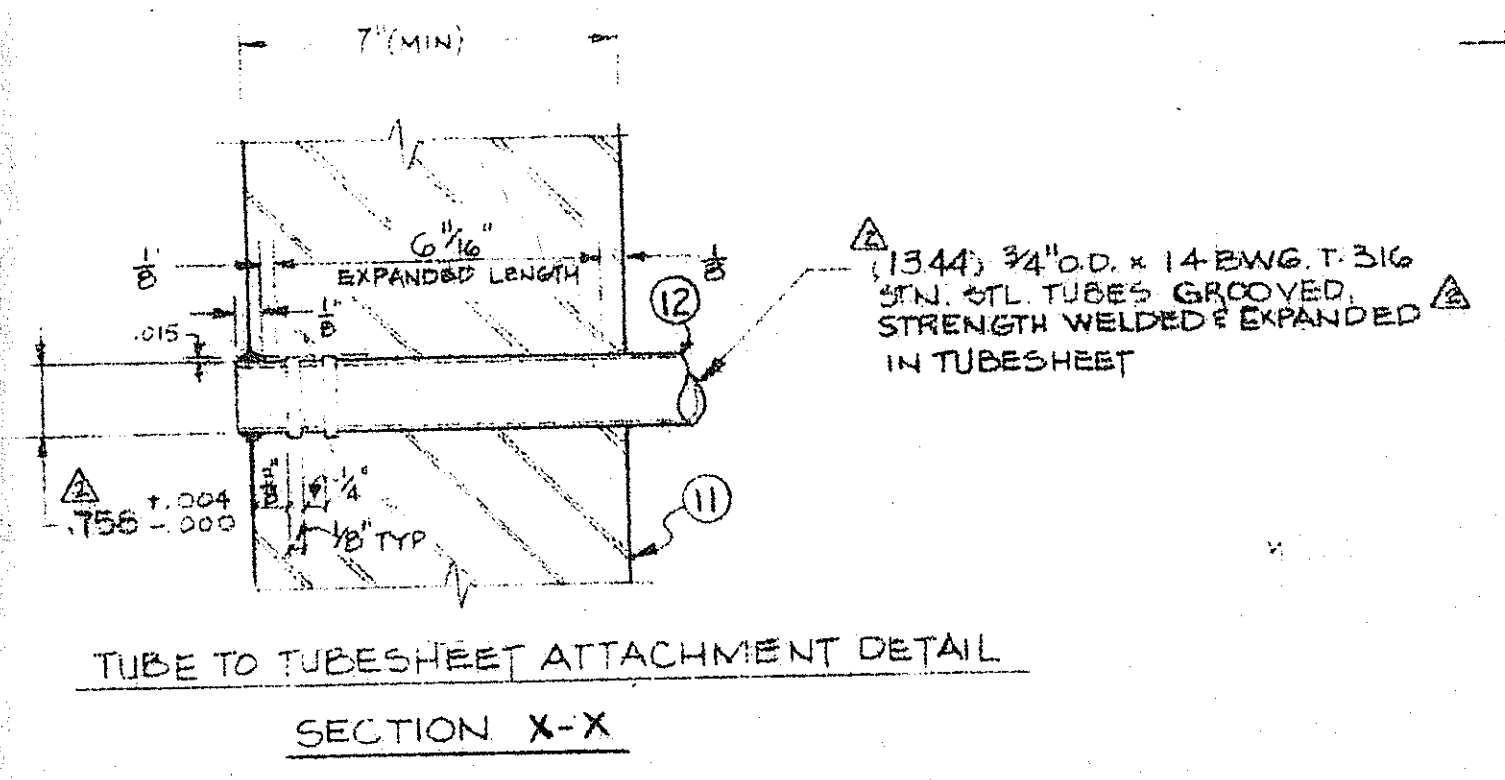
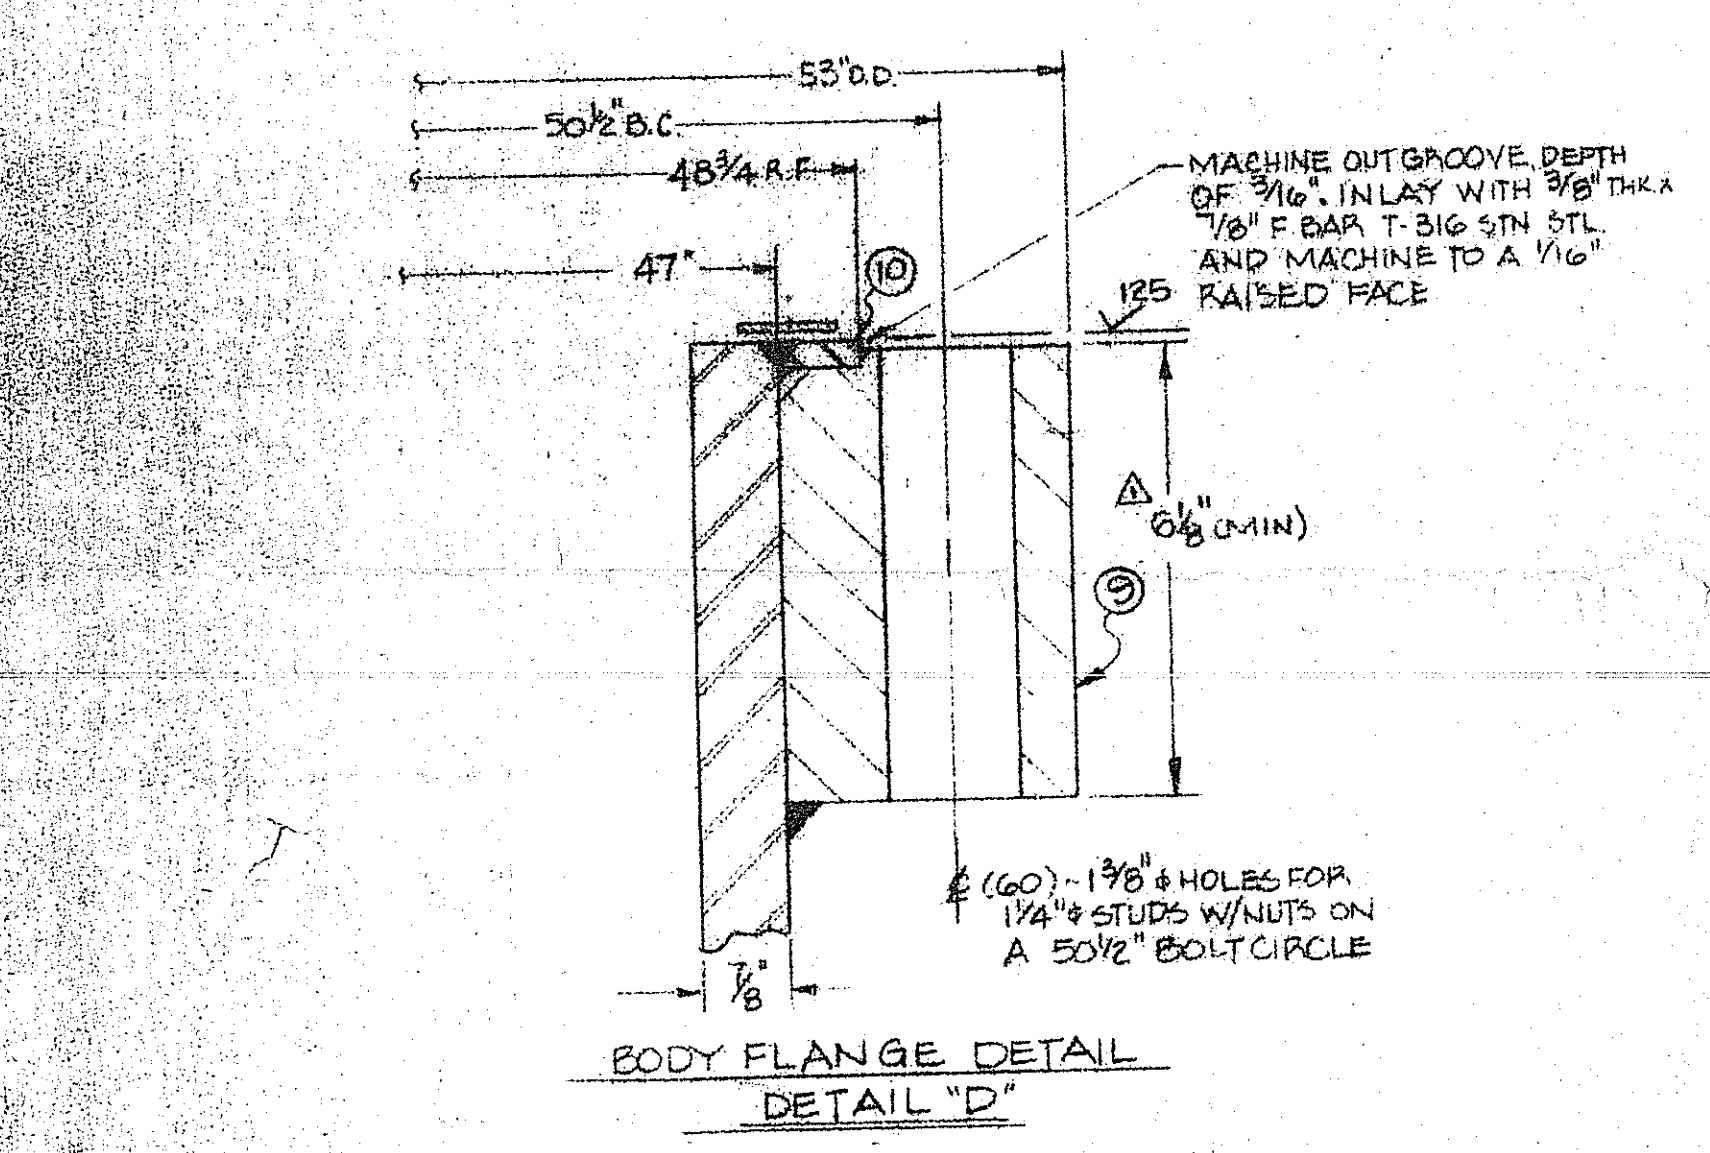
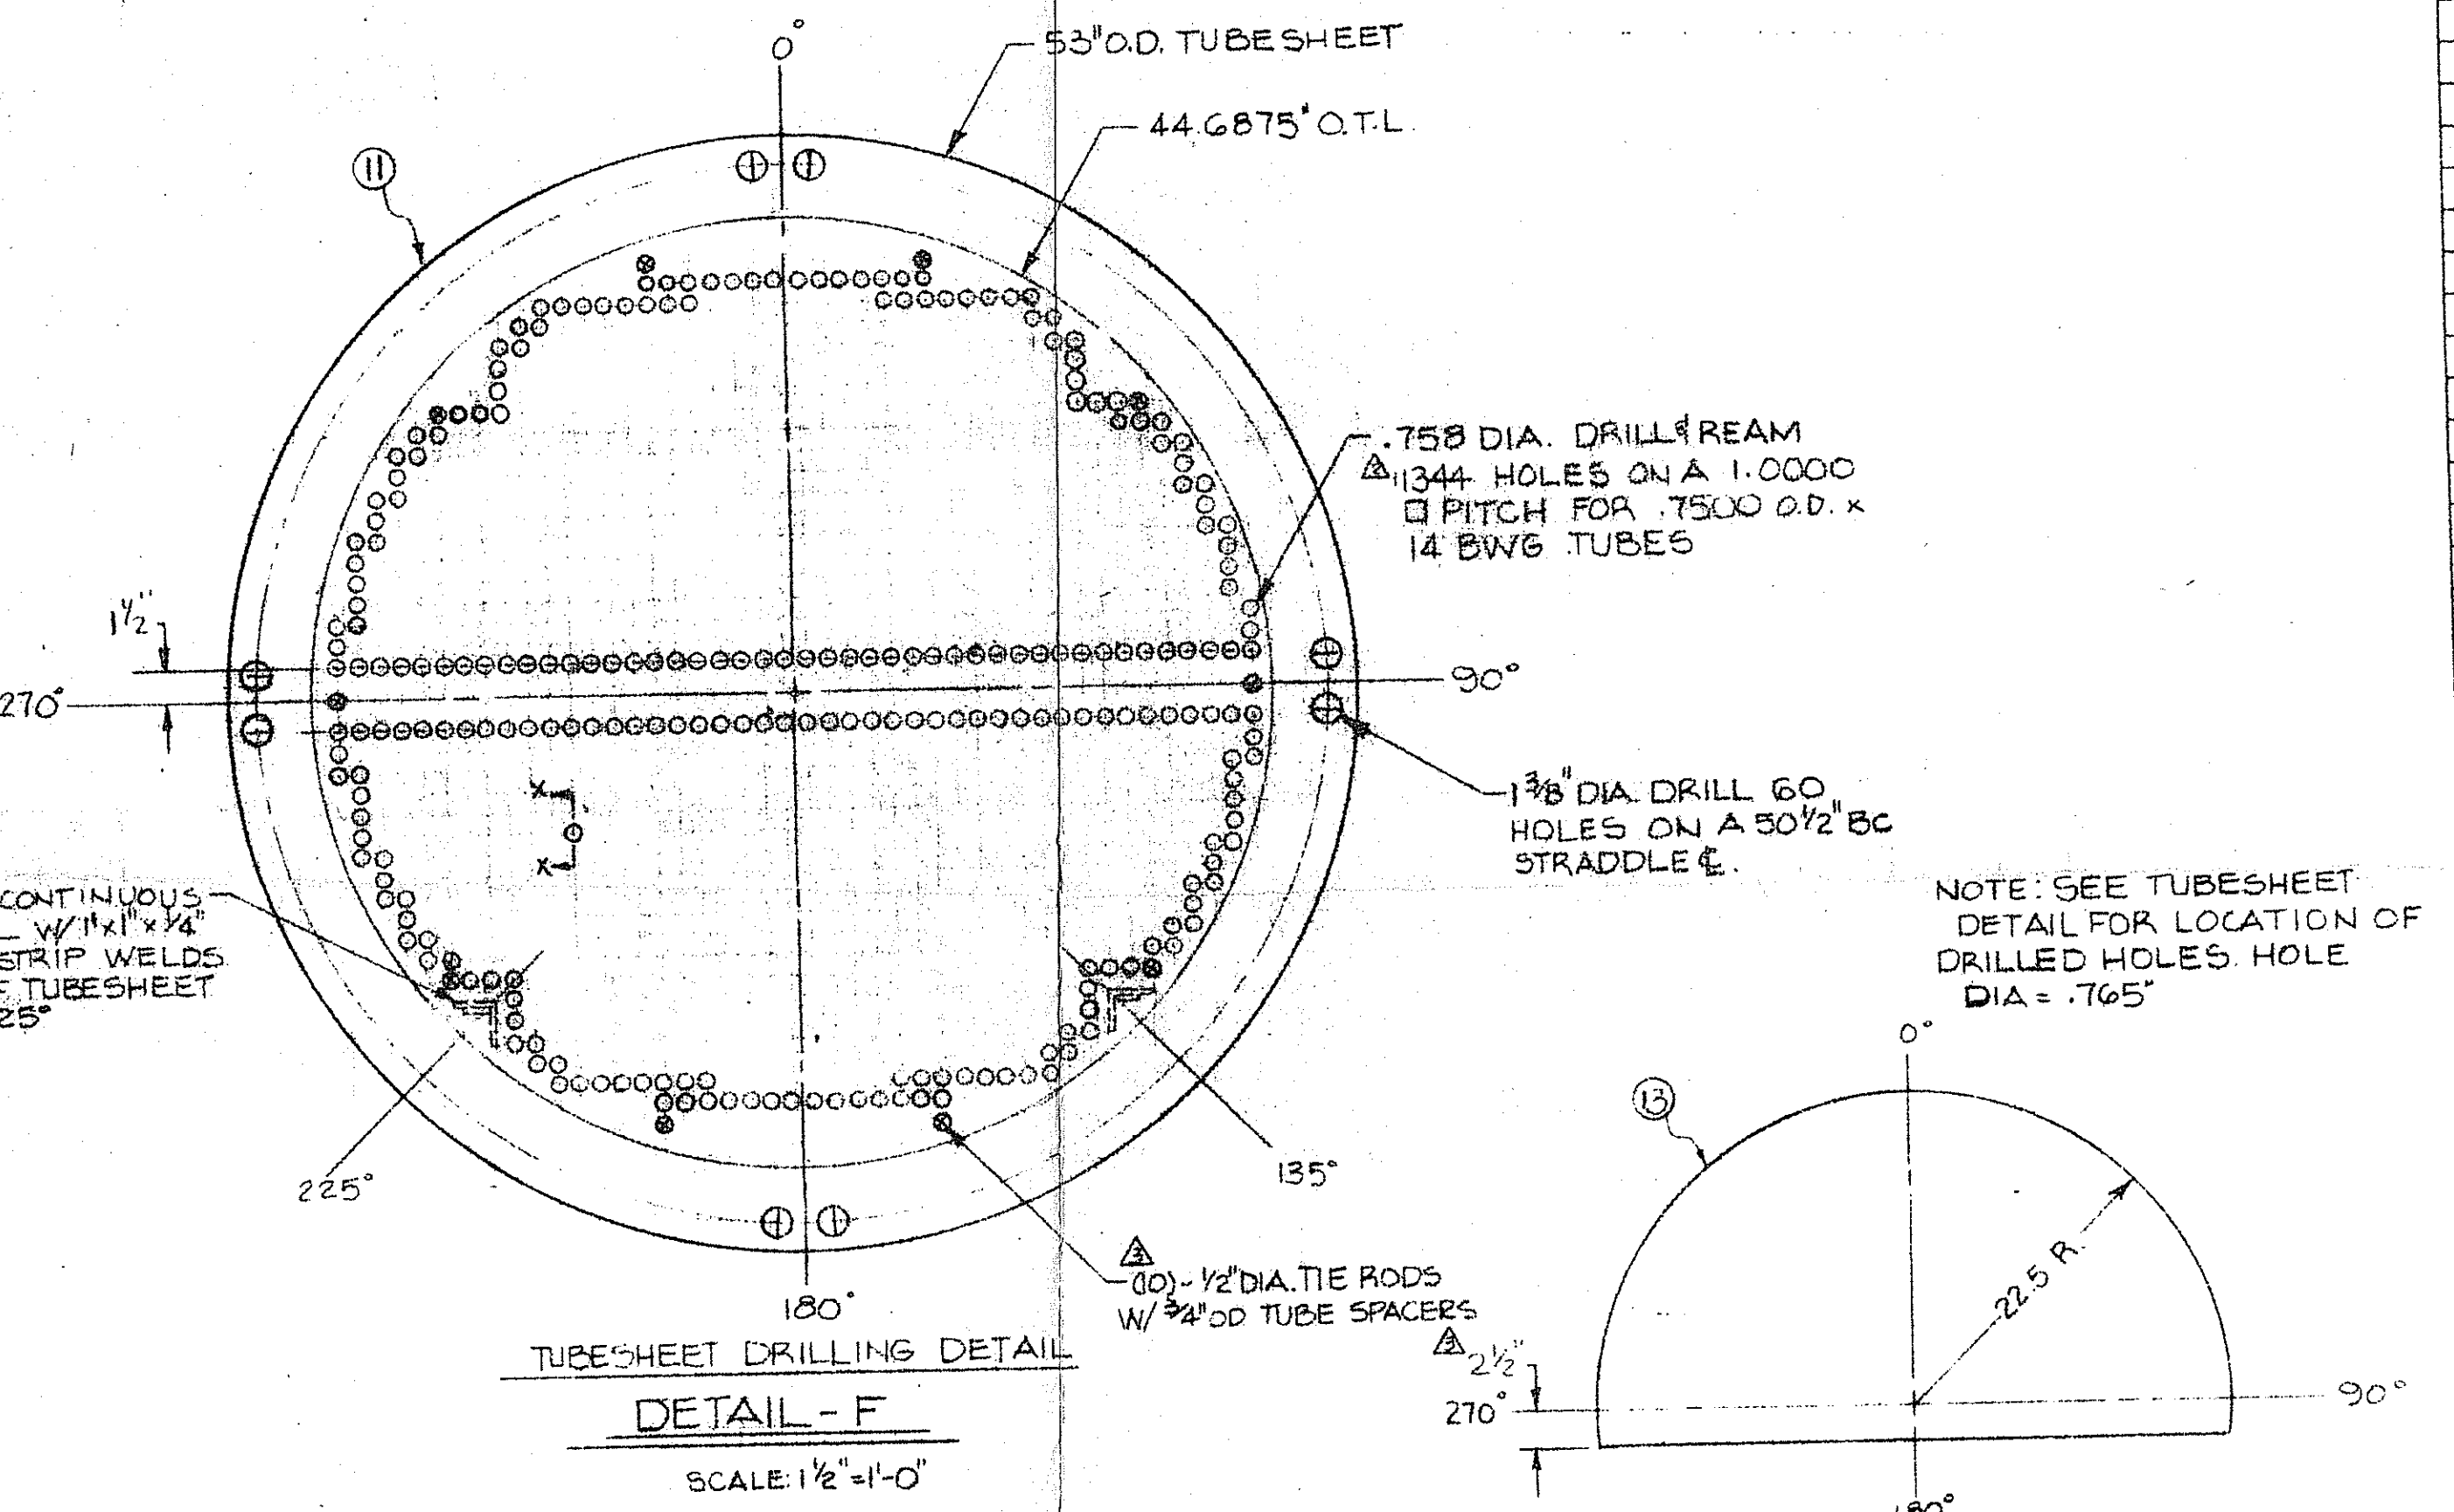


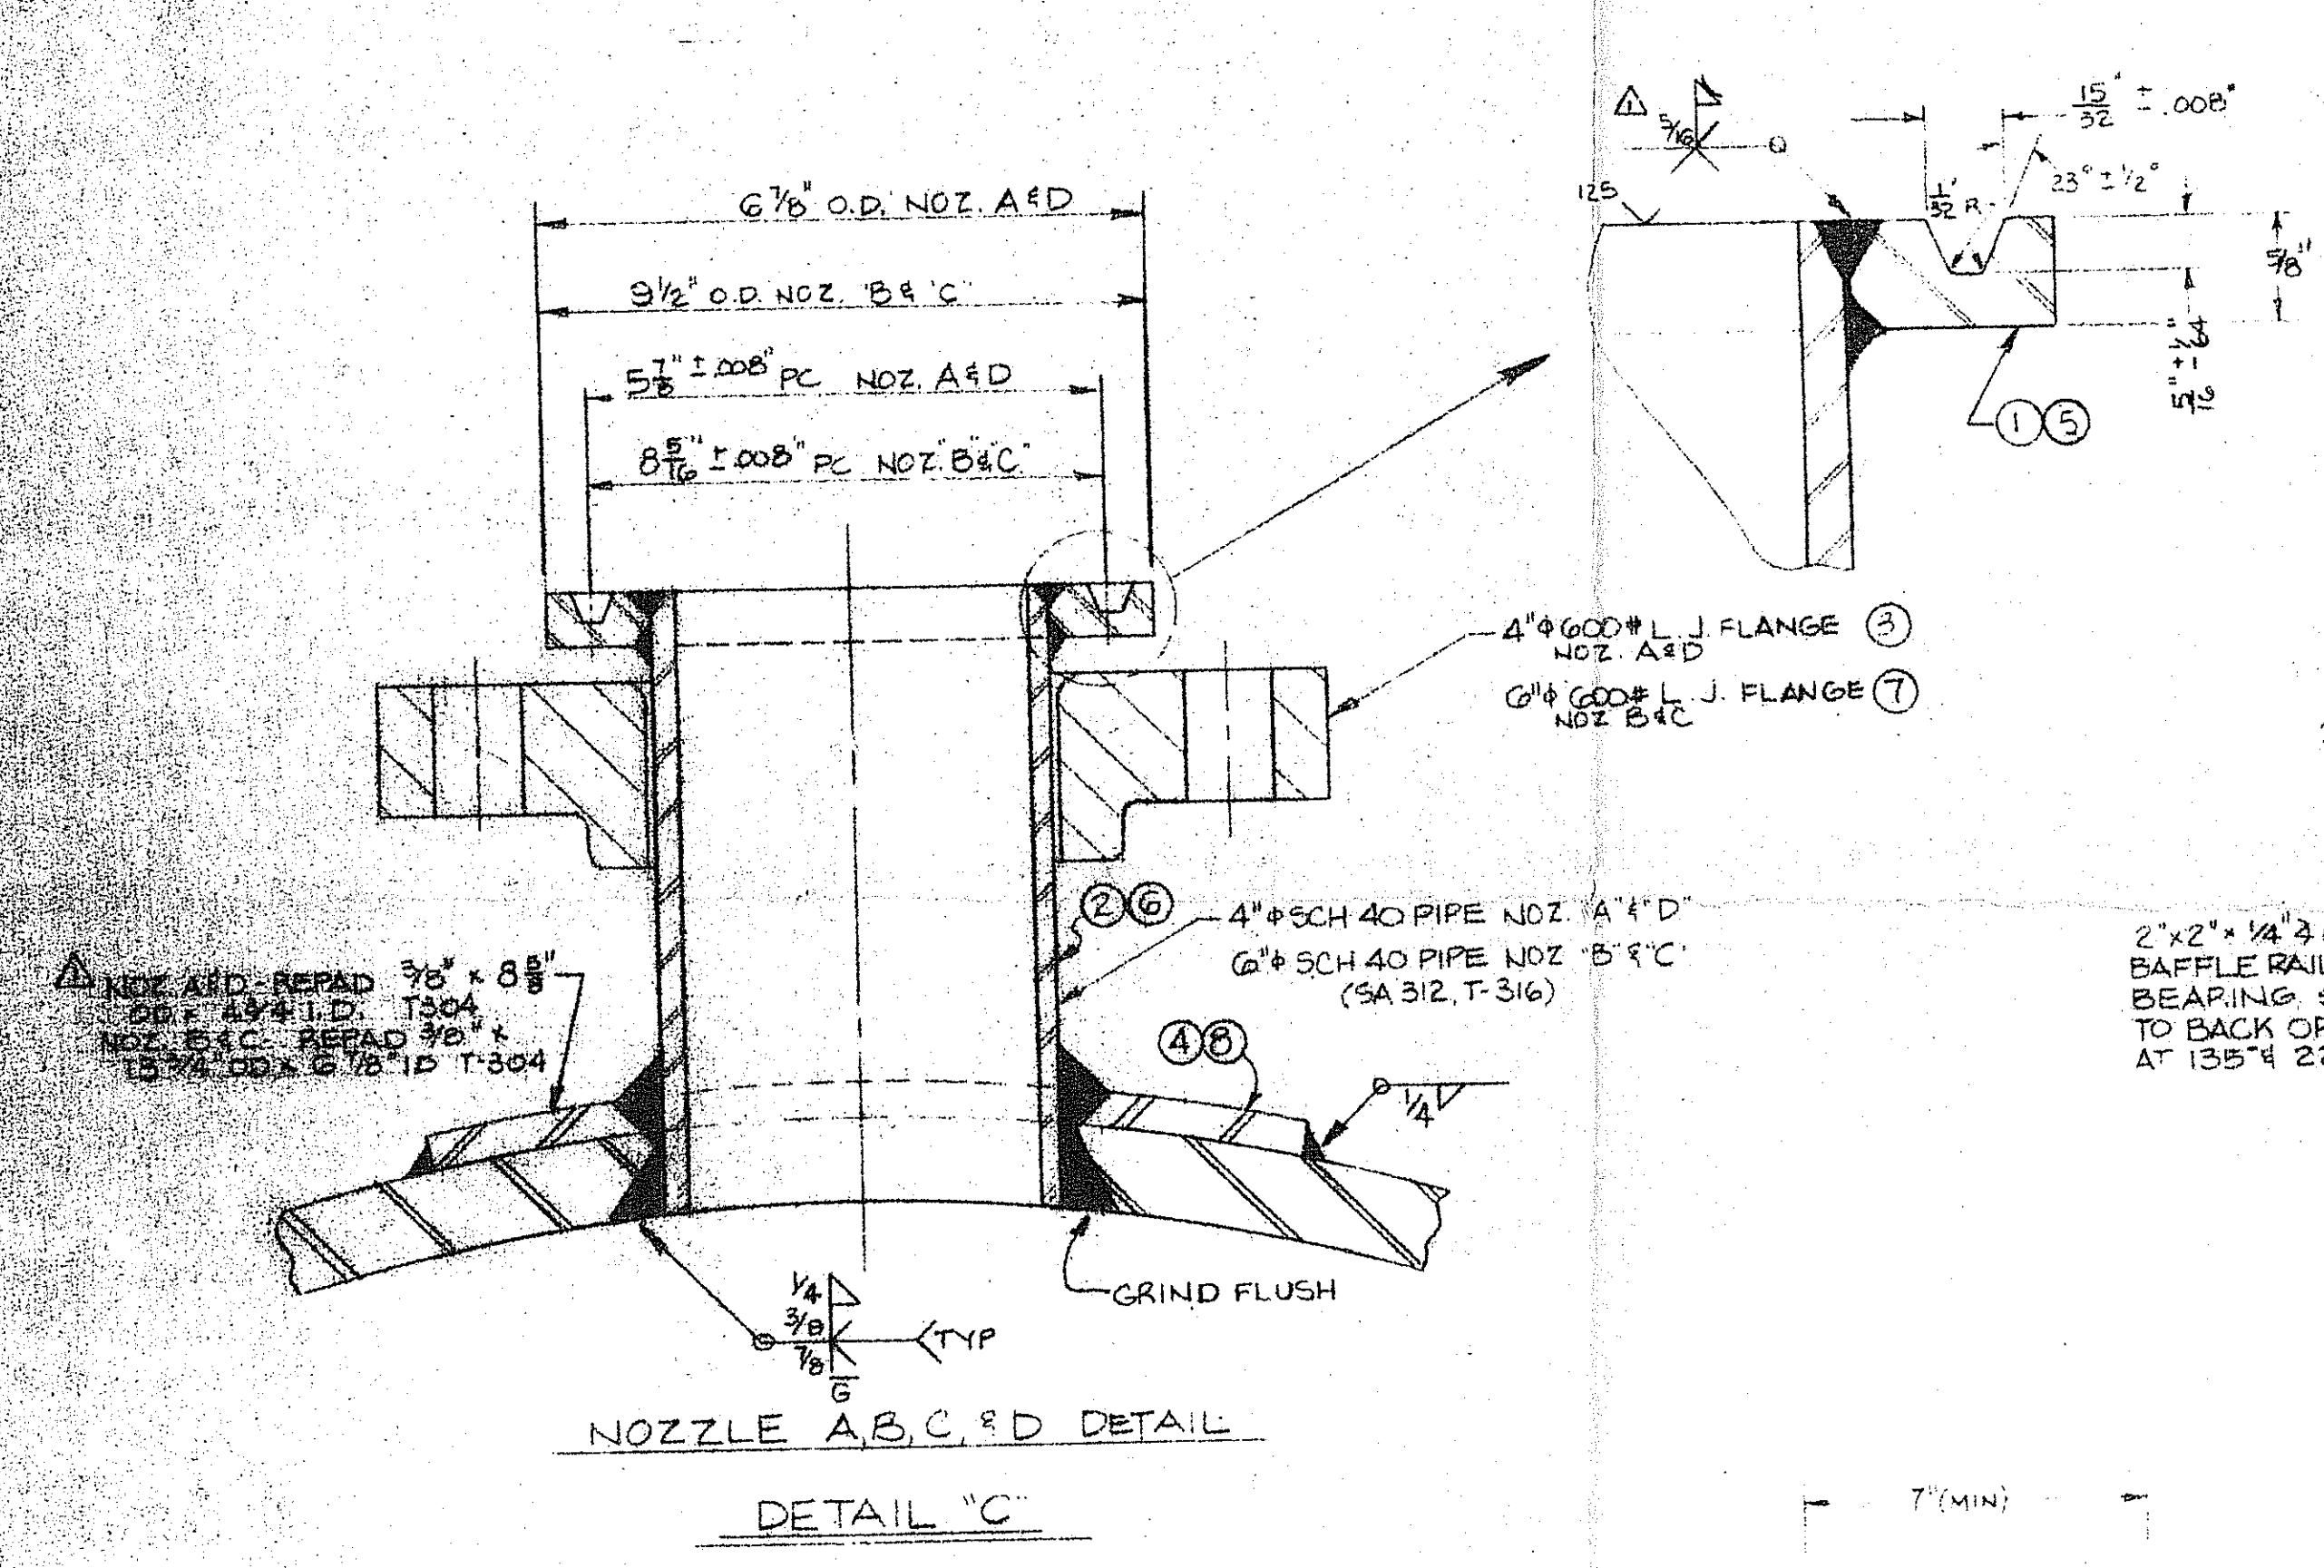

CERTIFIED DRAWING
BY Rebecca Hankford
DATE 11-3-82

OPPOSITE HAND
TYPICAL @ 225°

DETAIL - K		SCALE: 2"=1'-0"		20-10-82		FABRICATED PRODUCTS, INC.	
				CHARLOTTE, N.C.			
7/21	⚠	ADDED DETAIL "K" BAFFLE CUT WAS 1 1/4" FROM 4 APPERTURE HOLES	RCL	TOLERANCES (EXCEPT AS NOTED)	DECIMAL	SCALE	TRAIN BY RCL
		NO. OF TUBES AND TUBE HOLES WAS 1356			±	NA	APPROVED BY
		CORRECTED DETA. DIA. FOR TUBES IN TUBESHEET WAS 1/8"			±		
6-15-82	⚠	REVISED WELD OF 1/8" DIA. RING TO 1/4" WELD. ADDED SERIES TO NO. 4, B, C, D, BODY FLANGE WAS 1" MIN THK. BAFFLES WERE 9/16" THK. NO. OF TUBES WERE 1,360; ADDED TUBESHEETS BAFFLE, TUBE BUNDLE RAIL DETAIL	RCL		FRACTIONAL	TITLE	
					±	PREHEATER DETAILS	
					±		
					ANGULAR	DATE	DRAWING NUMBER
DATE	BY	REVISION RECORD		DATE	BY	3-17-82	2041-02
							REV-5

VENDOR PRINT FILE 57574-NV		DATE 12-28-82	
SHEET 1		EQUIPMENT	
PROJECT & ACCOUNT NOS. 026159 / 4025		NOS. P-4203-20	
PURCHASE ORDER NO. X1580018			
PLANT <u>Therover</u>			
REVIEWED - DRAFTING DESIGN			
APPROVED ENGINEER <u>Ron Ormoy</u>			