
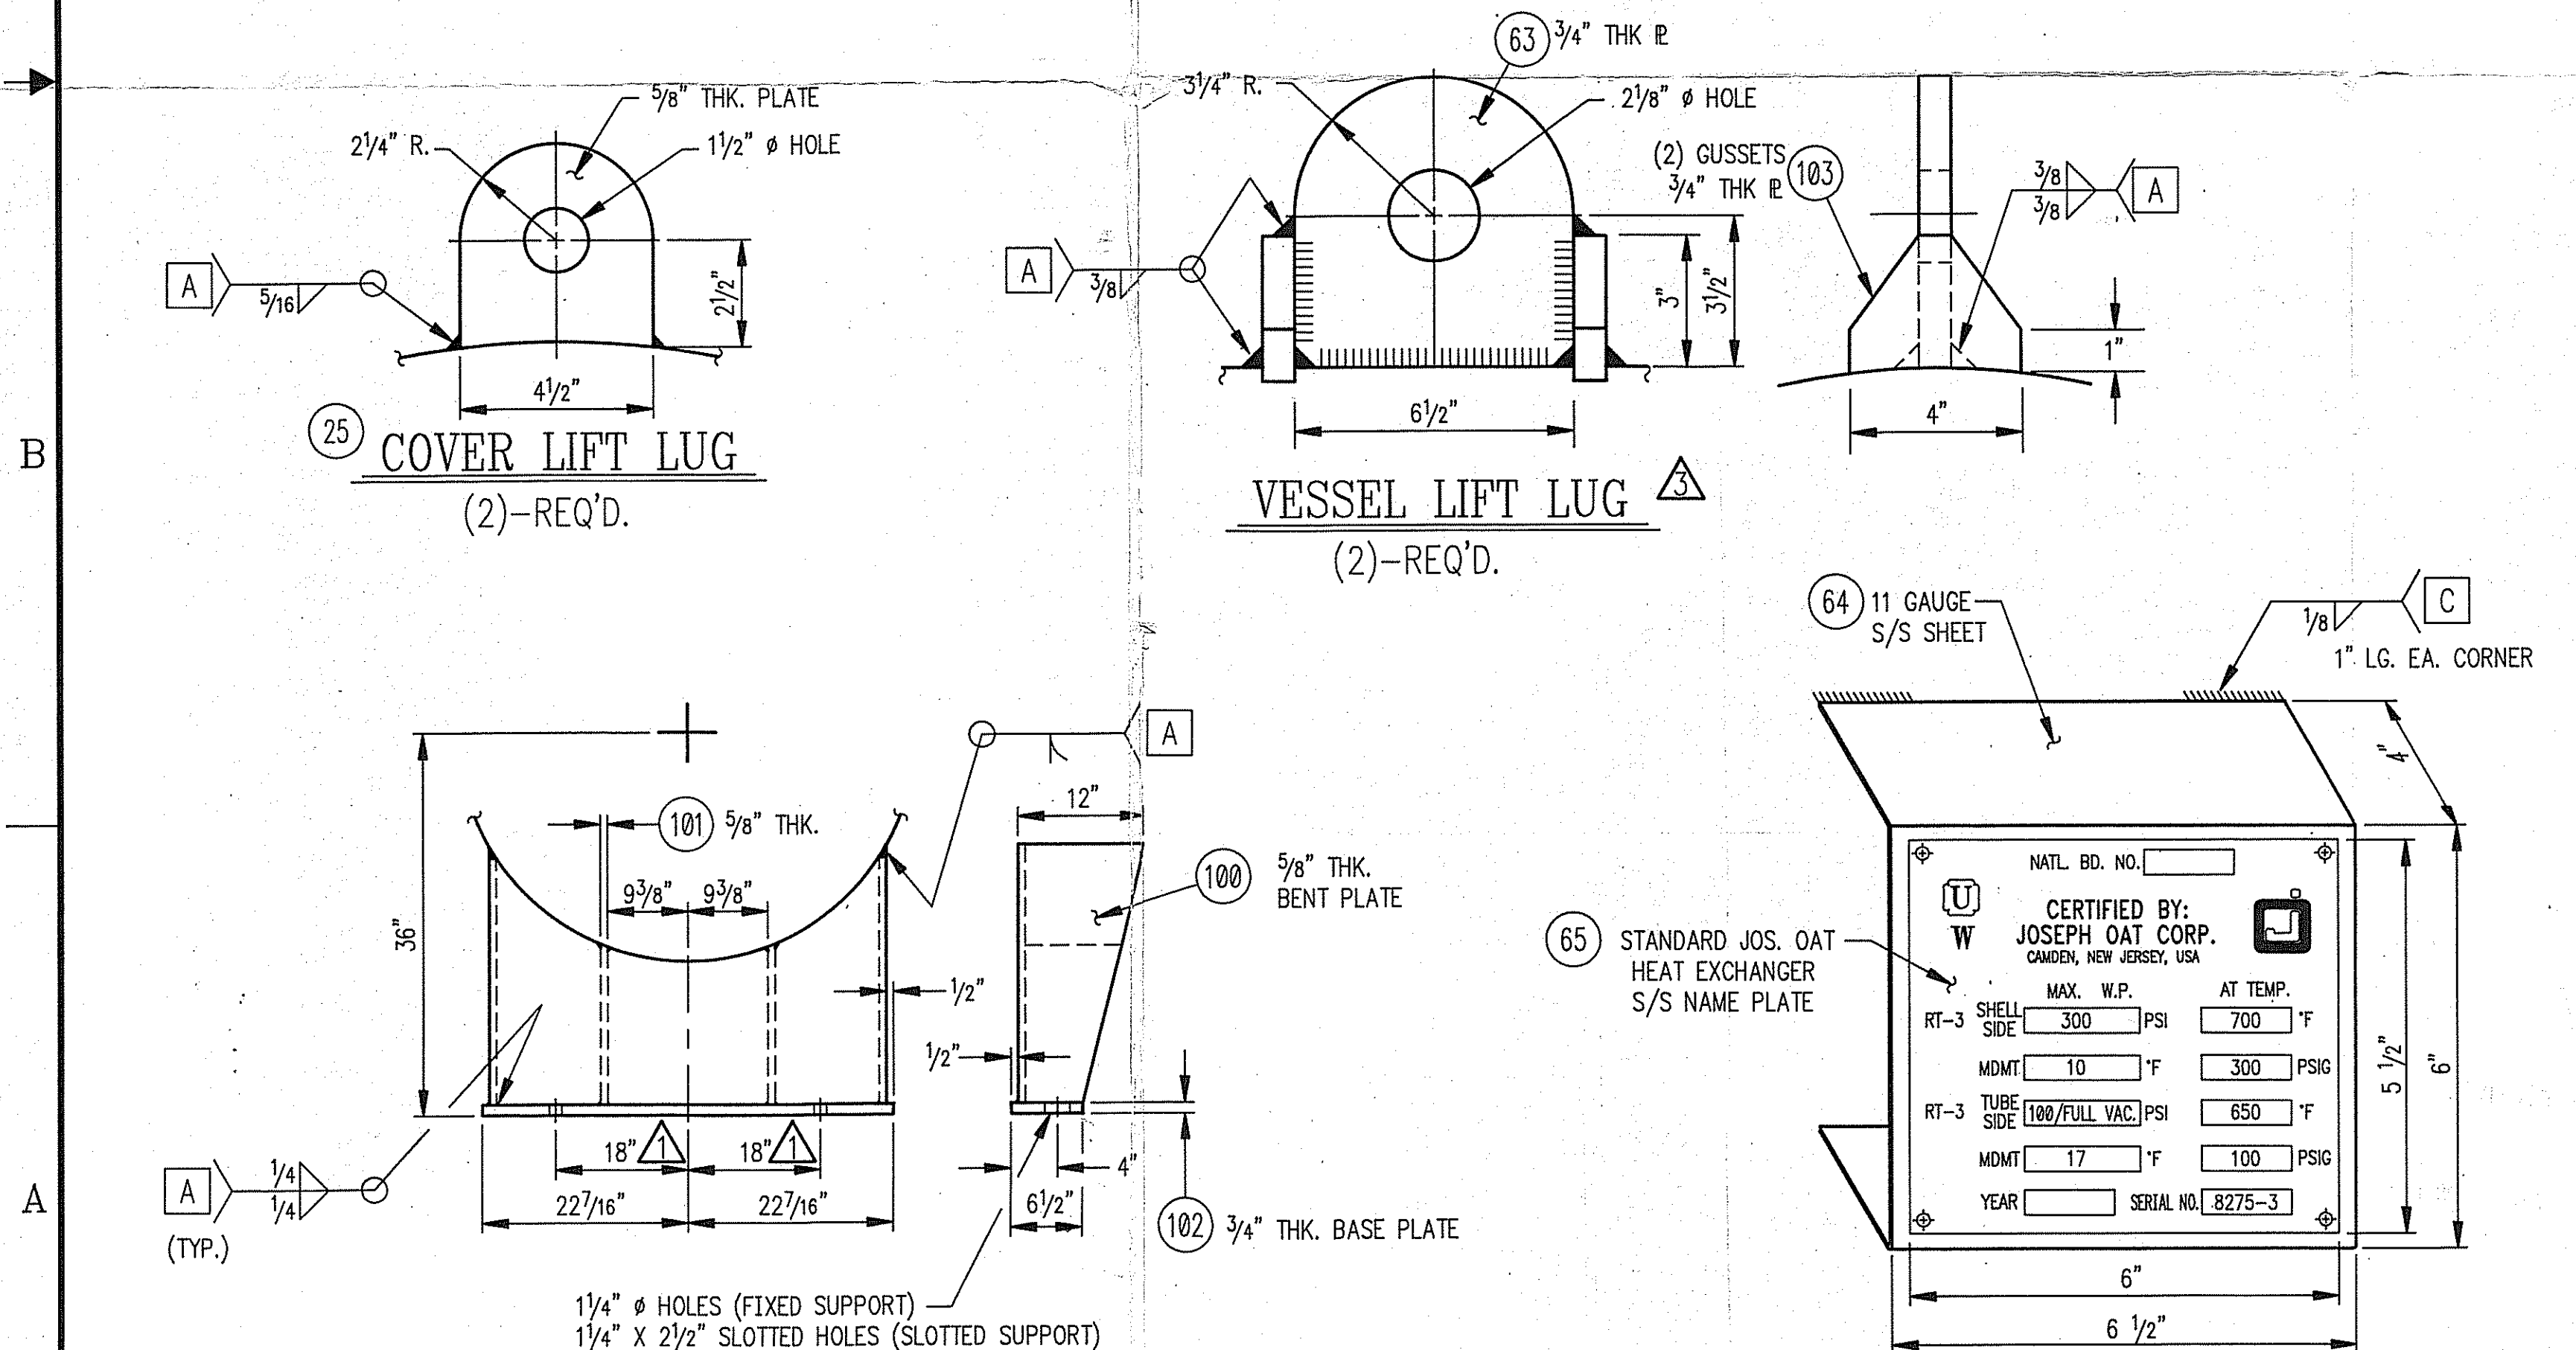


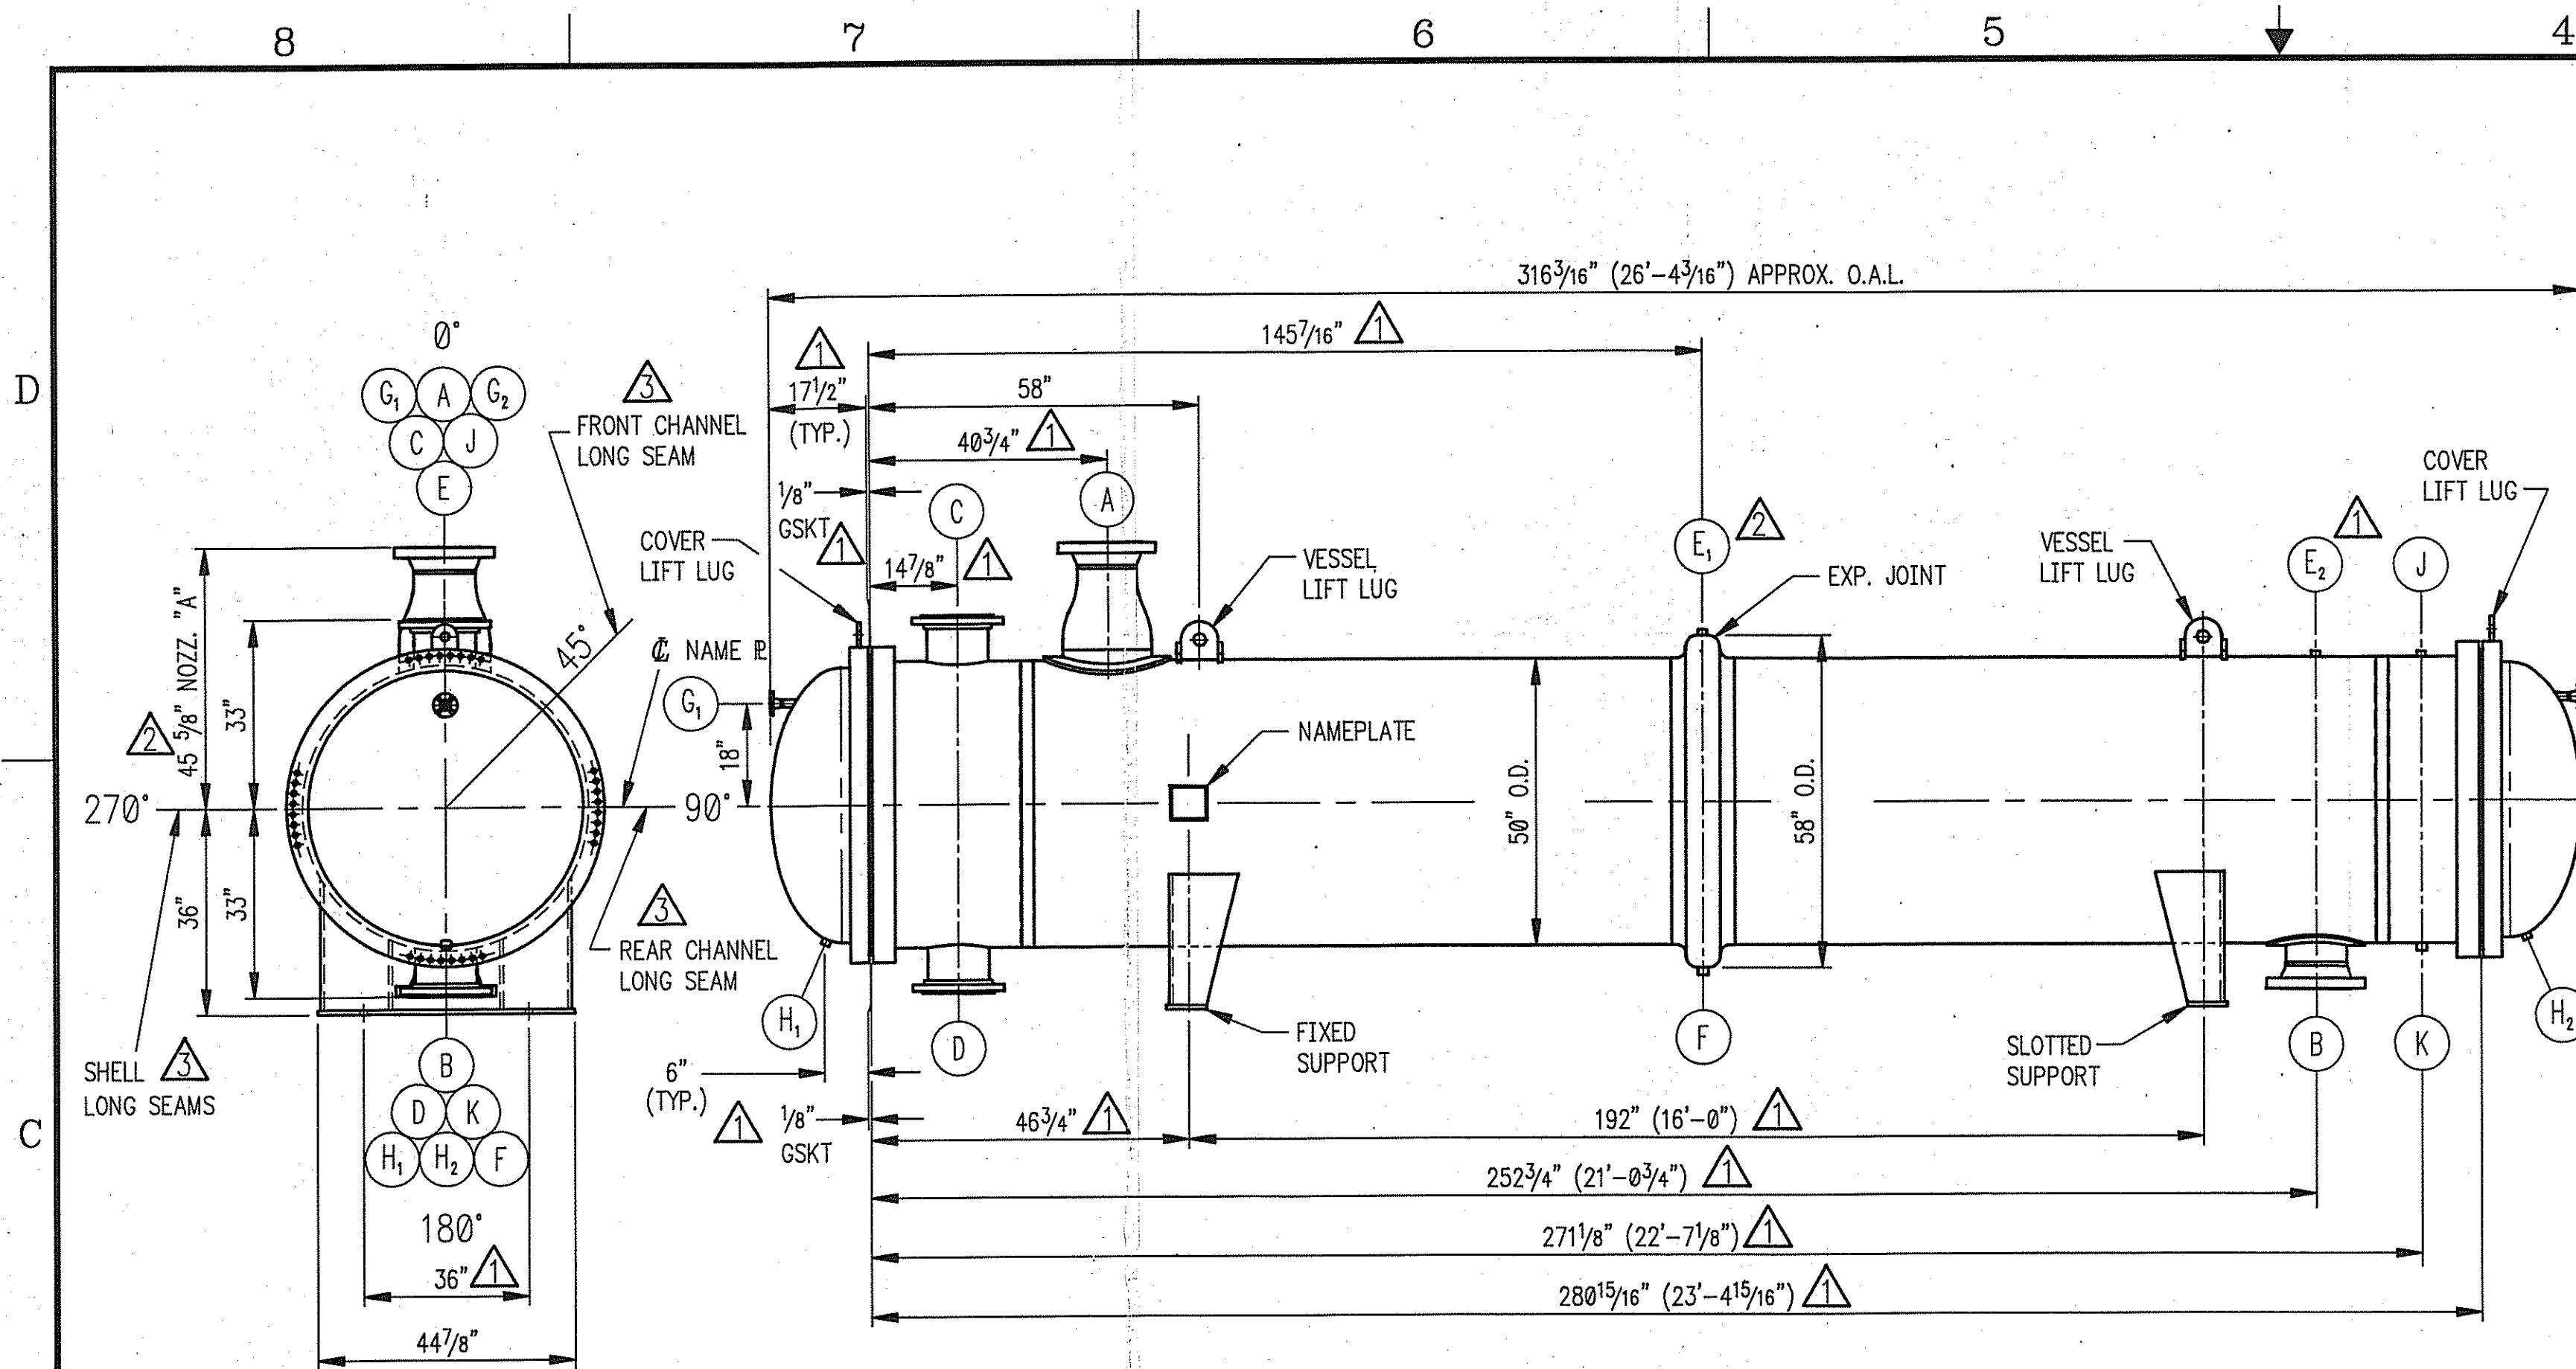

NOZZLE SCHEDULE					
MARK	SIZE	SCH	RATING	PURPOSE	REMARKS
A	10"	XS	300# WN	SHELL INLET	16" x 10" REDUCER
B	10"	120	300# WN	SHELL OUTLET	
C	10"	3/8"	150# LJ	TUBE OUTLET	
D	10"	3/8"	150# LJ	TUBE INLET	
E ₁ -E ₂	3/4"		3000#	SHELL VENT	THR'D. COUPLET W/PLUG
F	1"		3000#	SHELL DRAIN	THR'D. COUPLET W/PLUG
G ₁ -G ₂	1"	160	150# WN	STEAM JKT. INLET	
H ₁ -H ₂	3/4"		3000#	STEAM JKT. OUTLET	THR'D. COUPLET
J	3/4"		3000#	CHANNEL VENT	THR'D. COUPLET W/PLUG
K	1"		3000#	CHANNEL DRAIN	THR'D. COUPLET W/PLUG

DESIGN DATA	SHELL SIDE	TUBE SIDE
APPLICABLE CODES	ASME CODE 1989 SECTION VIII, DIV 1 1989 ADDENDA TEMA B	
DESIGN PRESSURE	300 PSIG	100PSIG/FULL VAC.
DESIGN TEMPERATURE	700° F.	650° F.
MAX. ALLOW. WORKING PRESS.	300 PSIG	100 PSIG
MIN. DESIGN METAL TEMP.	60°F. @ 300 PSIG	15°F. @ 100 PSIG
CORROSION ALLOWANCE	1/16"	NONE
BODY FLANGE FACE FINISH		125 RMS
RADIOGRAPHIC EXAMINATION	SPOT	SPOT
HEAT TREATMENT		
FINAL TEST PRESSURE	475 PSIG	170 PSIG

GENERAL NOTES:

- OAT IS TO SUPPLY TWO (2) SETS OF GASKETS ONE INSTALLED FOR TEST, AND SHIPPED WITH UNIT. ONE SET SHIPPED LOOSE

GENERAL INSPECTION NOTES:

- HYDROTEST VESSEL PER SP-1584
- LIQUID PENETRANT EXAMINE ALL ARC STRIKES AND CLIP REMOVAL MARKS PER SP-1580
- RADIOGRAPH TO EXTENT REQ'D. PER SP-1581

WELDING NOTES:

- | | | |
|---|---------|---|
| A | C/S-C/S | WPS-4101 W/E7018
WPS-5101 W/E7A2-2
WPS-7102 W/ER70S-2
WPS-8101 W/ER70S-2 |
| B | S/S-S/S | WPS-4303 W/E316
WPS-5301 W/ER316
WPS-7303 W/ER316
WPS-8303 W/ER316 |
| C | C/S-S/S | WPS-4305 W/E309
WPS-5310 W/ER309
WPS-7304 W/ER309
WPS-8301 W/ER309 |

- | | | |
|---|----------------|------------------|
| D | TUBE/TUBESHEET | WPS-8303 W/ER316 |
|---|----------------|------------------|

MATERIAL	SHELL/JACKET	TUBE SIDE
SHELL	SA-516-70	SA-240-316
COVER		SA-516-70 WITH SA-240-316 LINER
SHELL AND HEAD FLANGES		SA-105
NOZZLE NECKS	SA-106-B	SA-240-316
NOZZLE FLANGES	SA-105	SA-105
REINFORCING PADS	SA-516-70	
TUBE SHEETS	SA-240-316	
TUBES	SA-213-316	
BAFFLES	A-36	
SPACERS	A-53-B	
TIE-RODS	A-36	
PARTITION PLATES		SA-240-316
COUPLINGS	SA-105	SA-182-F316
GASKETS		SPIRAL WOUND CG 316 SS/GRAPHITE
BOLTS OR STUDS		SA-193-B7
NUTS		SA-194-2H
IMPINGEMENT PLATE	304 S/S	
SUPPORTS/LIFT LUGS	SA-36	SA-36
JACKET DESIGN DATA-ASME CODE 1989 SEC.VIII DIV. 1		
DESIGN PRESSURE/TEMPERATURE	150 PSIG/400°F	
MAWP/MDMT	150 PSIG/-20°F@150 PSIG	
CORROSION ALLOW./RADIOGRAPHIC EX.	1/16"/SPOT	
FINAL TEST PRESSURE	225 PSIG	
WEIGHT EMPTY	36,500#	
WEIGHT FULL OF WATER	54,000#	
PAINING	ALL EXTERNAL C/S - SANDBLAST PER SSPC-SP6 AND GIVE (1) COAT OF CARBOZINC 11, OR EQ. (3-5 MILS D.F.T.)	
ALL EXTERNAL S/S	- SOLVENT CLEAN PER SSPC-SP1 AND GIVE (2) COATS SILICONE BASE BLACK PAINT (1.5 MILS TOTAL MIN. D.F.T.)	
INSPECTION	OAT, CUSTOMER & AUTHORIZED I.A.	
STAMPING	ASME "U" STAMP REQ'D.	
NOTE: BOLT HOLES SHALL STRADDLE THE NORMAL VESSEL CENTER LINES.		

COMPANION DRAWINGS:
D-9826, D-9827, D-9828



APR 24 1991

JOSEPH OAT CORPORATION
CHEMICAL ENGINEERS/DESIGNERS/FABRICATORS
CAMDEN, NEW JERSEY 08104
EST. 1788

**OUTLINE/ASSEMBLY
CRUDE STILL REBOILER**
ITEM No. E-4403-2R

FOR: **CAPE INDUSTRIES, INC.**
WILMINGTON, NORTH CAROLINA

4/22/91	Δ ZONES: A3 B6 C7 C8 D7	HKn	REF. NO. E-4403-2R	JOB NO.: J-8275-3
12/5/90	Δ ZONES: D4 D8 D1	D. Saurio LHB	P.O. NO. P90630	
10-16-90	Δ ZONES: A7 C2 C3 C5 TO C8 D2 TO D8	J. F. Saurio LHB	DRAWN: R. M. Villegas DATE: 8-16-90	No. REQD: (1)
DATE	REVISION	BY	APPRVD	DRAWING NO. D-9825
			APPRVD. ENG/QC	3

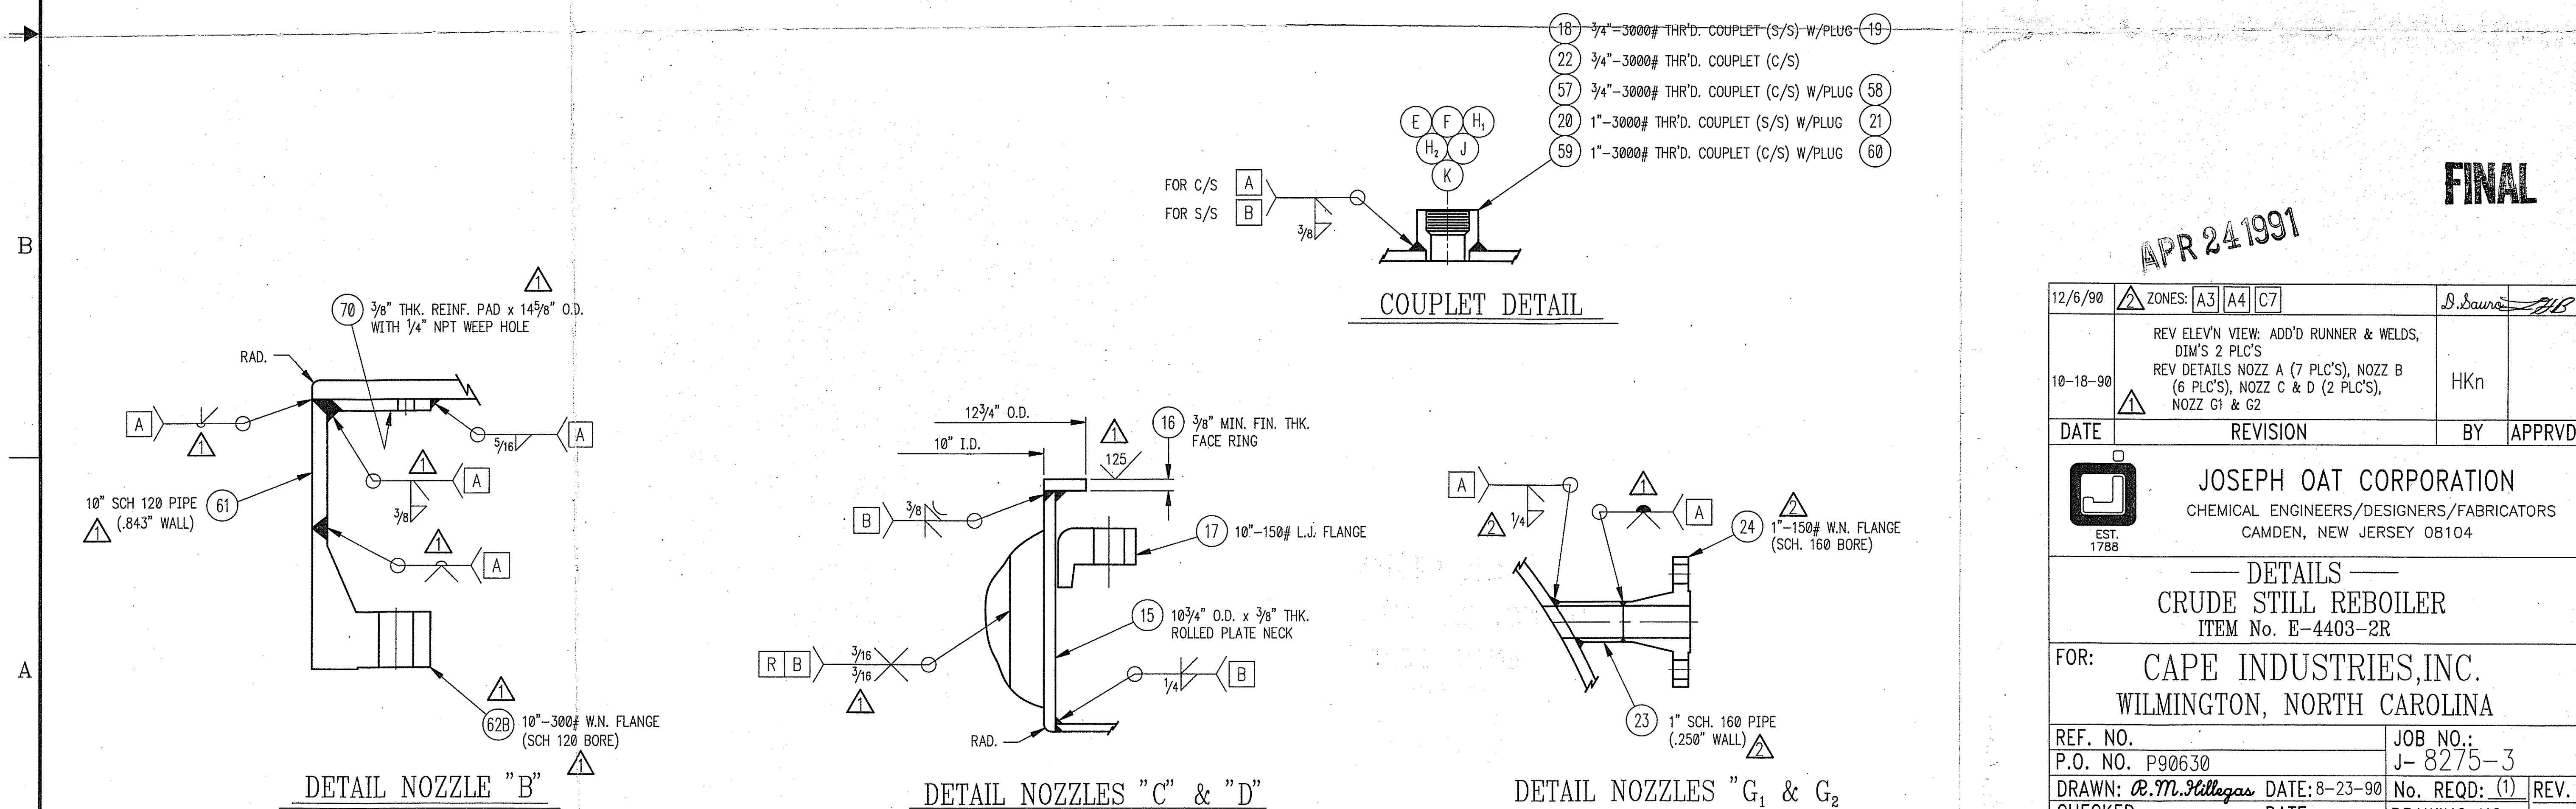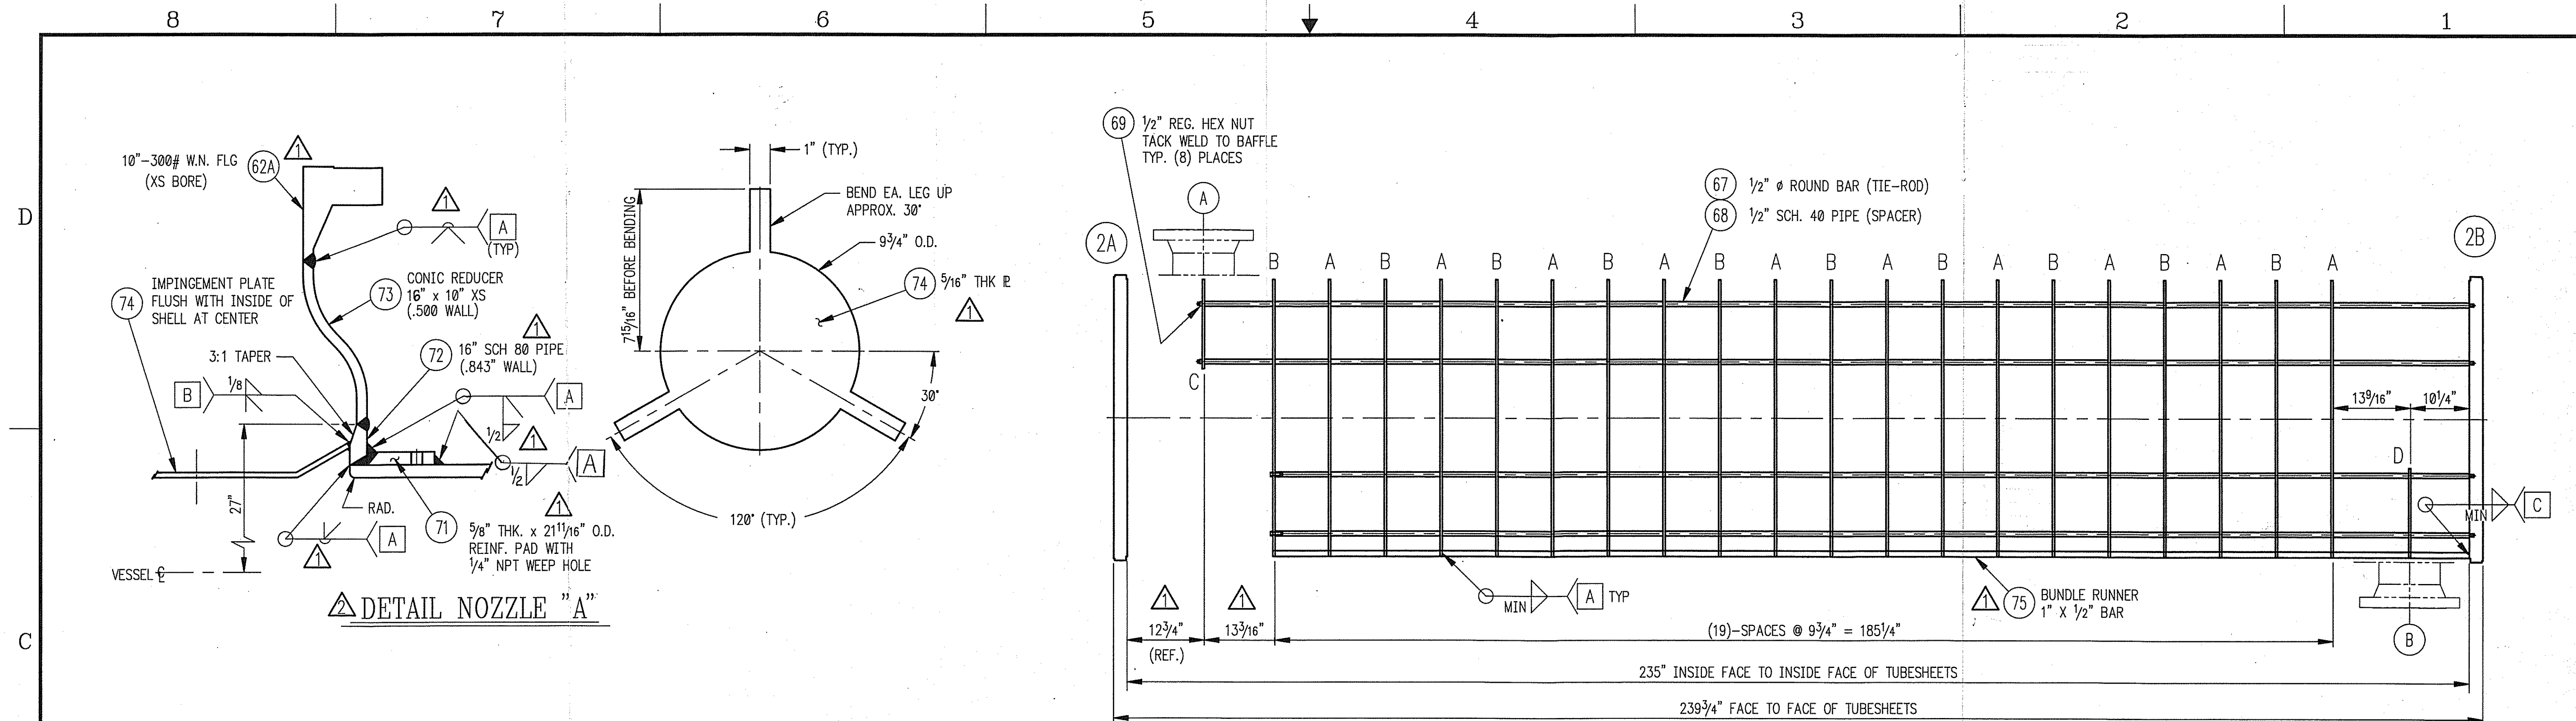

FINAL

APR 24 1991

12/6/90	 ZONES: A3 A4 C7	D. Saur 
10-18-90	 REV ELEV'N VIEW: ADD'D RUNNER & WELDS, DIM'S 2 PLC'S REV DETAILS NOZZ A (7 PLC'S), NOZZ B (6 PLC'S), NOZZ C & D (2 PLC'S), NOZZ G1 & G2	HKn
DATE	REVISION	BY APPRVD

EST.
1788

JOSEPH OAT CORPORATION

CHEMICAL ENGINEERS/DESIGNERS/FABRICATORS
CAMDEN, NEW JERSEY 08104

— DETAILS —
CRUDE STILL REBOILER
ITEM No. E-4403-2R

FOR: **CAPE INDUSTRIES, INC.**
WILMINGTON, NORTH CAROLINA

REF. NO.	JOB NO.:		
P.O. NO. P90630	J- 8275-3		
DRAWN: <i>R.M. Killegas</i>	DATE: 8-23-90	No. REQD: (1)	REV.
CHECKED:	DATE:	DRAWING NO.	
APPRVD: ENG/QC		D-9828	2

104275

FORM U-1 MANUFACTURER'S DATA REPORT FOR PRESSURE VESSELS
As Required by the Provisions of the ASME Code Rules, Section VIII, Division 1

1. Manufactured and certified by JOSEPH OAT CORP 2500 BROWNWAY CAMDEN N.J.
(Name and address of manufacturer)

Manufactured for CAPE IND. INC. WILMINGTON N.C.
(Name and address of purchaser)

3. Location of installation SAME
(Name and address)

4. Type HORIZ. 8275-3 — 9825 2802 1991
(Horiz. or vert., tank) (Mfr's serial No.) (CRN) (Drawing) (Nat'l. Bd. No.) (Year built)

5. The chemical and physical properties of all parts meet the requirements of material specifications of the ASME Boiler and Pressure Vessel Code. The design construction, and workmanship conform to ASME Rules, Section VIII, Division 1. 1989
Year

Addenda (date)

Code Case No.

Special service per UG-120(d)

Items 6-11 incl. to be completed for single wall vessels, jackets of jacketed vessels, or shells of heat exchangers

6. Shell: SA-516-70 .625 .0625 48.75 240"
Matl. (Spec. No., Grade) Nom. Thk. (in.) Corr. Allow. (in.) Diam. I.D. (ft & in.) (Length (Overall)) (ft & in.)

7. Seams: DBL. SPOT 85
Long. (Dbl., Sngl.) R.T. (Spot or Full) Eff. (%) H.T. Temp. (°F)

Time

Girth (Dbl., Sngl.)

R.T. (Spot, Partial, or Full)

No. of Courses

8. Heads: (a) Matl. — (b) Matl. —
(Spec. No., Grade) (Spec. No., Grade)

	Location (Top, Bottom, Ends)	Minimum Thickness	Corrosion Allowance	Crown Radius	Knuckle Radius	Elliptical Ratio	Conical Apex Angle	Hemispherical Radius	Flat Diameter	Side to Pressure (Convex or Concave)
(a)	—	—	—	—	—	—	—	—	—	—
(b)	—	—	—	—	—	—	—	—	—	—

If removable, bolts used (describe other fastenings) —

(Matl., Spec. No., Gr., Size, No.)

9. Type of Jacket SEE REMARKS Proof Test —

10. Jacket Closure — If bar, give dimensions — If bolted, describe or sketch (Describe as ogee & weld, bar, etc.)

11. MAWP 300 psi at max. temp. 700 °F. Min. design metal temp. 60 °F at 300 psi.
Hydro., pneu., or comb. test press. 475 psi.

Items 12 and 13 to be completed for tube sections

12. Tubesheets: SA-240-316 48.75 2 1/2 NONE - TUBE 1/16 - SHELL WELDED
Stationary Matl. (Spec. No., Gr.) Diam. (in.) (Subject to pressure) Nom. Thk. (in.) Corr. Allow. (in.) Attach. (Welded, Bolted)

Floating Matl. (Spec. No., Gr.)

Diam. (in.)

Nom. Thk. (in.)

Corr. Allow. (in.)

Attach.

13. Tubes: SA-213-316 1" 14 1093 STRAIGHT
Matl. (Spec. No., Gr.) O.D. (in.) Nom. Thk. (in. or Gauge) Number Type (Straight or "U")

Items 14-17 incl. to be completed for inner chambers of jacketed vessels or channels of heat exchangers

14. Shell: SA-240-316 .250 NONE 49.5" 15.875 - REAR 25.810 - FRONT
Matl. (Spec. No., Grade) Nom. Thk. (in.) Corr. Allow. (in.) Diam. I.D. (ft & in.) Length (Overall) (ft & in.)

15. Seams: DBL SPOT 85
Long. (Dbl., Sngl.) R.T. (Spot or Full) Eff. (%) H.T. Temp. (°F)

Time

Girth (Dbl., Sngl.)

R.T. (Spot, Partial, or Full)

1 - EACH END
No. of Courses

16. Heads: (a) Matl. SA-105 (b) Matl. SA-105
(Spec. No., Grade) (Spec. No., Grade)

	Location (Top, Bottom, Ends)	Minimum Thickness	Corrosion Allowance	Crown Radius	Knuckle Radius	Elliptical Ratio	Conical Apex Angle	Hemispherical Radius	Flat Diameter	Side to Pressure (Convex or Concave)
(a)	<u>END</u>	<u>3.25</u>	<u>NONE</u>	—	—	—	—	—	<u>55.125</u>	<u>FLAT</u>
(b)	<u>END</u>	<u>3.25</u>	<u>NONE</u>	—	—	—	—	—	<u>55.125</u>	<u>FLAT</u>

If removable, bolts used (describe other fastenings) SA-193-B7 3/4 92 SA-194-2H 3/4 184 EACH END
(Matl., Spec. No., Gr., Size, No.)

17. MAWP 100 psi at max. temp. 650 °F. Min. design metal temp. 15 °F at 100 psi.
Hydro., pneu., or comb. test press. 170 psi.

(12/87)

This Form (E00108) may be obtained from the ASME Order Dept., 22 Law Drive, Box 2300, Fairfield, NJ 07007-2300