
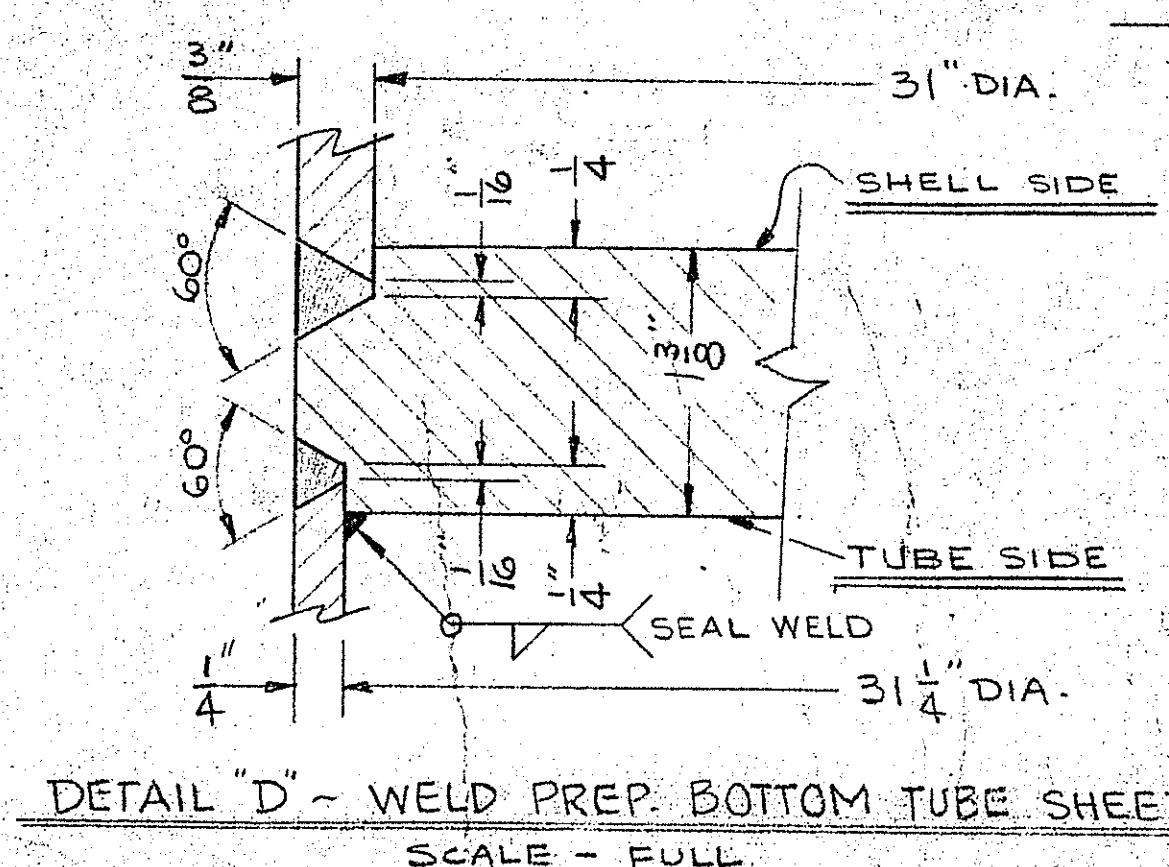
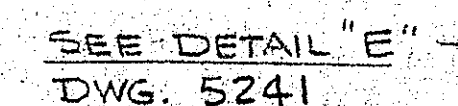
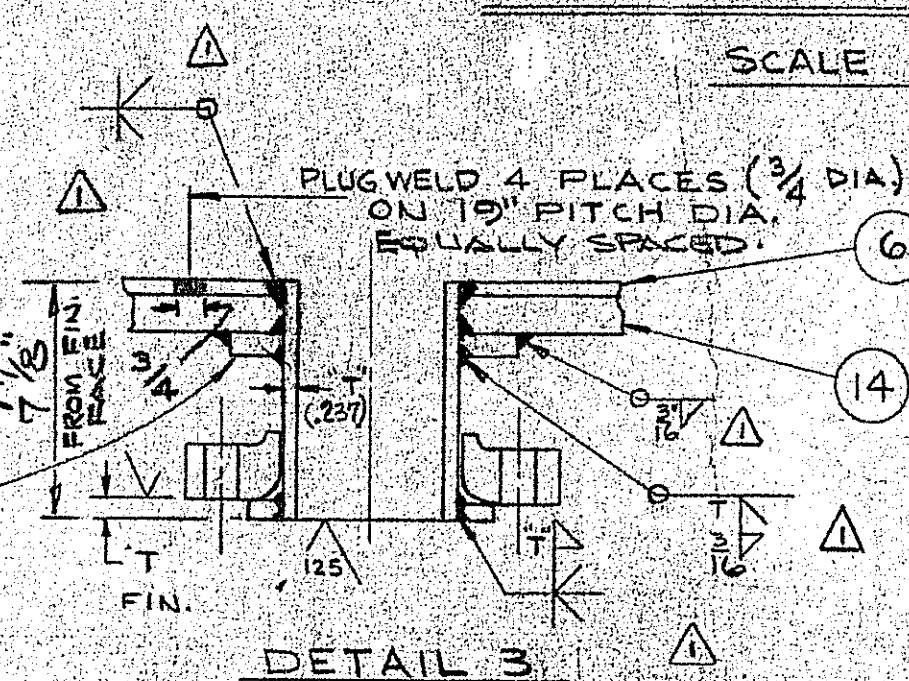
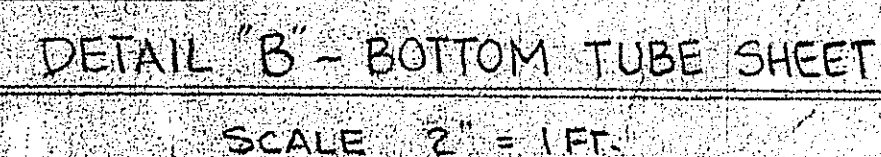
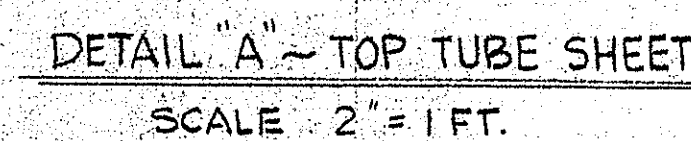


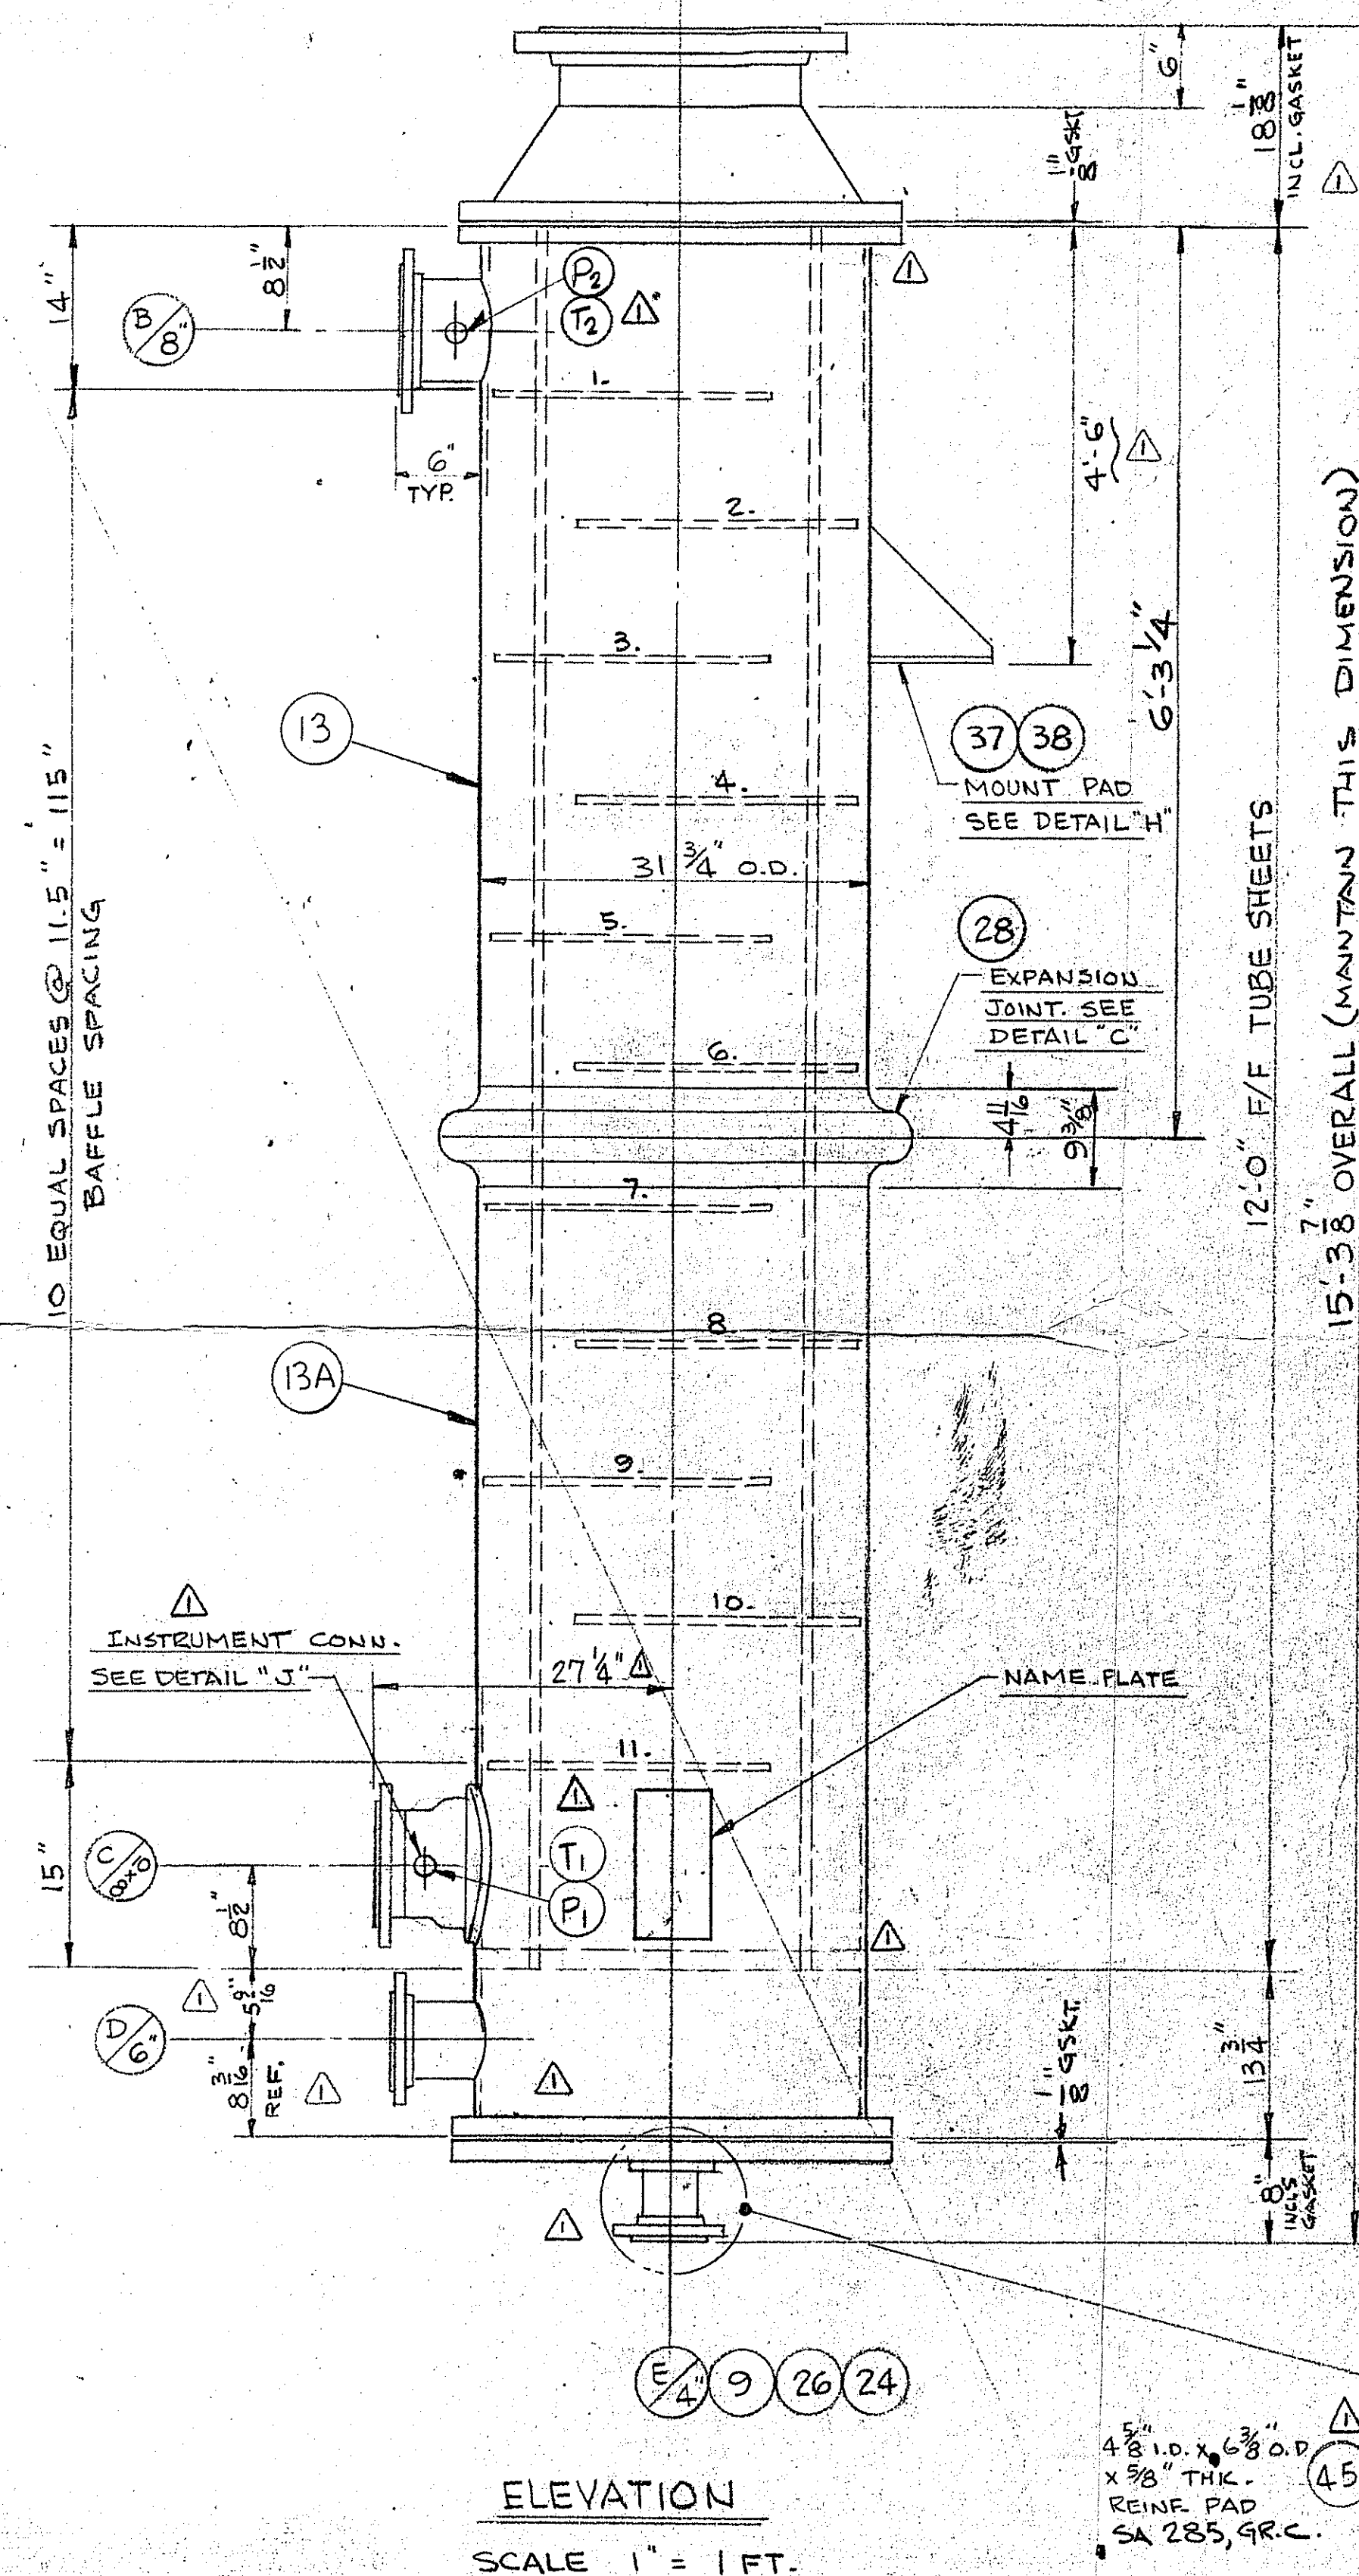

JOSEPH OAT & SONS, INCORPORATED

CHEMICAL ENGINEERS/DESIGNERS/FABRICATORS

CAMDEN, NEW JERSEY 08104

DATE STRIPPER CONDENSER
³/₄ O.D. X 15' ³/₈ O.A.L.
 PASS C/S ²/_{ND} 316 STL. CONSTR.
 1301 ASSEMBLY ²/_{ND} DETAILS

[FOR]

MERCURUS INCORPORATED
 HANOVER PLANT
 WILMINGTON, N.C.

ORDER NO. SEE TABLE NO. REQ'D. ONE

SEE ABLE	DRAWN: <i>CHAMBERS</i>	DRAWING NO.	REV.
	DATE: 3-28-72	5240	2