


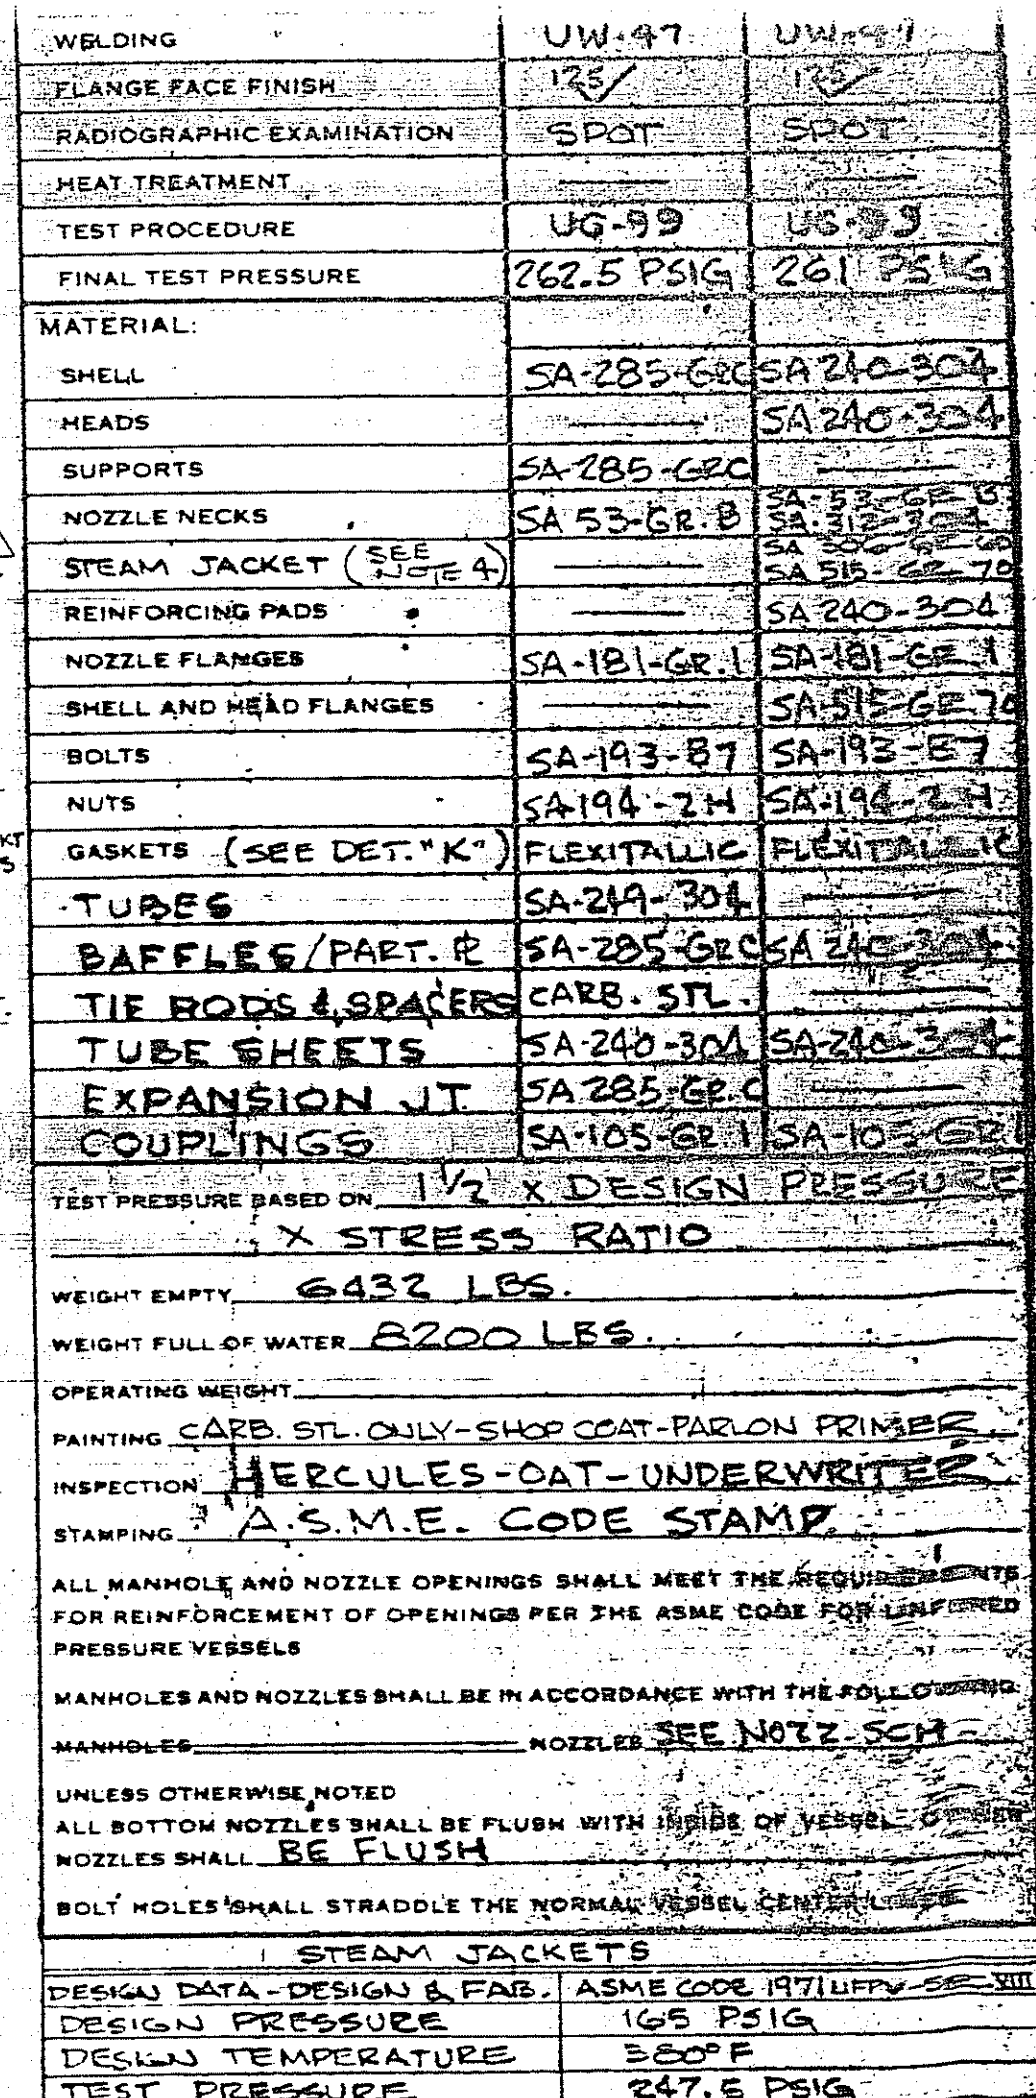

- NOTES:
- 1.) SEE DWG. 5259 FOR ADDITIONAL DETAILS.
 - 2.) SHIP ONE (1) SET OF SPARE GASKETS WITH VESSEL.
 - 3.) PAINT EQUIPEMENT NUMBER ON SIDE OF VESSEL. 4" HIGH LETTERS AND NUMBERS.
 - 4.) STEAM JACKET, Pcs. 46, 47 & 48
MATH. TO BE SA285 GR C

JAT JOB NO	ITEM NO.	P.O. NO.
J-2819 ^{3A} _{3B}	E-4513 ^{6A} _{6B}	026-35066
J-2127 ^{3A} _{3B}	E-6513 ^{6A} _{6B}	026-57026

10-7-72	△	ADDED PROJ. J-2121-3 ⁵ & TABULATION TABLE	2121-3 ⁵
8-31-72		ITS 46 & 47 WERE 5/16" TH. IT 48 WAS 1/2" TH. DIA. OF STM. TUB WAS 15 3/8". CW HEAD IT 21 REVISED MAT'L OF 3" STEAMCAT FROM 848555 ARCTO TO 524255 (AR) ADDED NOTE 4	IT 48 IT 21 ARCTO 524255 (AR)
8-22-72	△	ADDED STEAM JKT ITEMS 46 & 47 & 48 TO HEAD (IT 21). ADDED NOTE: Q2 & H2 3" x 3000" HCLP. CPL'S. Q & H ARE Q & H. STM. JKT. DESIGN DATA: CHANGED TO STM. JACKETS. Q & H. WAS 15 & 3 1/4".	IT 21 HCLP. CPL'S. STM. JACKETS Q & H
7-72	△	CHANNEL RLS. WELD 1/2" FILLET WAS 3/4". LAP RING TO BUNNET WELD ADDED BEVEL TO SYMBOL	CHANNEL RLS. WELD BUNNET WELD
7-72	△	ISSUED FOR APPROVAL	ISSUED FOR APPROVAL
DATE		REVISIONS #104327	BY



JOSEPH OAT & SONS, INCORPORATED
CHEMICAL ENGINEERS/DESIGNERS/FABRICATORS

ESTABLISHED 1788

CAMDEN, NEW JERSEY 08104

PURE MELTER HEATER
28 5/8" O.D. X 14'-11 3/8" O.A.L.
PASS C/S ~ 304 STN. STL. CONSTR.
ASSEMBLY & DETAIL

FOR
HERCULES, INCORPORATED
HANOVER PLANT
WILMINGTON, N.C.

PURCHASE ORDER NO. SEE TABLE		NO. REQ'D. 1	
JOB NO. SEE TABLE	DRAWN <i>R. HINES</i> DATE: 4-18-72 CHK'D: <i>JRC</i>	DRAWING NO. 5258	REV. 1

--	--	