

DAEKYUNG MACHINERY & ENGINEERING CO., LTD.


MOODY
INTERNATIONAL
10/8/08
Witnessed
Reviewed

☒ WITNESSED BY / ☐ REVIEWED BY

APPROVED BY [Signature]
REVIEWED BY [Signature]
PREPARED BY 2/15 2008.10.8

 **DAEKYUNG MACHINERY & ENGINEERING CO., LTD.**

ORDER NO.	U2007-09-2739	CUSTOMER	SUNCOR ENERGY INC.	<
-----------	---------------	----------	--------------------	---

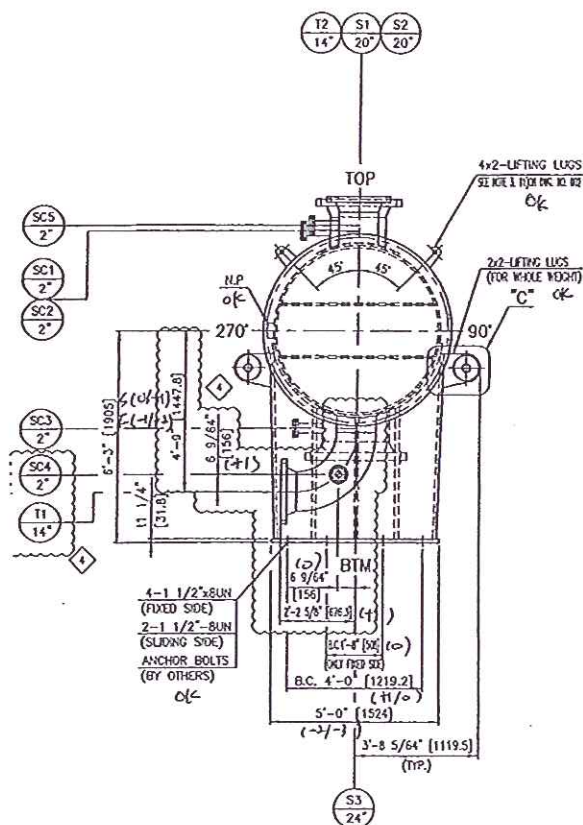

See Nozzle Report for nozzle projections

Reviewed by _____
witnessed by 9 OCT. 8th '61
AI/HSB



6-5 W
10/8 '68

F2


☒ WITNESSED BY / ☐ REVIEWED BY

APPROVED BY [Signature]
REVIEWED BY [Signature]
PREPARED BY 26-10-8.10.8

105819

DAEKYUNG MACHINERY & ENGINEERING CO., LTD.

ORDER NO.	U2007-09-2739	CUSTOMER	SUNCOR ENERGY INC.	DATE	2008.10.14	UNIT	mm
ITEM NO.	205E-400	ITEM NAME	COMPRESSOR DISCHARGE COOLER	DIMENSION REPORT AND VISUAL INSPECTION			
DWG. NO.	DK2007-231-001 Rev.4B	PCS/STEPNO.	-	RESULT OF INSPECTON			
				DIMENSIONAL	VISUAL	NOZZLE OPERATION	
				ACCEPT	ACCEPT		

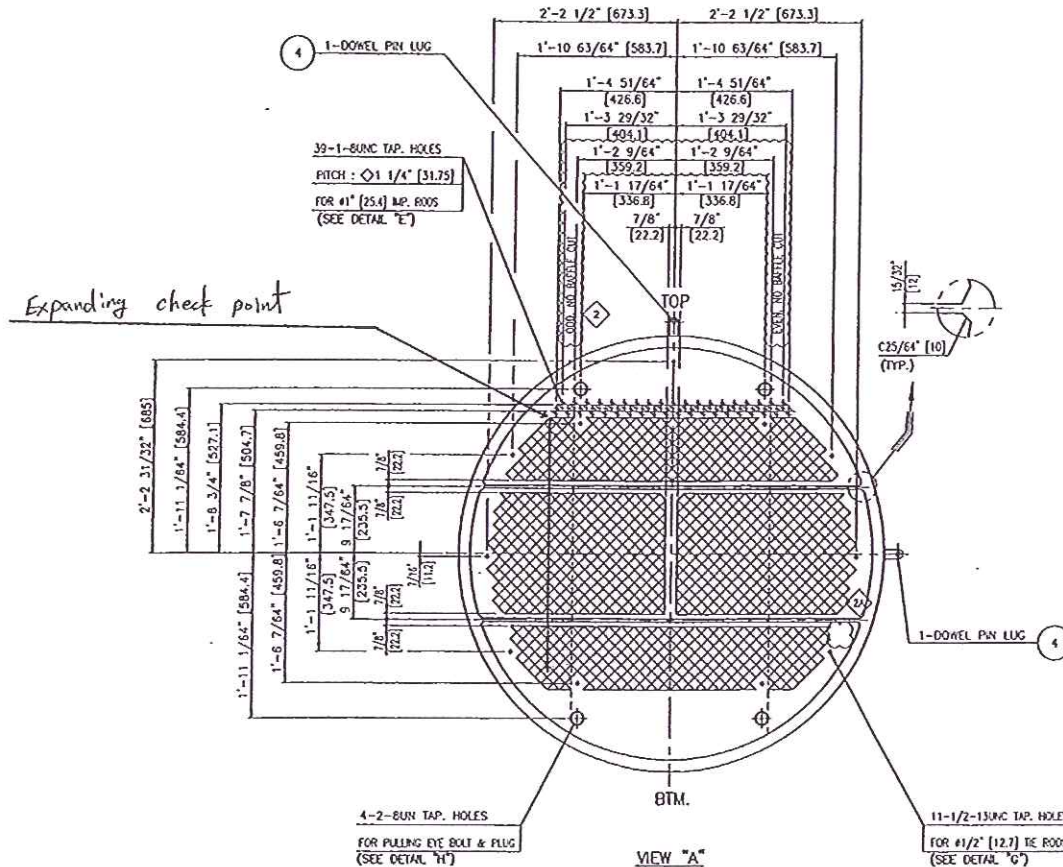

G-S Kim
10/14/08

Witnessed
Reviewed

71
8

WITNESSED BY / REVIEWED BY

APPROVED BY *[Signature]*
REVIEWED BY *[Signature]*
PREPARED BY *[Signature]* 2008.10.14