

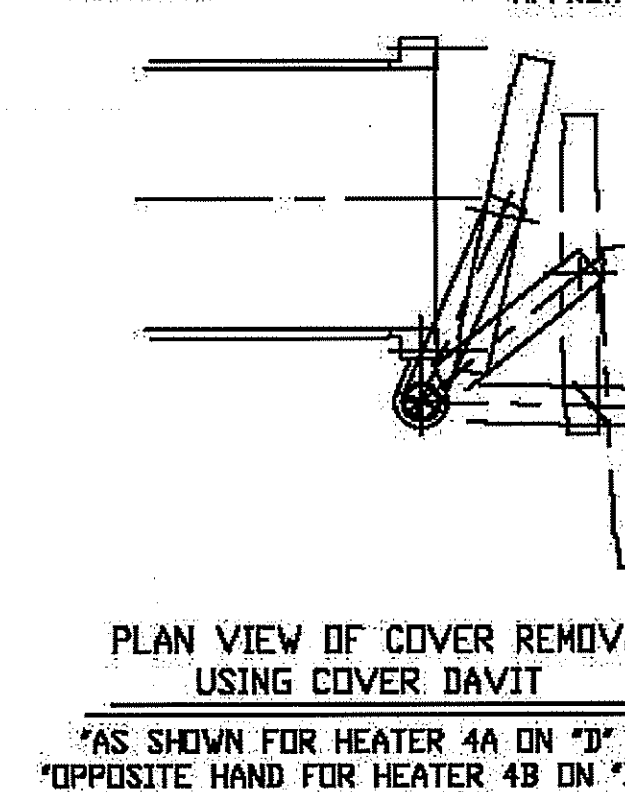
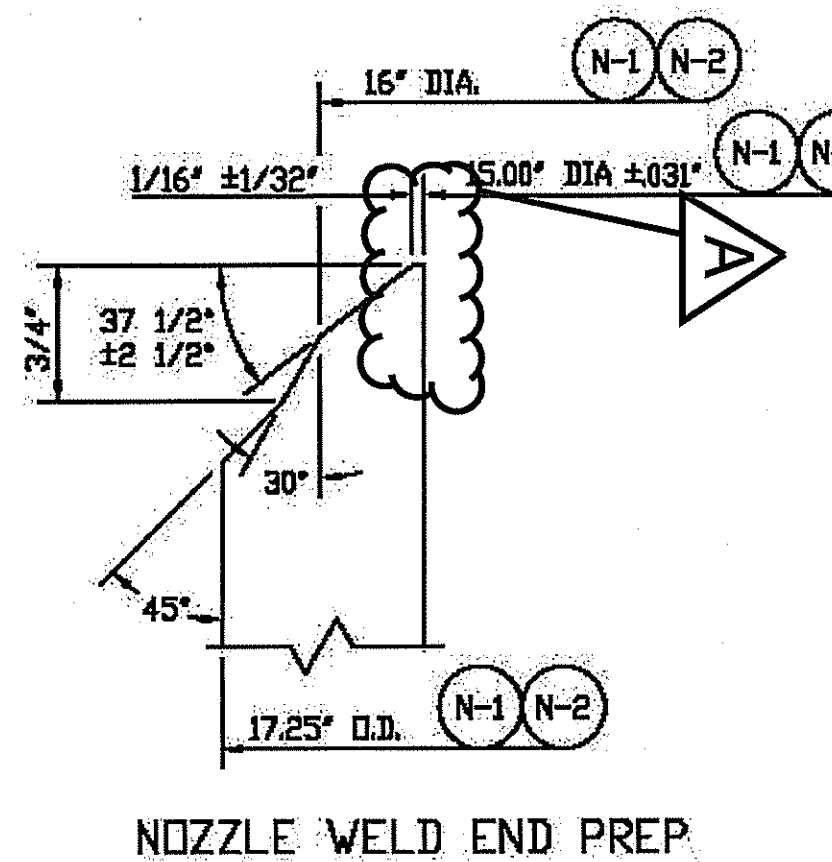
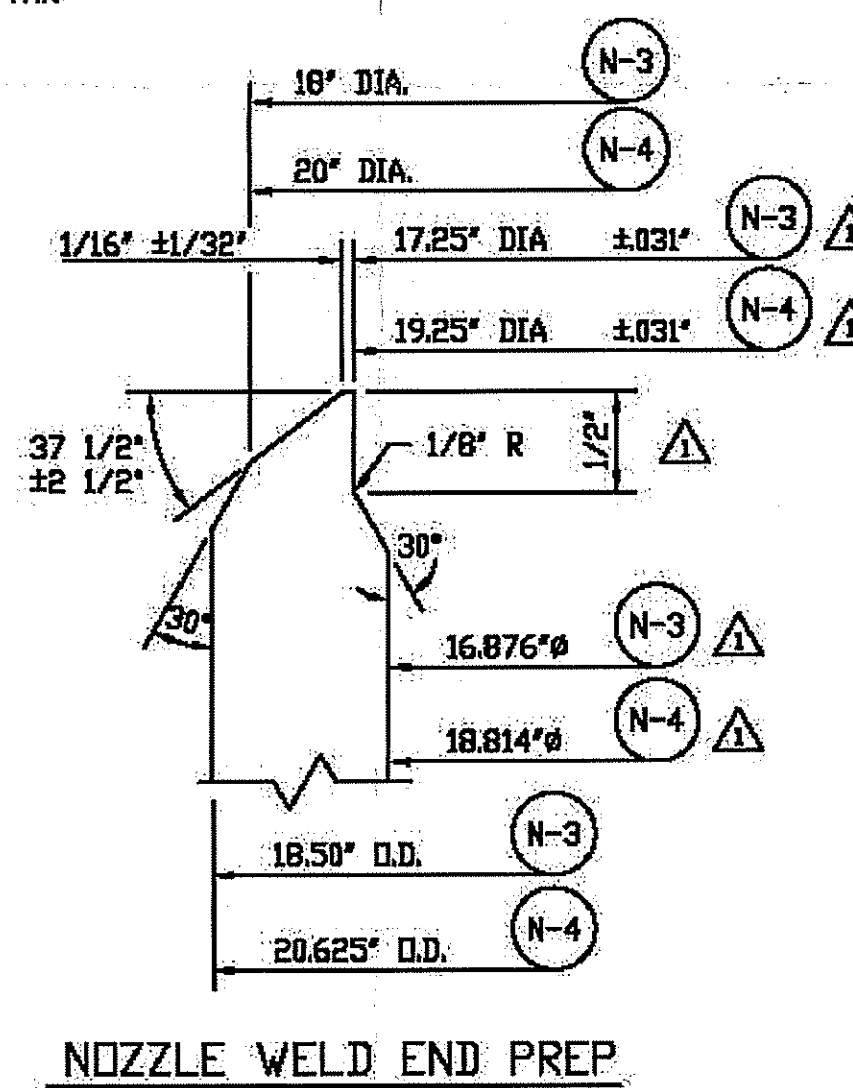
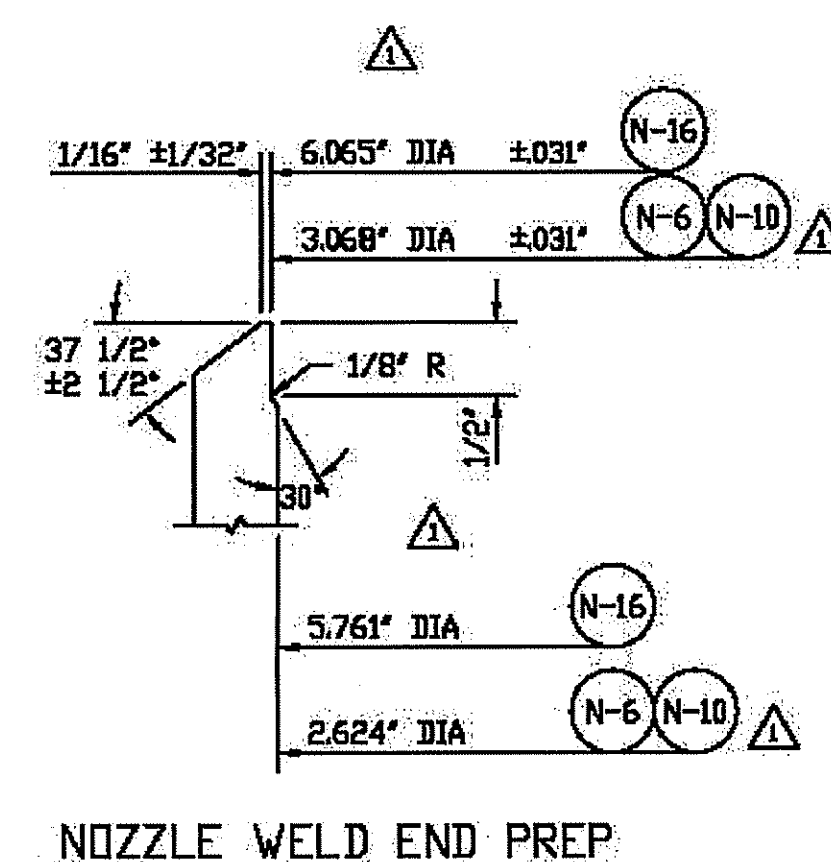
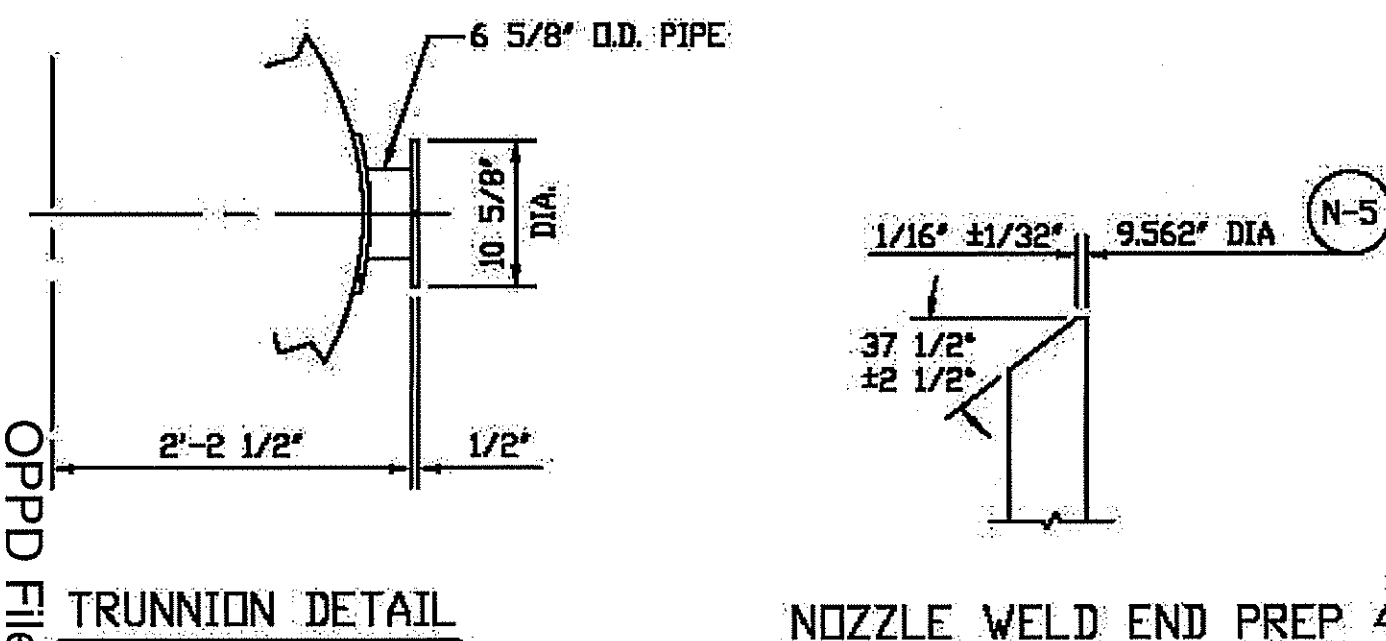
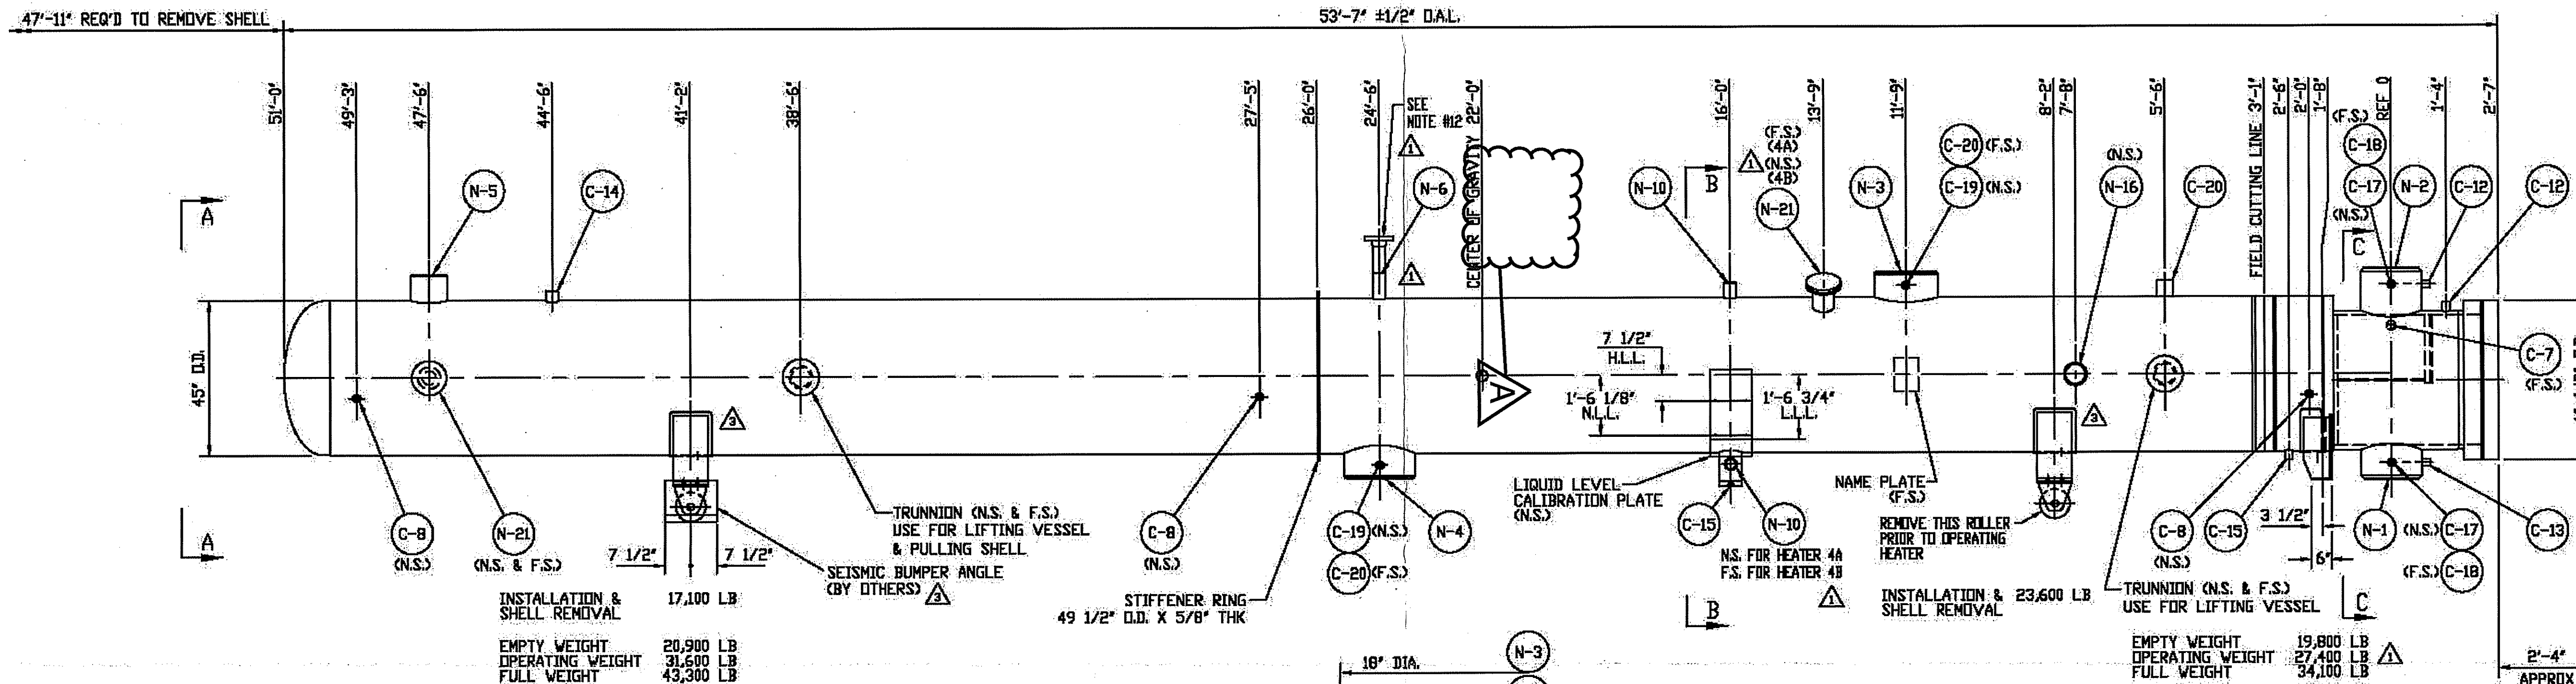
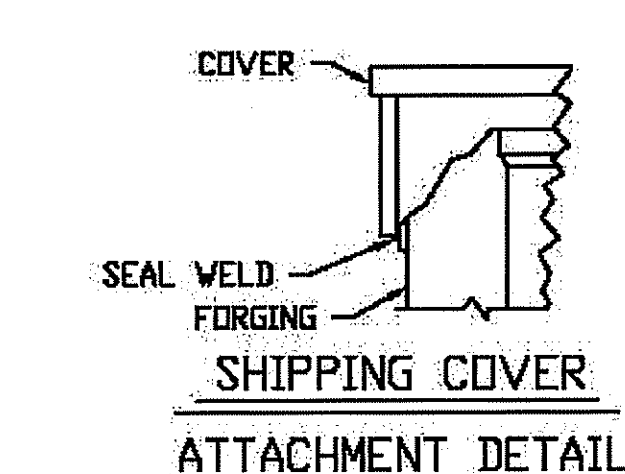
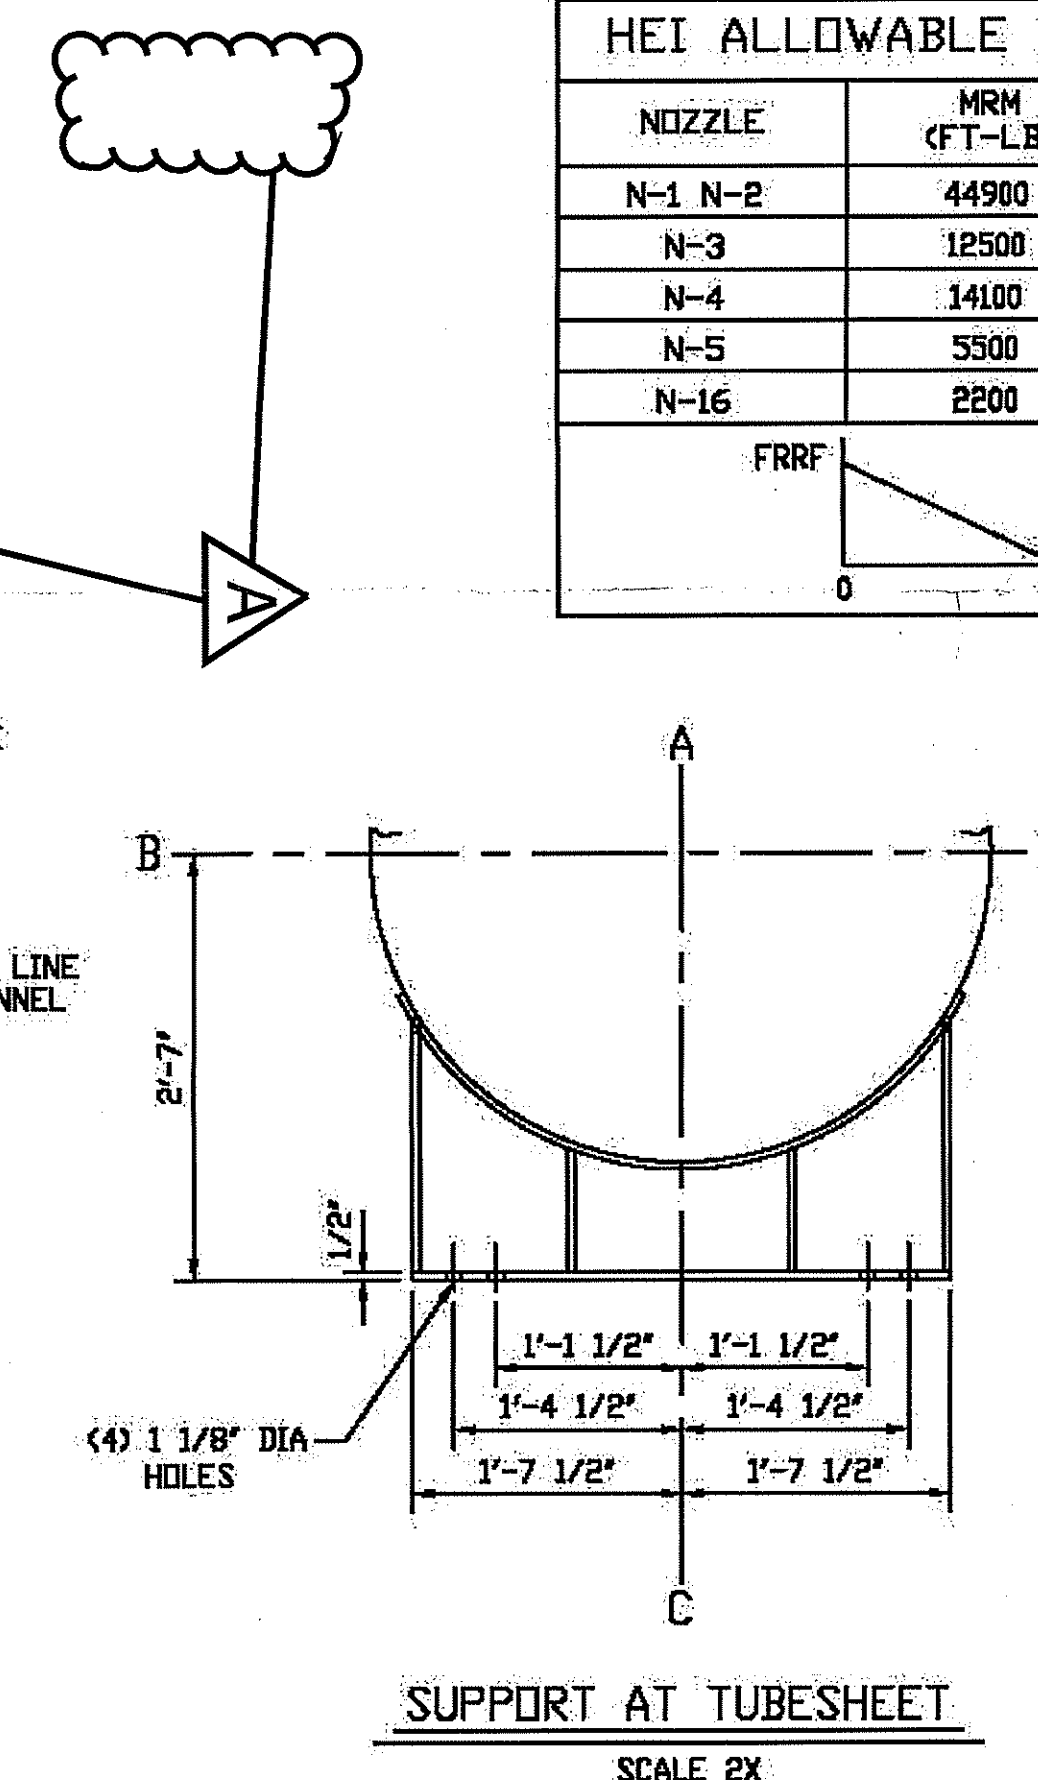
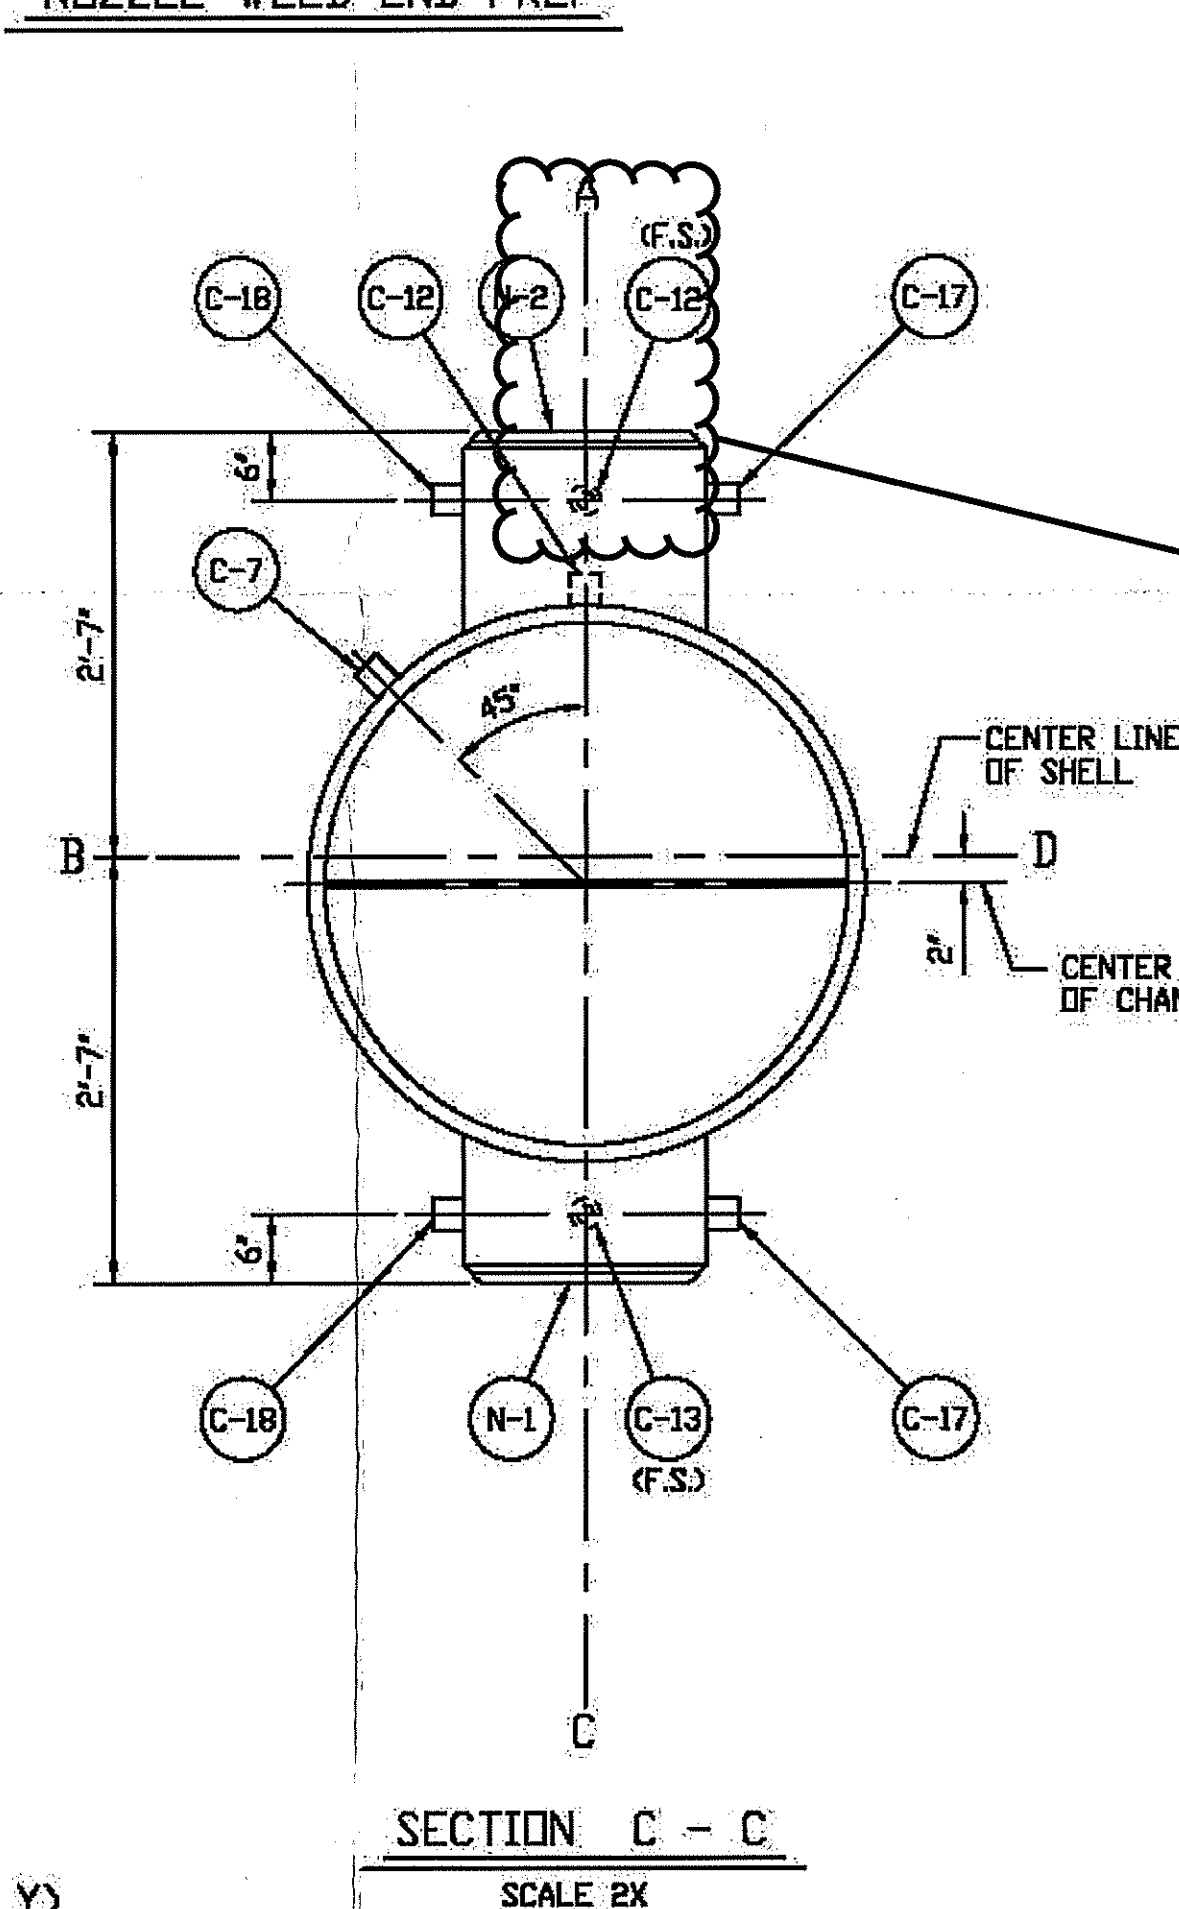


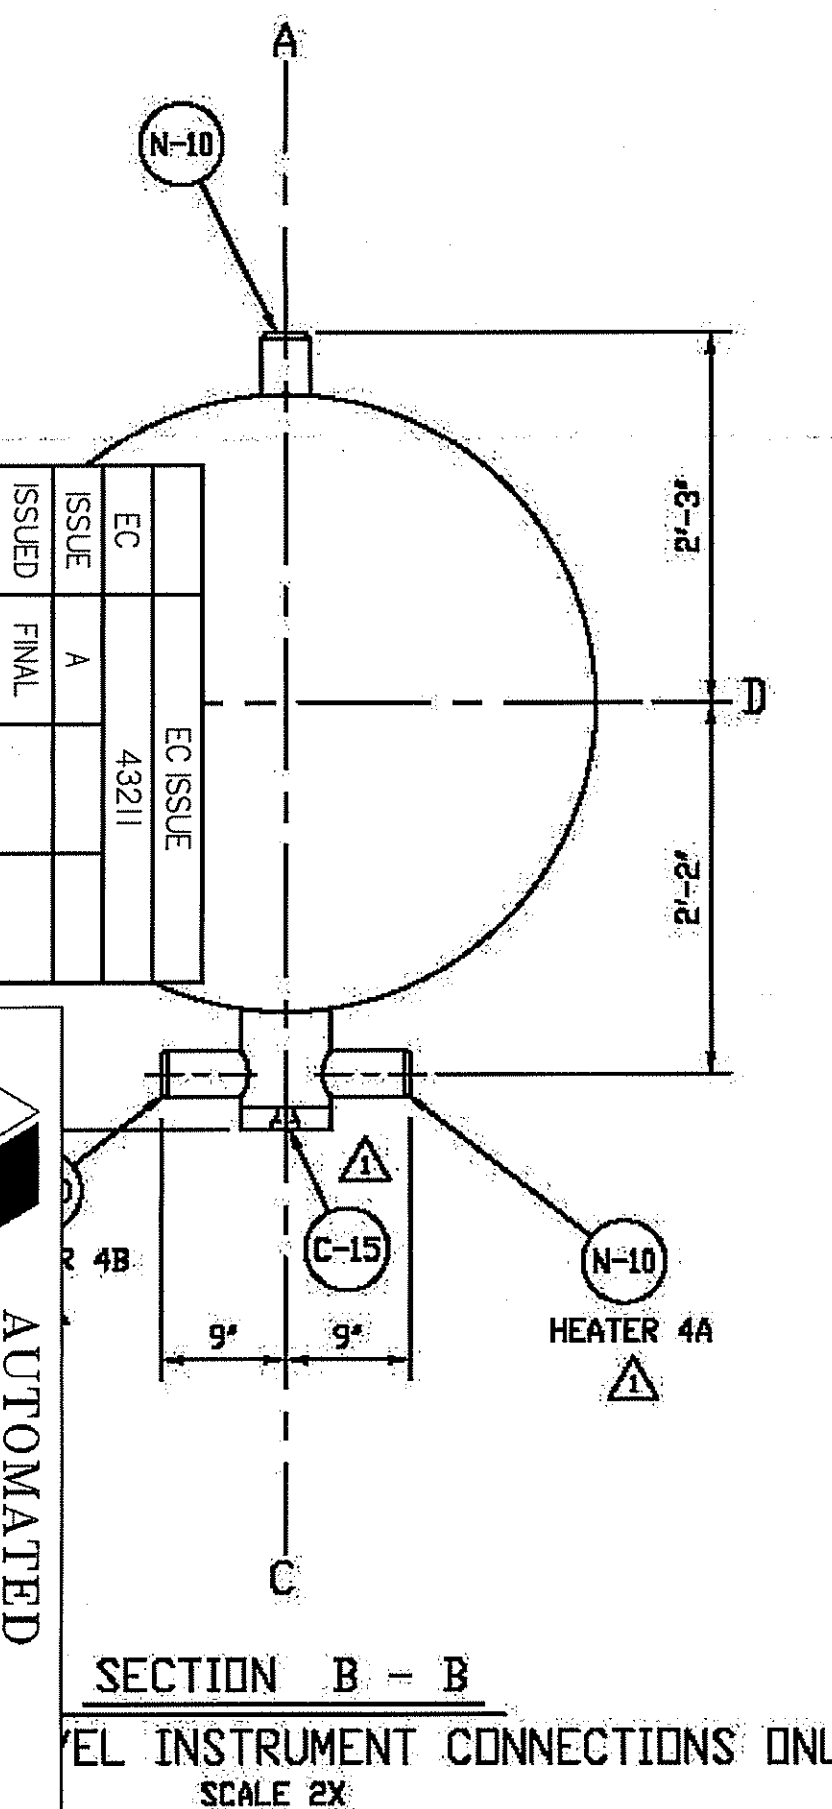

HEI ALLOWABLE NOZZLE LOADS		
NOZZLE	MRM (FT-LB)	FRRF (LB)
N-1 N-2	44900	46100
N-3	12500	18900
N-4	14100	23200
N-5	5500	7200
N-16	2200	4500

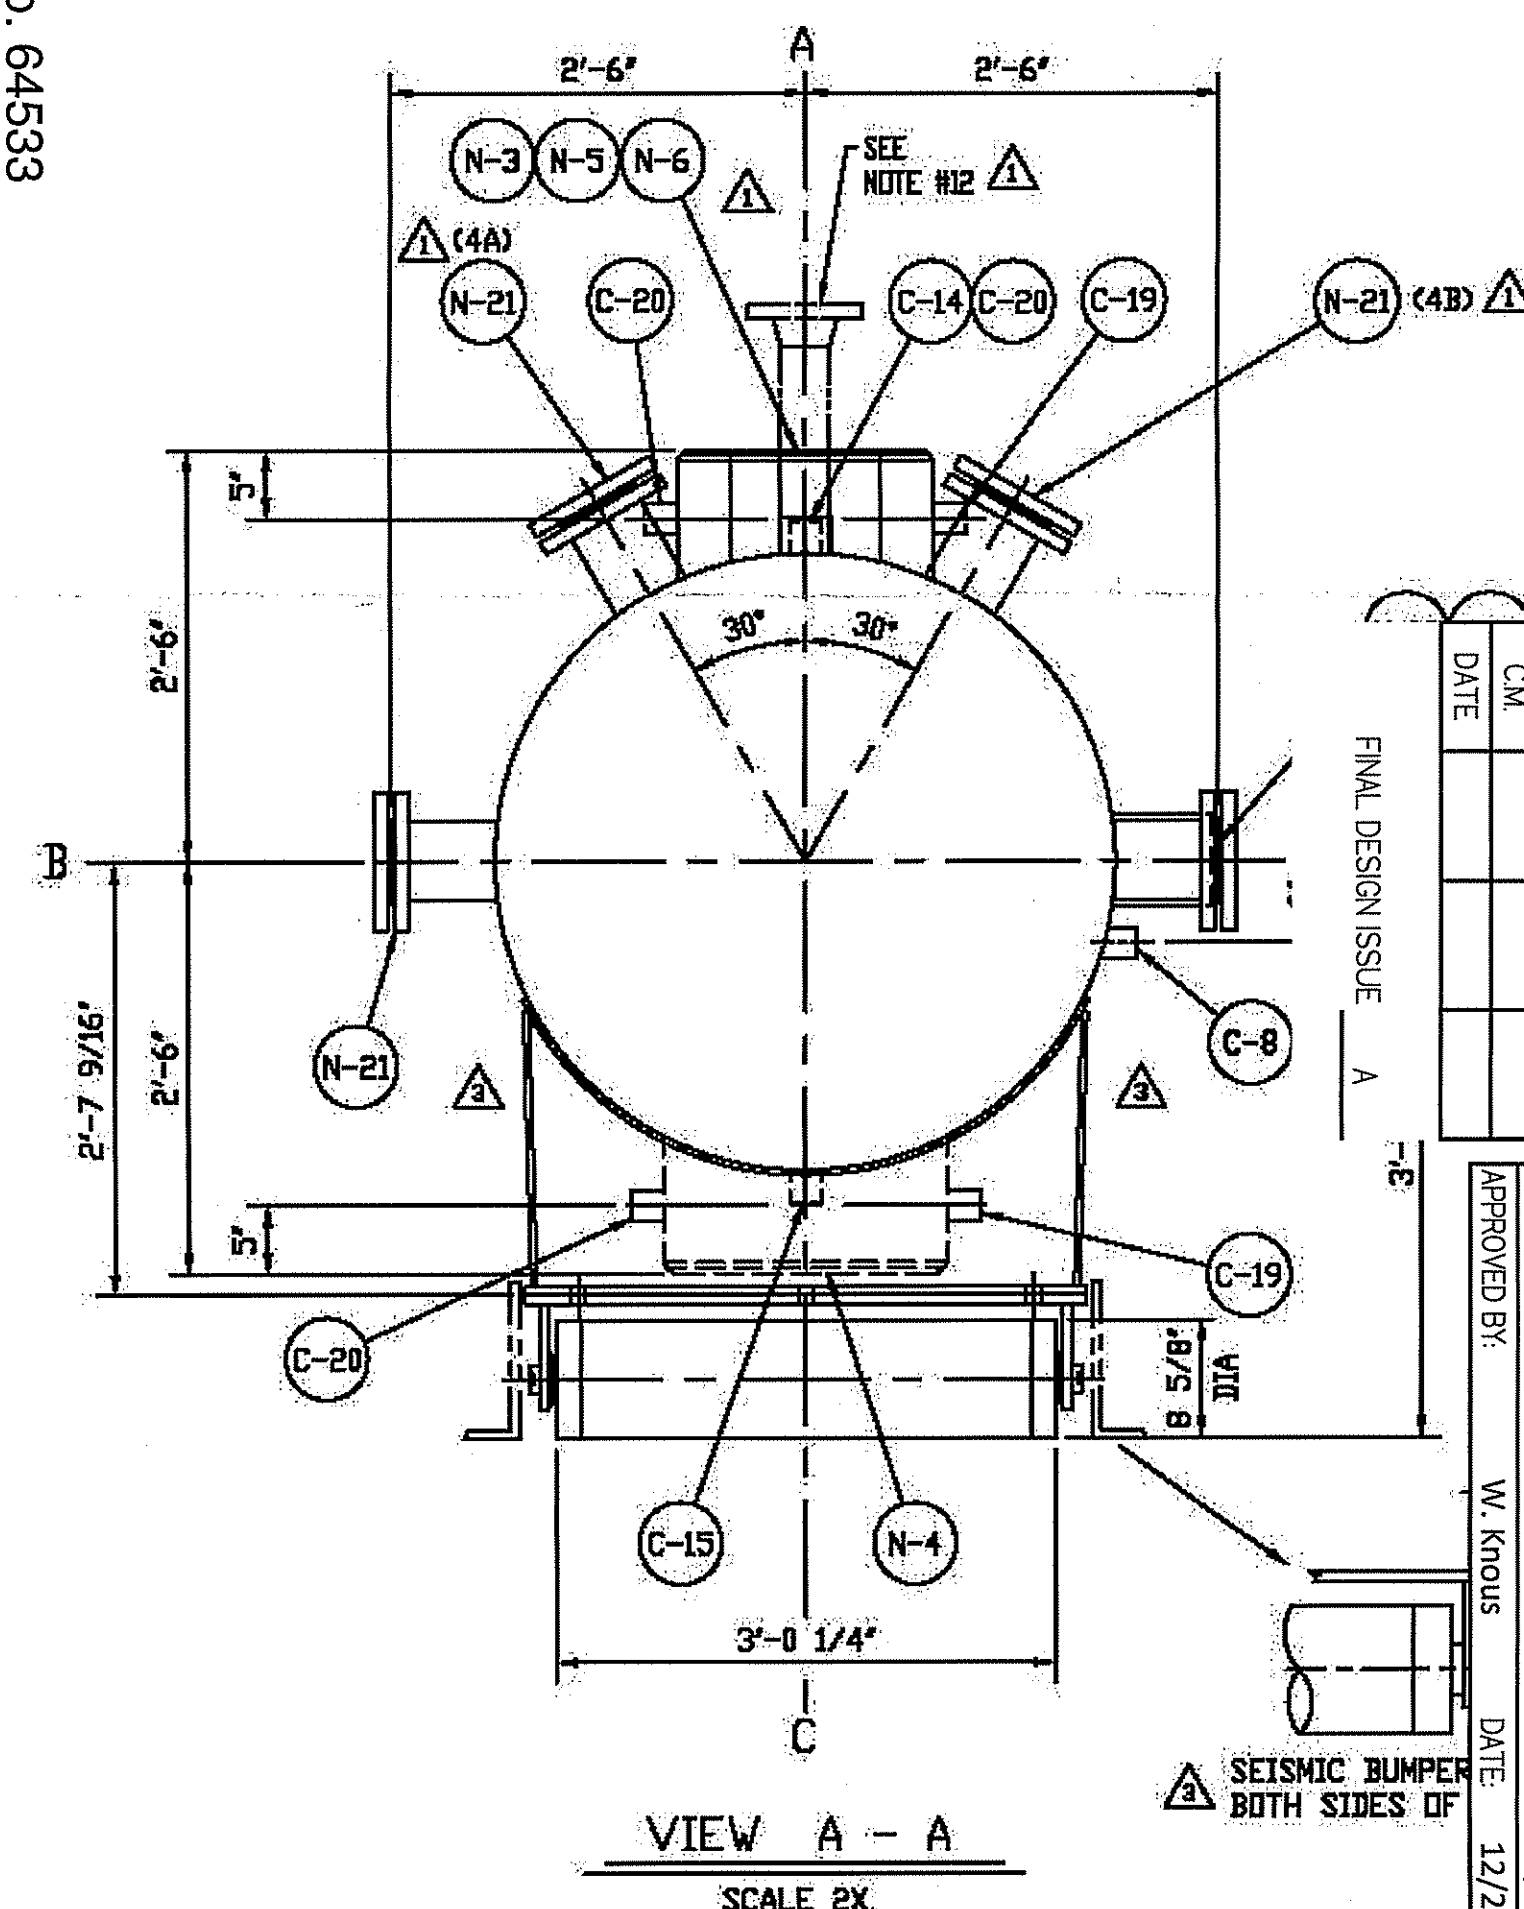

NORMAL OPERATING RANGE	
TEMPERATURE	1" NORMAL LIQUID LEVEL
DO NOT USE FOR ALARM POINTS	
STORED VOLUMES IN SHELL	
STEAM 366 CU. FT.	
SATURATED LIQUID 65 CU. FT.	
SUB COOLED LIQUID N/A	
CERTIFIED CORRECT FOR FABRICATION	
BY: Yubra Sylla	
DATE: 8/1/2011	

- GENERAL NOTES
- ALL BOLT HOLES ARE TO STRADDLE CENTERLINES.
 - ALL COUPLINGS ARE 6000 LB. AND PLUGGED.
 - TUBES ARE WELDED AND EXPANDED INTO TUBESHEET.
 - TUBES ARE 3/4" O.D. X .035" AVG. WALL, CSA-688-TP304L.
 - BLAST EXTERIOR AND PAINT ONE COAT OF SHOP PRIMER.
 - SHIP UNDER NITROGEN SEAL.
 - UNLESS OTHERWISE NOTED, ALL DIMENSIONS ARE WITHIN TOLERANCES SPECIFIED BY THE HEAT EXCHANGER INSTITUTE STANDARDS FOR CLOSED FEEDWATER HEATERS.
 - START UP TEST VENT SHOULD NOT BE USED DURING NORMAL OPERATION.
 - SAFETY RELIEF VALVES SHOULD BE INSTALLED IN A VERTICAL POSITION.
 - HEATER MUST BE VENTED THROUGH THE OPERATING AIR OUTLETS DURING OPERATION. THREE CRITICAL FLOW ORIFICE ASSEMBLIES WITH 1-300 LB RF FLANGES.
 - SHIP LOOSE ORIFICE DIAMETERS ARE 1/4".
 - REACTION LOADS SHOWN ARE THE MAXIMUM POSSIBLE WITH THE WEIGHT OF THE VESSEL SUPPORTED AT TWO POINTS.
 - INSULATION CLIPS WELDED ON 18" CENTERS.
 - 3"-300# RF. STUB FOR N-6 NOZZLE SUPPLIED AND WELDED AT SITE BY OTHERS.

REV.	DATE	DESCRIPTION
1	9/7/11	REVISED ROLLER SUPPORT AS NOTED
2	8-15-11	REVISED UNIT NUMBER PER CUSTOMER COMMENT
3	7-15-11	REV. PER CUSTOMER COMMENTS

NOZZLE SCHEDULE			
NOZZLE NO.	SIZE AND RATING	TYPE	APPLICATION
N-1	16" FORG	W.E.	FEEDWATER INLET
N-2	16" FORG	W.E.	FEEDWATER OUTLET
N-3	18" FORG	W.E.	STEAM INLET
N-4	20" FORG	W.E.	DRAINS OUTLET
N-5	10" PIPE	W.E.	DRAINS INLET
N-6	3" PIPE	W.E.	SHELL SAFETY RELIEF VALVE
C-7	3/4"	S.W.	CHANNEL SAFETY RELIEF VALVE
C-8	3"	S.W.	OPERATING AIR OUTLET
N-10	2 3"	W.E.	GAUGE GLASS CONNECTION
C-12	2 1"	S.W.	LIQUID LEVEL INSTRUMENT CONN
C-13	1"	S.W.	HIGH LIQUID LEVEL CONTROL
C-14	1"	S.W.	CHANNEL START UP TEST VENT
C-15	2 1 1/2"	S.W.	CHANNEL DRAIN
N-16	1 6"	W.E.	SHELL START UP TEST VENT
C-17	2 1"	S.W.	HEATER DRAIN TANK VENT
C-18	2 1"	S.W.	TEMPERATURE CONNECTION
C-19	2 1"	S.W.	PRESSURE GAUGE CONNECTION
C-20	3 1"	S.W.	TEMPERATURE CONNECTION
N-21	3 4"-300 LB	RF. FLG	PRESSURE GAUGE CONNECTION

CONSTRUCTION		
CODE: ASME SECTION VIII DIV.1, 2010, CODE STAMP RECD: YES		
DESIGN DATA	SHELL SIDE	TUBE SIDE
DESIGN PRESSURE	250 PSI & F.V.	700 PSI
TEST PRESSURE	325 PSI	910 PSI
DESIGN TEMPERATURE	420° F.	420° F.
NUMBER OF PASSES OR ZONES	ONE ZONE	TWO PASS
CORROSION ALLOWANCE	1/16"	1/8"
VESSELS REQUIRED PER UNIT TWO	TOTAL UNITS ONE	
EFFECTIVE SURFACE	10,761 SQ. FT. PER VESSEL	
60° F. MIN. DESIGN METAL TEMPERATURE		
POST WELD HEAT TREAT: SHELL AND SKIRT		
RADIOGRAPHY		
SPUT: SHELL, SKIRT AND CHANNEL	EMPTY	40,700 LB
	FULL	77,400 LB
	BUNDLE	28,100 LB
	OPERATING	59,000 LB
FULL: NONE		
CUSTOMER PURCHASE ORDER NUMBER	159609	
Yuba SPX HEAT TRANSFER INC.		
2121 N. 161st E. Ave. TULSA, OKLAHOMA 74116		
SETTING PLAN		
44-574 LOW PRESSURE FEEDWATER HEATER NO. 4A & 4B		
HORIZONTAL ITEM FW-14A & FW-14B		
UNIT NO. 1		
OMAHA PUBLIC POWER DISTRICT		
FORT CALHOUN STATION		
DATE	SCALE	REV.
5/11/11	NONE	3