

Cooper-Bessemer Company

Applied Mechanics Report

AM-3371

~~106377~~
106377
1063777

Celanese Chemical Company

RFB-24

SO-4555


MO-987RC

Torsional results are presented.

Submitted by

R. W. Harvey

November 7, 1974

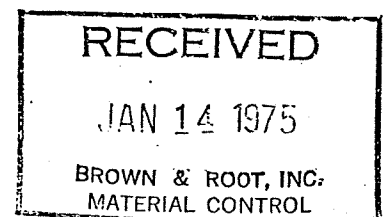

AM-3371
11-7-74

This RFB-24 compressor, rated 3900 hp at 5320 rpm, will be driven by a Turbodyne steam turbine, which has a design speed range of 4400 to 6070 rpm. The main drive coupling will be a Zurn 103 FEL Amerigear coupling.

The predicted torsional natural frequencies are:

Mode	Frequency, cpm
1	3,650
2	23,040

This unit will be satisfactory torsionally.

Submitted by

R. W. Harvey
R. W. Harvey


/n

Approved by

J. W. Roeder
J. W. Roeder

Distribution:

A. A. Albright (3)
AM-3371

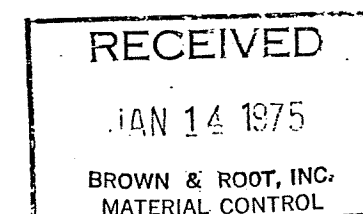

COOPER-BESSEMER COMPANY
Centrifugal Compressor Design Report

Celanese Chemical Company

RFB-24

SO-4555

MO-987RC

Lateral Results Are Presented

By R. H. Meier

November 21, 1974

RECEIVED

JAN 14 1975

BROWN & ROOT, INC.
MATERIAL CONTROL


The rotor system of this centrifugal compressor was analyzed for lateral natural frequency response.

This rotor system is of a single stage, overhung mass design and includes half of the complete drive coupling (Zurn 103 FEL Amerigear). In service, this rotor system is designed to operate continuously between 4400 and 6070 RPM.

The theoretical analysis indicates a first bending mode to occur at 7885 RPM. This is based on the realistic assumptions of total equivalent dynamic support stiffnesses of 600000 and 200000 lbs/in for impeller end and drive end bearings respectively.

Considering both lateral natural frequencies and operating speed range, this compressor rotor system will operate satisfactorily.


Submitted by

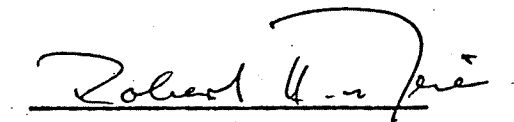

R. H. Meier

/php


NORMAL OPERATIONS (WITH 4000 rpm Plotted)

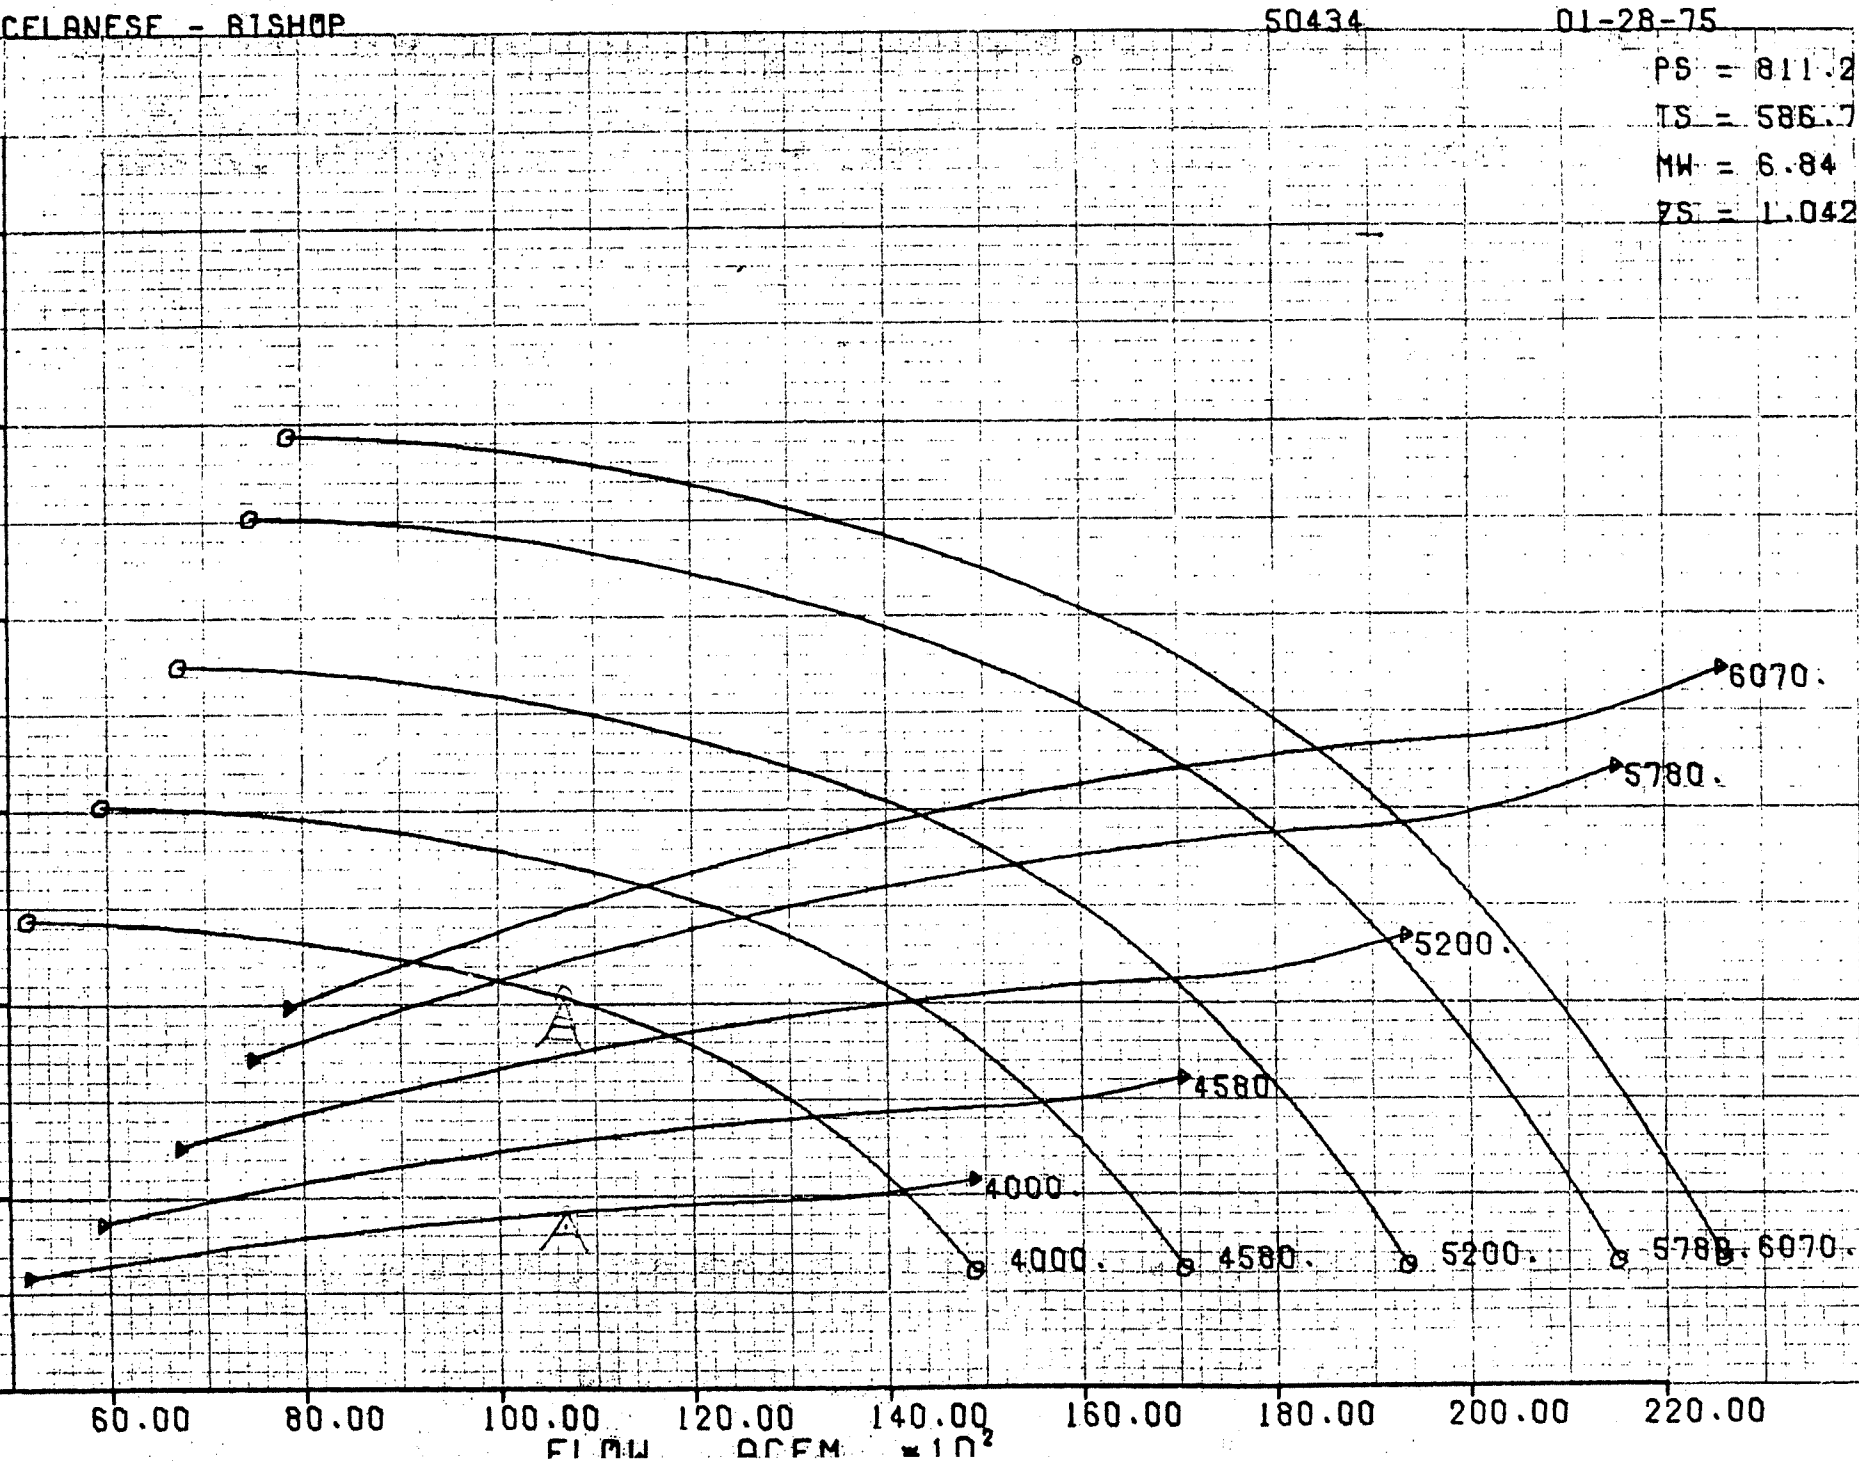


File:
Peyote Compressor
Book

NORMAL OPERATIONS

PS = 811.2 = 796.5 psig
TS = 586.7 = 126.7°F
MW = 6.84
LS = 1.042

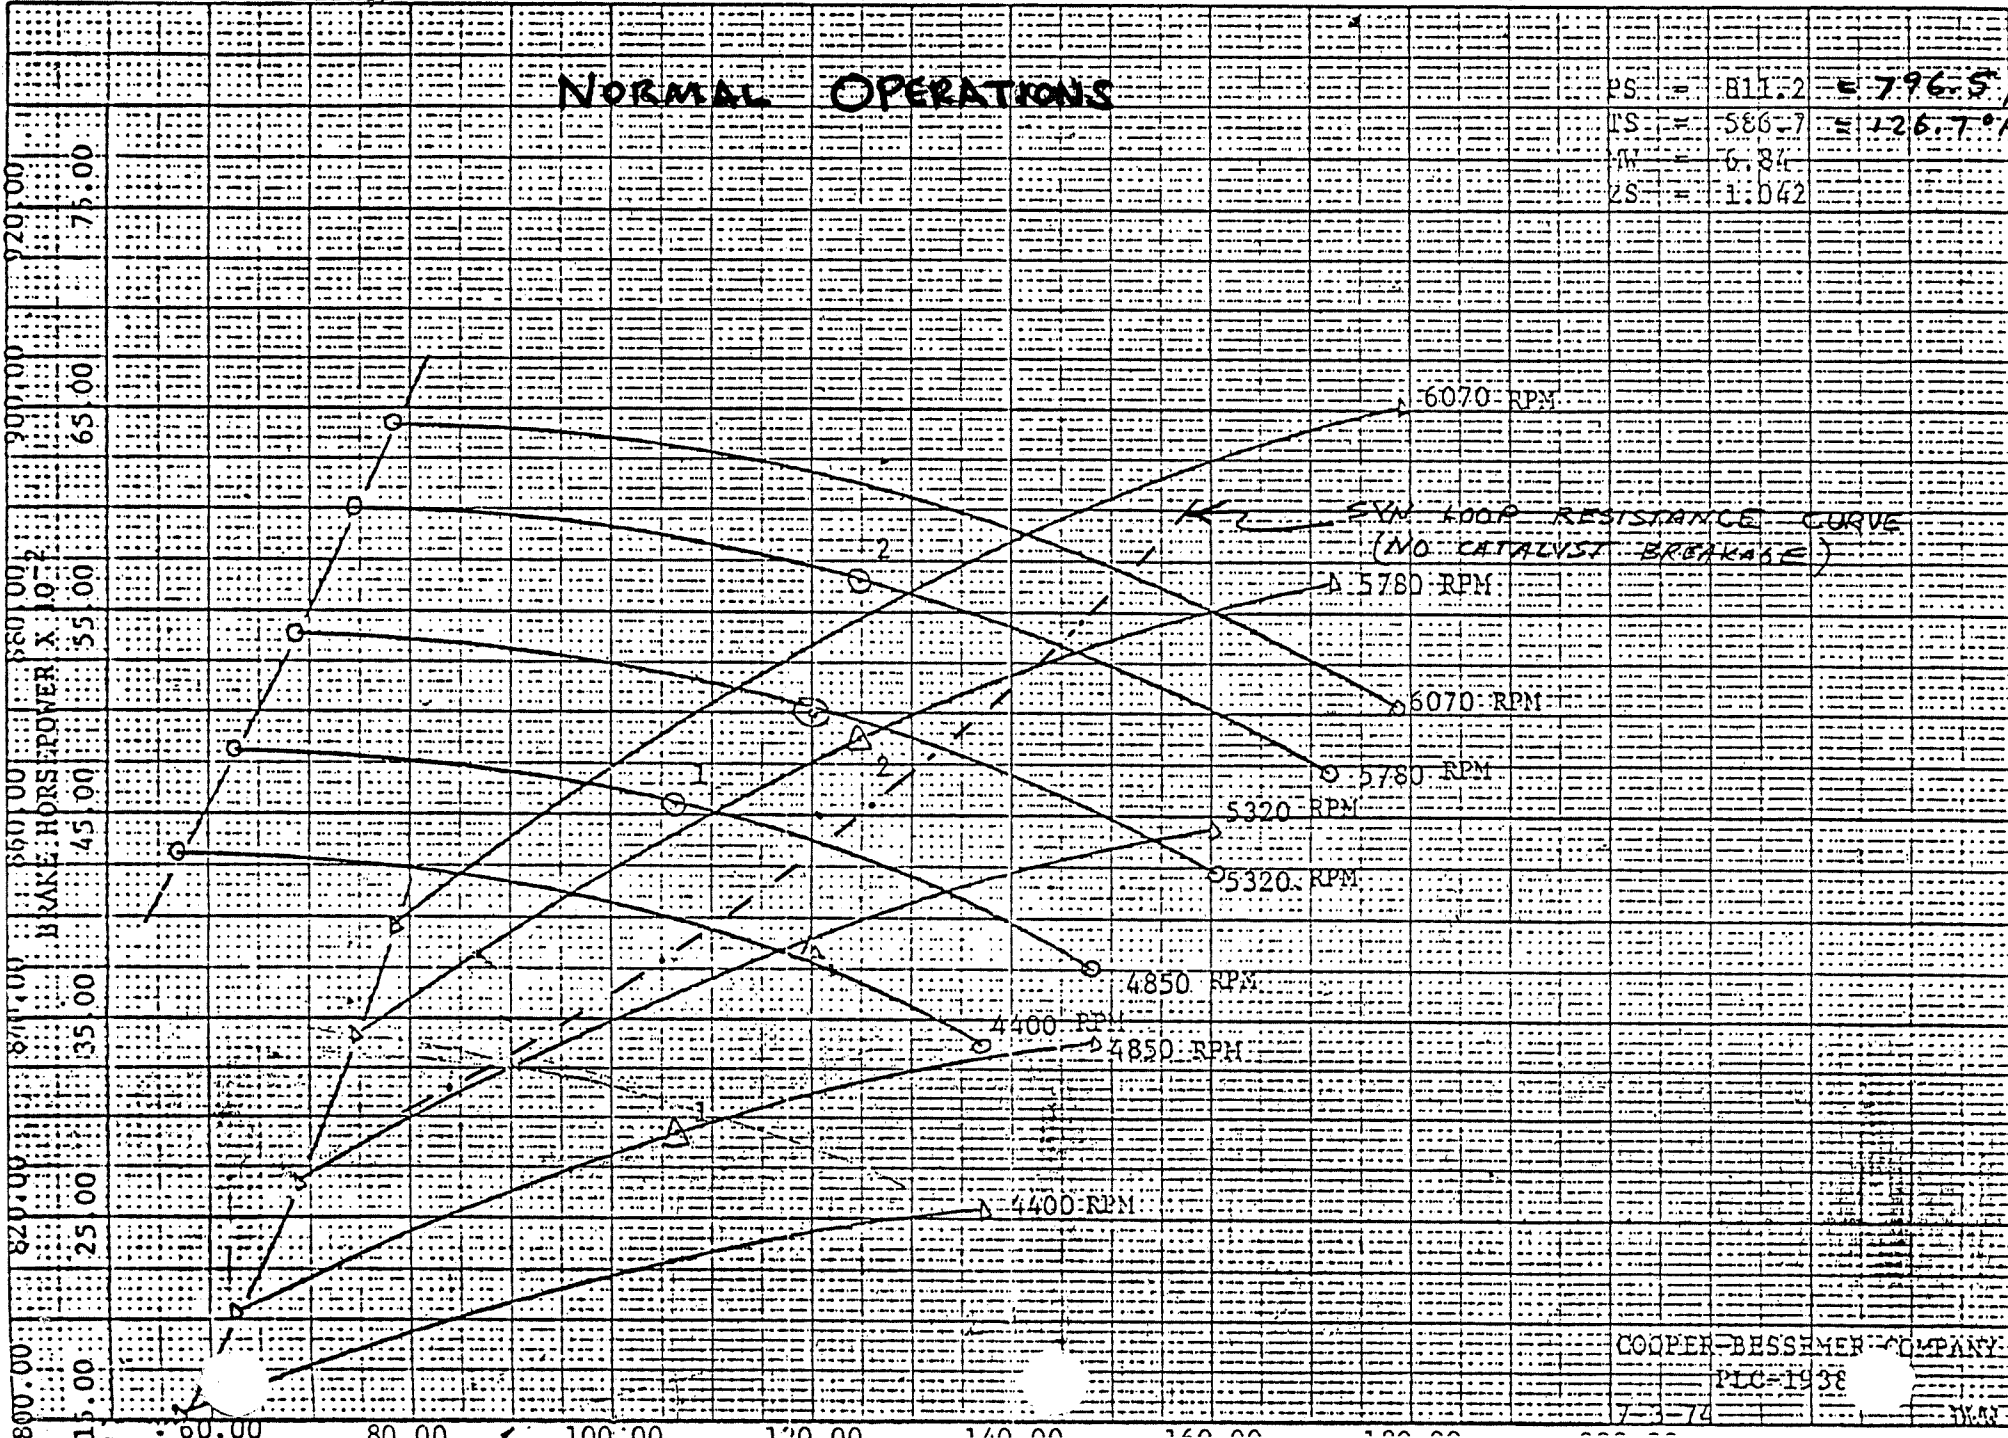


NORMAL OPERATIONS

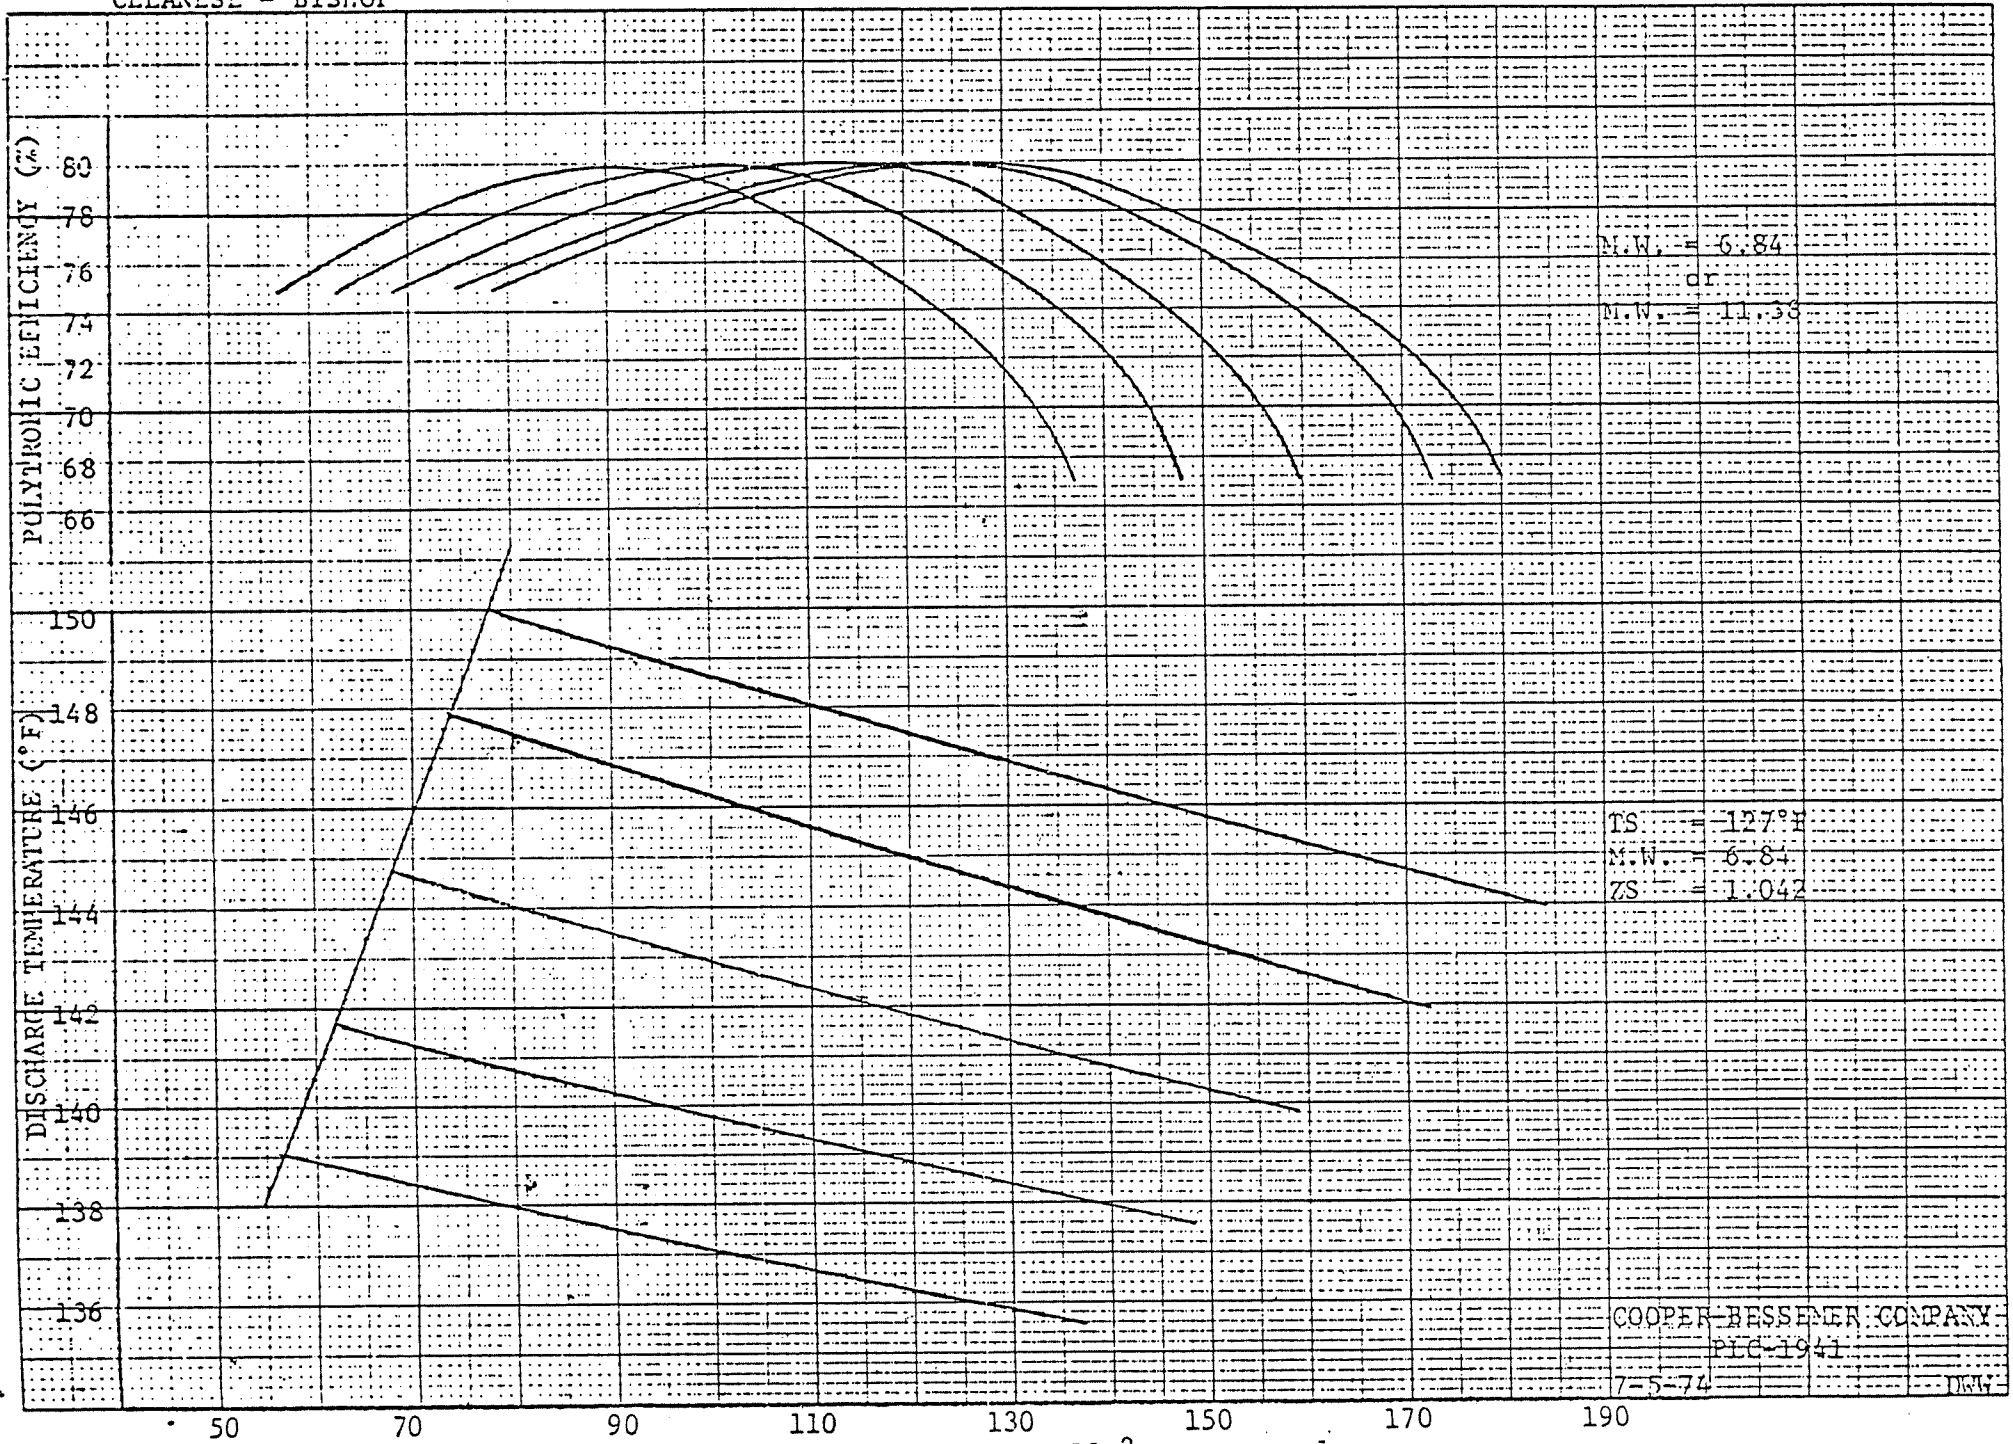


CELANESE - BISHOP NITROGEN

N₂ @ 90 psig

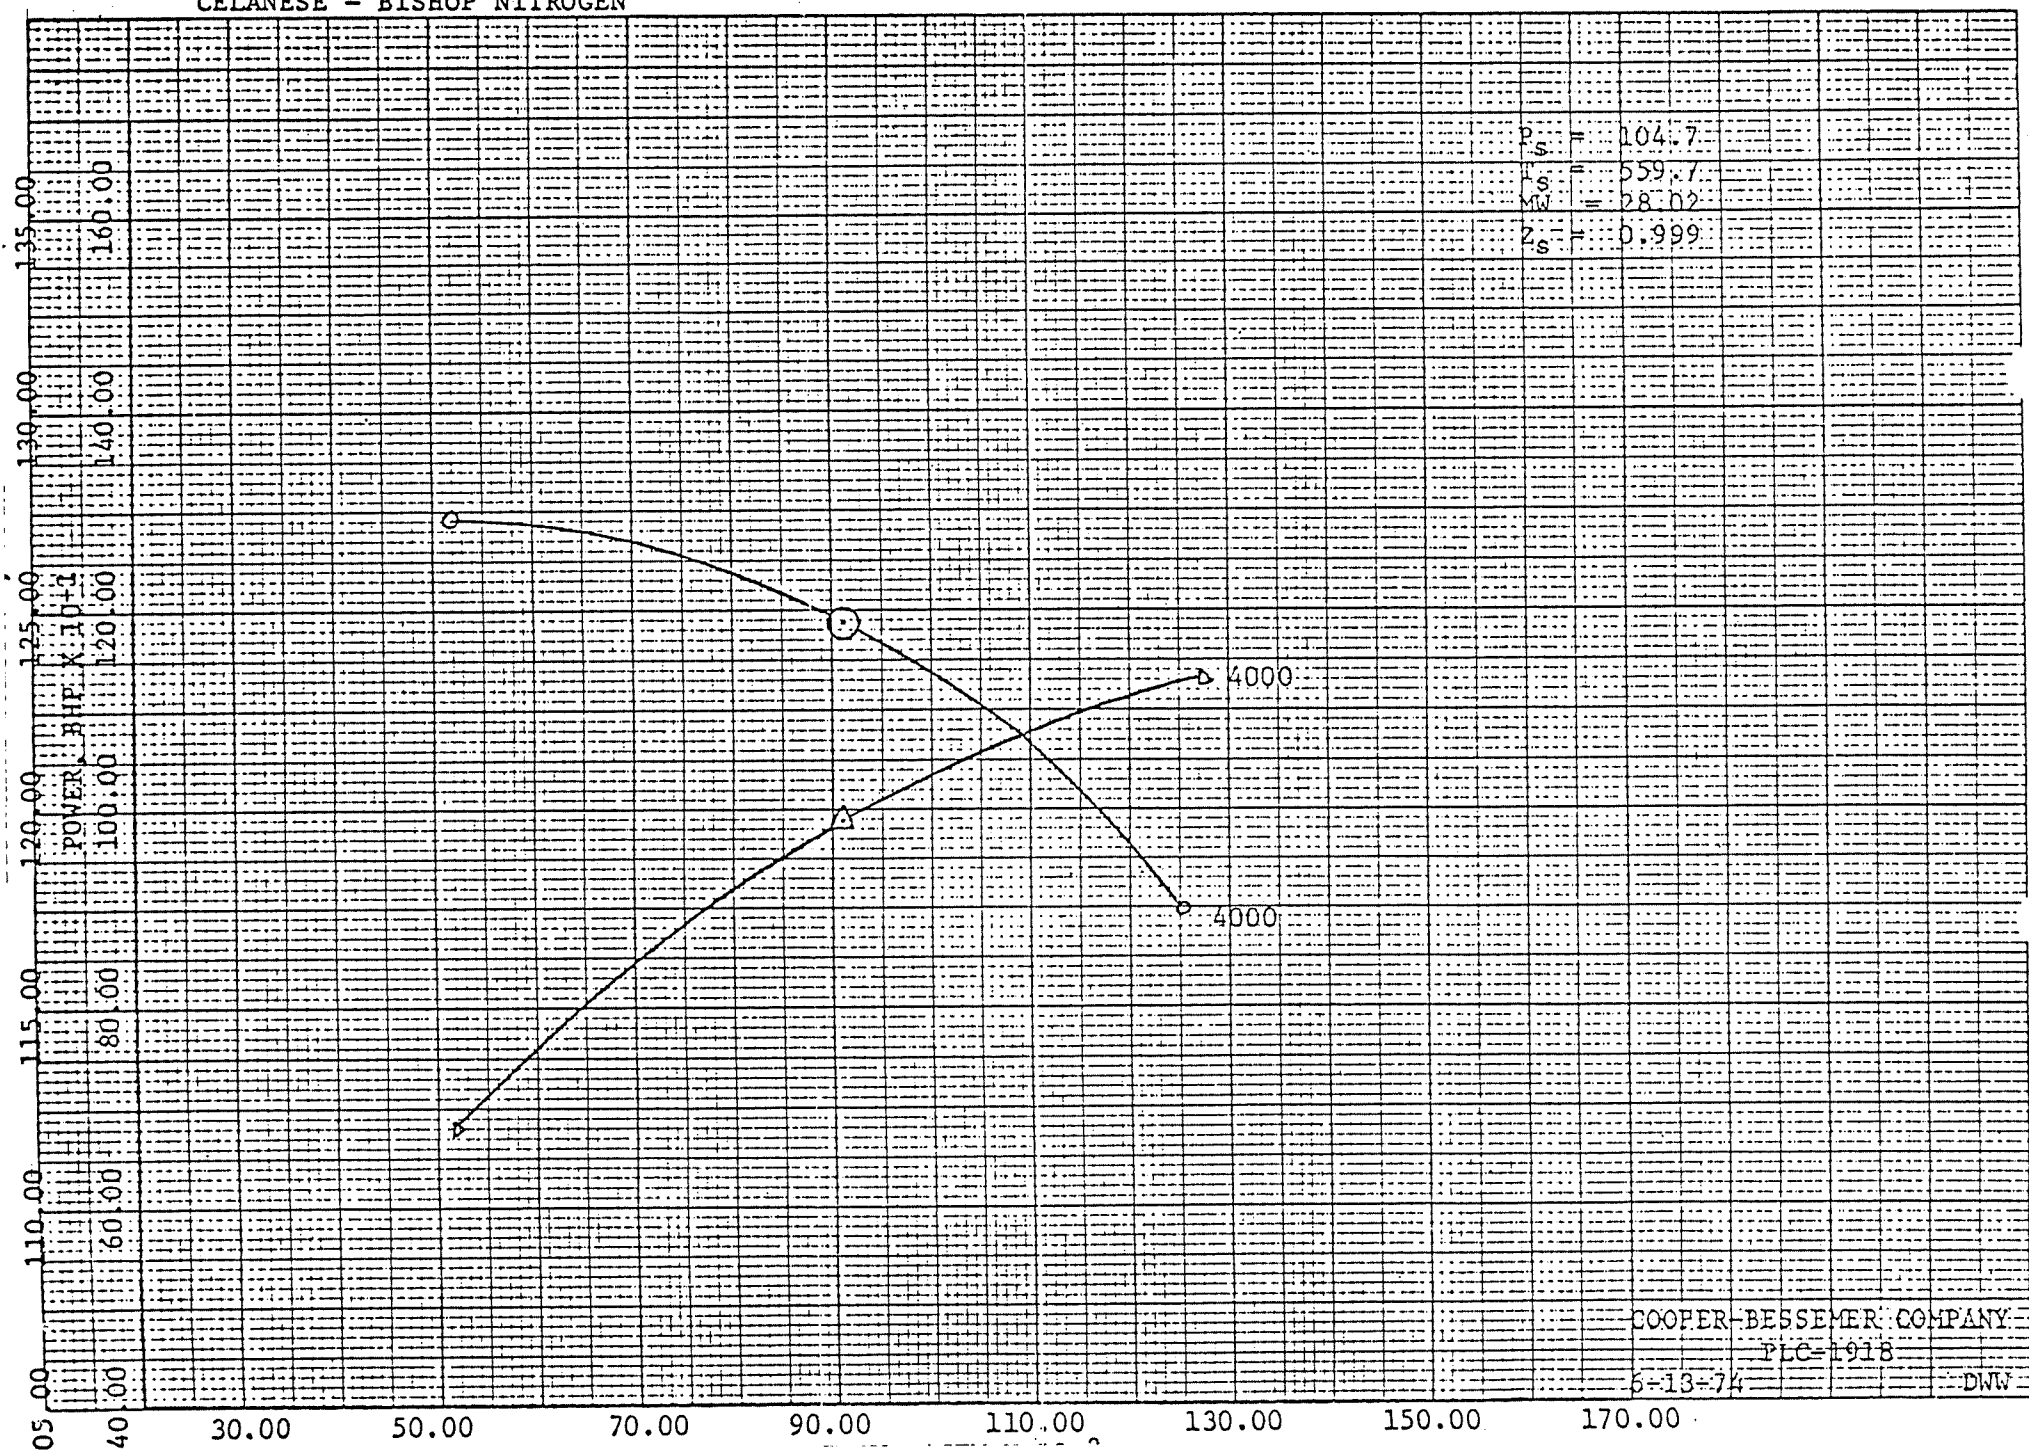

N₂ @ 127 PSIG

CELANESE - BISHOP NITROGEN

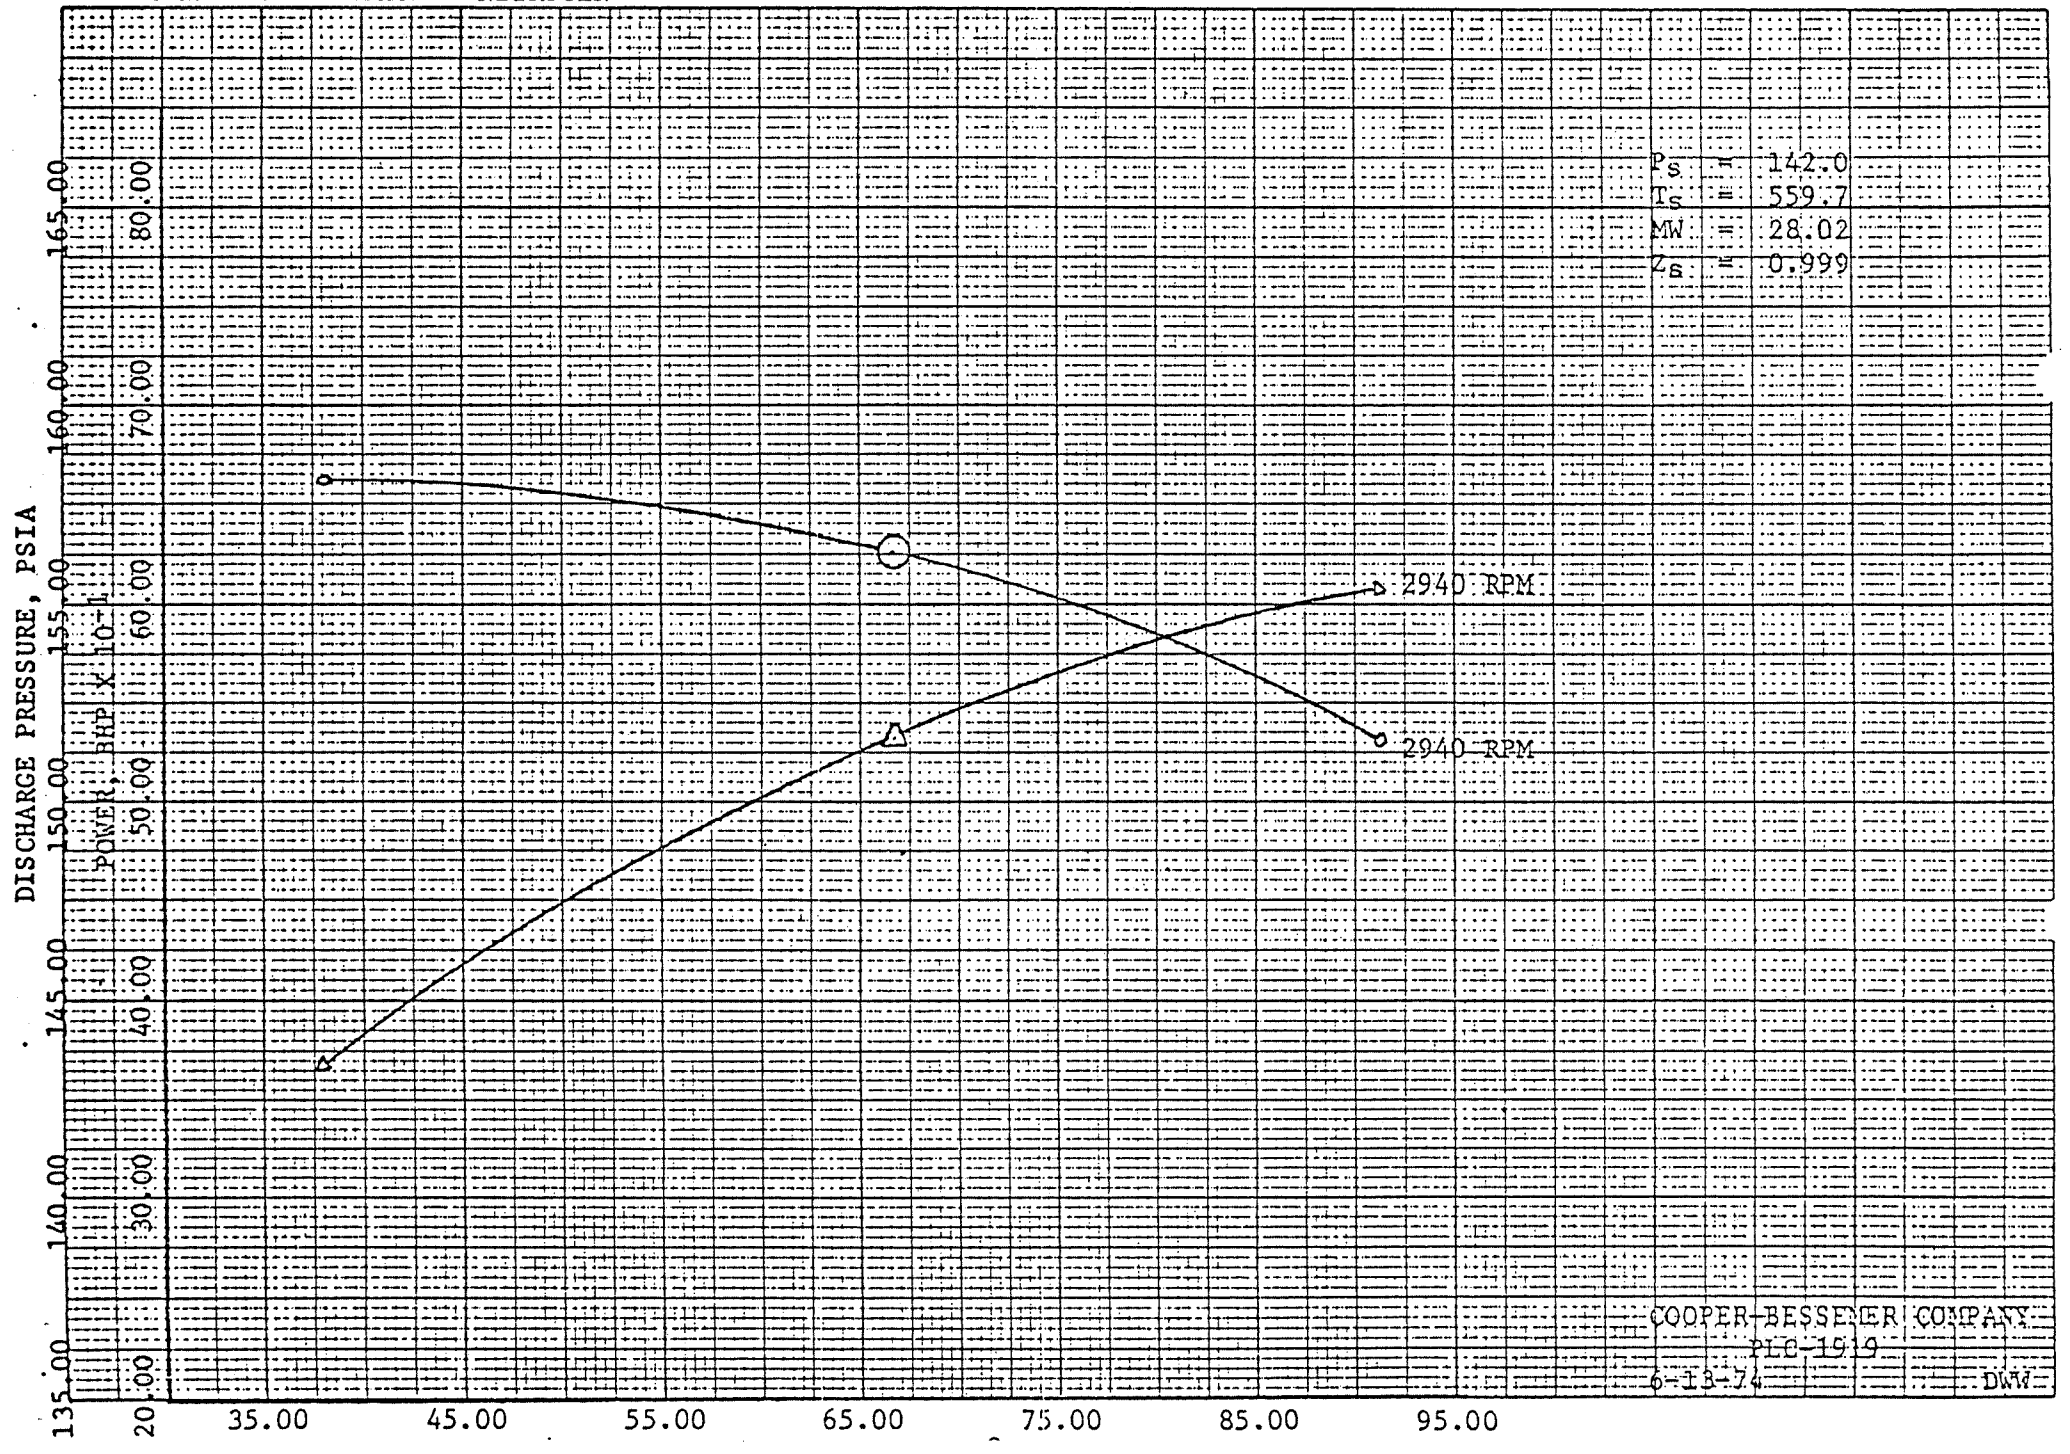


P_s = 142.0
T_s = 559.7
MW = 28.02
Z_s = 0.999


COOPER-BESSEMER COMPANY
6-13-74 DW

2-20-74

CO₂ CASE

CELANESE - BISHOP

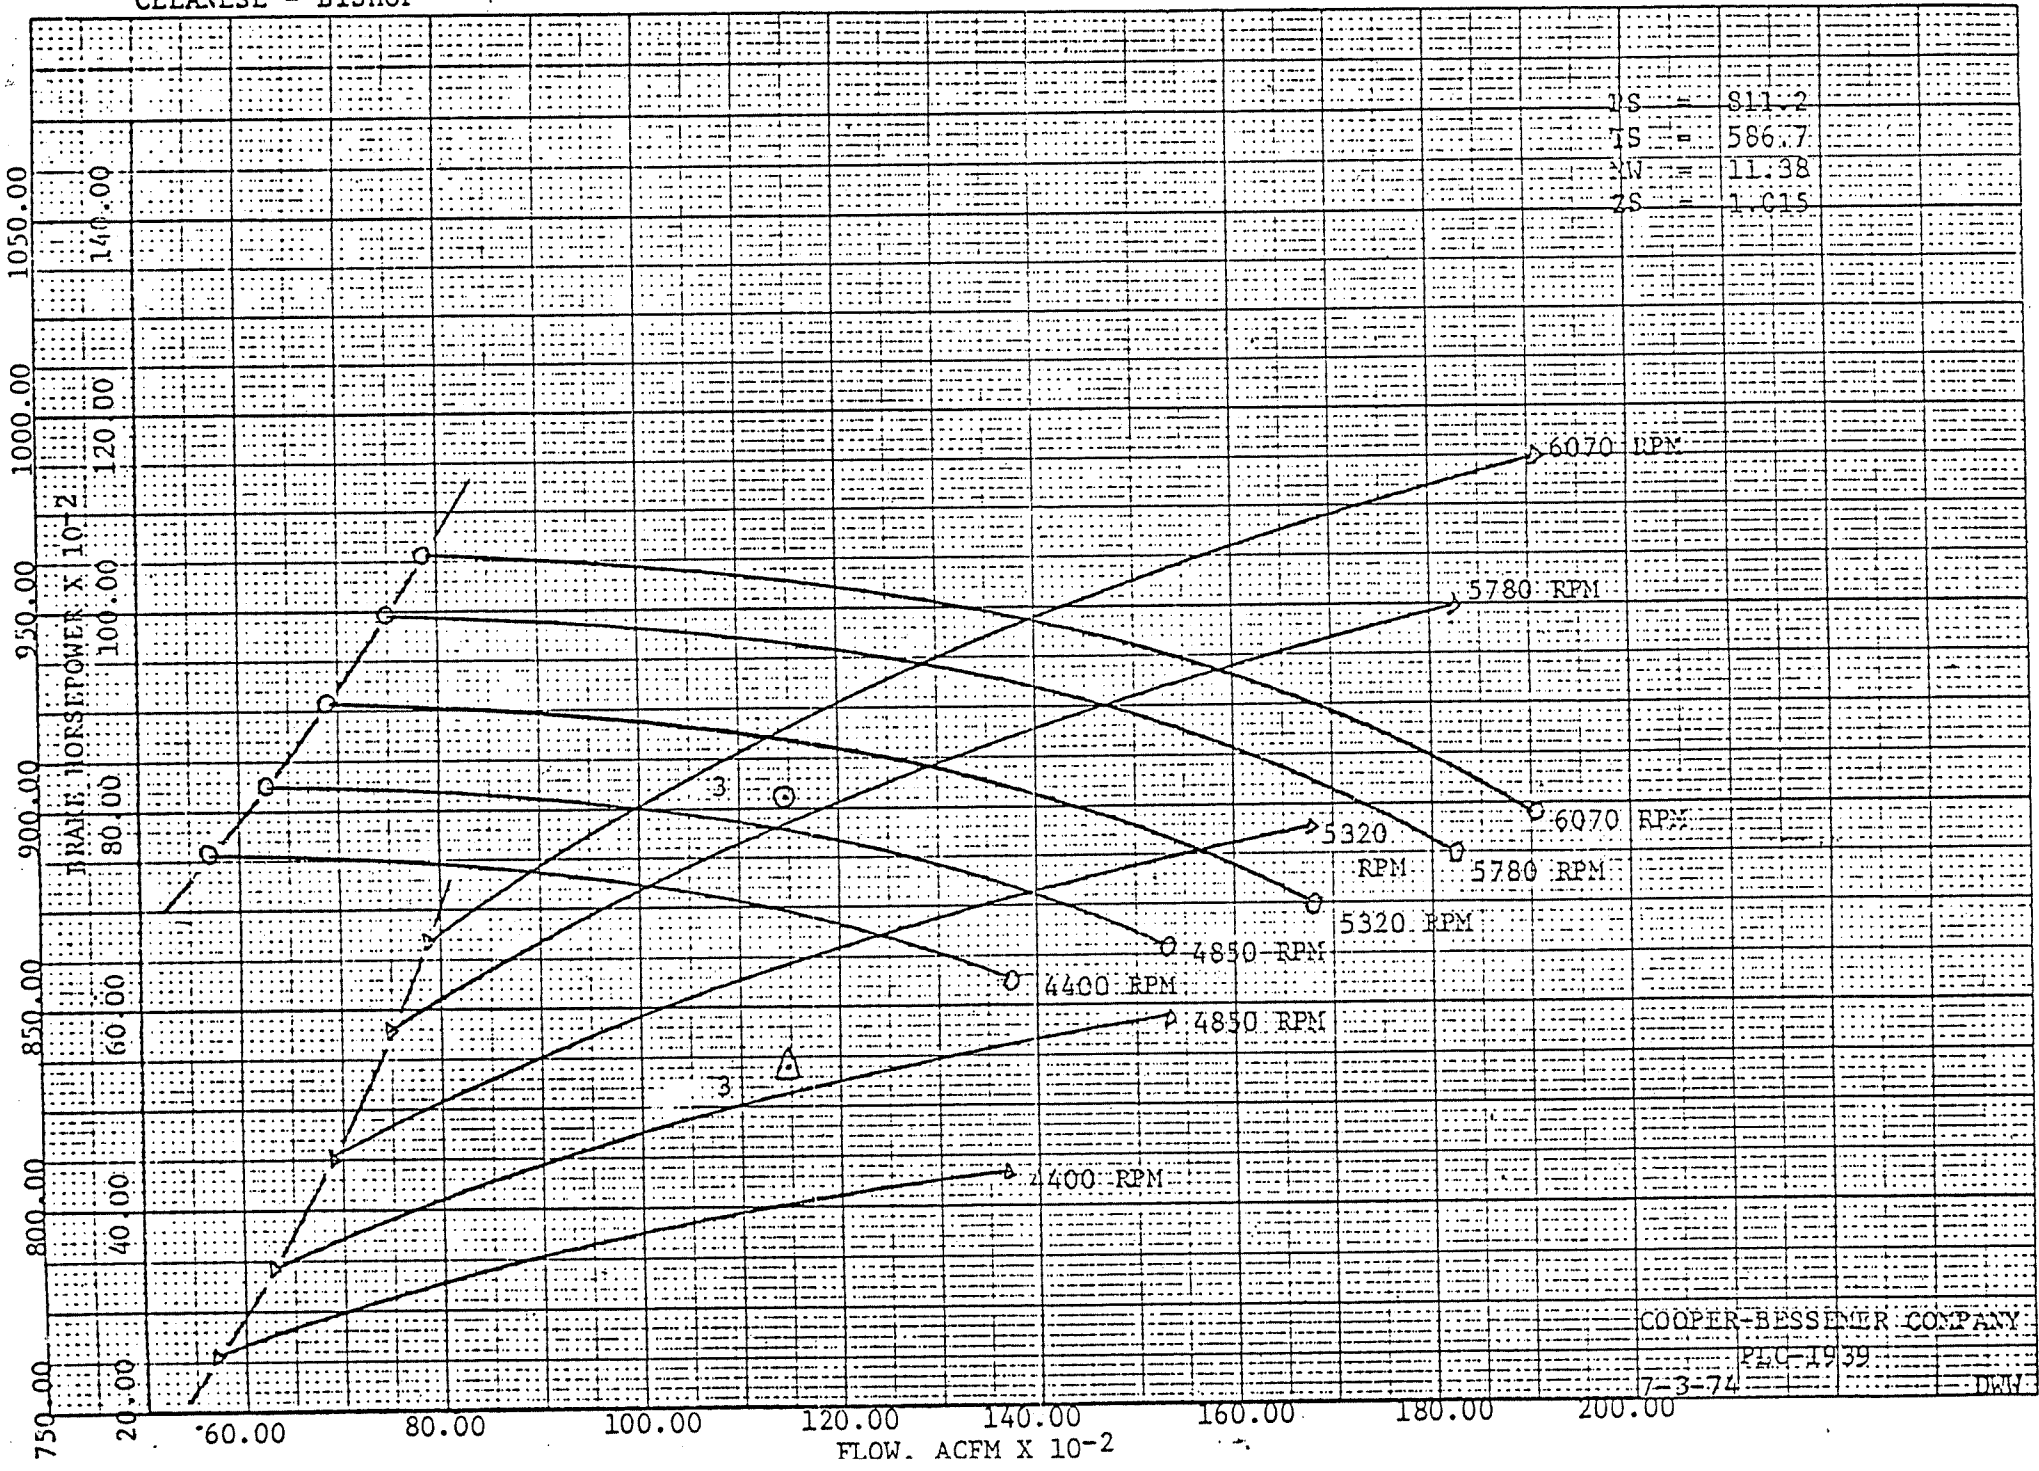

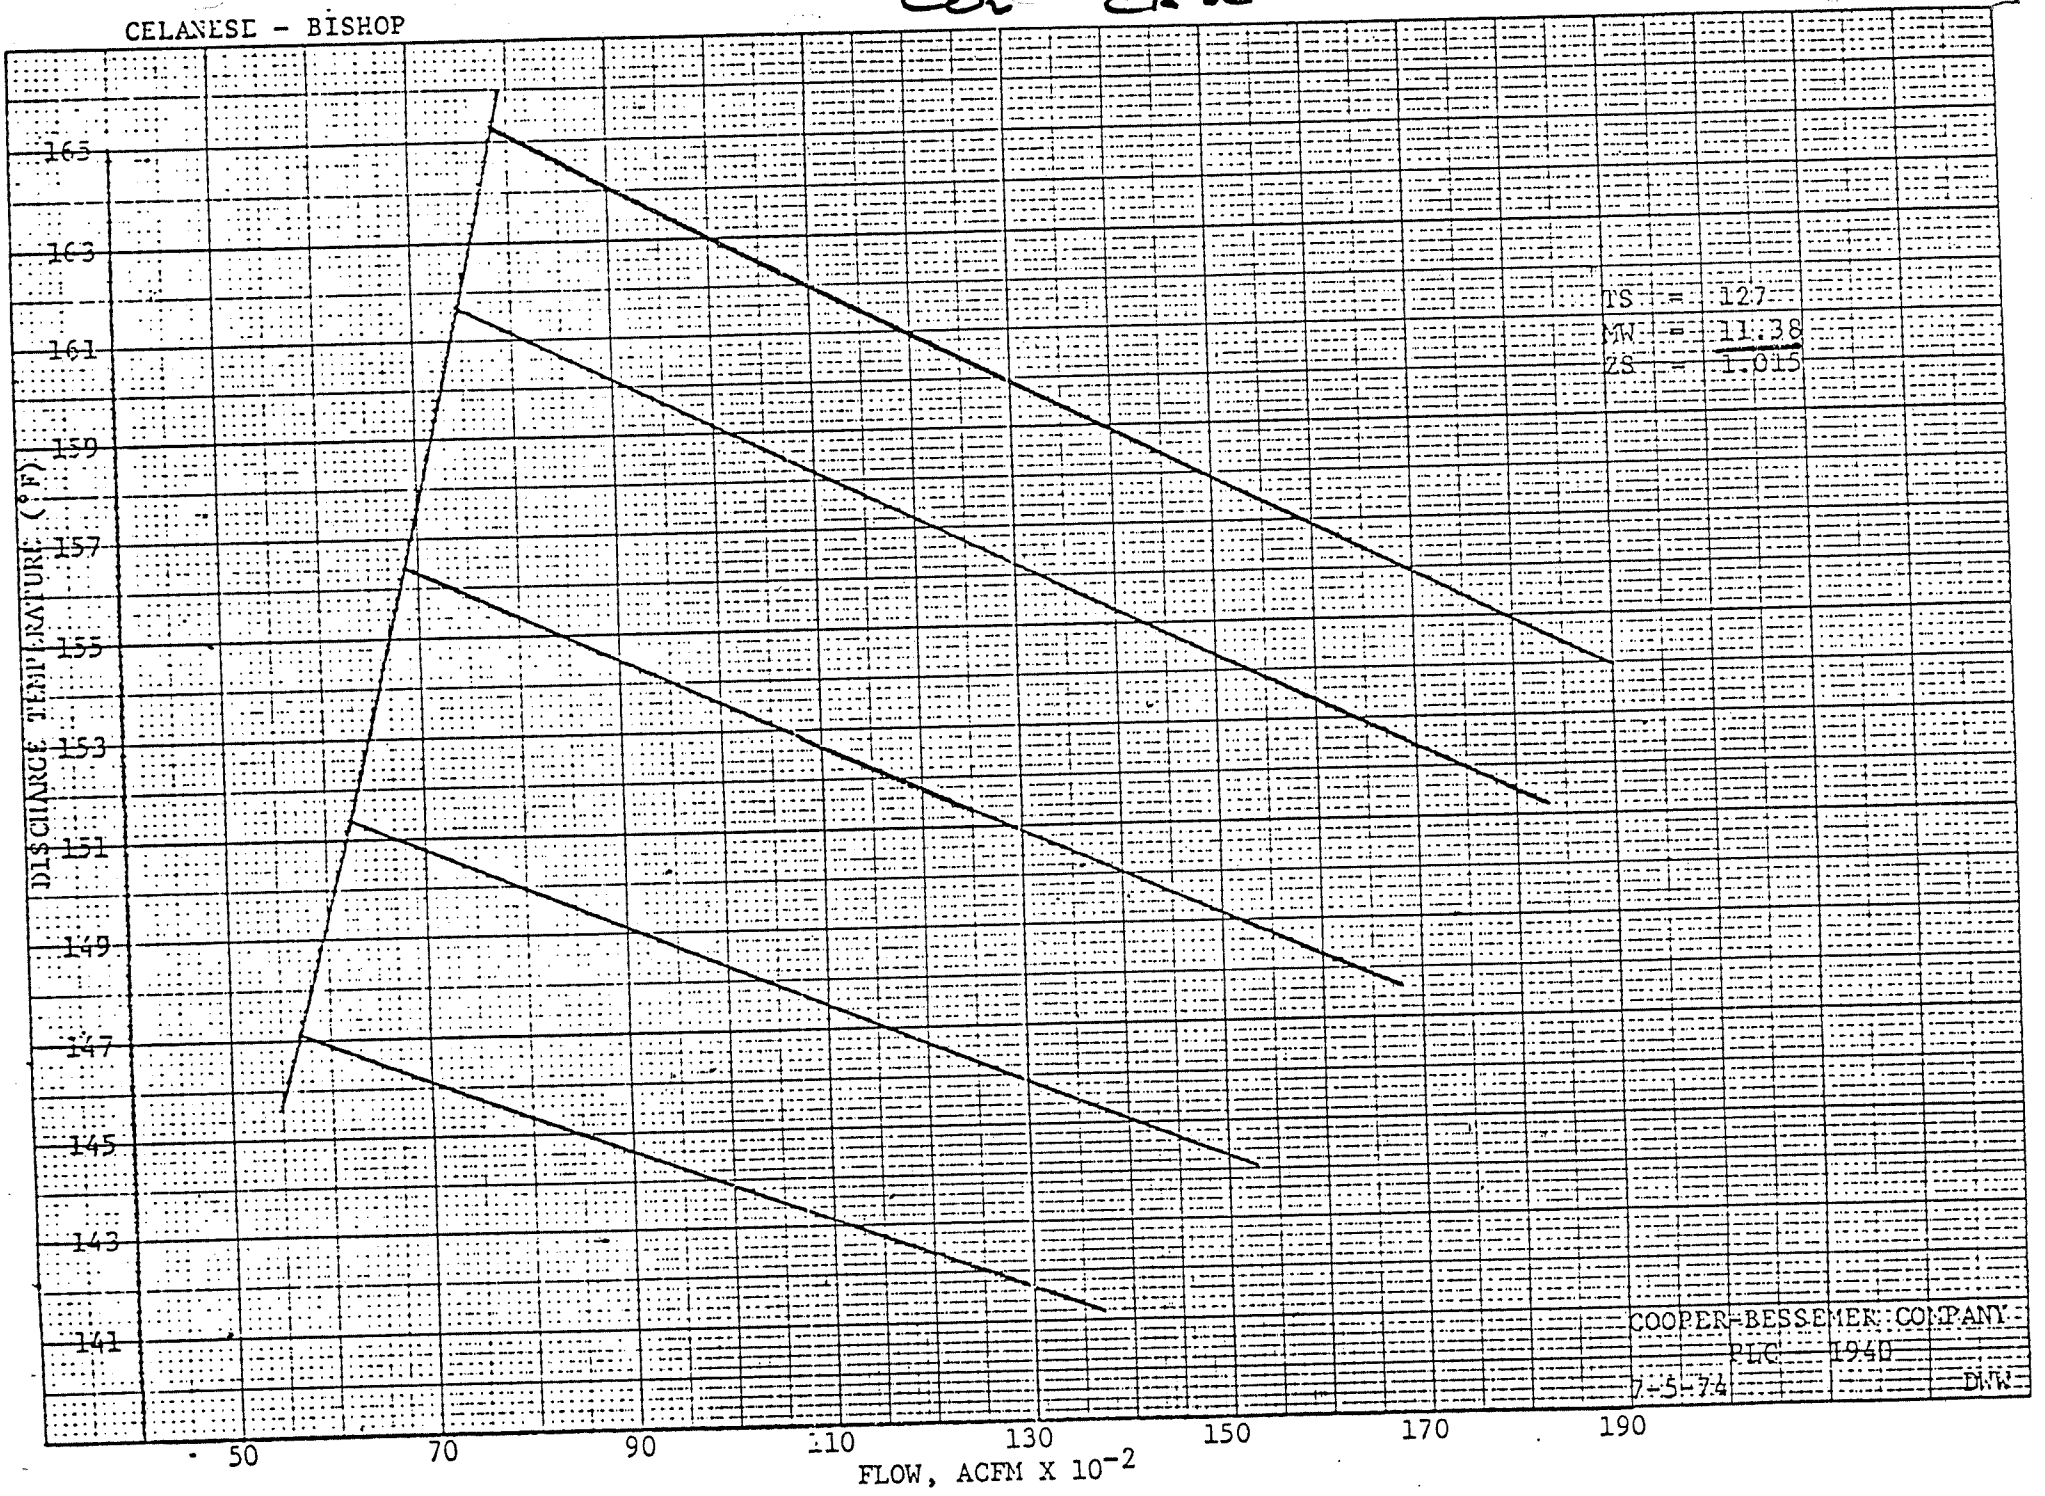

BROWN & ROOT Inc. HOUSTON, TEXAS

CONT. NO.
ER-0995

STEAM TURBINE DATA SHEET FOR

TURBINE TO MEET PURCHASERS' SPEC. S-50.03-01

SPEC. NO.
149-M-15-DS

JHK 9/17/74 REVIEWED

APPROVED BCS

DATE 11-13

SHT. 1 OF 2

CLIENT CELANESE CHEMICAL CO.
DESTINATION BISHOP, TEXAS
UNIT STEAM TURBINE F.D. FAN
ITEM PT-1222 NO. REQ'D. ONE JOB NO. ER 0995
DRIVEN EQUIPMENT FORCED DRAFT FAN
THRU GEAR REDUCER

OPERATING CONDITIONS

ITEM-COND:	RATED	DESIGN	NORMAL	MINIMUM
HORSEPOWER:	440		295	
SPEED (rpm):	4760		4120	
INITIAL PRESS (psig)	240	250	240	240
INITIAL TEMP (Ftt):	SAT.	SAT.	SAT.	SAT.
EXH PRESS (psig/in.Hg.abs):	55	55	50	40
EXH TEMP (Ftt):	SAT		SAT.	SAT.
* HAND VALVES OPEN:				
* WATER RATE:				
MAX.CASING PRESSURE (psig)				
MAX.ALLOW.PRESS.EXH.END (psig)		75		
INDOOR		OUTDOOR	X	ROOF: Yes - No
WINTERIZATION:			No	
DUTY:cont.	X	intermit	stand by	hrs/yr 8760
STEAM COST:\$/M#			PAYOUT PERIOD (yrs)	

CONSTRUCTION FEATURES

TYPE:vert _____ horiz. X NO STAGES:single X mult _____
ROTATION(from gov end):cw _____ ccw YES
GOVERNOR:mech _____ hydr _____ oil relay _____ NEMA class D
CONTROL: WOODWARD PG-PL
GOVERNOR VALVE TYPE:single X mult _____
AIR HEAD FOR INSTRUMENT CONTROL JACK SCREW _____
Range 40 % below 4760 rpm
Max. rpm @ 5000 AT 15 psig-Min rpm @ 2850 AT 3 psig
HAND SPEED CHANGER:range 5000 max rpm 2850 min rpm
TRIP-THROTTLE VALVE:separate COMBINED
Remote trip YES, SOLENOID Actuation DE-ENERGIZED
Other trip LOCAL Actuation MANUAL
Other trip EMERGENCY Actuation MECH. GOV
SOLE PLATE YES BASE PLATE _____ FURNISHED BY VENDOR
Turbine _____ Turbine & Gear _____ Driven Eqpt. _____
STEAM INLET:rating 600 facing RF orient RT, UP
EXHAUST: rating 150 facing RF orient LET, SIDE
* DRAINS: no. _____ type & size _____
* VENTS: no. _____ type & size _____
* WATER CONN: no. _____ type & size _____
* LUBE OIL INLET: no. _____ type & size _____
* LUBE OIL OUTLET: no. _____ type & size _____
* SEAL STEAM CONN: no. _____ type & size _____
* GLAND DRAIN CONN: no. _____ type & size _____
* INSTRUMENT CONN: no. _____ type & size _____
* OTHER CONN:service _____ type & size _____

1 MANUFACTURER TURBODYNE
2 TYPE & SIZE 202 WHB
3 SERIAL NO. _____
4 QUOTE NO. 30-216-74 DATE 7-5-74
5 PURCHASE ORDER NO. 50022 DATE _____
6

CONSTRUCTION FEATURES (cont.)

7 COUPLING:make BY GEAR type VENDOR
8 Mount Coupling Half: YES Yes No
9 Lubrication: _____ Mounting: TAPERED-NEMA
10 Furnished by: GEAR VENDOR
11 INSULATION: NO No type INSUL STUDS FURN.
12 JACKET: NO No type _____
13 GEAR UNIT:required YES type SINGLE HELICAL
14 BY PURCHASER
15

TURBINE SPECIFICATIONS

16 NO. OF STAGES SINGLE
17 ROTOR TYPE:solid _____ built up ✓
18 SPEED(rpm):max.allow 5000 1st crit. trip 5500
19 NO.AUTO VALVES: _____ TYPE LIFT:cam _____ bar _____
20 BEARINGS:radial type & size SPLIT SLEEVE JOURNAL
21 THRUST:type & size BALL
22 PACKING TYPE:end glands CARBON RINGS
23 Interstage Diaphragms NONE
24 MATERIALS:
25 Steam Inlet Parts CARBON STEEL-CL II
26 Casing C. STEEL Shaft HOT ROLLED ALLOY
27 Nozzles S.S. Nozzle Rings S.S.
28 Wheels C. STEEL Blading S.S.
29 Shrouds S.S. Gov. Trim Valve S.S.
30 Labyrinths NONE
31 Shaft Material Under Packing S.S.-12CR

32 Applied By:spraying X plating _____
33 NET WEIGHT: _____ SHIPPING WEIGHT: _____
34 ROTOR WEIGHT: _____
35 WEIGHT HEAVIEST PIECE FOR MAINT: _____

FURNISHED BY OTHERS

GEAR SPECIFICATIONS

36 MANUFACTURER _____ DESIGNATION _____
37 BUILT IN _____ SEPARATE _____
38 NO.OF REDUCTIONS _____ RATIO _____
39 CL. to CL. OF SHAFTS _____ FACE WIDTH _____
40 TYPE OF BEARINGS _____ TYPE LUBR _____
41 AGMA GEAR:service factor _____ type _____
42 ROTATION L.S.(from gov end):cw _____ ccw _____
43 SPEED OF L.S.(rmp): _____
44 LUBRICATION: _____
45 NET WEIGHT: _____ SHIPPING WEIGHT _____
46 WEIGHT HEAVIEST PIECE FOR MAINT: _____
47 MATERIALS:
48 Case _____ Shaft _____
49 Case _____ Pinion _____
50 Brgs _____
51
52
53

CHKD.
DATEBCS JHK
11-5-74 11-13 12-27



Item No. PT-1222

GEAR SPECIFICATIONS (cont.)

COUPLING: make _____ type _____
Mount Coupling Half: Yes No
Lubrication: _____ Mounting: _____
Furnished by: _____

LUBE OIL SYSTEM

TYPE: BY OTHERS, PRESSURIZED

PRESS(psig): driver _____ gear _____ control _____

System Design _____ R.V. Set _____

SCHEMATIC DIAGRAM: _____

GPM: turb _____ gear _____ control oil _____

Driven Equipment _____

MAIN PUMP: make _____ type _____

Casing Mat'l. _____ Flanges _____

Speed _____ gpm _____

Driver _____ hp _____

Coupling _____

Location _____ Control _____

AUX. PUMP: make _____ type _____

Casing Mat'l. _____ Flanges _____

Speed _____ gpm _____

Driver _____ hp _____

Coupling _____

Location _____ Control _____

COOLER: no. _____ make _____ location _____

Duty _____ Surface _____ Water (gpm) _____

Shell: o.d. _____ thickness _____ des. press. _____

Tubes: o.d. _____ length _____ bwg _____ no. _____

Material: shell _____ channel _____ tubes _____

Switch Valve: make _____ mat'l. _____

FILTERS: no. _____ make _____ type _____

Casing Mat'l. _____ Flanges _____

Design Press _____ Δ P _____ Micron _____

Switch Valve: make _____ mat'l. _____

RESERVIOR: location _____ size _____

Retention _____ Material _____

Flanges _____ Interior Coating _____

Heating Coil _____

Insulation Supports _____

NET WEIGHT _____ SHIPPING WEIGHT _____

INSPECTION & TESTS

Item	Required		Witnessed	
	Yes	No	Yes	No
Shop Inspection	☒	☐	☒	☐
Mechanical Run	☒	☐	☒	☐
Performance	☐	☒	☐	☐
Bearings (Post Run)	☒	☐	☒	☐
Auxiliary Equipment	☐	☐	☐	☐
With Gear	☐	☒	☐	☐
Hydrostatic	☒	☐	☒	☐
Other	☐	☐	☐	☐
Comment:				

INSTRUMENTATION

CONTROL PANEL: NO furnished by _____

INSTRUMENTS MAKE SIZE LOCATION

STEAM INLET PG VALVED & PLUG 3

STEAM CHEST PG VALVED & PLUG 3

1st STAGE STEAM PG

EXHAUST STEAM PG VALVED & PLUG 3

L.O. PRESS at PUMP

L.O. PRESS at BRGS

OIL FILT. PG & MANIFOLD

BRG. TEMP. 5" DIAL THERM EACH DRAIN 3

L.O. to COOLER

L.O. from COOLER

C.W. to OIL COOLER

C.W. from OIL COOLER

G.G. L.O. RESER.

FLOW INDICATOR IN EA, BRNG DRAIN

LOW L.O. PRESS. ALARM

AUX. L.O. PUMP RUN ALARM

THROTTLE V.A. TRIP ALARM

TACHOMETER: vibrating reed NO electrical YES 2

SPEED TRANSMITTER: NO type PICKUP ONLY

READ-OUT BY

CELANESE

TURBINES: API 611 ELEC: class I group D div 2

PIPING: B31.3 VESSELS: EXCHANGERS:

GEAR: API 613

ALLOWABLE PIPING FORCES & MOMENTS

	INLET FLANGE		EXHAUST FLANGE	
	Force lb.	Moment ft.-lb.	Force lb.	Moment ft.-lb.
PARALLEL TO SHAFT				
VERTICAL				
HORIZ. 90° TO SHAFT				

UTILITIES

STEAM AUX: inlet _____ psig _____ Ftt EXH _____ psig/in Hg abs

ELECTRICAL POWER: 460 v 3 ph 60 cy

CONTROL: 120 v 1 ph 60 cy

COOLING WATER: temp 90 F-Press 50 psig

INSTRUMENT AIR (psig): 90 SERVICE AIR (psig): 90

EXCEPTIONS TO SPECIFICATIONS

ITEMS MARKED * TO BE COMPLETED

BY TURBODYNE AND RETURNED.

(1) TURBODYNE TO FURNISH AIRPAX

SENSOR. PURCH. TO FURNISH

MONITOR AND INSTALL REMOTE.

(2) WATER COOLED BEARING HOUSING TO BE

PLUGGED NOTES:

(3) Turbine to meet Purchaser's General Pur-

pose Steam Turbine Specifications

S-50.03-01.

(4) RATED + NORMAL RLYR TO API 611 PARA 9A-4B

INSULATION CLIPS REQUIRED.

NO POSITIONING SCREWS REQD

FOR SOLE PLATE

BY _____
CHK'D _____
DATE _____

ORIGINAL
Y
-HND
APPROV

BROWN & ROOT Inc. HOUSTON, TEXAS

CONT NO

ER-0995

STEAM TURBINE DATA SHEET FOR PT-1223

SPEC NO

149-M-14-DS

TURBINE TO MEET GENERAL PURCHASERS' SPECIFICATION S-50.03-01

BY JHK 1/17/74 REVIEWED

APPROVED

BCS

DATE 11-13

SHT. 1 OF 2

CLIENT CELANESE CHEMICAL CO
DESTINATION BISHOP TEXAS
UNIT STEAM TURBINE, I.D. FAN
ITEM PT 1223 NO. REQ'D ONE JOB NO. ER-0995
DRIVEN EQUIPMENT INDUCED DRAFT FAN
THRU GEAR REDUCER

OPERATING CONDITIONS

ITEM-COND: RATED DESIGN NORMAL MINIMUM
HORSEPOWER: 1118 732
SPEED (rpm): 4760 4025
INITIAL PRESS (psig) 600 650 600 600
INITIAL TEMP (Ftt): 750 750 750 750
EXH PRESS (psig/in.Hg.abs): 55 55 50 40
EXH TEMP (Ftt): SAT SAT SAT
* HAND VALVES OPEN: _____
* WATER RATE: _____
MAX CASING PRESSURE (psig) 650
MAX ALLOW PRESS EXH END (psig) 75
INDOOR _____ OUTDOOR X ROOF: Yes - No
WINTERIZATION: Yes - No
DUTY: cont. ✓ intermit _____ stand by _____ hrs/yr 8760
STEAM COST: \$/M³ _____ PAYOUT PERIOD (yrs) _____

CONSTRUCTION FEATURES

TYPE: vert _____ horiz. X NO STAGES: single X mult _____
ROTATION (from gov end): cw _____ ccw YES
GOVERNOR: mech _____ hydr _____ oil relay _____ NEMA class D
CONTROL: WOODWARD PG-PL
GOVERNOR VALVE TYPE: single X mult _____
AIR HEAD FOR INSTRUMENT CONTROL YES JACK SCREW _____
Range 40 % below 4760 rpm
Max. rpm @ 5000 AT 15 psig Min rpm @ 2850 AT 3 psig
HAND SPEED CHANGER: range 5000 max rpm 2850 min rpm
TRIP THROTTLE VALVE: separate COMBINED
Remote trip YES - SOLENOID Actuation DE-ENERGIZED
Other trip LOCAL Actuation MANUAL
Other trip EMERGENCY Actuation MECH GOV.
SOLE PLATE YES BASE PLATE _____ FURNISHED BY VENDOR
Turbine ✓ Turbine & Gear NO Driven Eqt. NO
STEAM INLET: rating 600 facing RF orient RT-UP
EXHAUST: rating 150 facing RF orient LEFT SIDE
* DRAINS: no. _____ type & size _____
* VENTS: no. _____ type & size _____
* WATER CONN: no. _____ type & size _____
* LUBE OIL INLET: no. _____ type & size _____
* LUBE OIL OUTLET: no. _____ type & size _____
* SEAL STEAM CONN: no. _____ type & size _____
* GLAND DRAIN CONN: no. _____ type & size _____
* INSTRUMENT CONN: no. _____ type & size _____
* OTHER CONN: service _____ type & size _____

1 MANUFACTURER TURBODYNE
2 TYPE & SIZE 283 WVK
3 SERIAL NO: _____
4 QUOTE NO. 30-216-74 DATE 7/5/74
5 PURCHASE ORDER NO. 50022 DATE _____
6

CONSTRUCTION FEATURES (cont.)

8 COUPLING: make BY GEAR VENDOR type _____
9 Mount Coupling Half: (Yes) No
10 Lubrication: _____ Mounting: NEMA TAPER
11 Furnished by: GEAR VENDOR
12 INSULATION: Yes (No) type STUDS TO BE
13 JACKET: Yes (No) type FURNISHED
14 GEAR UNIT: required YES type SINGLE HELICAL
15 BY PURCHASER
16

TURBINE SPECIFICATIONS

17 NO. OF STAGES ONE
18 ROTOR TYPE: solid _____ built up ✓
19 SPEED (rpm): max. allow 5000 1st crit * trip 5500
20 NO. AUTO VALVES: _____ TYPE LIFT: cam _____ bar _____
21 BEARINGS: radial type & size SPLIT SLEEVE JOURNAL
22 THRUST: type & size TILT PAD THRUST
23 PACKING TYPE: end glands CARBON RING
24 Interstage Diaphragms NONE
25 MATERIALS:
26 Steam Inlet Parts CARBON STEEL
27 Casing _____ Shaft _____
28 Nozzles _____ Nozzle Rings _____
29 Wheels _____ Blading _____
30 Shrouds _____ Gov. Trim Valve _____
31 Labyrinths _____
32 Shaft Material Under Packing _____

Applied By: spraying _____ plating _____
NET WEIGHT: _____ SHIPPING WEIGHT: _____
ROTOR WEIGHT: _____
WEIGHT HEAVIEST PIECE FOR MAINT: _____

GEAR SPECIFICATIONS

39 MANUFACTURER _____ DESIGNATION _____
40 BUILT IN _____ SEPARATE _____
41 NO. OF REDUCTIONS _____ RATIO _____
42 CL. to CL. OF SHAFTS _____ FACE WIDTH _____
43 TYPE OF BEARINGS _____ TYPE LUBR _____
44 AGMA GEAR: service factor _____ type _____
45 ROTATION L.S. (from gov end): cw _____ ccw _____
46 SPEED OF L.S. (rpm): _____
47 LUBRICATION: _____
48 NET WEIGHT: _____ SHIPPING WEIGHT: _____
49 WEIGHT HEAVIEST PIECE FOR MAINT: _____
50 MATERIALS:
51 Case _____ Shaft _____
52 Case _____ Pinion _____
53 Brgs _____

CHKD. DATE 11-5-74 11-13 12-27-74

CHKD. DATE

CHKD. DATE



Item PT=1223

GEAR SPECIFICATIONS (cont.)

COUPLING: make _____ type _____
Mount Coupling Half: _____ Yes - No _____
Lubrication: _____ Mounting _____
Furnished by: _____

LUBE OIL SYSTEM

TYPE: BY OTHERS - PRESSURIZED

PRESS (psig): driver _____ gear _____ control _____

System Design _____ R.V. Set _____

SCHEMATIC DIAGRAM: _____

GPM: turb _____ gear _____ control oil _____

Driven Equipment _____

MAIN PUMP: make _____ type _____

Casing Mat'l. _____ Flanges _____

Speed _____ gpm _____

Driver _____ hp _____

Coupling _____

Location _____ Control _____

AUX. PUMP: make _____ type _____

Casing Mat'l. _____ Flanges _____

Speed _____ gpm _____

Driver _____ hp _____

Coupling _____

Location _____ Control _____

COOLER: no _____ make _____ location _____

Duty _____ Surface _____ Water (gpm) _____

Shell: o.d. _____ thickness _____ des. press. _____

Tubes: o.d. _____ length _____ bwg _____ no. _____

Material: shell _____ channel _____ tubes _____

Switch Valve: make _____ mat'l. _____

FILTERS: no _____ make _____ type _____

Casing Mat'l. _____ Flanges _____

Design Press _____ Δ P _____ Micron _____

Switch Valve: make _____ mat'l. _____

RESERVIOR: location _____ size _____

Retention _____ Material _____

Flanges _____ Interior Coating _____

Heating Coil _____

Insulation Supports _____

NET WEIGHT _____ SHIPPING WEIGHT _____

INSPECTION & TESTS

Item	Required		Witnessed	
	Yes	No	Yes	No
Shop Inspection	☒	☐	☒	☐
Mechanical Run	☒	☐	☒	☐
Performance	☐	☒	☐	☐
Bearings (Post Run)	☒	☐	☒	☐
Auxiliary Equipment	☐	☐	☐	☐
With Gear	☐	☒	☐	☒
Hydrostatic	☒	☐	☒	☐
Other	☐	☐	☐	☐

Comments:

6. SPEC. S50.12-01 DOES NOT APPLY

INSTRUMENTATION

2 CONTROL PANEL NO furnished by _____

3 INSTRUMENTS MAKE _____ SIZE _____ LOCATION _____

4 STEAM INLET PG VALUE & PLUG5 STEAM CHEST PG VALUE & PLUG

6 1st STAGE STEAM PG

7 EXHAUST STEAM PG VALUE & PLUG

8 L.O. PRESS at PUMP

9 L.O. PRESS at BRGS

10 OIL FILT. PG & MANIFOLD

11 BRG. TEMP. 5" DIAL THERM. EACH DRAIN

12 L.O. to COOLER

13 L.O. from COOLER

14 C.W. to OIL COOLER

15 C.W. from OIL COOLER

16 G.G. L.O. RESER.

17 FLOW INDICATOR IN EACH BRNG DRAIN

18 LOW L.O. PRESS. ALARM

19 AUX. L.O. PUMP RUN ALARM

20 THROTTLE VA. TRIP ALARM

21 TACHOMETER: vibrating reed NO electrical YES22 SPEED TRANSMITTER: Yes (1) type PICKUP ONLY23 READ-OUT BY24 CELANESE25 TURBINES: API 611 ELEC: _____ class 1 group D div 226 PIPING: B31.3 VESSELS: _____ EXCHANGERS: _____27 GEAR: API 613

28

29

30

31

32 PARALLEL TO SHAFT

33 VERTICAL

34 HORIZ. 90° TO SHAFT

35

36

37

38

39

40

41

42

43

44

45

46

47

48

49

50

51

52

53

54

55

56


57

58

59

60

BROWN & ROOT Inc. HOUSTON, TEXAS

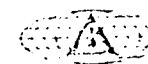CONT NO
ER-0775

STEAM TURBINE DATA SHEET

ITEM NOS. PT 1226/1227

SPEC NO
147-M-14-

BY JHK 7/27/74 REVIEWED WWS

APPROVED

PAS

DATE 11-13

SHT. 1 OF 3

CLIENT CILANESE CHEMICAL Co.
DESTINATION PLANT, TEXAS
UNIT METHANOL
ITEM PT 1226/1227 NO REQ'D. 2 JOB NO. ER-0775
DRIVEN EQUIPMENT BOILER FEEDWATER PUMPS
(P-2488/2489)

OPERATING CONDITIONS

ITEM-COND:	* RATED	DESIGN	NORMAL	MINIMUM
△ HORSEPOWER:	619		526	
△ SPEED (rpm):	3600		3450	
△ INITIAL PRESS (psig)	240	250	240	240
INITIAL TEMP (Ftt):	SAT	SAT	SAT	SAT
EXH PRESS (psig/in.Hg.abs):	55	55	50	40
EXH TEMP (Ftt):	SAT	SAT	SAT	SAT
* HAND VALVES OPEN:	2		1	
* WATER RATE:				
MAX.CASING PRESSURE (psig)		250	INLET END	
MAX.ALLOW.PRESS.EXH.END (psig)		75		
INDOOR		OUTDOOR	✓	ROOF: NO No
WINTERIZATION:				No
DUTY: cont. ✓ intermit		stand by		hrs/yr 8760
STEAM COST: \$/M ³				PAYOUT PERIOD (yrs)

CONSTRUCTION FEATURES

TYPE: vert — horiz. ✓ NO. STAGES: single ✓ mult —
△ ROTATION (from gov end): cw — ccw CCW
GOVERNOR: mech — hydr — oil relay ✓ NEMA class D
CONTROL: WOODWARD PG-PL
(PRESSURE CONTROL)
GOVERNOR VALVE TYPE: single ✓ mult —
AIR HEAD FOR INSTRUMENT CONTROL YES JACK SCREW —
Range 25% % below 3600 rpm
Max. rpm @ 3780 @ 15 psig-Min rpm @ 2700 @ 3 psig
HAND SPEED CHANGER: range 3780 max rpm 2700 min rpm
TRIP-THROTTLE VALVE: COMBINED
Remote trip YES Actuation ENERGIZE
Other trip: LOCAL Actuation MANUAL
Other trip EMERGENCY Actuation MECH. GOV.

△ SOLE PLATE — BASE PLATE ✓ FURNISHED BY TURBO.
△ Turbine ✓ Turbine & Gear — Driven Eqpt. ✓

STEAM INLET: rating 600 # facing R.F. orient BT. / UP
EXHAUST: rating 150 # facing R.F. orient LET / SIDE

* DRAINS: no. 1 type & size —
* VENTS: no. — type & size —
* WATER CONN: no. — type & size —
* LUBE OIL INLET: no. — type & size —
* LUBE OIL OUTLET: no. — type & size —
* SEAL STEAM CONN: no. — type & size —
* GLAND DRAIN CONN: no. — type & size —
* INSTRUMENT CONN: no. — type & size —
* OTHER CONN: service —
type & size —

1 MANUFACTURER TURBODYNE
2 TYPE & SIZE 282 VHB
3 SERIAL NO. —
4 QUOTE NO. 30-216-74 DATE 1/5/74
5 PURCHASE ORDER NO. 7 DATE —
6 040-041-50022
7 CONSTRUCTION FEATURES (cont.)
8 COUPLING: make HEASTMAN type FLEX-SPACER
9 Mount Coupling Half: Yes — No — STRAIGHT — SINGLE —
10 Lubrication: NO Mounting BY TURBODYNE
11 Furnished by: PUMP VENDOR
12 INSULATION: Yes — No — type TURBODYNE TD FIBER
13 JACKET: Yes — No — type INSULATION CLING
14 GEAR UNIT: required NO type —
15 Coupling Guard by Turbo. △

16 TURBINE SPECIFICATIONS
17 NO. OF STAGES SINGLE
18 ROTOR TYPE: solid — built up ✓
19 SPEED (rpm): max. allow — 1st crit — trip —
20 NO. AUTO VALVES: TYPE LIFT: cam — bar —
21 BEARINGS: radial type & size SLEEVE
22 THRUST: type & size BALL
23 PACKING TYPE: end glands CARBON RING
24 Interstage Diaphragms NONE
25 MATERIALS:
26 Steam Inlet Parts CAST STEEL-TBD CL II
27 Casing: ASTM A216 WCB Shaft HOT ROLLED ALLOY
28 Nozzles S.S. Nozzle Rings S.S.
29 Wheels CARBON STEEL Blading S.S.
30 Shrouds S.S. Gov. Trim Valve S.S.
31 Labyrinths NONE
32 Shaft Material Under Packing 12 CR. SS
33 Applied By: spraying ✓ plating —
34 NET WEIGHT: — SHIPPING WEIGHT: —
35 ROTOR WEIGHT: —
36 WEIGHT HEAVIEST PIECE FOR MAINT: —

37 GEAR SPECIFICATIONS
38 MANUFACTURER — DESIGNATION —
39 BUILT IN — SEPARATE —
40 NO. OF REDUCTIONS — RATIO —
41 CL. to CL. OF SHAFTS — FACE WIDTH —
42 TYPE OF BEARINGS — TYPE LUBR —
43 AGMA GEAR service factor — type —
44 ROTATION L.S. (from gov end): cw — ccw —
45 SPEED OF L.S. (rpm): —
46 LUBRICATION: —
47 NET WEIGHT: — SHIPPING WEIGHT: —
48 WEIGHT HEAVIEST PIECE FOR MAINT: —
49 MATERIALS:
50 Case — Shaft —
51 Case — Pinion —
52 Brgs —



ITEMS PT-1226 & 1227

GEAR SPECIFICATIONS (cont.)		INSTRUMENTATION	
COUPLING make _____ type _____	2 CONTROL PANEL ☒ No furnished by _____		
Mount Coupling Hilt: _____ Yes - No _____	3 INSTRUMENTS MAKE SIZE LOCATION		
Lubrication: _____ Mounting: _____	4 STEAM INLET PG <u>VALVE + PLUG</u> ☒		
Furnished by: _____	5 STEAM CHEST PG <u>VALVE + PLUG</u> ☒		
	6 1st STAGE STEAM PG <u>VALVE + PLUG</u> ☒		
	7 EXHAUST STEAM PG <u>VALVE + PLUG</u> ☒		
	8 L.O. PRESS at PUMP <u>VALVE + PLUG</u> ☒		
	9 L.O. PRESS at BRGS <u>HEADER: VALVE + PLUG</u> ☒		
	10 OIL FILT. PG & MANIFOLD <u>VALVED CONN BEFORE FILTER</u>		
	11 BRG. TEMP ☒ <u>5" DIAL THERMOMETER IN EA DRAIN</u>		
	12 L.O. to COOLER " " " " ☒		
	13 L.O. from COOLER " " " " ☒		
	14 C.W. to OIL COOLER <u>NO</u>		
	15 C.W. from OIL COOLER <u>5" DIAL THERMOMETER</u> ☒		
	16 G.G. L.O. RESER. <u>YES</u>		
	17 FLOW INDICATOR <u>IN EA. BRG DRAIN</u>		
	18 LOW L.O. PRESS. ALARM <u>YES</u>		
	19 AUX. L.O. PUMP RUN ALARM <u>YES OFF OF START SW.</u>		
	20 THROTTLE VA. TRIP ALARM <u>NO</u>		
	21 TACHOMETER: vibrating reed <u>NO</u> electrical <u>PICK UP ONLY</u> ☒		
	22 SPEED TRANSMITTER <u>NO</u> type <u>READ OUT BY</u>		
	23 <u>CLARNESS</u>		
	24 CODES		
	25 TURBINES <u>API 611</u> ELEC <u>NEMA</u> class <u>1</u> group <u>D</u> div <u>2</u>		
	26 PIPING: <u>B31.3</u> VESSELS: _____ EXCHANGERS: _____		
	27 GEAR: <u>NONE</u>		
	28		
	29		
ALLOWABLE PIPING FORCES & MOMENTS			
INLET FLANGE		EXHAUST FLANGE	
Force lb.	Moment ft.-lb.	Force lb.	Moment ft.-lb.
PARALLEL TO SHAFT			
VERTICAL			
HORIZ. 90° TO SHAFT			

UTILITIES			
STEAM AUX: inlet _____ psig _____ Ftt EXH _____ psig/in Hg abs			
ELECTRICAL POWER: <u>460</u> v <u>3</u> ph <u>60</u> cy			
CONTROL: <u>120</u> v <u>1</u> ph <u>60</u> cy			
COOLING WATER: temp <u>90</u> F-Press <u>50</u> psig			
INSTRUMENT AIR (psig): <u>90</u> SERVICE AIR (psig): <u>90</u>			


ADDITIONS AND COMMENTS			
EXCEPTIONS TO SPECIFICATIONS			
① TURBINE FURN WITH LOW OIL PRESS TRIP AND			
SOLENOID VALVE - STAINLESS STEEL NOZZLE RIA			
HIGH OIL TEMP & LOW LUBE OIL PRESS. S.O. BPD			
② TURBINE TO MEET PURCHASERS			
SPEC. S-50.03-01			
③ TURBINE TO HAVE			
COOLED BEARING HOUSING - SEE SPEC.			
④ DATED & NORMAL REFER TO API 611			
PARAGRAPH 4.2.1.2			
⑤ SPEC. S50.12-01 DOES NOT APPLY			
⑥ LUBE OIL SYSTEM TO HAVE CAPACITY			
TO CARRY THE COOLER FLOW RATE			

INSPECTION & TESTS			
Item	Required	Witnessed	
	Yes No	Yes No	
Shop Inspection	☒ ☐	☒ ☐	
Mechanical Run	☒ ☐	☒ ☐	
Performance	☐ ☒	☐ ☒	
Bearings (Post Run)	☒ ☐	☒ ☐	
Auxiliary Equipment	☐ ☐	☐ ☐	
With Gear	☐ ☐	☐ ☐	
Hydrostatic	☒ ☐	☒ ☐	
Other	☐ ☐	☐ ☐	
Comments:			

BFW PUMP & TURBINE
LUBE OIL SYSTEM
PT 1226/1227

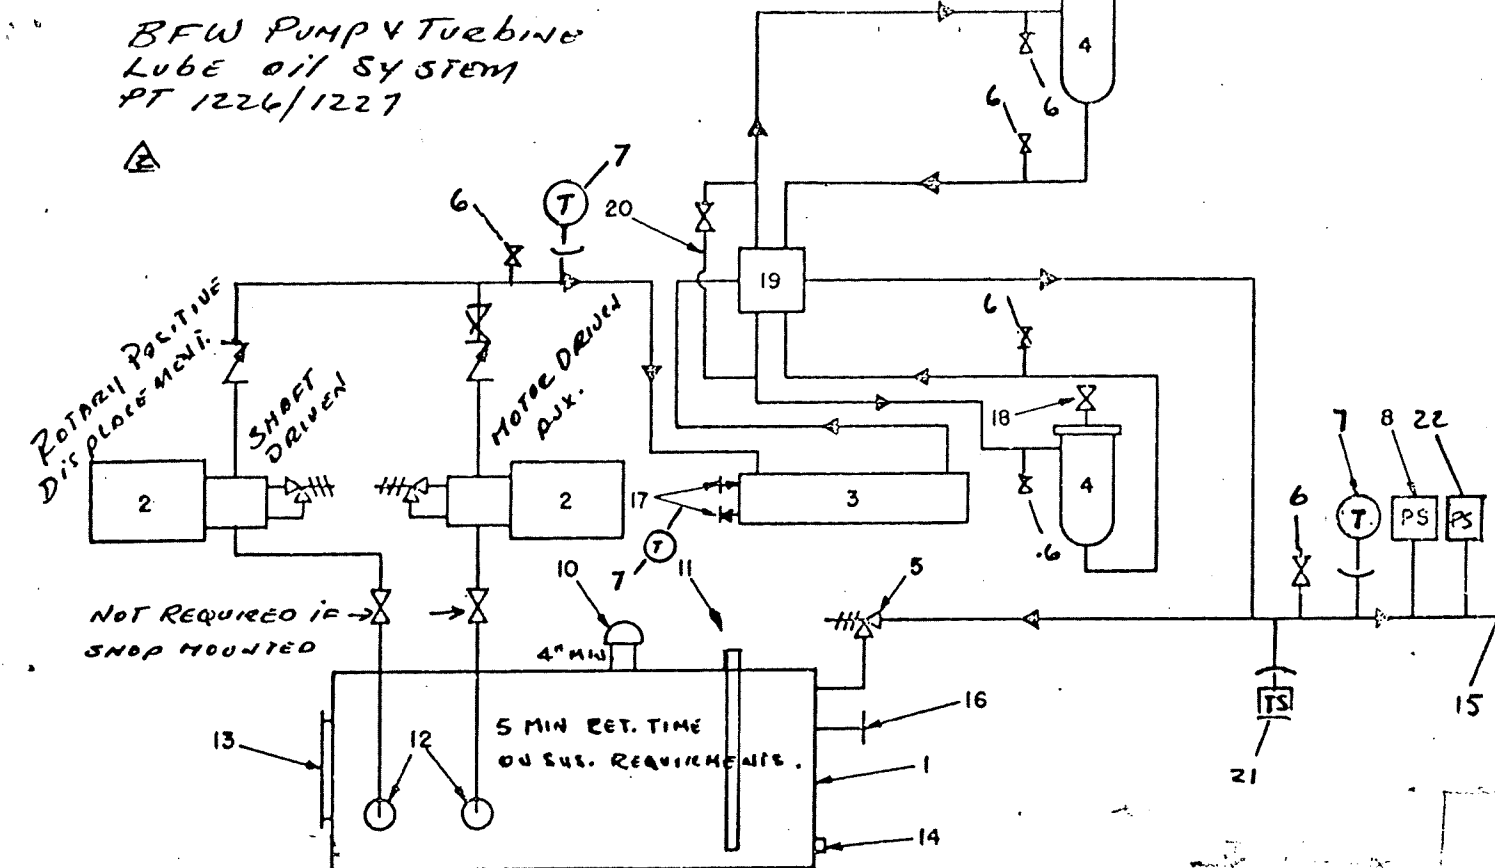

- | | |
|--|-----------------------------------|
| 1. Reservoir | 11. Sight Level Gauge |
| 2. Pump and Driver Assembly | 12. Pump Suction Screen |
| 3. Cooler 5/8" INHIB. ADM. TUBES | 13. Cleanout Opening |
| 4. Filter TWIN, 25 MICRONS | 14. Drain |
| 5. Pressure Regulating Valve FULL FLOW, SELF CONTAINED | 15. Oil Supply Connection |
| 6. VALVE & PLUGGED PRESSURE TAPS. | 16. Oil Return Drain Connection |
| 7. Temperature Gauge 5" DIAL | 17. Cooling Water Connections |
| 8. Pressure Switch LOW OIL ALARM; BFW PUMP START; | 18. Vent Cock |
| 9. SIGHT FLOW INDICATOR | 19. Transfer Valve |
| 10. Fill and Vent Breather Cap | 20. Pressure Equalization Line |
| | 21. TEMP SWITCH - HIGH TEMP ALARM |
| | 22. LOW OIL P.S. - SHUT DOWN |

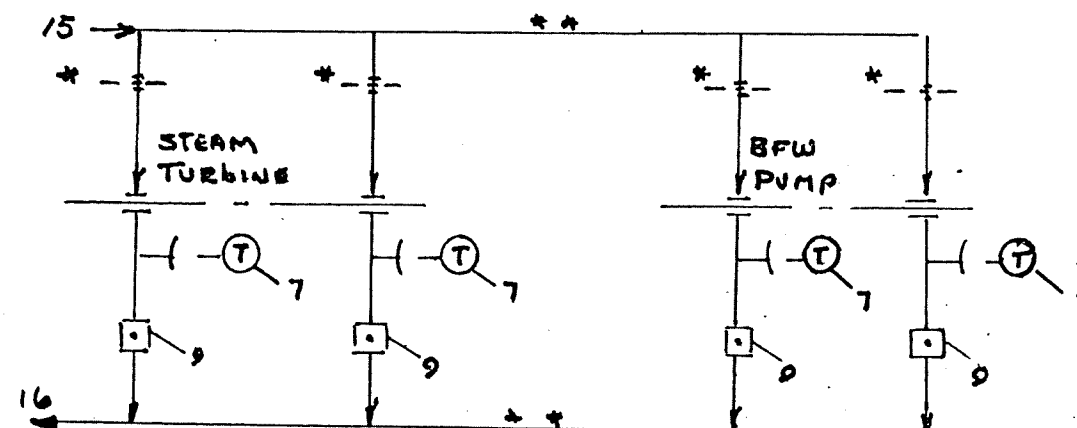

NOTE:

- * 1. ORFICE IF REQUIRED.
- 2. STAINLESS STEEL LUBE OIL PIPING.
- * * 3. LUBE OIL PIPING TO BFW PUMP TO BE SHIPPED LOOSE BY TURBODYN.
- 4. BFW OIL REQUIREMENTS: 4 GPM @ 5 PSIG.
- 5. SKID MOUNTED LUBE CONSOLE


202 W4B
240 PSIG - 403° - 50 PSIG
295 HP @ 4120 RPM (440 HP @ 4760 RPM - RATED)
@ 55 PSIG

FINAL ISSUE
APPROVED BY
Korotenko
DAVY POWERGAS INC.

VENDOR TO PROVIDE WATER RATE DATA

STEAM FLOW - LBS./HR

24000
20000
16000
12000
8000
0

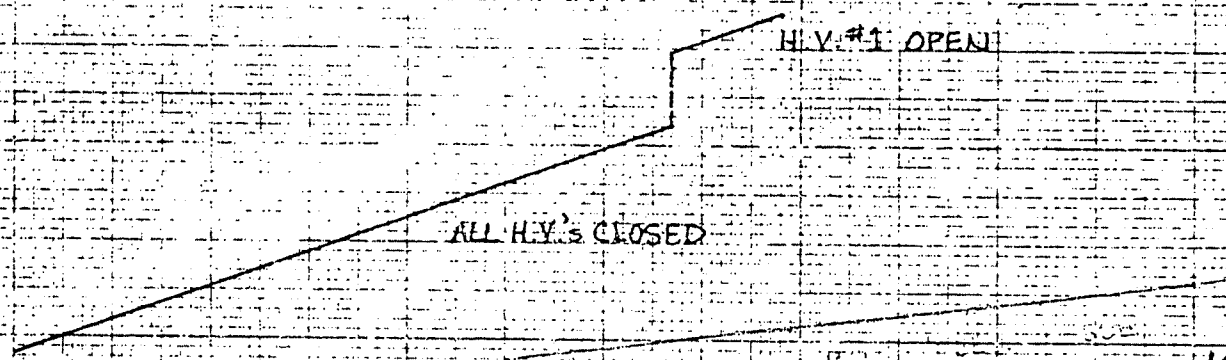

4207 50022 05 A PT1222

HORSEPOWER


WELD NO. 22600
S.O. NO. 19185


TURBODYNE CORPORATION
NORTHINGTON FIRELINE DIVISION
WELLSVILLE, NEW YORK 16803

DATE 12-15-74
EM-18038

NO. 340R-20 DIETZGEN GRAPH PAPER
20 X 20 PER INCH

EUGENE DIETZGEN CO.
MADE IN U. S. A.

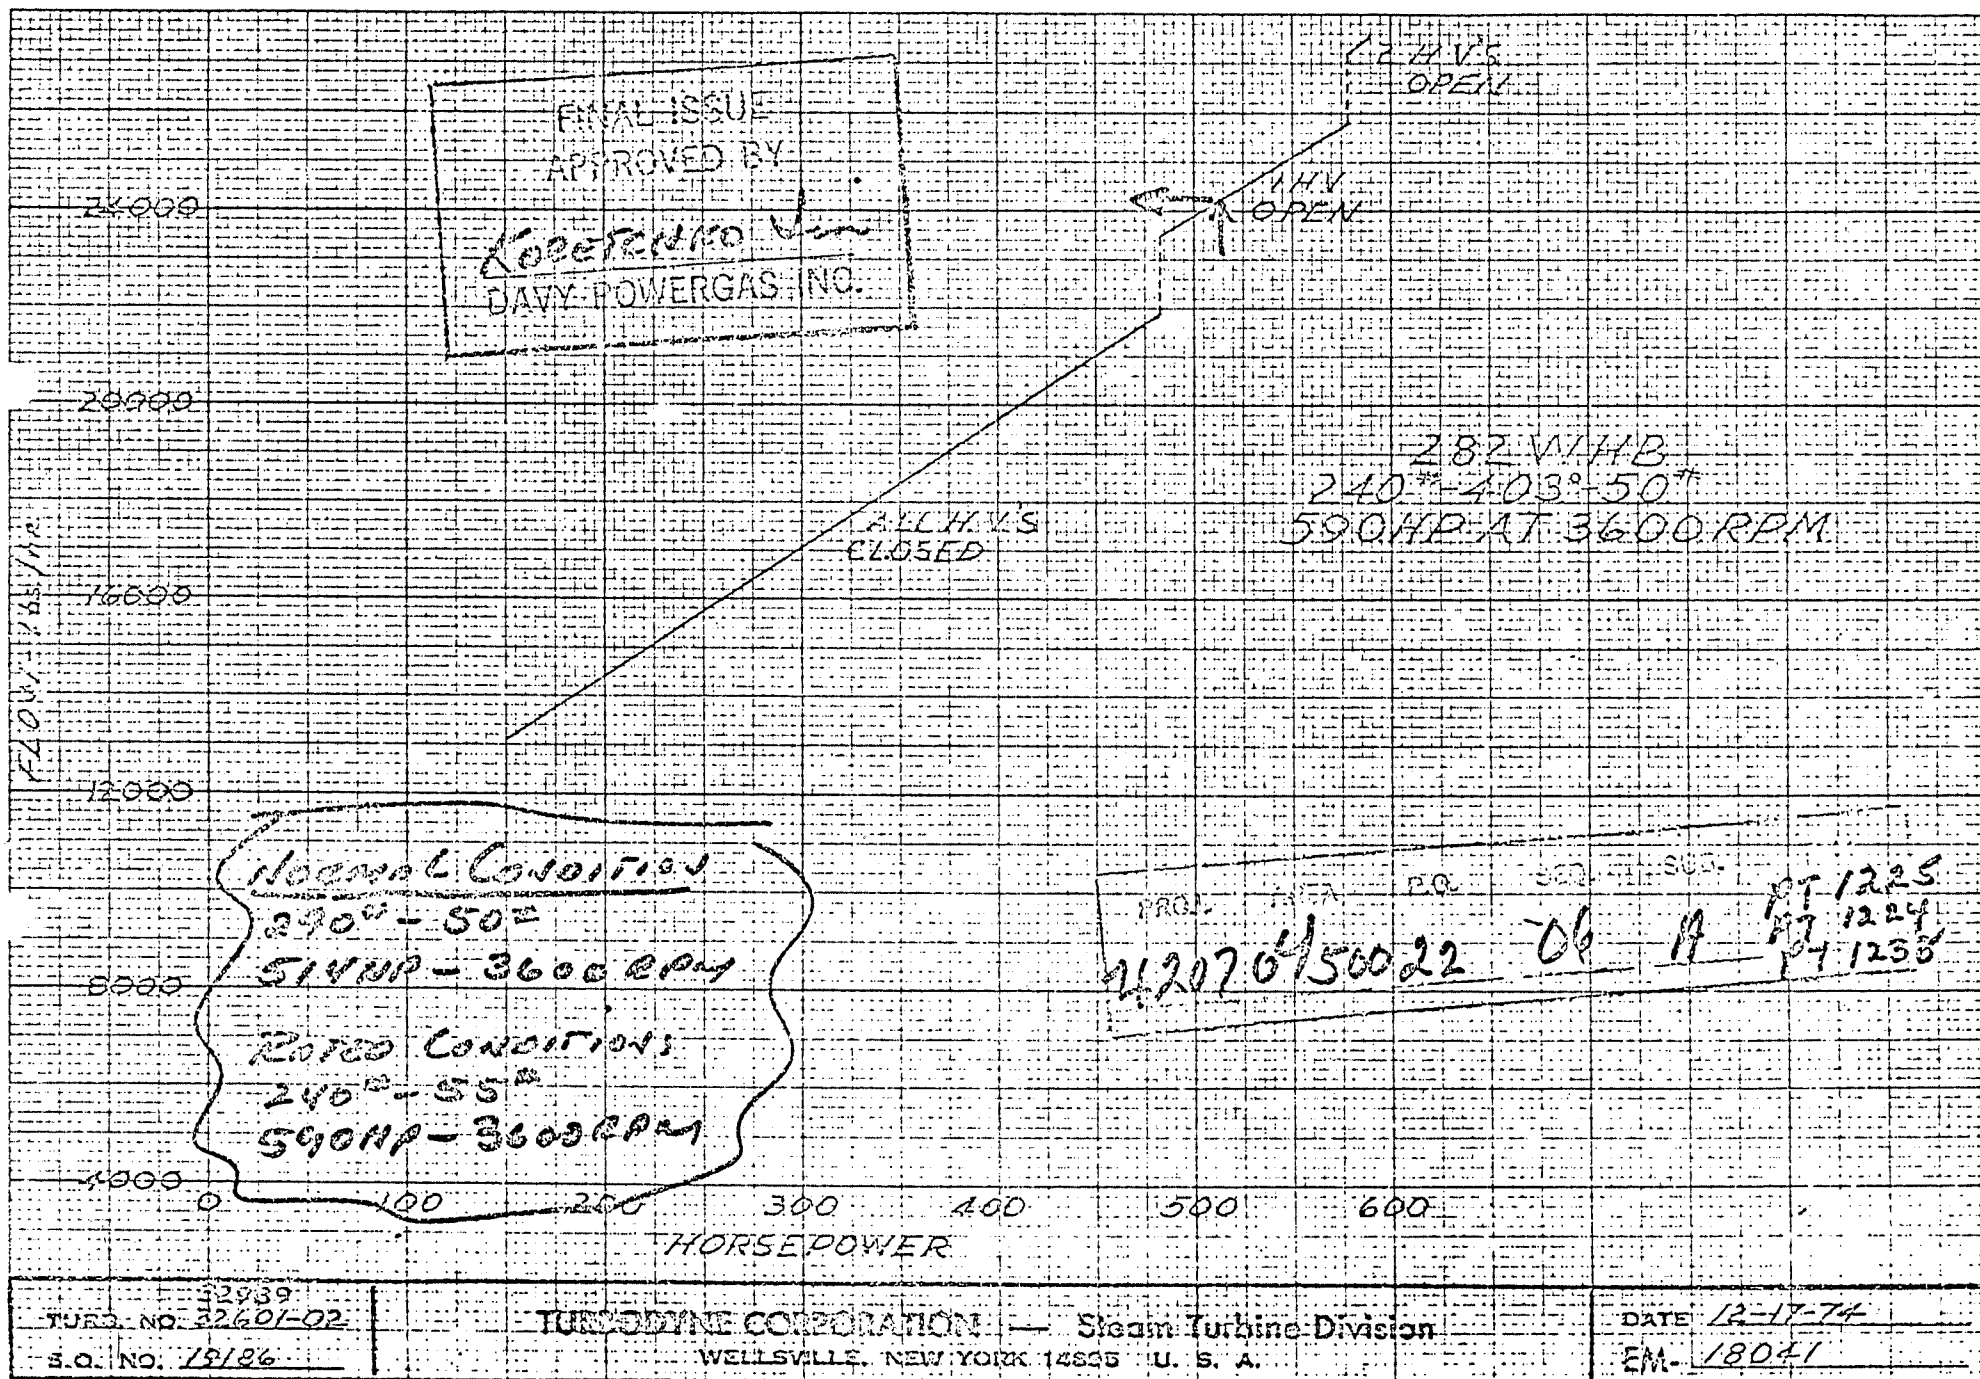


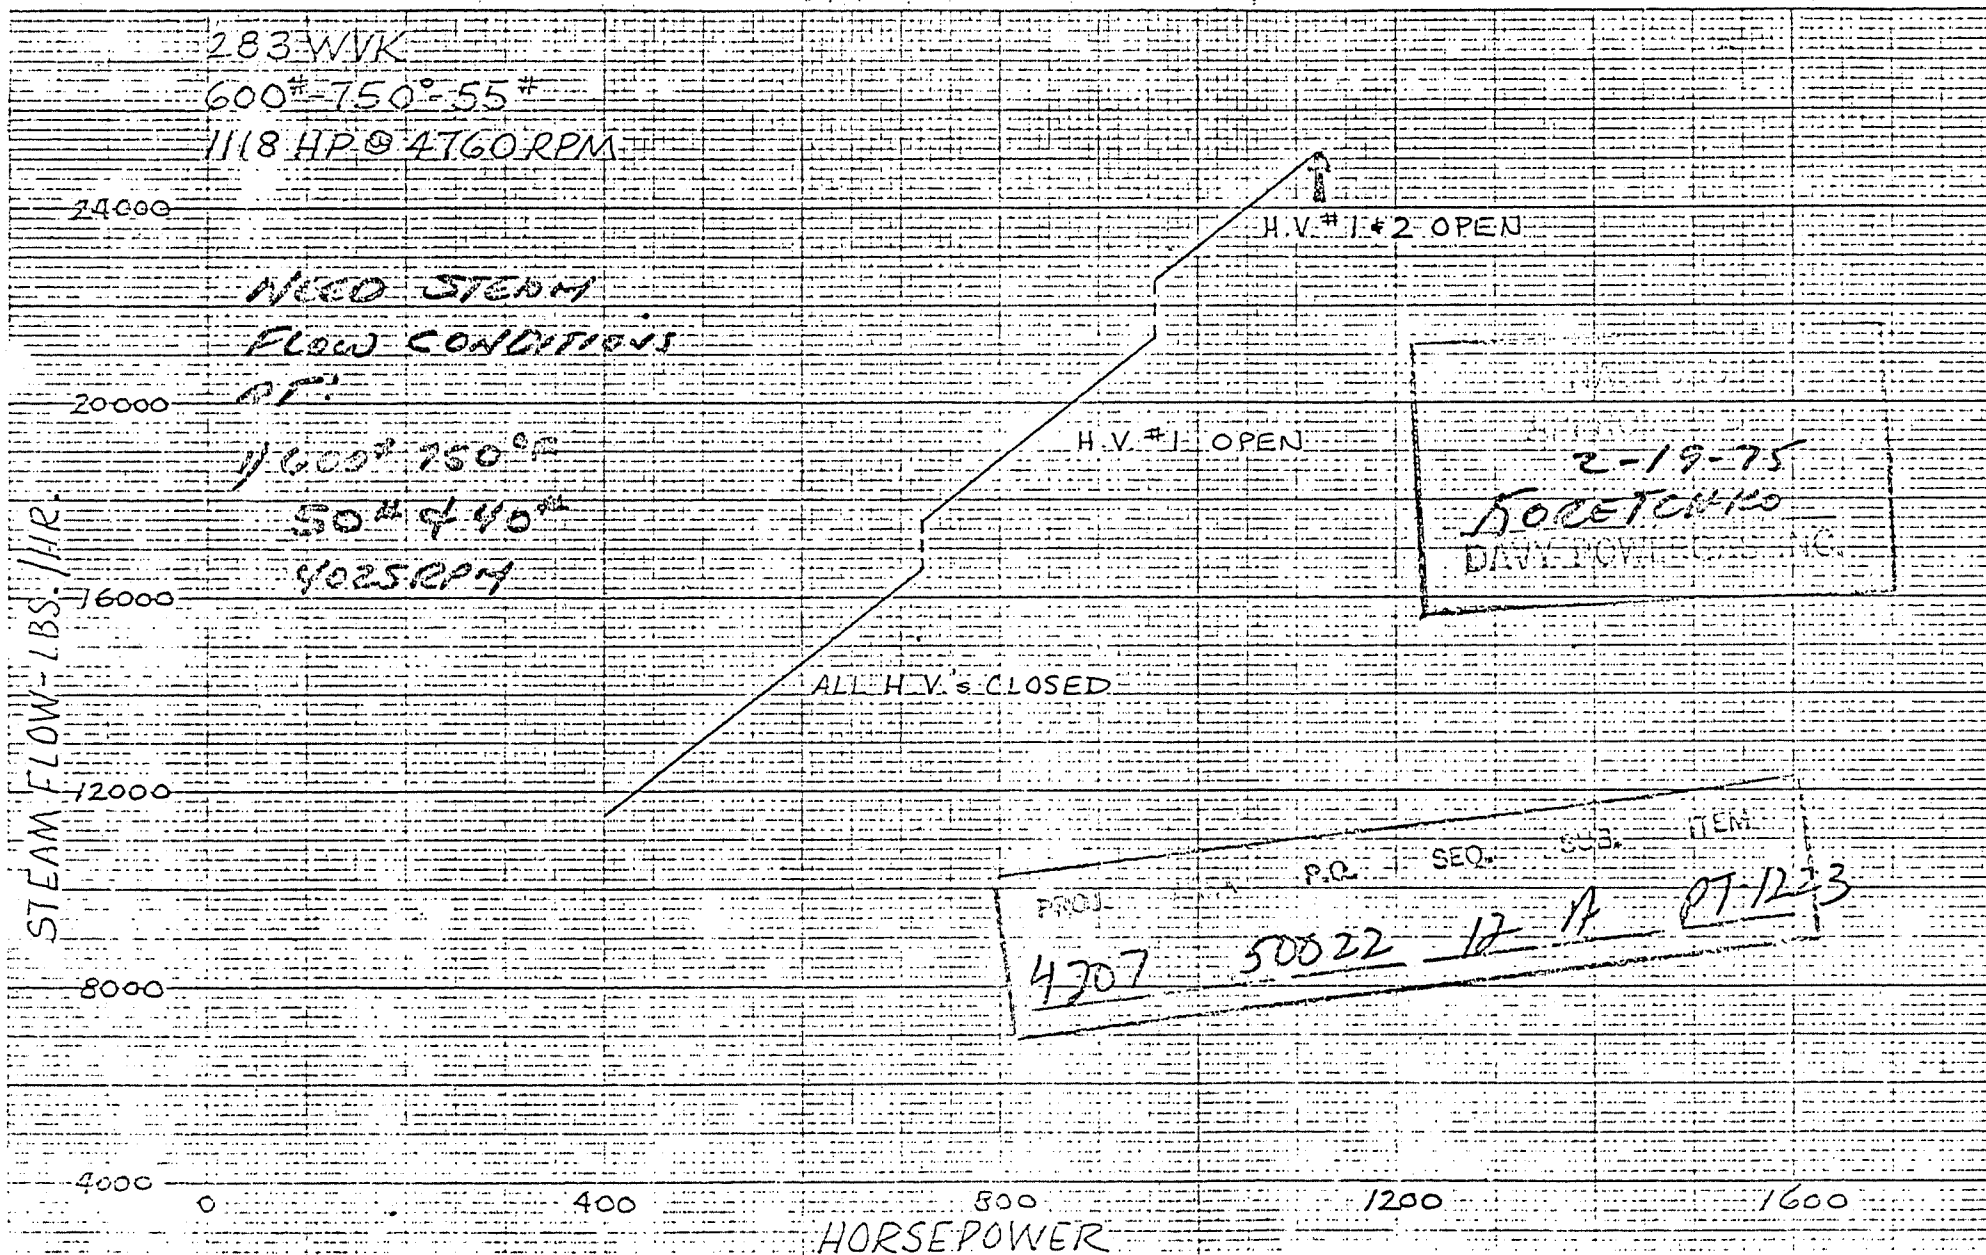


TURB. NO. 32599
S.O. NO. 19184

TURBODYNE CORPORATION
WORTHINGTON TURBINE DIVISION
WELLSVILLE, NEW YORK 14885 U.S.A.

DATE 1-27-75
EM-18081

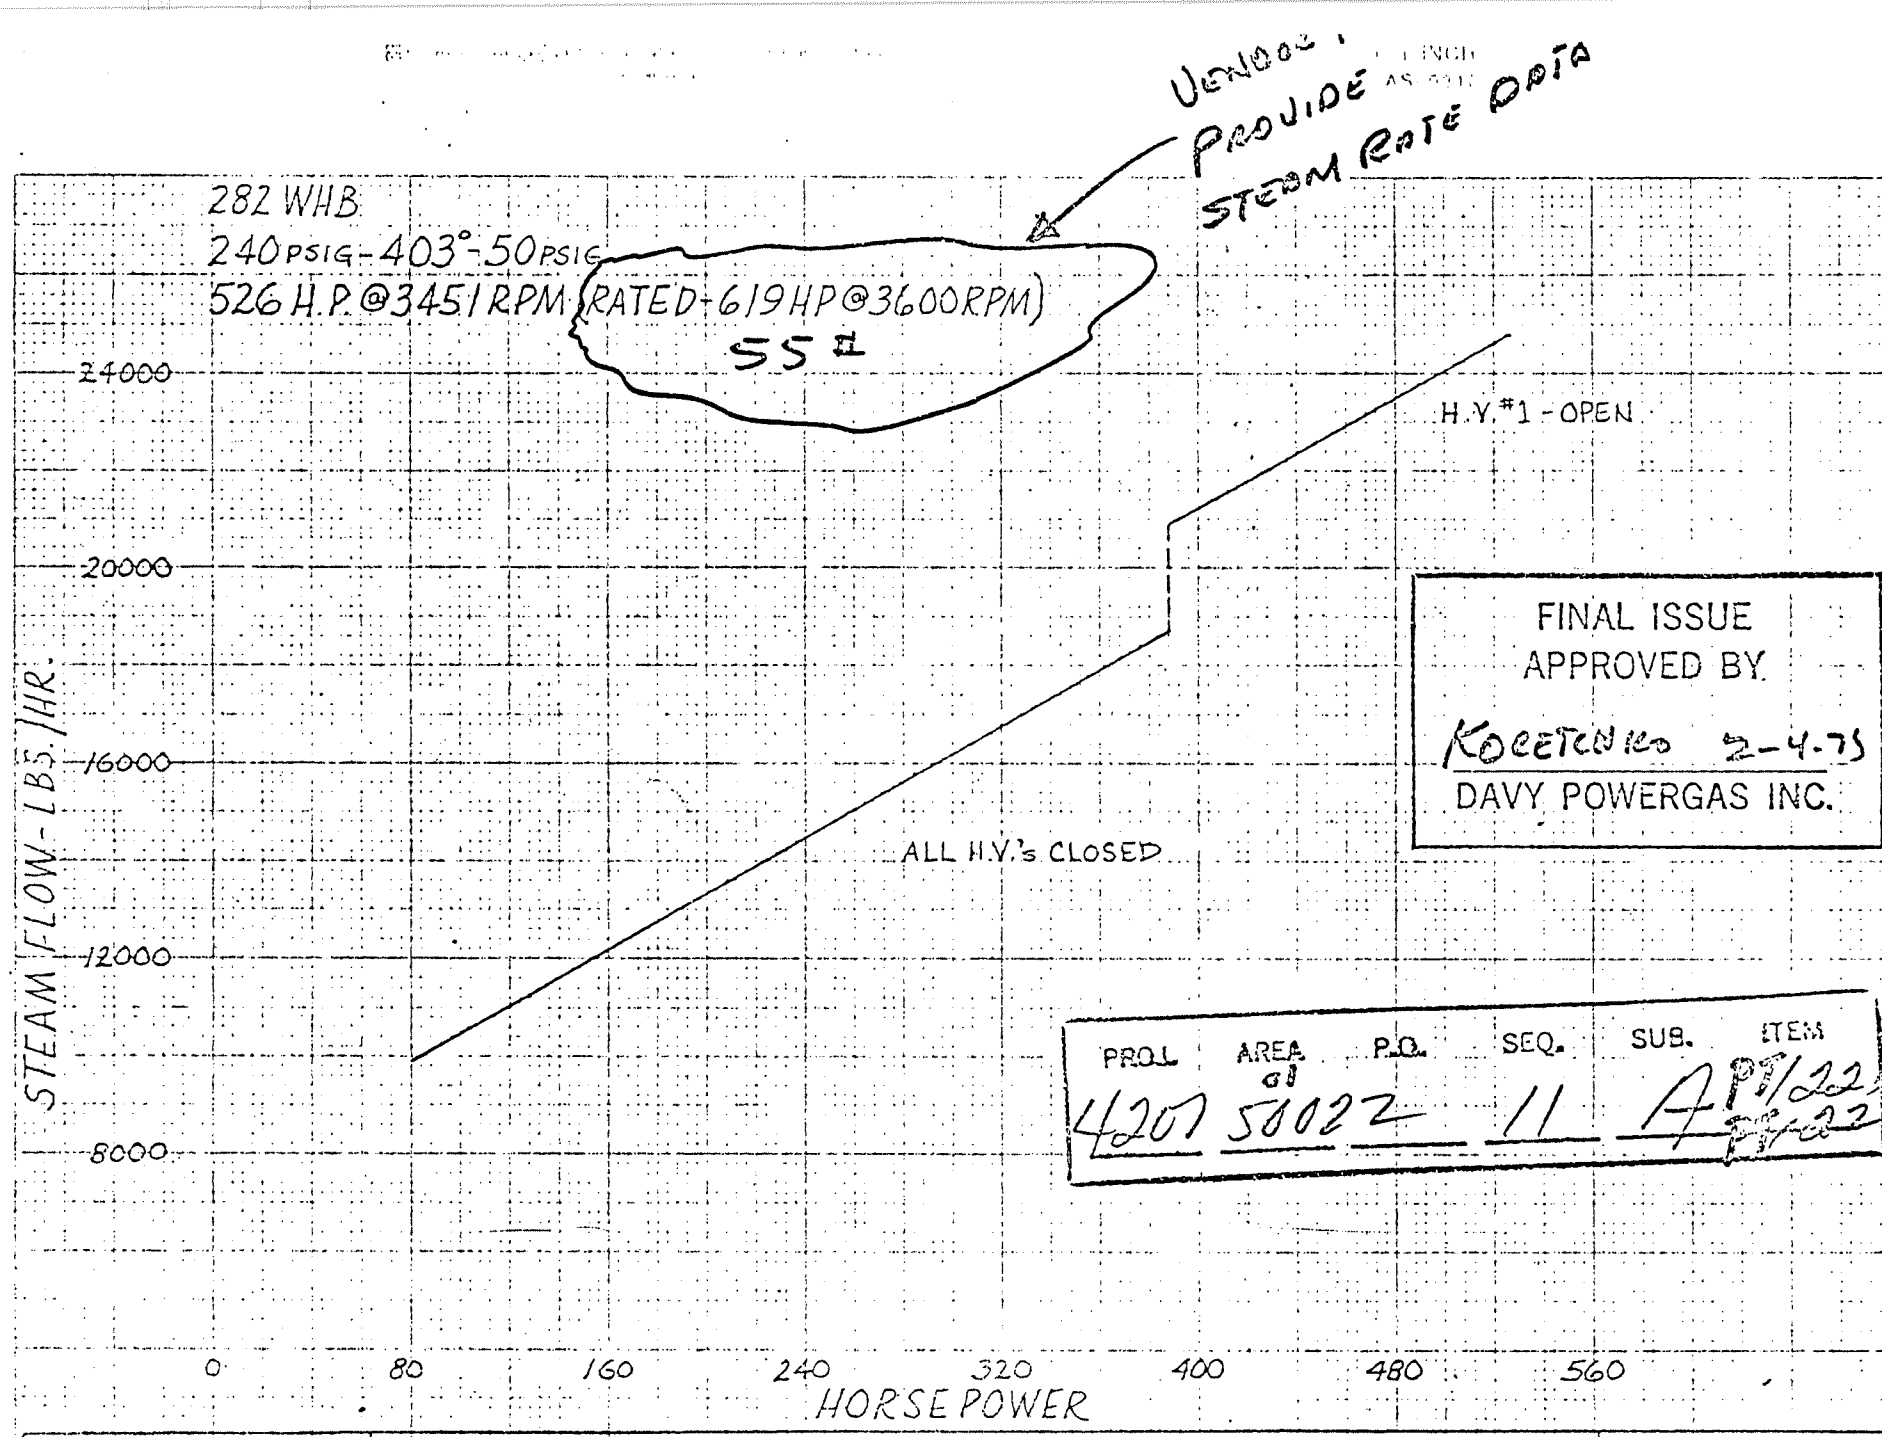

SQUARE 20 x 45 1 INCH
AS-0810 51

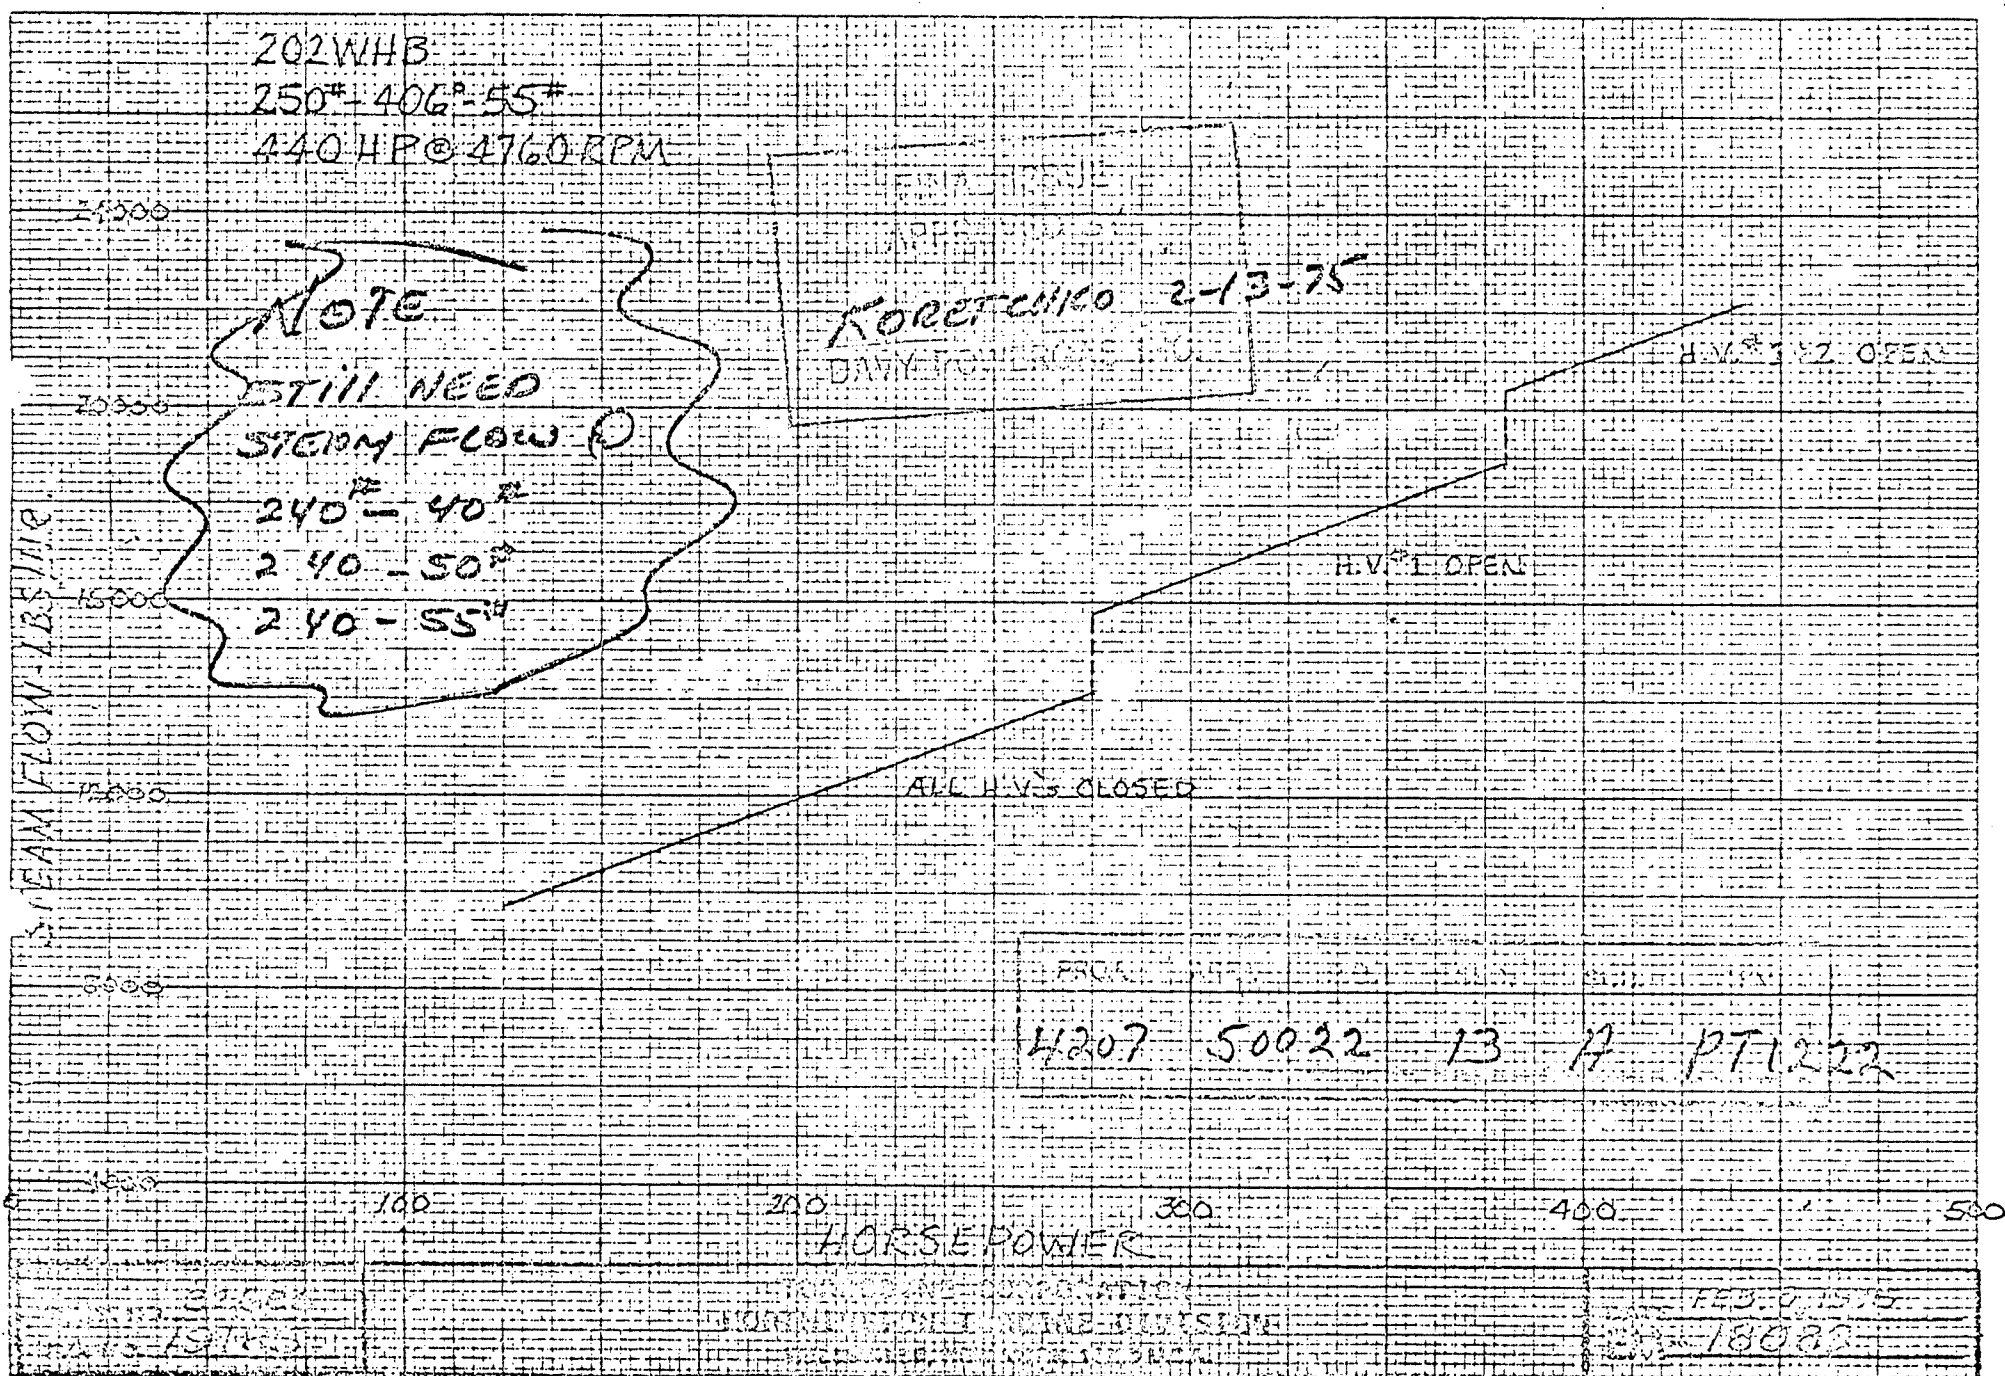

LD-143912

LD-143912, LD-143913
LD-143914, LD-143915

16. GOVERNOR SETTINGS:
 21. - 2850 R.P.M. TURBINE SPEED.
 15. - 5000 R.P.M. TURBINE SPEED.

18. COUPLING NUT SUPPLIED BY WORTHINGTON.

20. LAGGING HOOKS ON TURBINE CASING.

21. USE DRY AIR OR INERT GASES FOR PURGING GOVERNOR - PURGING PRESSURE SHOULD BE SLIGHTLY OVER ATMOSPHERIC PRESSURE.

22. SOLENOID DUMP VALVE 1PH-60HZ 120VA LOCATED IN LOW OIL PRESSURE TRIP LINE TO TRIP WHEN DE-ENERGIZED.

23. TACHOMETER MAGNETIC PICKUP AIRPAX #1-0005 WITH 60TOOTH GEAR ON TURBINE SHAFT.

SEND DETAIL SPEC. OF DWG.

MAX allowable EXH END Pressure?
 NEED DIAGRAMMATIC DWG of oil SYSTEM
 THERMAL EXPANSION INFORMATION? TO BE SENT TO PHIL GERRARD AND BENDIX. NEED CONFIRMATION INFORMATION HAS BEEN SENT.

NOTES:

1. STEAM INLET & EXHAUST PIPING MUST BE PROPERLY SUPPORTED SO AS NOT TO EXCEED ALLOWABLE FORCES & MOMENTS.
2. FOUNDATION BOLTS SHOULD NOT BE RIGIDLY LOCATED UNTIL UNIT IS IN PLACE ON FOUNDATION AS BOLT HOLES IN SOLE PLATE MAY VARY .25
3. HAND SPEED ADJUSTMENT KNOBS MUST BE BACKED OUT AND LOCKED DURING AUTOMATIC SPEED CONTROL.
4. AN ATMOSPHERIC RELIEF VALVE OF SUFFICIENT SIZE TO PASS 23,582 LBS. PER HOUR WITH A MAXIMUM PRESSURE OF 145 LBS. R.S.I.G. AND SET TO OPEN AT 150 LBS. R.S.I.G. SHOULD BE PLACED IN THIS LINE. NO SHUT OFF VALVE SHOULD BE PLACED BETWEEN RELIEF VALVE AND TURBINE.
5. VENT SCREW - LOOSEN TO ALLOW AIR TO BLEED FROM GOVERNOR HYDRAULIC SYSTEM WHEN FIRST PUT INTO SERVICE OR IF GOVERNOR HAS BEEN TAKEN DOWN, DRAINED AND REFILLED.
6. EYEBOLT IN TURBINE CASE COVER TO BE USED FOR LIFTING TURBINE CASE COVER ONLY.
7. BOLT HOLES IN FLANGES TO STRADDLE HORIZONTAL AND VERTICAL CENTERLINES.
8. SENTINEL WARNING VALVE, SETTING?
9. SHIMS FURNISHED BY OTHERS. TO BE USED.
10. HAND VALVES - 2 - REQUIRED.
11. LOW OIL PRESSURE TRIP.
12. KEYWAY - SEE DETAIL OF SHAFT END
13. 4 HOLES - 1/8 DIA. DRILL THRU FOR 1/2" FOUNDATION BOLTS (SEE NOTE #2)
14. HIGH SPEED STOP OVERRIDE DEVICE.
15. EXHAUST FLANGE STUDS FURNISHED BY TURBODYNE.

"SST" LINE STEAM TURBINE

WITH WOODWARD (PG-PL) DIRECT ACTING (HB) GOVERNOR

440 HP. FRAME 202 WHB 4760 RPM.

APPROXIMATE WEIGHTS

TURBINE	2000 LBS
SOLE PLATE	275 LBS
APPROX. WEIGHT	2275 LBS
UPPER HALF OF TURBINE CASING	250 LBS
TURBINE ROTOR	235 LBS

CUSTOMER'S FLANGED CONNECTIONS

FLANGE	USA S.I. SIZE	O.D.	B.C.	NO. HOLES	DIA. HOLES	MIN. FLANGE THICKNESS	RAISED FACE	REMARKS
A TURBINE INLET	600	4	10.75	8	1 1/4	1.50	25x6.9 DIA.	NOTE #1
B TURBINE EXHAUST	150	8	13.50	8	2-10/16	1.50	NONE	NOTES #1 & 4
C LUBE OIL SUPPLY	150	7/4	3.87	4	5/8	.50	NONE	
D LUBE OIL DRAIN	150	1 1/2	5.00	4	5/8	.68	NONE	

CUSTOMER'S SCREWED CONNECTIONS

CONNECTION	NO.	SIZE	VALVE REQ'D	VALVE SUPPLIED BY	PIPE TO	REMARKS
A-J STEAM RING DRAIN	1	3/4" PIPE 4 TAP	YES	CUSTOMER	OPEN DRAIN	
B-J TURBINE CASING DRAIN	1	3/4" PIPE 4 TAP	YES	CUSTOMER	OPEN DRAIN	
C-J STEAM END PACKING CASE DRAIN	1	1/2" PIPE 4 TAP	NO		OPEN DRAIN	
D-J EXHAUST END PACKING CASE DRAIN	1	1/2" PIPE 4 TAP	NO		OPEN DRAIN	
E-J STEAM CHEST DRAINS	2	3/4" PIPE 4 TAP	YES	CUSTOMER	OPEN DRAIN	
F-J STEAM CHEST COVER DRAIN	1	1/2" PIPE 4 TAP	NO		OPEN DRAIN	
A-T TACHOMETER MAGNETIC PICKUP CONDUIT	1	1/2" PIPE 2 TAP				NOTE #19
A-S PNEUMATIC SPEED CONTROL	1	1/2" S.A.E. 4 TUBING				CUSTOMER'S AIR SUPPLY NOTE #16
B-S GOVERNOR PURGE AIR	1	1/2" S.A.E. 4 TUBING				NOTE #21
BT SOLENOID DUMP VALVE COND. CONN.	1	3/4" PIPE 4 TAP				NOTE #22
A-X INITIAL GAUGE CONN.	1	3/4" PIPE 4 TAP	YES	TURBODYNE		
B-X STEAM RING GAUGE CONN.	1	3/4" PIPE 4 TAP	YES	TURBODYNE		
C-X EXHAUST GAUGE CONN.	1	3/4" PIPE 4 TAP	YES	TURBODYNE		

PROJ. AREA P.O. SEQ. SUB. ITEM
 420 01 5000 16 A PT-1222
 ITEM PT-1222

OUTLINE

WORTHINGTON TURBINE INTERNATIONAL, INC.

A DIVISION OF TURBODYNE CORPORATION

WELLSVILLE, NEW YORK 14890 U.S.A.

DRAWN: A. GARROD DATE: 1-24-75

CHECKED: J. W. H. DATE: 1-24-75

APPROVED: A. J. H. DATE: 1-24-75

SCALE: 1/8" = 1'-0"

FRAME 202 WHB

FIRST SIZE 1/8" DIA.

PIPING CALCULATIONS

THE TOTAL RESULTANT FORCE AND TOTAL RESULTANT MOMENT IMPARTED ON THE TURBINE AT ANY CONNECTION MUST NOT EXCEED THE FOLLOWING:

F = A-M

FLANGE INLET 2075
EXHAUST 400

RESULTANT FORCE, INCLUDING PRESSURE FORCES WHERE UNRESTRAINED EXPANSION JOINTS ARE USED AT THE CONNECTION, POUNDS

M = RESULTANT MOMENT, POUND FEET

THE COMBINED RESULTANTS OF THE FORCES AND MOMENTS OF THE INLET AND EXHAUST CONNECTIONS, RESOLVED AT THE CENTERLINES OF THE EXHAUST CONNECTION MUST NOT EXCEED THE FOLLOWING TWO CONDITIONS:

THE RESULTANTS MUST NOT EXCEED: F = 2210 LBS
M = 1110 POUND FEET

COMBINED RESULTANT OF INLET AND EXHAUST FORCES: F = 2210 LBS
M = 1110 POUND FEET

COMBINED RESULTANT OF INLET AND EXHAUST MOMENTS AND MOMENTS RESULTING FROM FORCES, POUND FEET

THE COMPONENTS OF THESE RESULTANTS SHALL NOT EXCEED:

F_x = 445 POUNDS F_y = 1110 POUNDS F_z = 890 POUNDS
M_x = 2210 POUND FEET M_y = 1110 POUND FEET M_z = 1110 POUND FEET

PARALLEL TO TURBINE SHAFT
VERTICAL
HORIZONTAL AND AT RIGHT ANGLES TO TURBINE SHAFT

TO BE USED FOR THE PURPOSE OF CHECKING THE DESIGN OF THE TURBINE AND ITS CONNECTIONS TO THE PIPING SYSTEM.

DESIGNED BY: J. W. H. DATE: 1-24-75
CHECKED BY: J. W. H. DATE: 1-24-75
APPROVED BY: A. J. H. DATE: 1-24-75

IMPORTANT

THIS DRAWING HAS BEEN RELEASED FOR PRODUCTION ANY CHANGES MAY AFFECT PRICE AND DELIVERY.

THIS DRAWING AND ALL INFORMATION THEREON IS THE PROPERTY OF THE WORTHINGTON CORPORATION, AND IS CONFIDENTIAL AND MUST NOT BE MADE PUBLIC OR COPIED. IT IS SUBJECT TO RETURN ON DEMAND.

THIS PRINT IS CERTIFIED CORRECT FOR






STEAM TURBINE DIVISION


LD-143912

LC-144997

- ② WORM & WHEEL SPRAY.
 ③ 1/4" ORIFICE NIPPLE.
 ④ 1/2" GAUGE VALVE
 ⑤ BEARING OIL PRESSURE GAUGE
 2-1/2 DIAL RANGE 0 TO 30 1/4" BOTTOM
 CONNECTED LINE MOUNTED.

OIL REQUIREMENTS

BEAR. OIL ————— 3 GPM AT 15 P.S.I.
 DRAIN FROM CONN'D ——— 3 GPM

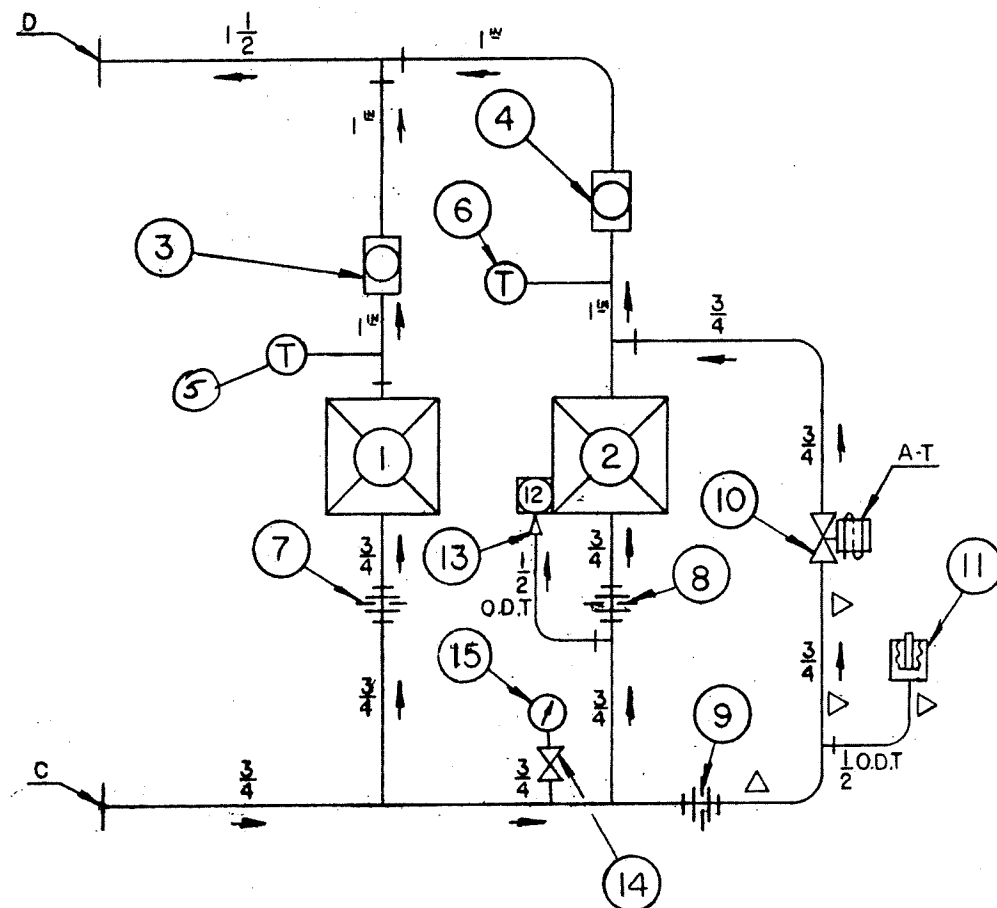

— — — — — LINES PIPED IN SHOP BY TUBODYNE
 ▲ ▲ ▲ ▲ ▲ RECOMMENDED LINES TO BE STEAM
 TRACED - CAUTION: OVER HEATING
 MAY CAUSE CARBONIZATION OF OIL.

DESCRIPTION

- ① EXHAUST END BEARING.
- ② STEAM END BEARING.
- ③ 1" SIGHT FLOW INDICATOR, WITH FLAPPER REMOVED
FISHER & PORTER (EXH. END BEARING DRAIN).
- ④ 1" SIGHT FLOW INDICATOR, WITH FLAPPER REMOVED
FISHER & PORTER (STM. END BEARING DRAIN).
- ⑤ THERMOMETER - 5" DIAL ASHCROFT - EVERY
ANGLE 3/4" PIPE THD. SEPARABLE SOCKET
(EXH. END BEARING DRAIN).
- ⑥ THERMOMETER - 5" DIAL ASHCROFT - EVERY
ANGLE 3/4" PIPE THD. SEPARABLE SOCKET
(STM. END BEARING DRAIN).
- ⑦ ORIFICE PLATE 3/32" DIA. HOLE.
- ⑧ ORIFICE PLATE 3/16" DIA. HOLE.
- ⑨ ORIFICE PLATE 1/8" DIA. HOLE.
- ⑩ 3/4" SOLENOID DUMP VALVE - TO TRIP
WHEN DE-ENERGIZED.
- ⑪ LOW OIL PRESSURE TRIP SET AT 3 P.S.I.
RESET MANUALLY.

NOTES:

1. IDENTIFY ALL CUSTOMER'S CONNECTIONS.
2. SHOP TO PROVIDE PIPING SUPPORTS WHERE
NECESSARY.
3. SEE OUTLINE DWG FOR SIZE AND
LOCATIONS OF CONNS. D, C, A-T.
4. ALL PIPING MUST BE KEPT WITHIN OUTLINE
LIMITATIONS IF POSSIBLE.
5. ALL BUTT WELDED JOINTS TO HAVE FULL
PENETRATION.
6. WELDING TO BE DONE PER WORTHINGTON SPEC.
W/0.32.
7. ON ALL FABRICATED PIPING DISASSEMBLED FOR
SHIPPING TAG EACH END OF BROKEN JOINT
WITH CORRESPONDING NUMBER FOR
REASSEMBLY ON SITE
8. STN. STEEL PIPE TO BE MECHANICALLY
CLEANED AT WELDS AS REQUIRED & SUITABLY
WASHED WITH CLEANING FLUID TO REMOVE
DIRT.
9. FLANGES IN STN. STEEL LINES ARE SLIP-ON TYPE
STN. STEEL, AND ARE WELDED FRONT &
BACK WITH STN. STL. WELDING ROD.
10. BOLT HOLES IN FLANGES TO STRADDLE CENTERLINES
UNLESS OTHER POSITIONING IS SPECIFIED OR
SHOWN ON DRAWING.

DIAGRAMMATIC SKETCH
OF OIL PIPING

WORTHINGTON CORPORATION
 TURBINE DIVISION
 WELLSVILLE, N. Y. U. S. A.

DRAWN: H.C. DUNN DATE: 4-2-75
 TRACED: SCALE: N.T.S.
 CHECKED: M.A. 12-75 FRAME:
 APPROVED: J.R. 4-14-75 TEST. & O. 6-19-75

LC-144997

ITEM - PT-1222

FINAL ISSUE
 APPROVED BY

Radcliffe 5-9-75
 DAY POWERGAS INC.

MICROFILM

AREA	P.O.	SEQ.	SUB.	ITEM
4207	50022	20	A	PT-1222

IMPORTANT

THIS DRAWING HAS BEEN
 RELEASED FOR PRODUCTION
 ANY CHANGES MAY AFFECT
 PRICE AND DELIVERY.

THIS DRAWING AND ALL INFORMATION THEREON
 IS THE PROPERTY OF THE WORTHINGTON CORPO-
 RATION, AND IS CONFIDENTIAL AND MUST NOT
 BE MADE PUBLIC OR COPIED. IT IS SUBJECT TO
 RETURN ON DEMAND.

THIS PRINT IS CERTIFIED CORRECT FOR

Celanese Chemical Co.

CUSTOMER'S ORDER NO. 040-041-58022

BRANCH OFFICE NO. 30-40025

WORKS ORDER NO. U-19185

APPROVED BY: J.R. Burgess DATE: 4/24/75

THE CONSTRUCTION SHOWN IS STANDARD FOR THIS MACHINE
 ANY DEVIATION FROM STANDARD MAY INVOLVE ADDITIONAL
 COST. A CORRESPONDING INCREASE IN SELLING PRICE AND
 DELAY IN SHIPMENT IF CHANGES ARE NECESSARY. INDICATE
 THEM CAREFULLY AND IN DETAIL ON THIS PRINT AND RETURN
 TO TURBODYNE CORP. YOU WILL BE ADVISED PROMPTLY AS TO
 THE ADDITIONAL PRICE. MEANWHILE THOSE DETAILS INVOLVED
 WILL BE HELD UP UNTIL YOUR AUTHORIZATION TO PROCEED
 IS RECEIVED.

STEAM TURBINE DIVISION

#8

RECOMMENDED SPARE PARTS FOR TURBINE 19185 SER.NO. 32600						
PART NO.	SECTION DRAWING	NAME OF PART	QTY. **	DRAWING NO.	MATERIAL	UNIT PRICE F.O.B. WORKS
	LE-135666-A	MAIN TURBINE BEARINGS				
38		STEAM END BEARING	1	IC-102699-1-2	B&B	\$204.00
60		EXHAUST END BEARING	1	IC-81654-1-2	B&B	86.54
348		MAIN BALL THRUST BEARING	1	ND 3311XR	STL	14.84
		TURBINE SHAFT PACKING				
46		Carbon Rings	2	W-35173-1	L51X	16.62
46		Carbon Rings	8	W-35173-2	L51X	16.62
403		Carbon Ring Springs	10	V-12729	INC	4.35
		GOVERNOR WEARING PARTS				
203-7		GOVERNOR VALVE & BUSHING ASSM.	1	25353	---	940.00
201		EMERGENCY VALVE SPINDLE	1	V-9654	STSTL	40.18
752		VALVE LINK	1	LA-126882-1	STSTL	83.03
108		BALL BEARING UPPER DRIVE SHAFT	1	ND#3207	STSTL	2.96
112		BALL BEARINGS LOWER DRIVE SHAFT	1	ND#3207	STSTL	2.96
100		WORM WHEEL	1	LB-102697-3	STSTL	89.06
2306		GOVERNOR DRIVE SHAFT	1	IC-102695-1	ALLOY STL	106.74
2036		WOODWARD GOVERNOR COUPLING SLEEVE	1	LA-100976-1	STL	103.00
376		Sylphon Bellows	1	W-20024	---	121.00
24		EMERGENCY GOVERNOR CUP	1	LB-102369-1	HRS	
		EMERGENCY GOVERNOR PARTS	1 Set	465561-3		476.00
Prices shown are those in effect at this date and are subject to change without notice. Invoice prices will be those in effect at time of shipment.						
				PROJ.	AREA	P.O.
				4107	50822	24
						A
						PT-1222
Wellsville Q-73223 Date Issued: 4/30/75						
Estimated Delivery 70-80 Working Days						
** QUANTITY OF PARTS PER TURBINE. QUANTITY OF SPARES TO BE STOCKED IS CUSTOMERS OPTION						

PROJ.	AREA	P.O.	SEQ.	SUB.	ITEM
4207	50022	30	B		PT-1222 1226 1227

CELANESE CHEMICAL COMPANY

BISHOP, TEXAS

Outline & assembly dwg. -
Also lube oil diagram etc.
have not been approved

FINAL ISSUE
APPROVED ☒ As Noted
Korechko 10-6-75
DAVY POWERGAS INC.

INSTRUCTIONS FOR

SINGLE STAGE

NON-CONDENSING STEAM TURBINES

TURBINE SERIAL NUMBERS

32597 - 32598 - 32600

WELLSVILLE WORKS ORDER NUMBERS

U - 19183 - U-19185

TURBODYNE
CORPORATION

STEAM TURBINE DIVISION

WELLSVILLE, NEW YORK 14895

Aug. 1975

TURBINE DATA SHEET

U-19183 - U-19185

Serial Numbers - 32597 - 32598 (U-19183)
32600 (U-19185)

Turbine Frame - 282 WHB (U-19183)
202 WHB (U-19185)

Number of Turbine Stages - 1 Curtis

Driven Machine - Bingham Boiler Feed Water Pump (U-19183)
Forced Draft Fan (U-19185)

Turbine Rating - 619 H.P. at 3600 R.P.M. (U-19183)
440 H.P. at 4760 R.P.M. (U-19185)

Turbine Rotation Viewed From Governor End of Turbine - Counterclockwise

Inlet Steam Conditions - 240 psig. at 403° F.T.T.

Exhaust Condition - 50 psig.

Variable Conditions - 250 psig. - 406° F.T.T. - 55 psig. (Maximum)
240 psig. - 403° F.T.T. - 40 psig. (Minimum)

Casing Material - Cast Steel

Shaft Packing - 5 Carbon Rings in Each Packing Case

Bearing Pressure - 8 psig. (U-19183)
15 psig. (U-19185)

Low Oil Pressure Trip To Trip Out Turbine At - 3 psig.; Reset 4.5 psig. (U-19183)
3 psig.; Reset Manually (U-19185)

Low Oil Pressure Alarm Switch Set to Alarm At 4.8 psig. Falling Oil Pressure

Quantity of Fresh Cooling Water Required For Oil Cooler - 12 G.P.M. at 90° F. (U-19183)

Auxiliary Oil Pump - Motor Driven - Capacity 9.4 G.P.M. at 28 psig. (U-19183)
Pump To Cut In At 6 psig. - Cut Out at 7 psig.

High Oil Temperature Alarm Switch Set At - 130° F. (U-19183)

Solenoid Dump Valve To Trip When - Energized (U-19183)
De-Energized (U-19185)

Emergency Overspeed Trip Setting -- 4158 R.P.M. (U-19183)
5500 R.P.M. (U-19185)

TURBINE DATA SHEET

U - 19183 - 19185

Sentinel Warning Valve Set To Open At - 90 psig.

Journal Bearing Information:

Shaft Bearing Journal Size -	Bearing Bore -
Steam End - 2.620 ^{+.000} _{-.001}	2.626 ^{+.001} _{-.000}
Exhaust End - 2.620 ^{+.000} _{-.001}	2.626 ^{+.001} _{-.000}

Turbine Main Journal Running Clearance: Steam End - .006" to .008"
Exhaust End - .006" to .008"

Governor Valve Size - 3-5/8" (U-19183)
4" (U-19185)

Speed Governor - Woodward Direct Acting PG-PL

Governor Air Signal - Turbine Speed Relationship

U-19183	U-19185
3 psig. - 2700 R.P.M.	2850 R.P.M.
15 psig. - 3780 R.P.M.	5000 R.P.M.

Governor Speed Setting - 3600 R.P.M. (U-19183)
4760 R.P.M. (U-19185)

Exhaust Relief Valve To Start Opening at 100 (U-19183)
130 (U-19185) psig., to be fully
open at U-19183) 110 32,430
(U-19185) 145 psig. to pass 23,582 #/hr. (U-19185)

Number of Hand Valves - Two (2) for Part Load

Valves Open	H.P. Load at Rated Condition	
(U-19183)	(U-19183)	U-19185)
Governor (Hand Valves Closed)	356	246
# 1	490	339
# 1 - # 2	619	440

TURBINE WEIGHTS - See Outline Drawing, Figure A-1

WARNING! EYEBOLT IN TURBINE CASE COVER TO BE USED
FOR LIFTING TURBINE CASE COVER ONLY

QUANTITY		DESCRIPTION OF PART	DRAWING NO. & ITEM NO.	PATTERN NO.	MATERIAL	MATERIAL SPEC. NO.	PROCESS SPEC. NO.	ITEM NO.
GR. 2	GR. 1							

PIPING CALCULATIONS

1. THE TOTAL RESULTANT FORCE AND TOTAL RESULTANT MOMENT IMPOSED ON THE TURBINE AT ANY CONNECTION MUST NOT EXCEED THE FOLLOWING:

	FLANGE	A
$F = \frac{A-M}{3}$	INLET	2000
	EXHAUST	4000

F = RESULTANT FORCE, INCLUDING PRESSURE FORCES WHERE UNRESTRAINED EXPANSION JOINTS ARE USED AT THE CONNECTION, POUNDS.

M = RESULTANT MOMENT, POUND FEET

2. THE COMBINED RESULTANTS OF THE FORCES AND MOMENTS OF THE INLET AND EXHAUST CONNECTIONS, RESOLVED AT THE CENTERLINES OF THE EXHAUST CONNECTION MUST NOT EXCEED THE FOLLOWING TWO CONDITIONS.

a. THE RESULTANTS MUST NOT EXCEED: $F_c = \frac{2220 - M_c}{2}$

F_c = COMBINED RESULTANT OF INLET AND EXHAUST FORCES, POUNDS.

M_c = COMBINED RESULTANT OF INLET AND EXHAUST MOMENTS AND MOMENTS RESULTING FROM FORCES, POUND FEET.

b. THE COMPONENTS OF THESE RESULTANTS SHALL NOT EXCEED:

$F_x =$	445 POUNDS	$M_x =$	2220 POUND FEET
$F_y =$	1110 POUNDS	$M_y =$	1110 POUND FEET
$F_z =$	890 POUNDS	$M_z =$	1110 POUND FEET

x, PARALLEL TO TURBINE SHAFT

y, VERTICAL

z, HORIZONTAL AND AT RIGHT ANGLES TO TURBINE SHAFT

TOLERANCE FOR DIMENSIONS TO HUNDREDTHS OF AN INCH
1 - FINISHED SURFACE ± .02
2 - UNFINISHED SURFACE ± .05
REF.

REVISIONS			4 in. INLET	LA-125374
			8 in. EXHAUST	
			WORTHINGTON TURBINE INTERNATIONAL, INC.	
			A DIVISION OF TURBODYNE CORPORATION	
			WELLSVILLE, NEW YORK 14806 U.S.A.	
			DRAWN: D.L.	DATE:
			TRACED:	SCALE:
			CHECKED: F.J.R.	FRAME:
			APPROVED: M.S. 6-4-70	FIRST S.O.:

1 ROUGH 250
2 FINE 125
3 GRIND 32
4 POLISH 15

25 SMOOTH 63
3 GRIND 32
4 POLISH 15

QUANTITY		DESCRIPTION OF PART	DRAWING NO. & ITEM NO.	PATTERN NO.	MATERIAL	MATERIAL SPEC. NO.	PROCESS SPEC. NO.	ITEM NO.
GR. 2	GR. 1							

PIPING CALCULATIONS.

1. THE TOTAL RESULTANT FORCE AND TOTAL RESULTANT MOMENT IMPOSED ON THE TURBINE AT ANY CONNECTION MUST NOT EXCEED THE FOLLOWING:

	FLANGE	A
$F = \frac{A-M}{3}$	INLET	3000
	EXHAUST	4660

F = RESULTANT FORCE, INCLUDING PRESSURE FORCES WHERE UNRESTRAINED EXPANSION JOINTS ARE USED AT THE CONNECTION, POUNDS.

M - RESULTANT MOMENT, POUND FEET

2. THE COMBINED RESULTANTS OF THE FORCES AND MOMENTS OF THE INLET AND EXHAUST CONNECTIONS, RESOLVED AT THE CENTERLINES OF THE EXHAUST CONNECTION MUST NOT EXCEED THE FOLLOWING TWO CONDITIONS

- a. THE RESULTANTS MUST NOT EXCEED: $F_c = \frac{2600 - M_c}{2}$

F_c = COMBINED RESULTANT OF INLET AND EXHAUST FORCES, POUNDS.

M_c = COMBINED RESULTANT OF INLET AND EXHAUST MOMENTS AND MOMENTS RESULTING FROM FORCES, POUND FEET.

- b. THE COMPONENTS OF THESE RESULTANTS SHALL NOT EXCEED:

F _x =	520 POUNDS	M _x =	2600 POUND FEET
F _y =	1300 POUNDS	M _y =	1300 POUND FEET
F _z =	1040 POUNDS	M _z =	1300 POUND FEET

x PARALLEL TO TURBINE SHAFT
y, VERTICAL
z, HORIZONTAL AND AT RIGHT ANGLES TO TURBINE SHAFT

TOLERANCE FOR DIMENSIONS
TO HUNDREDTHS OF AN INCH
1 - FINISHED SURFACE ±.02
2 - UNFINISHED SURFACE ±.05

REF.

REVISIONS			6 in. INLET 12 in. EXHAUST	LA-125377	
			WORTHINGTON TURBINE INTERNATIONAL, INC. A DIVISION OF TURBODYNE CORPORATION WELLSVILLE, NEW YORK 14805 U.S.A.		
			DRAWN: D.L.		DATE:
			TRACED:		SCALE:
			CHECKED: F.J.R.		FRAME:
			APPROVED: M.S. 6-9-70	FIRST S.O.:	

1
2

ROUGH 250
FINE 125

25
3
4

SMOOTH 63
GRIND 32
POLISH 15