

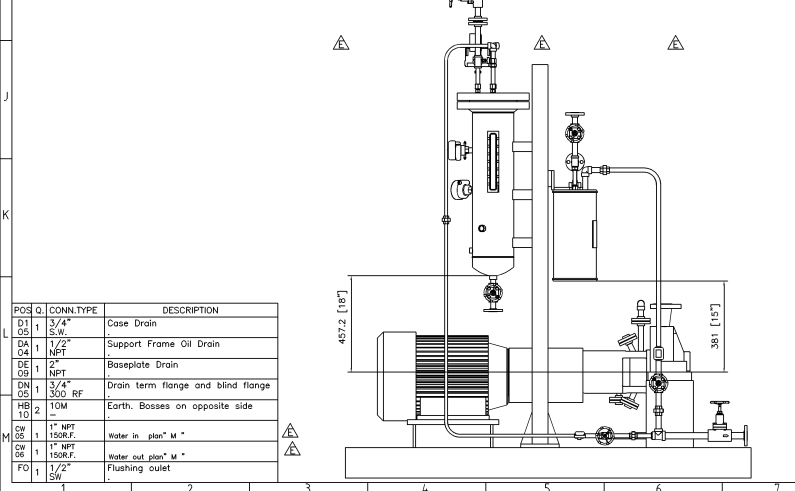
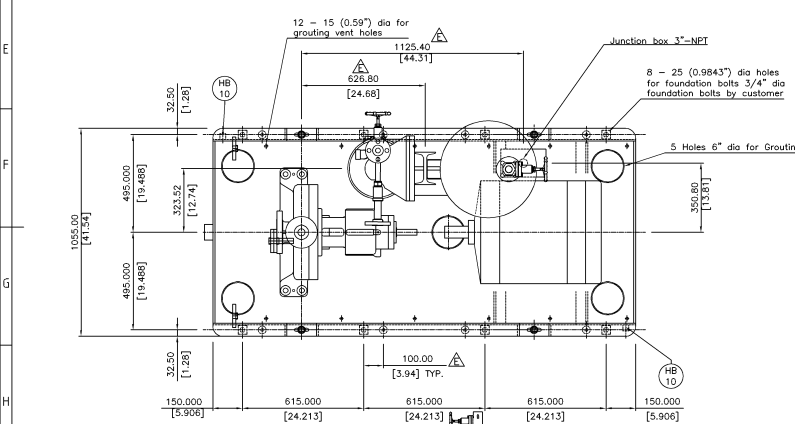
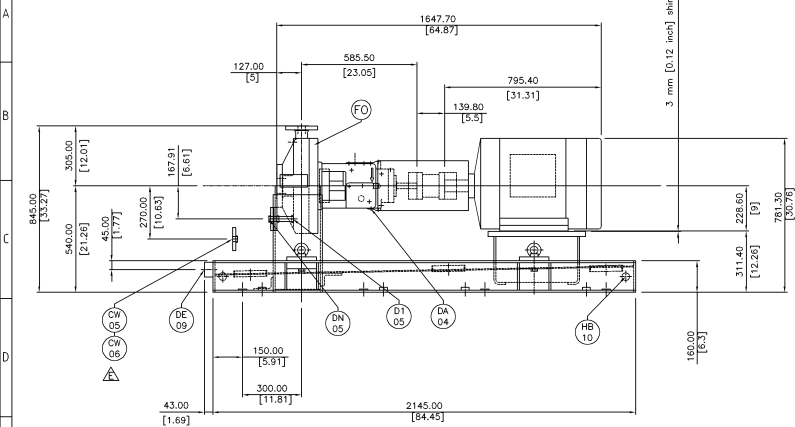
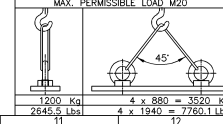
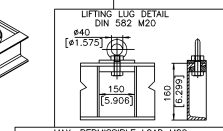
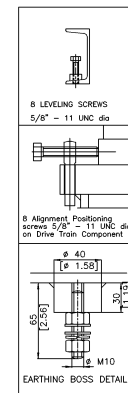


DRAWING NO. DWG035000	REV. E
--------------------------	-----------

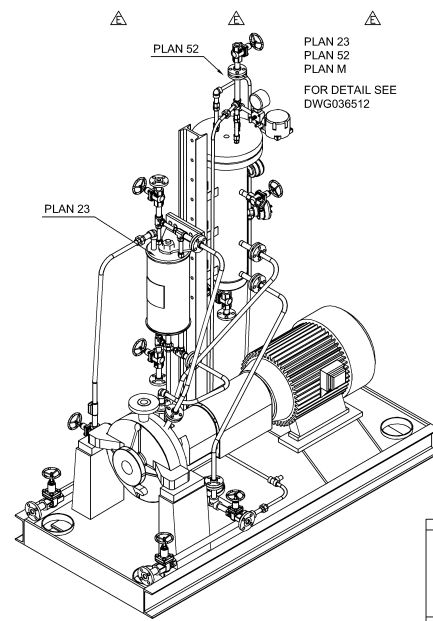

POS	Q	CONN. TYPE	DESCRIPTION
CW	05	1" 150RF.	Water in "plan" M "
CW	06	1" NPT 150RF.	Water out "plan" M "
FO	1	1/2" SW	Flushing outlet

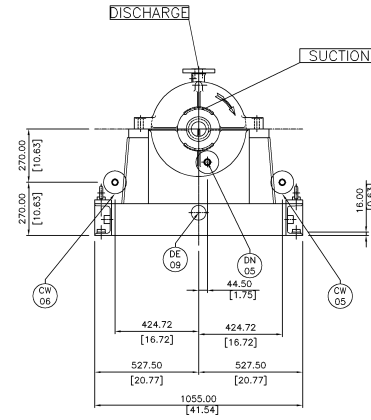

15HPXPM12A CENTRIFUGAL PUMP GENERAL ARRANGEMENT

SECTION



THIS PROPRIETARY AND/OR CONFIDENTIAL MATERIAL IS THE PROPERTY OF FLOWSERVE CORP. AND IS FURNISHED ONLY FOR THE PURPOSE INDICATED. FLOWSERVE RESERVES ALL RIGHTS IN THE MATERIAL, AND DOES NOT CONVEY PERMISSION TO MANUFACTURE OR USE THE CONFIDENTIAL OR PROPRIETARY INFORMATION CONTAINED HEREIN.