
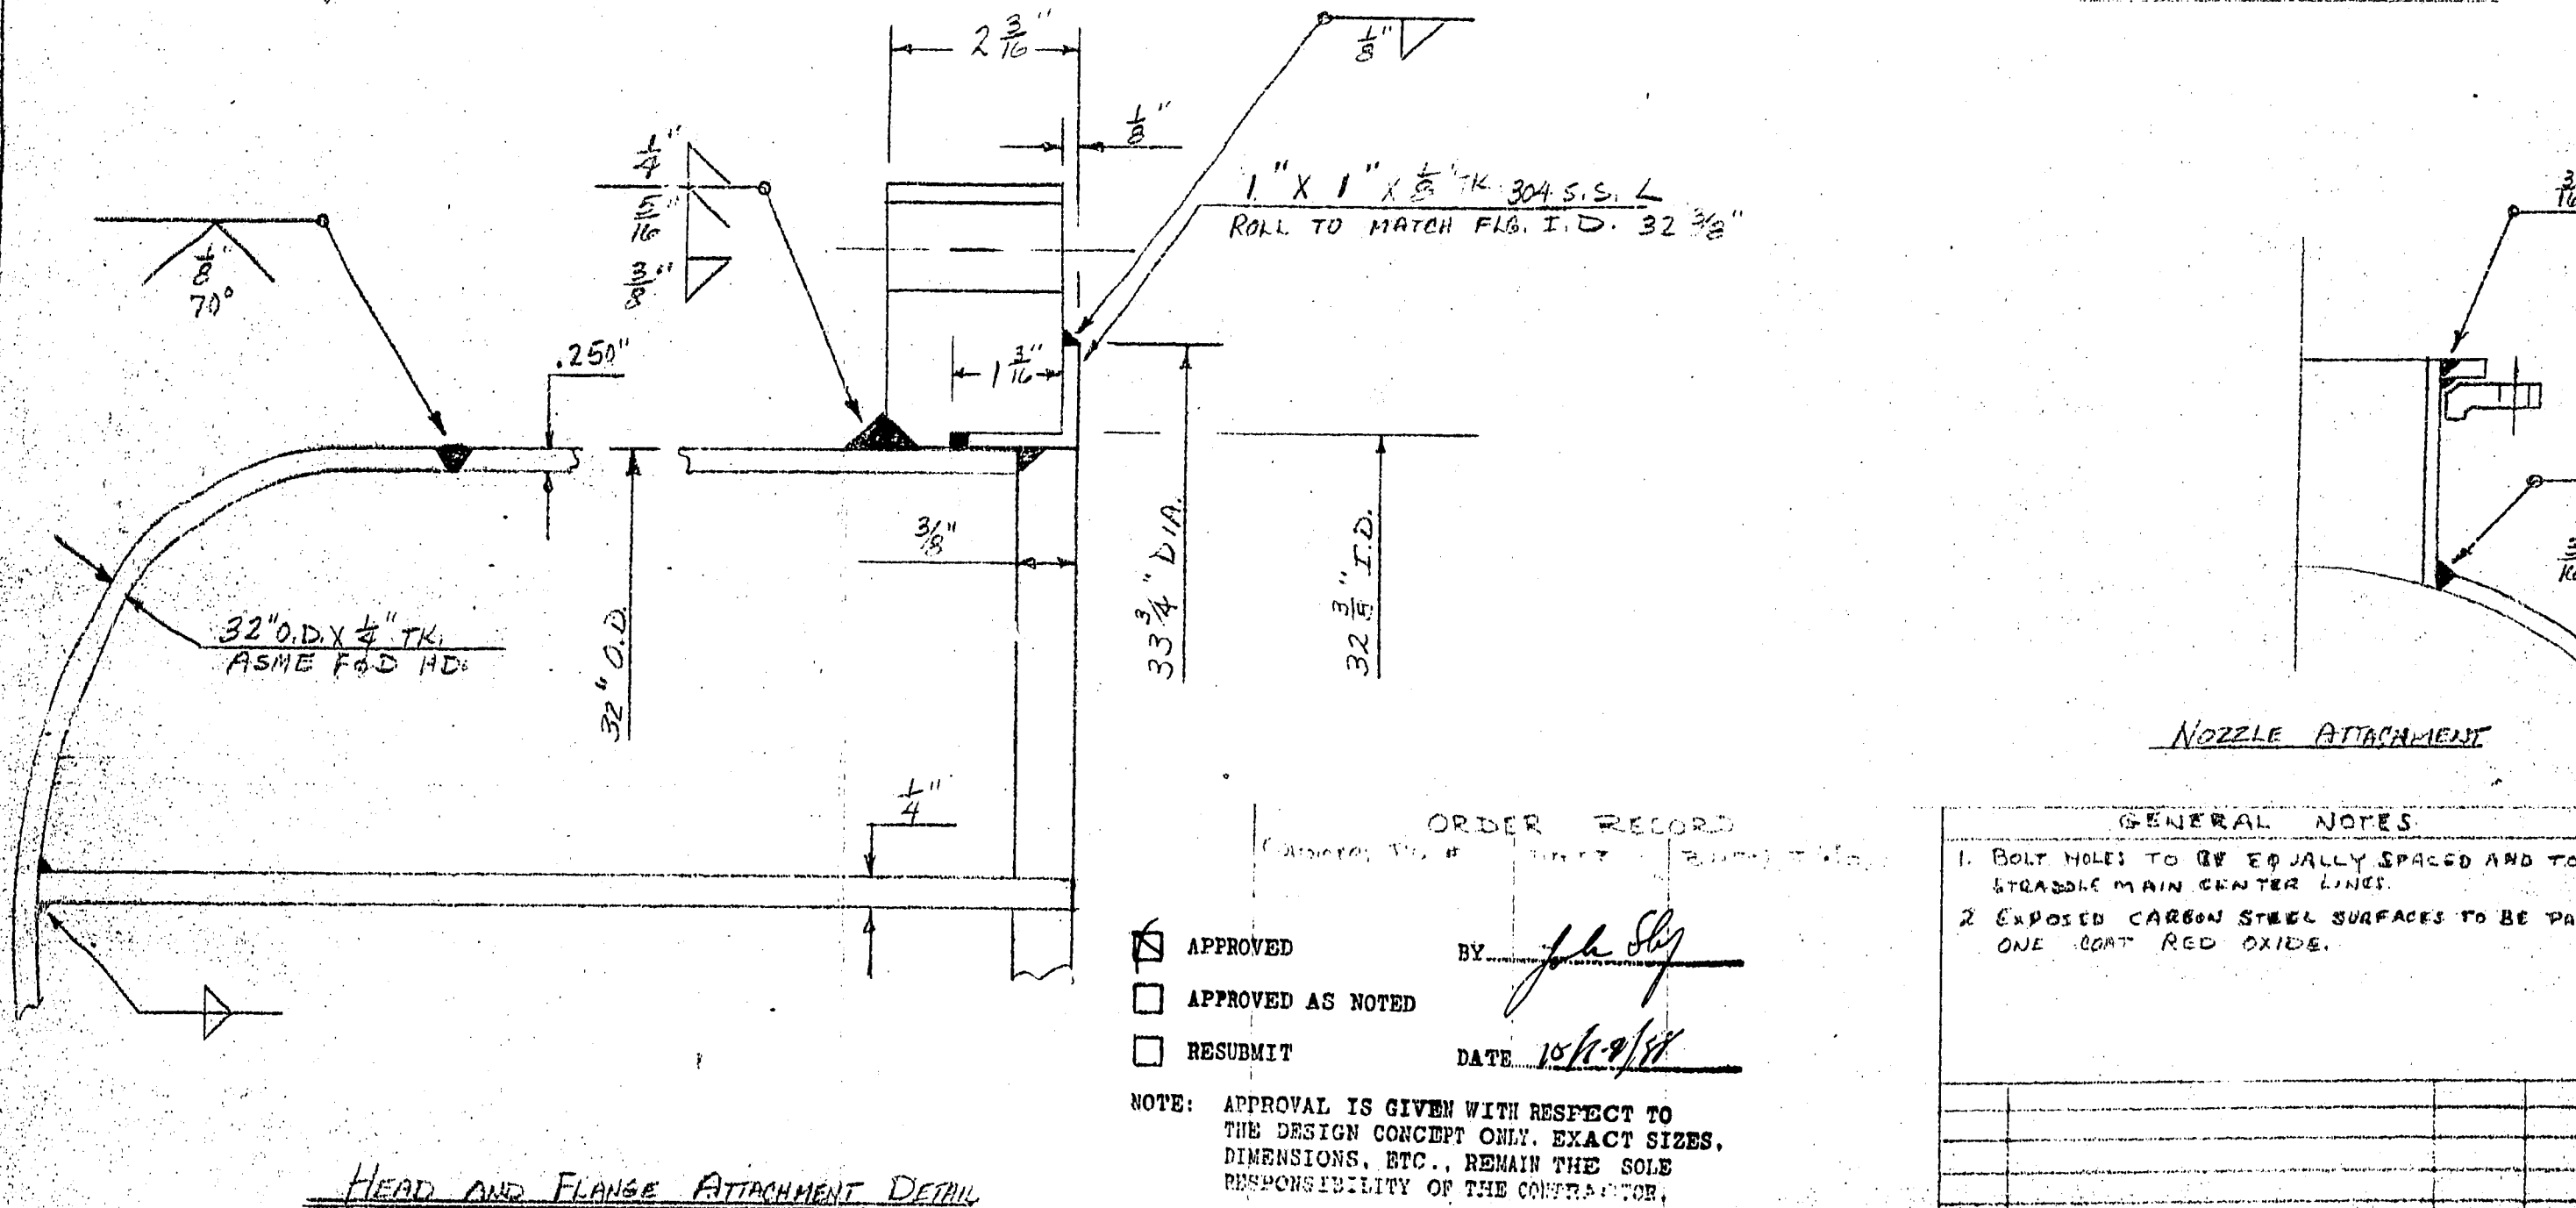


CSF-00003

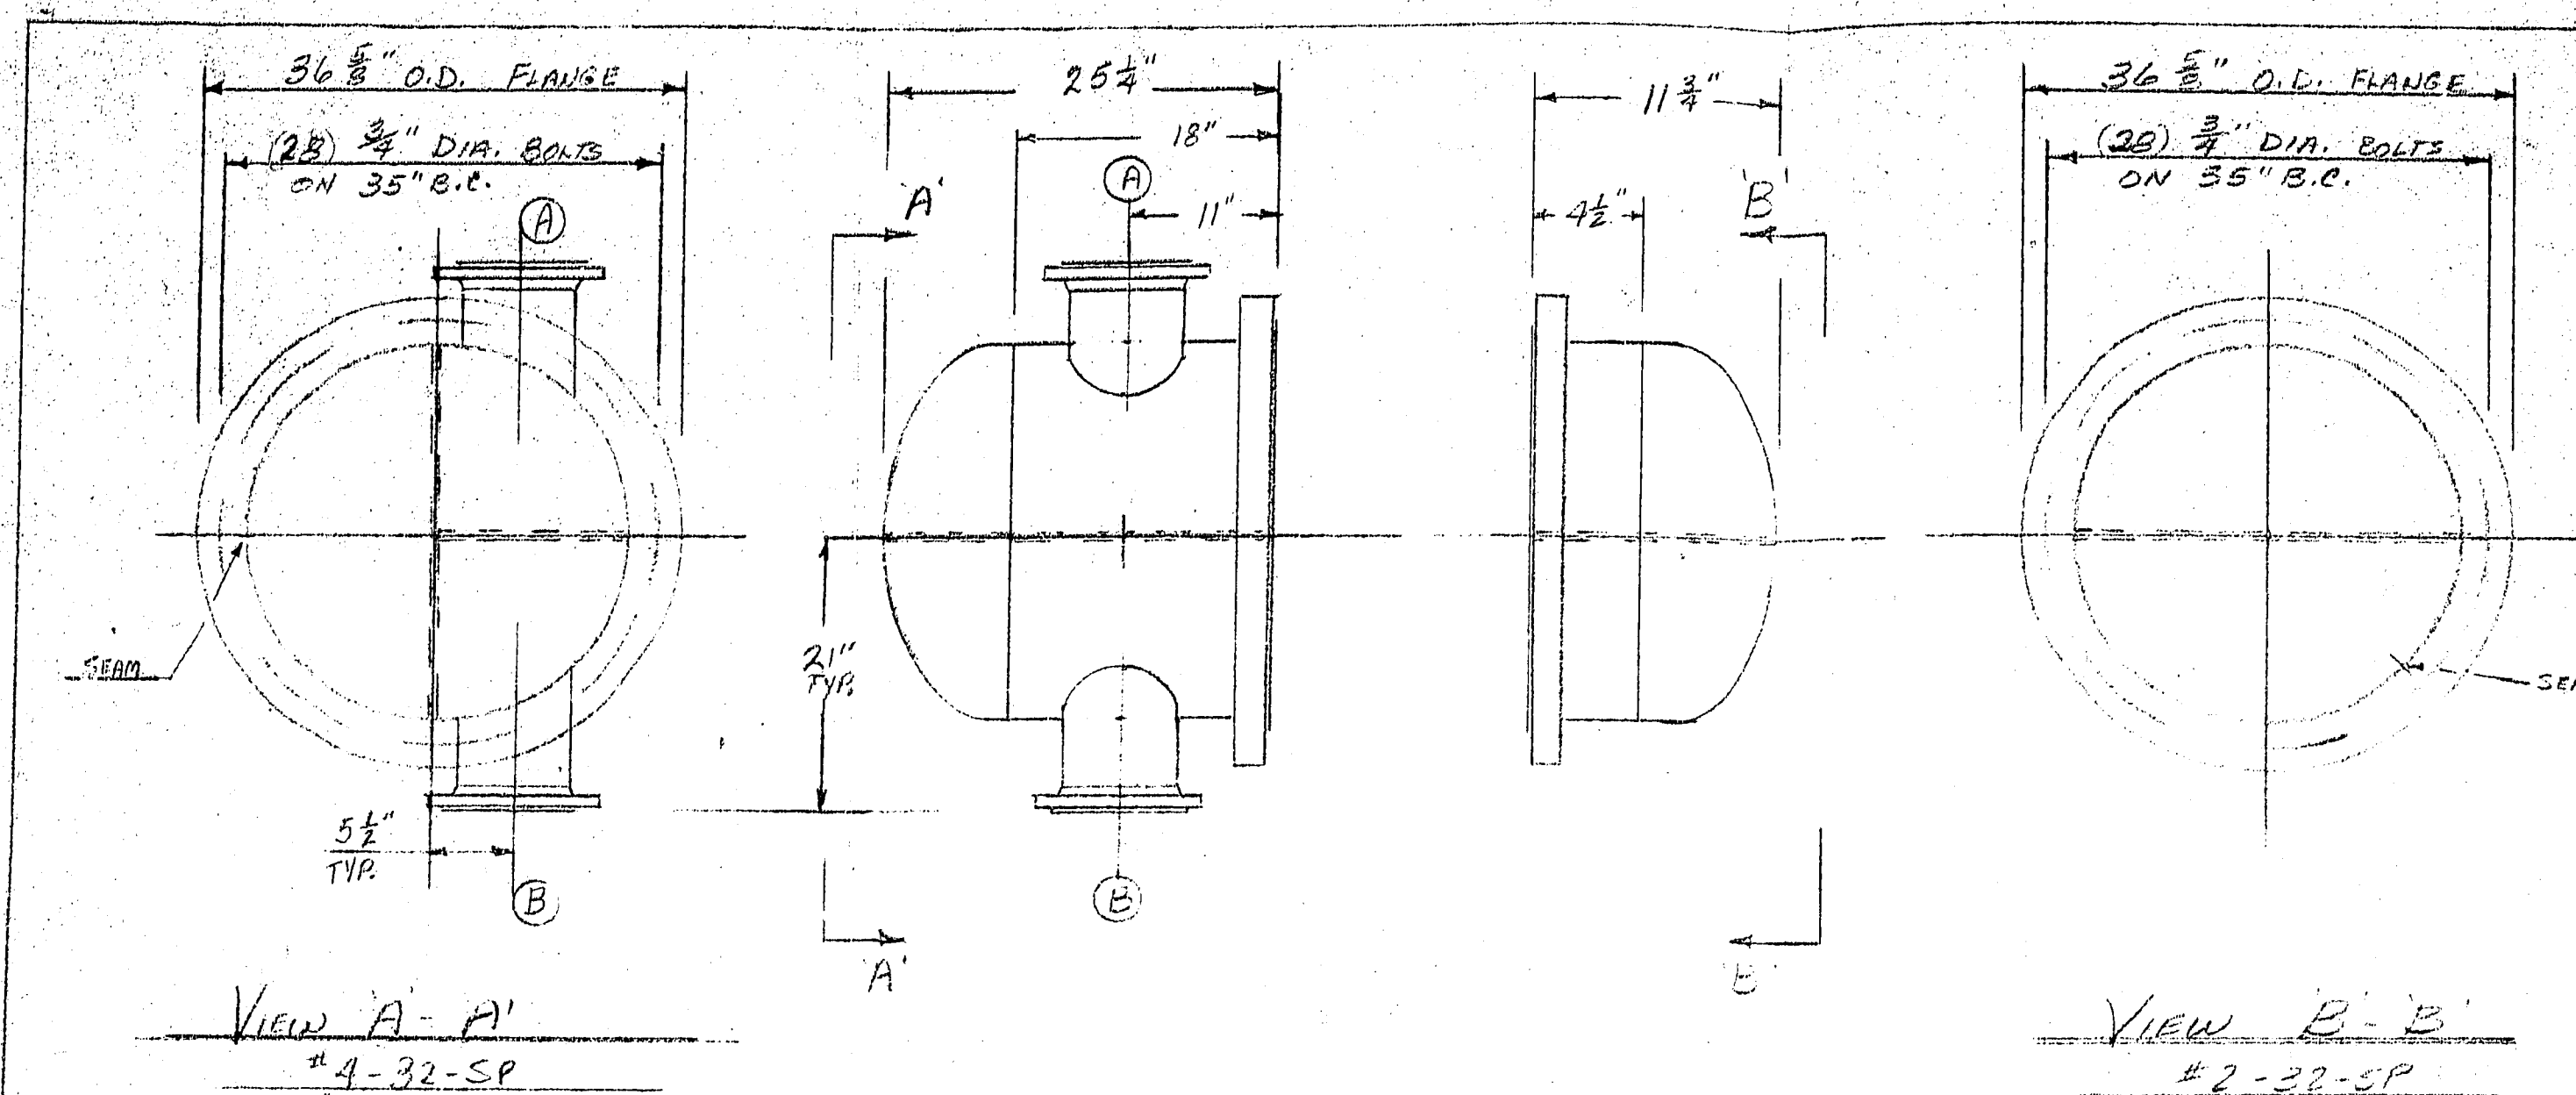

DESIGN DATA		
	SHELL SIDE	TUBE SIDE
DESIGN PRESSURE		100 PSIG
HYDRO. TEST PRESSURE		150 PSIG
DESIGN TEMPERATURE		150°F
CORROSION ALLOWANCE		"
RADIOGRAPH		"

THIS EXCHANGER SHALL BE FABRICATED IN ACCORDANCE WITH
ASME CODE SECT. VIII, DIV. 1, 1986 EDITION, PARA UW-12C
1987 ADDENDA.

ASME PART STAMP

MATERIALS		
	SHELL SIDE	Tube Side
CYLINDER		SA-240-30
COVER		SA-240-30
CYLINDER FLANGES		SA-516-70
NOZZLES		SA-312-30A
NOZZLE FLANGES		SA-105
GASKETS		
LAP JT. & CLADDING		SA-240-30

TUAK SHEETS

TUBES O.D. X. B.W. 6

BAFFLE







[illegible]

TYPE

UNIT CONTAINS APPROX. SQFT. OF TUBE SURFACE, ARRANGED
ON PITCH. TUBE PAGES: TUBES PER PAGE:

DRILL TUBE HOLES DIA. 4/8" TO DIA.

DRILL BASKET HOLES DIA.

GASKETS - O.D.I.A. X I.D.I.A. X TK.

BASKETS, SUPPORTS - () O.D.I.A. X TK. ON "PITCH"

CUT OR C/L.

ESTIMATED WEIGHT

EMPTY - 800#	BUNDLES -	FLOODED -
--------------	-----------	-----------

CUSTOMER - FREEMAN, LAURIE P.O.# 2 4124278

U.S. No. #1 33 50 #2 33 50

UNIT NO - 4-32-SP + 2-32-SP

[illegible]

DRAWN BY	CHECKED BY	APPV BY	SCALE	DATE
----------	------------	---------	-------	------

OWK			NTS 10/17/88
-----	--	--	--------------

BUXTON MFG. CO

GENERAL No. 10 OVER M. I. FILE No. 10

ORDER NO. DOVER N.J. EST. NO.

8910-0 (CSE-3)

0810-8 (CSF-3)

Form No. C-136E

DRAWING NO - C-4365