


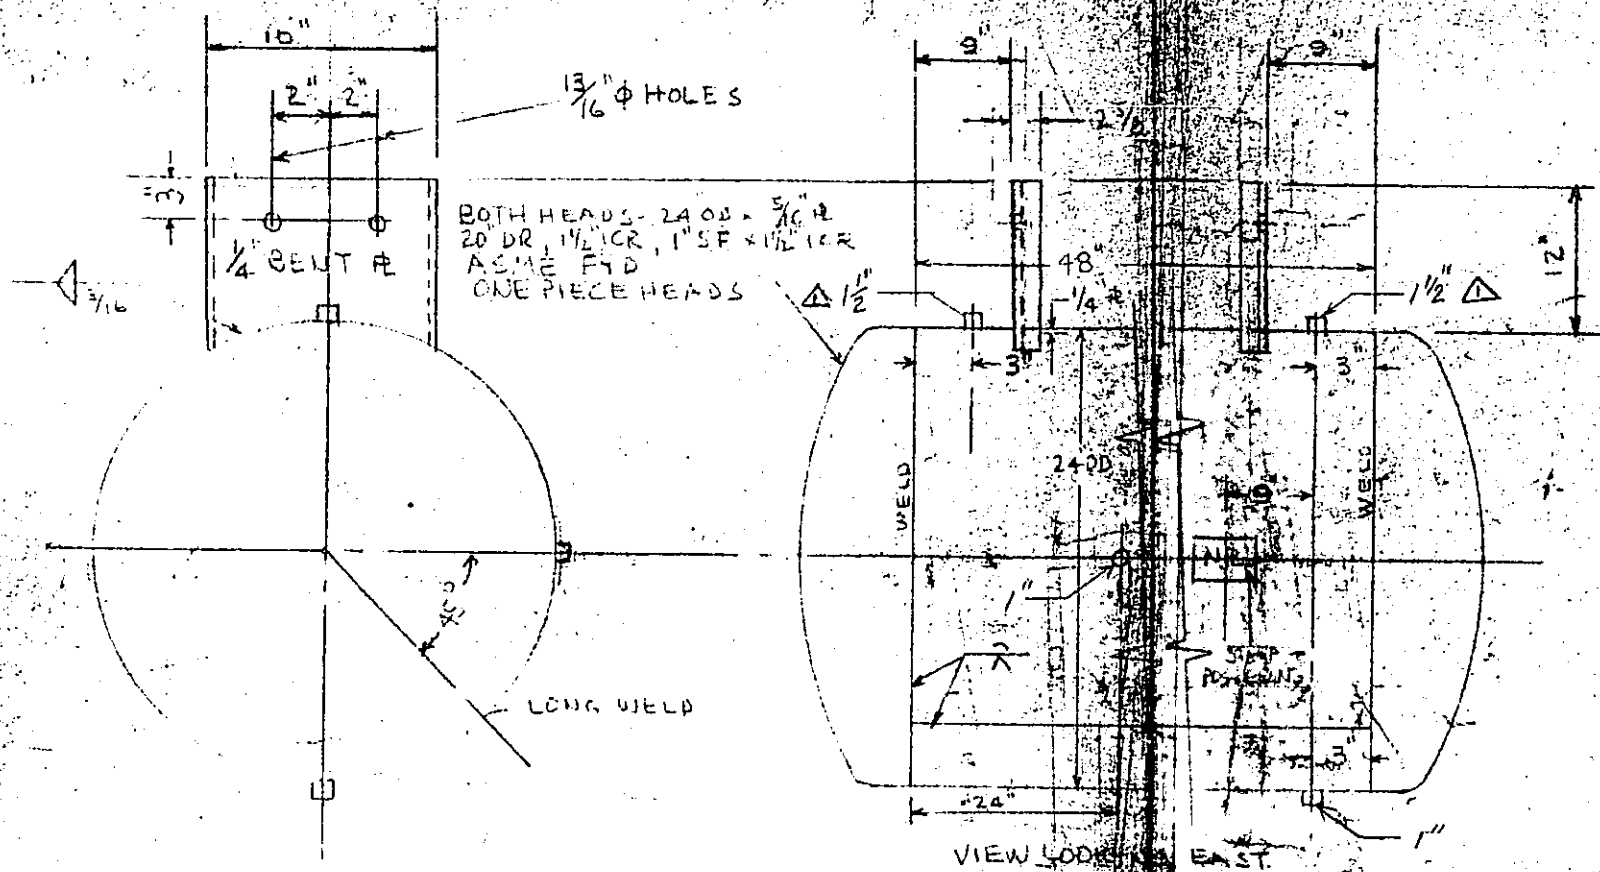

HOFFMANN CAZOCHE INC. P.O. #28067LE
 PROJECT 66
 ARTHUR G. MCKEE - CONTRACTOR
 CONT. 3126 - P.O. MCK-3126-22

POS. No. E& No.
 B-3-6995 XTB-376
 B-3-6996 XTB-377
 B-3-6997 XTB-378

MCKEE DWG. 6995-1
 6996-1
 6997-1

3 UNITS REQ'D

BUTT WELDED THRUOUT

MATERIAL A240-304

ASME CODE STAMP: 200 PSIG, 75°: HYDRO-300 PSI
 MAX ALLOW WORK PRES. 236 PSK

FINISH: CLEAN PER SSPC-SP2, CLOSE OPENING
 REMOVE SPATTER

WTEMP. -400°: FLOWED - 1300°

B3-6995

ENIVEL ENGINEERING CORPORATION
 CLIFTON NEW JERSEY

COMPRESSED AIR HEAD TANKS

XTB-376

ROSEN 70274

SCALE	BY DATE	APP'D DATE	ORDER	DRAWING NO.
1/2"	EM 4/13/70	A 4/14/70	70999	70195-01

APPROVED
 Checked for General Design & Controlling Dimensions Only. This Approval does not relieve the Vendor of Responsibility for Correctness of Design, Details and Dimensions.
 VENDOR TO MAKE CORRECTIONS AS NOTED AND ISSUE PRINTS FOR OUR (Distribution) (Further Approval)
 (HOLD) (PROCEED WITH) FABRICATION
 ARTHUR G. MCKEE & CO. CLEVELAND OFFICE
 By *V.E. Jorgensen* Date 6-29-71

GM

8/13/71

△ TOP INLET & OUTLET CONNECTIONS
 CHANGED FROM 1" TO 1/2" COUPLING
 10-80 RICK LINE