

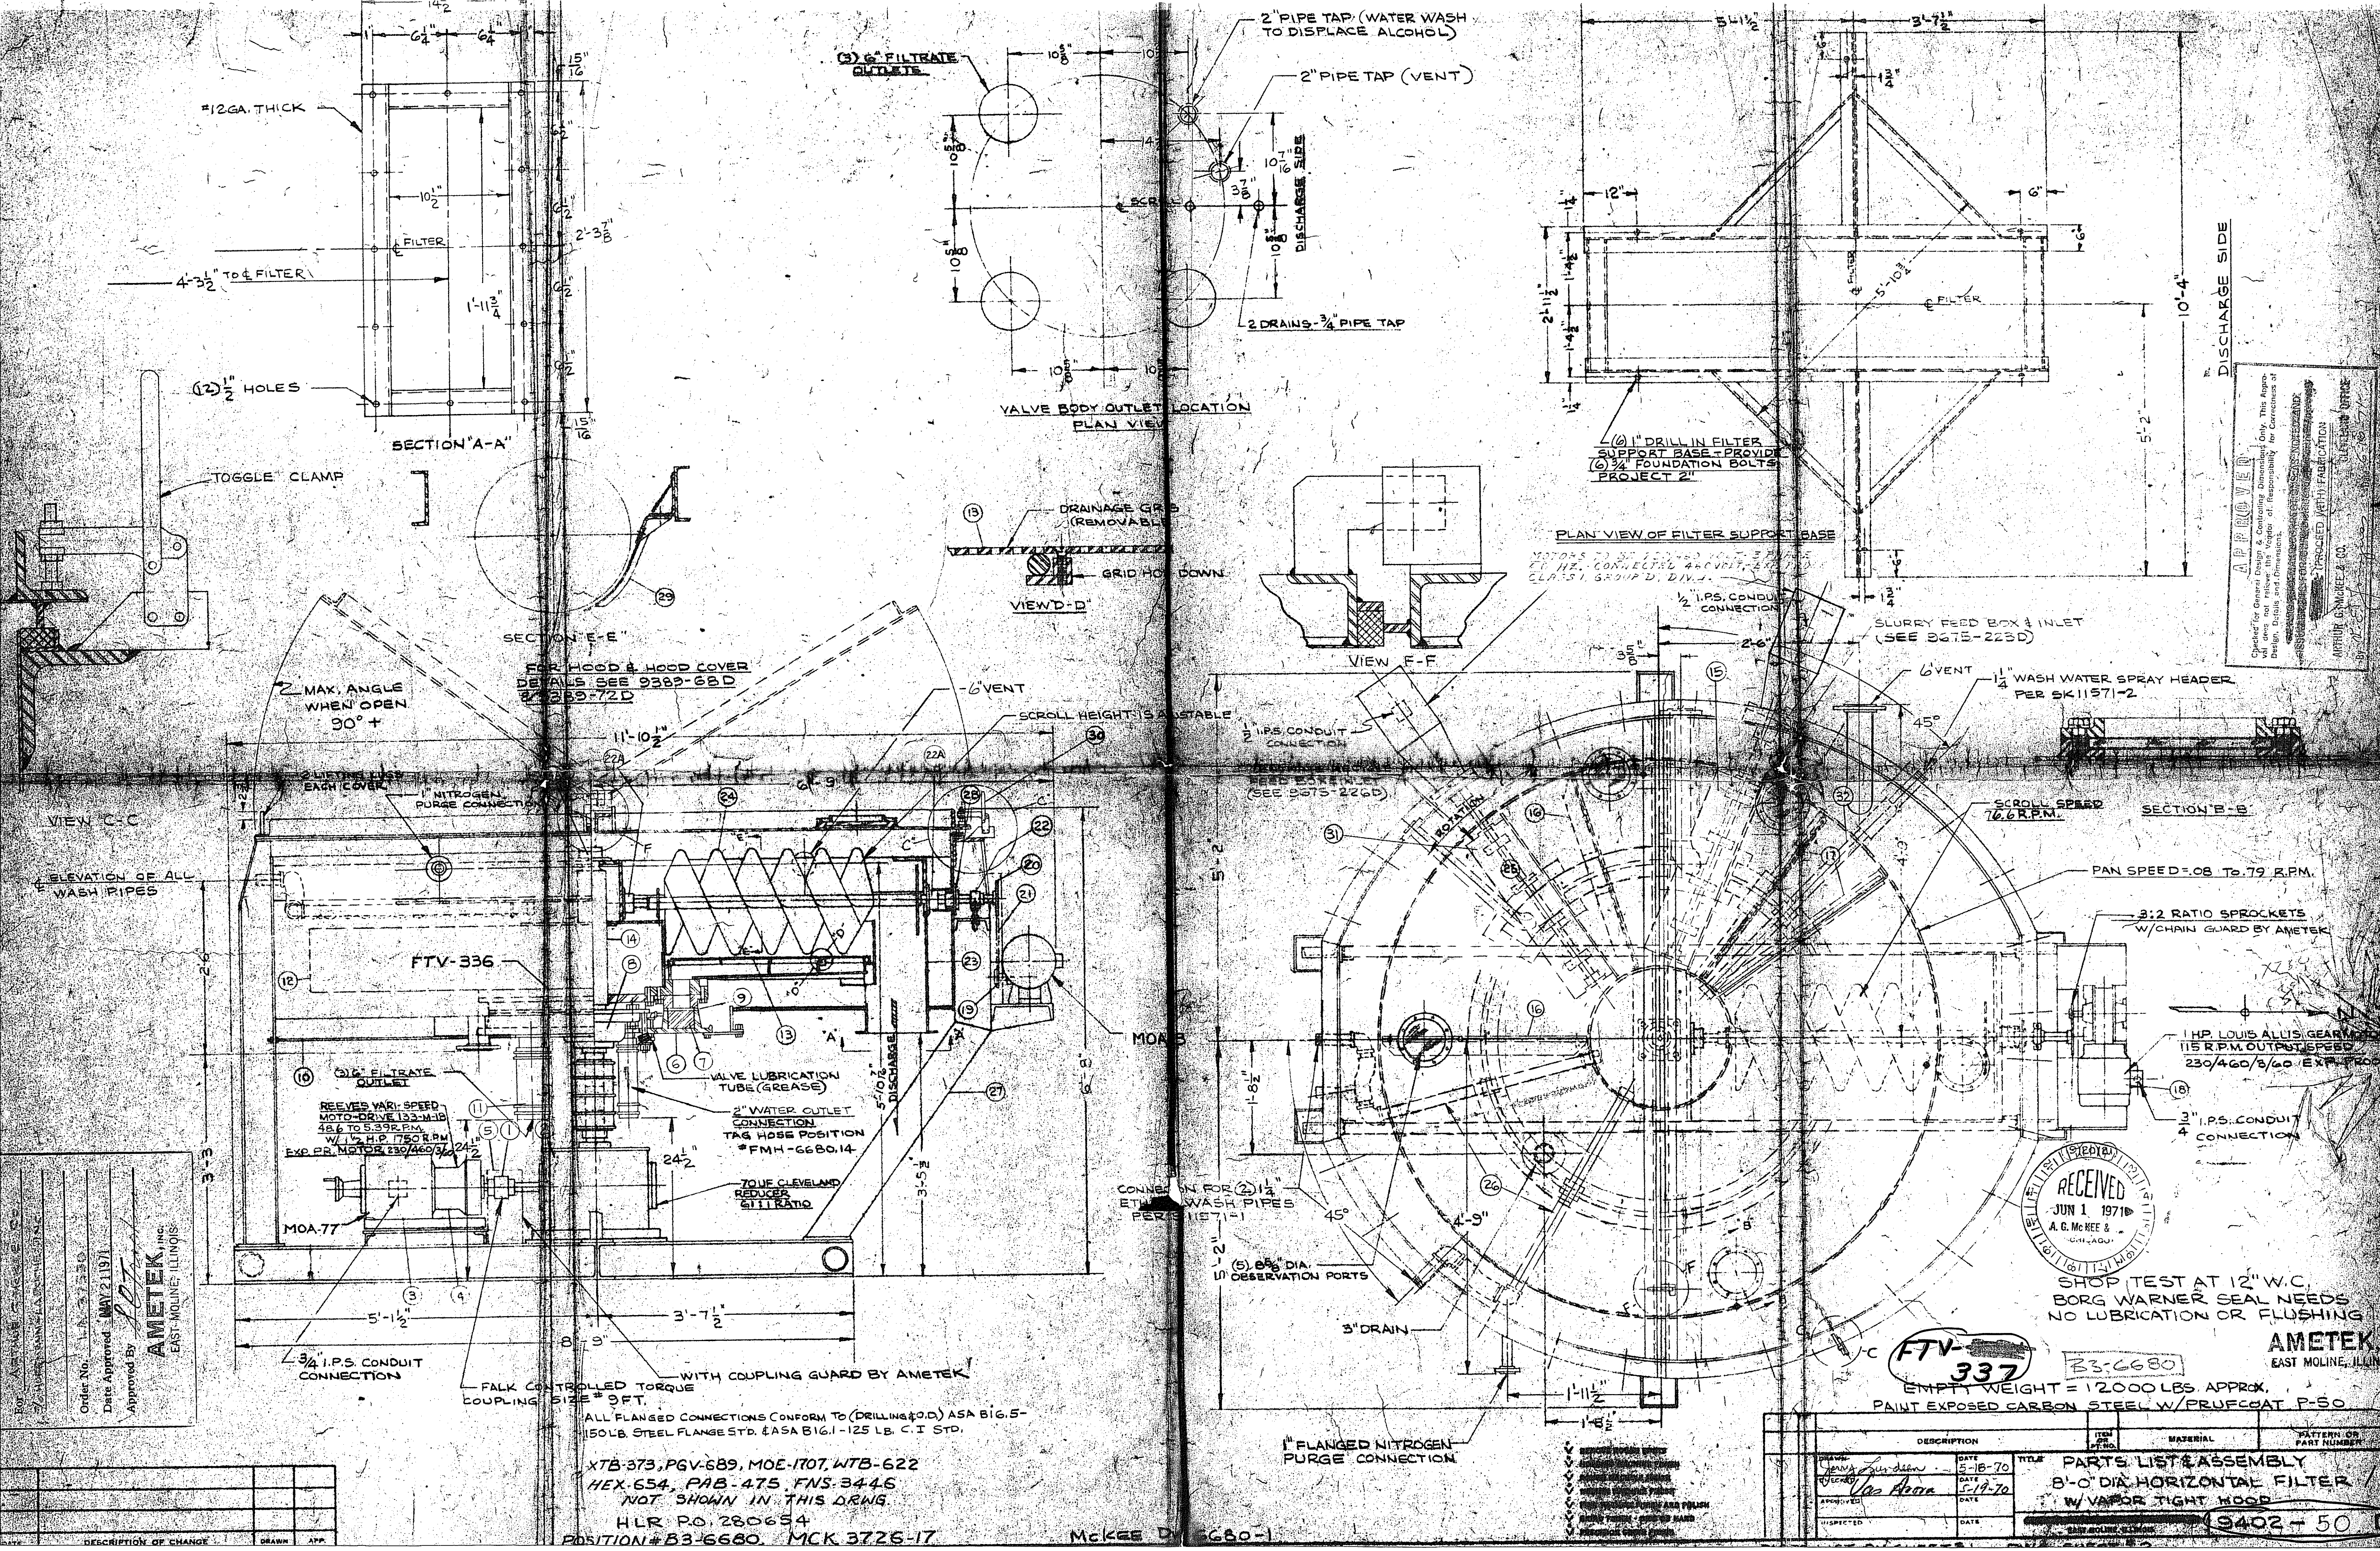
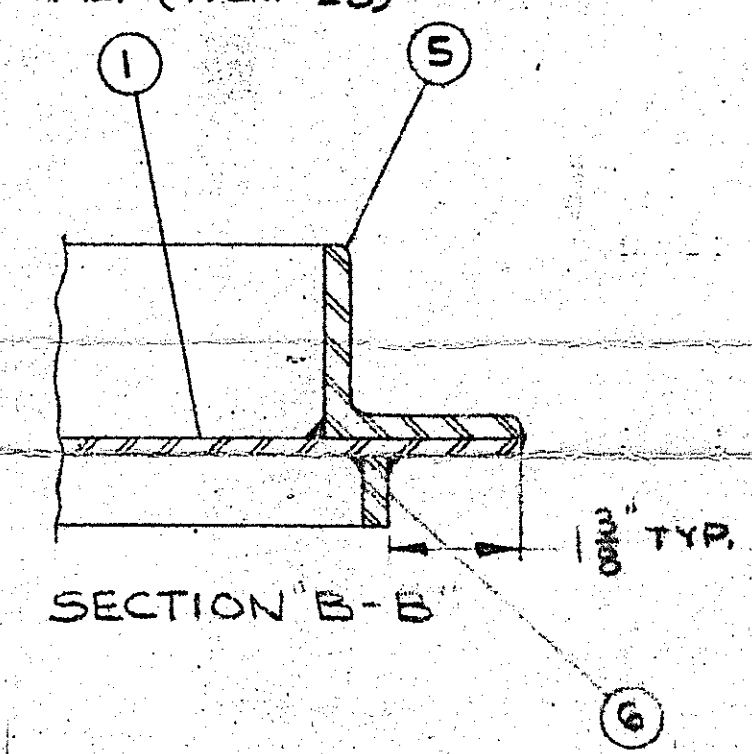
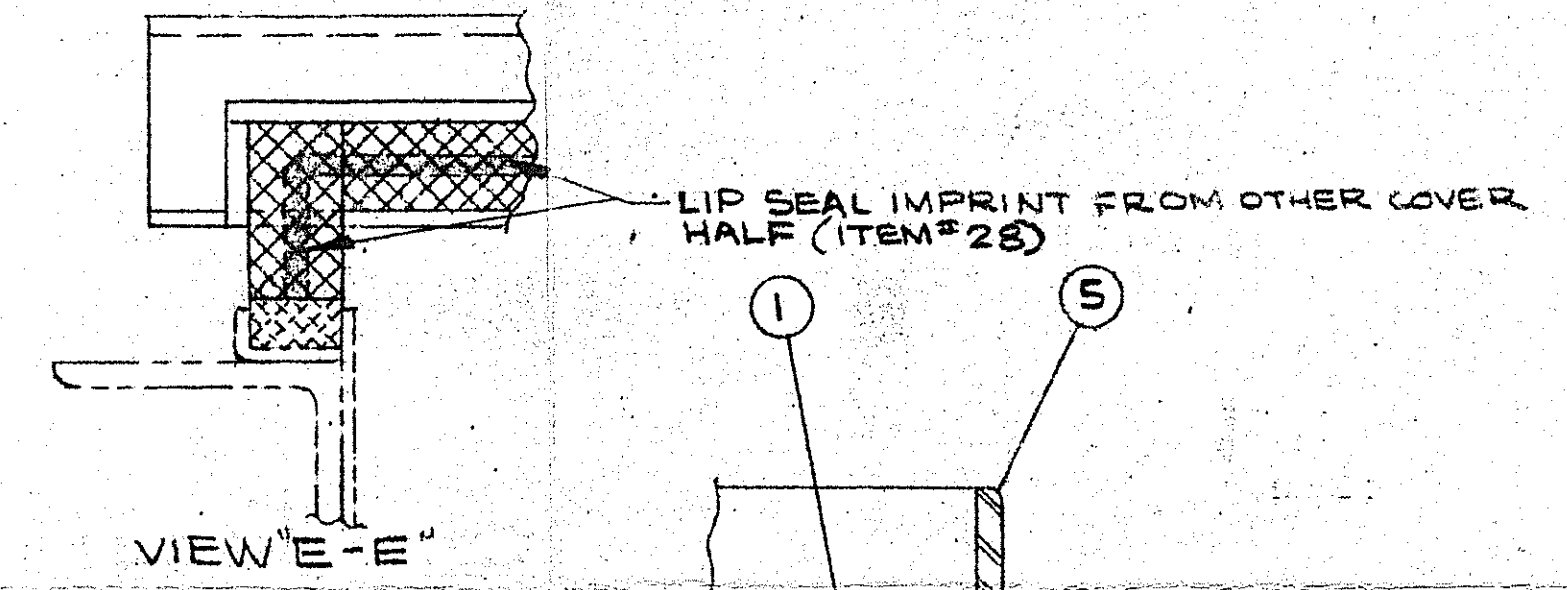


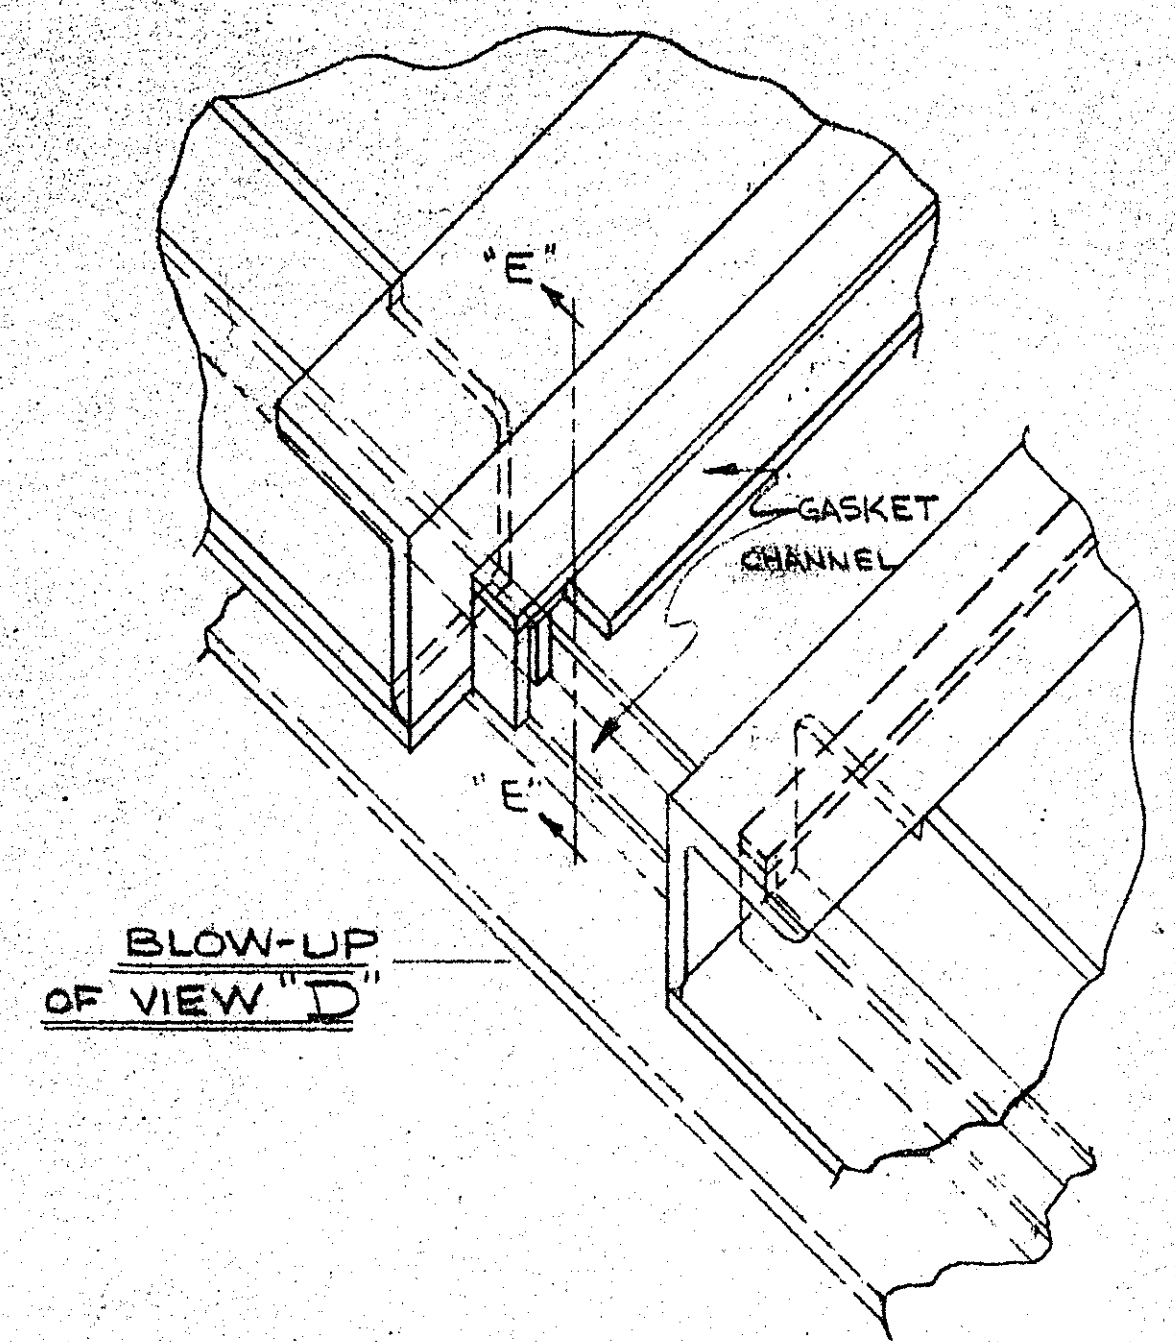


UNLESS OTHERWISE SPECIFIED FRACTIONAL DIMENSIONS ARE IN INCHES, DECIMAL DIMENSIONS TO .005

APPROVED FOR CONSTRUCTION
For HOFFMAN-LA ROCHE, INC.
c/o ARTHUR G. MCKEE & CO.
Order No. LA-37530
Date Approved 3/11/71
Approved By [Signature]
ARTHUR G. MCKEE & CO., INC.
EAST MOLINE, ILLINOIS

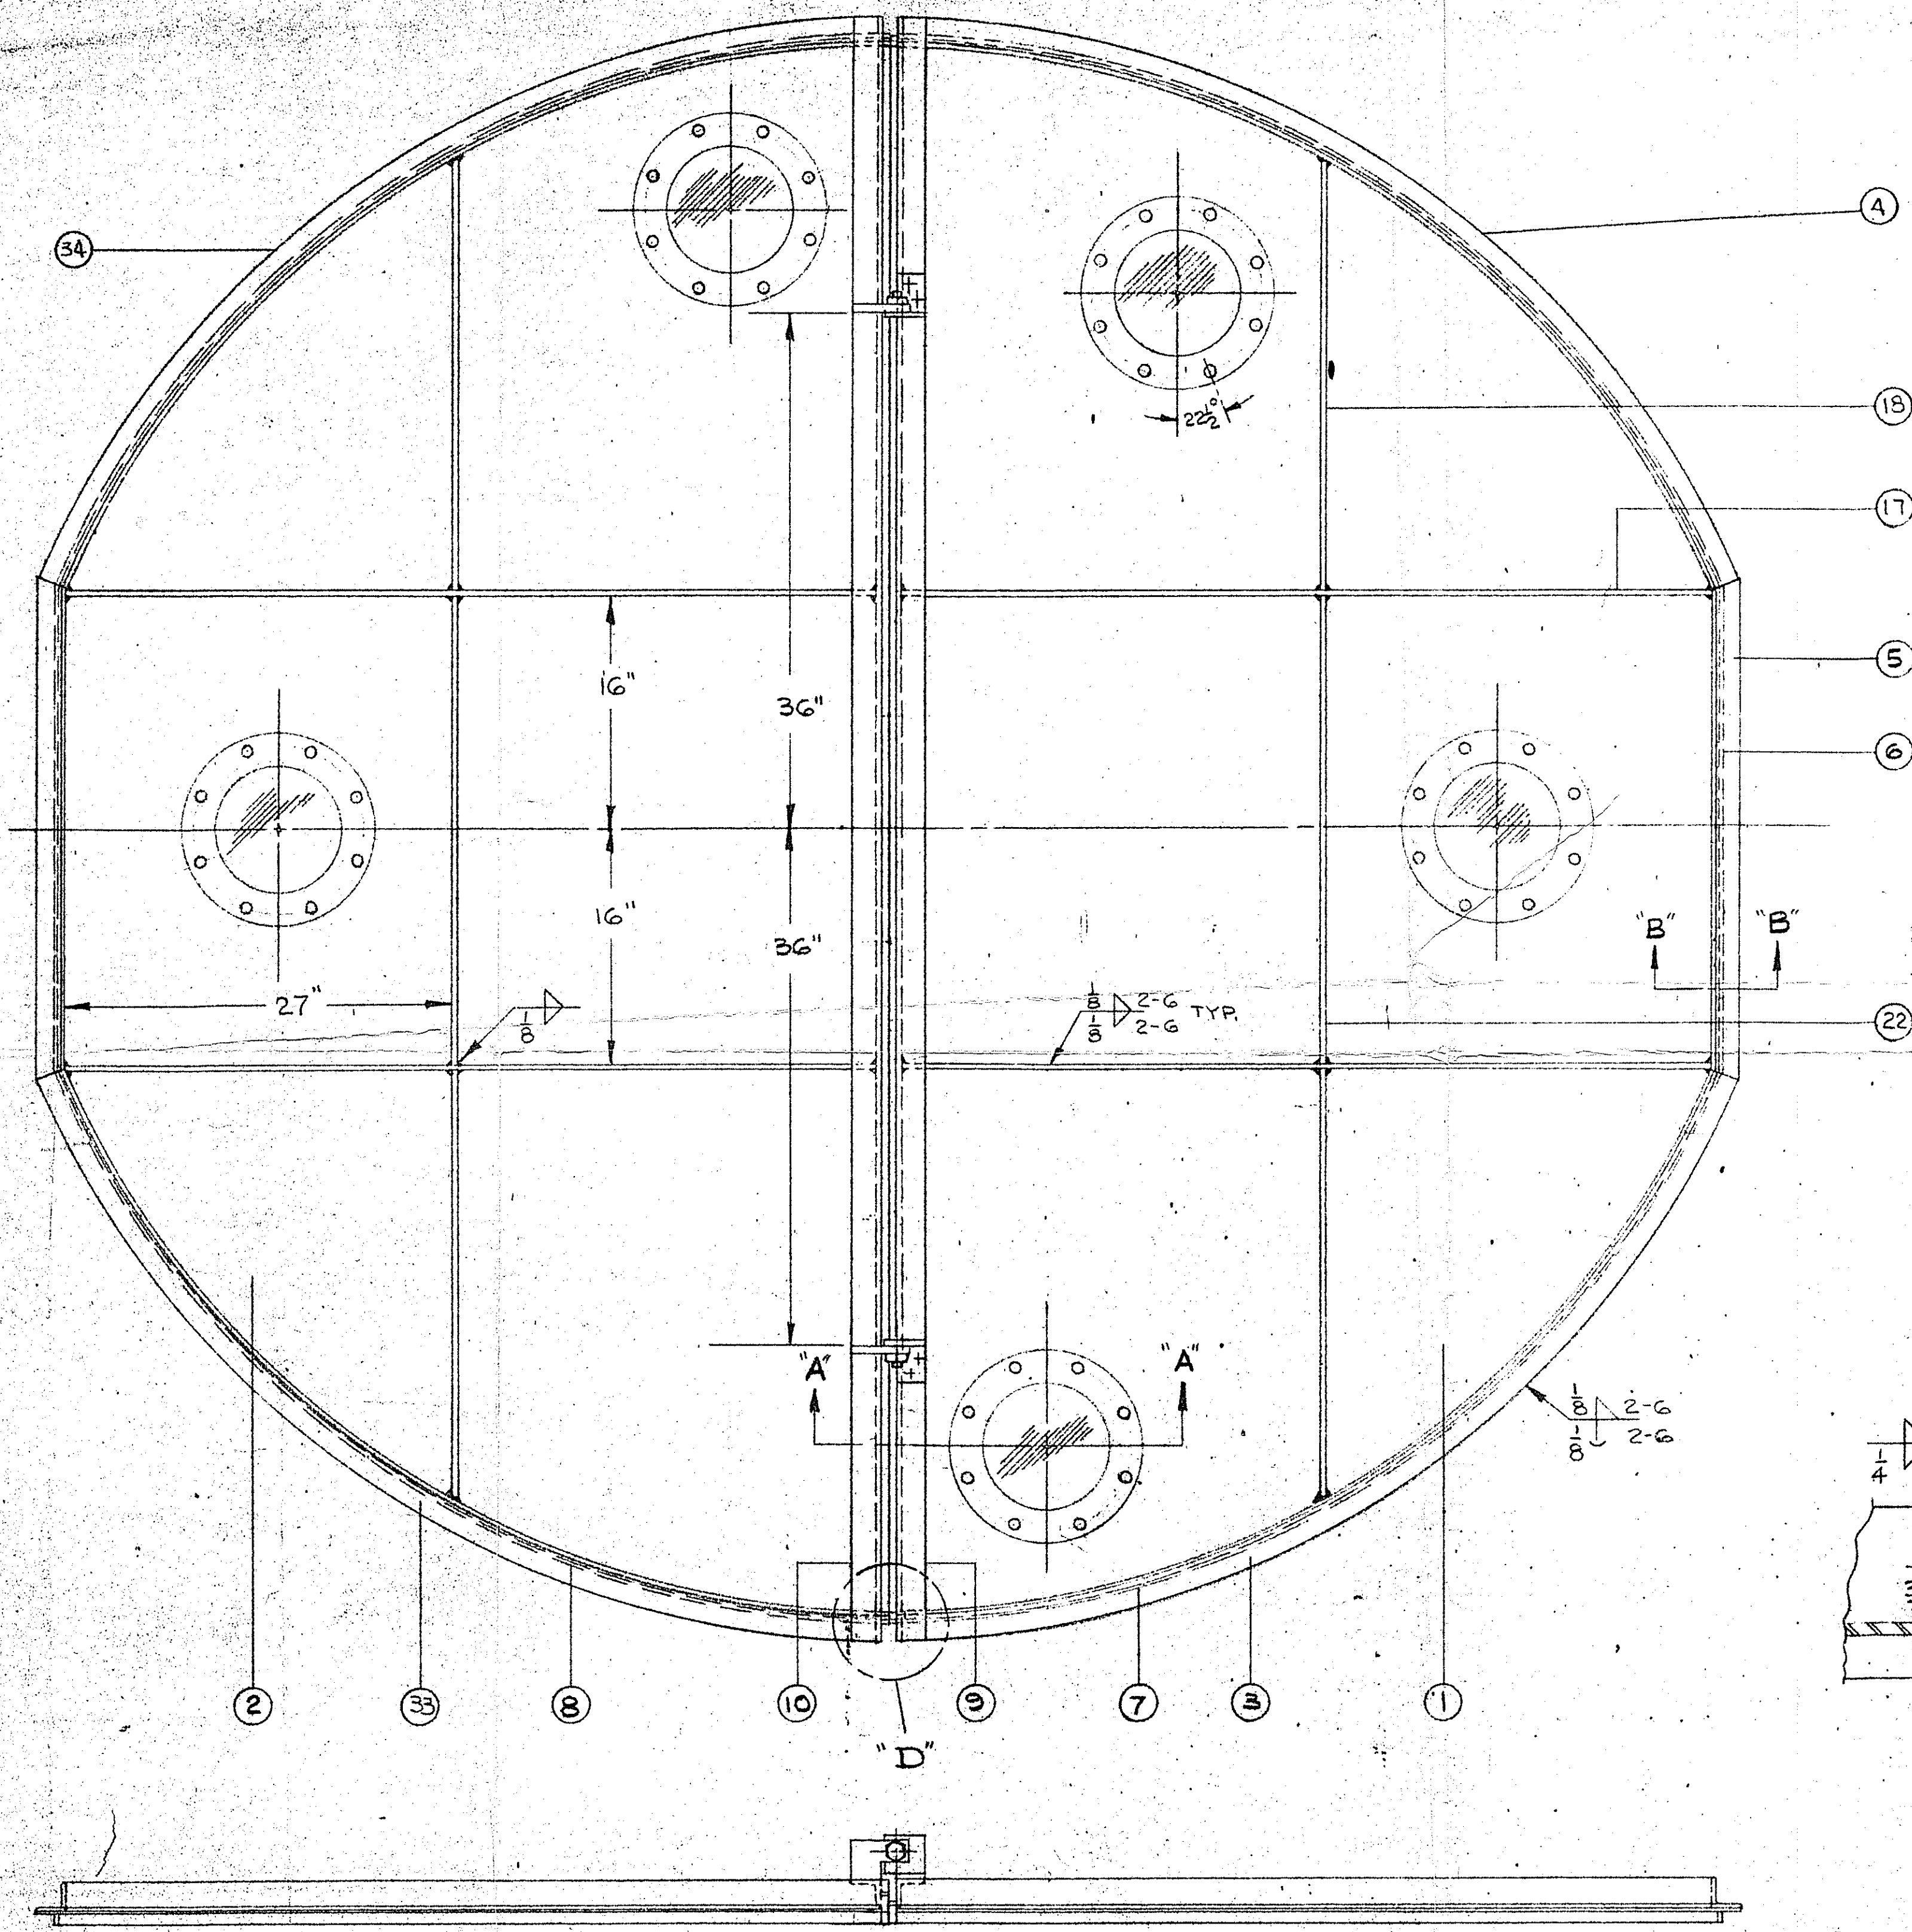

PRINT MADE
APR 19 1971
ARTHUR G. MCKEE & CO.

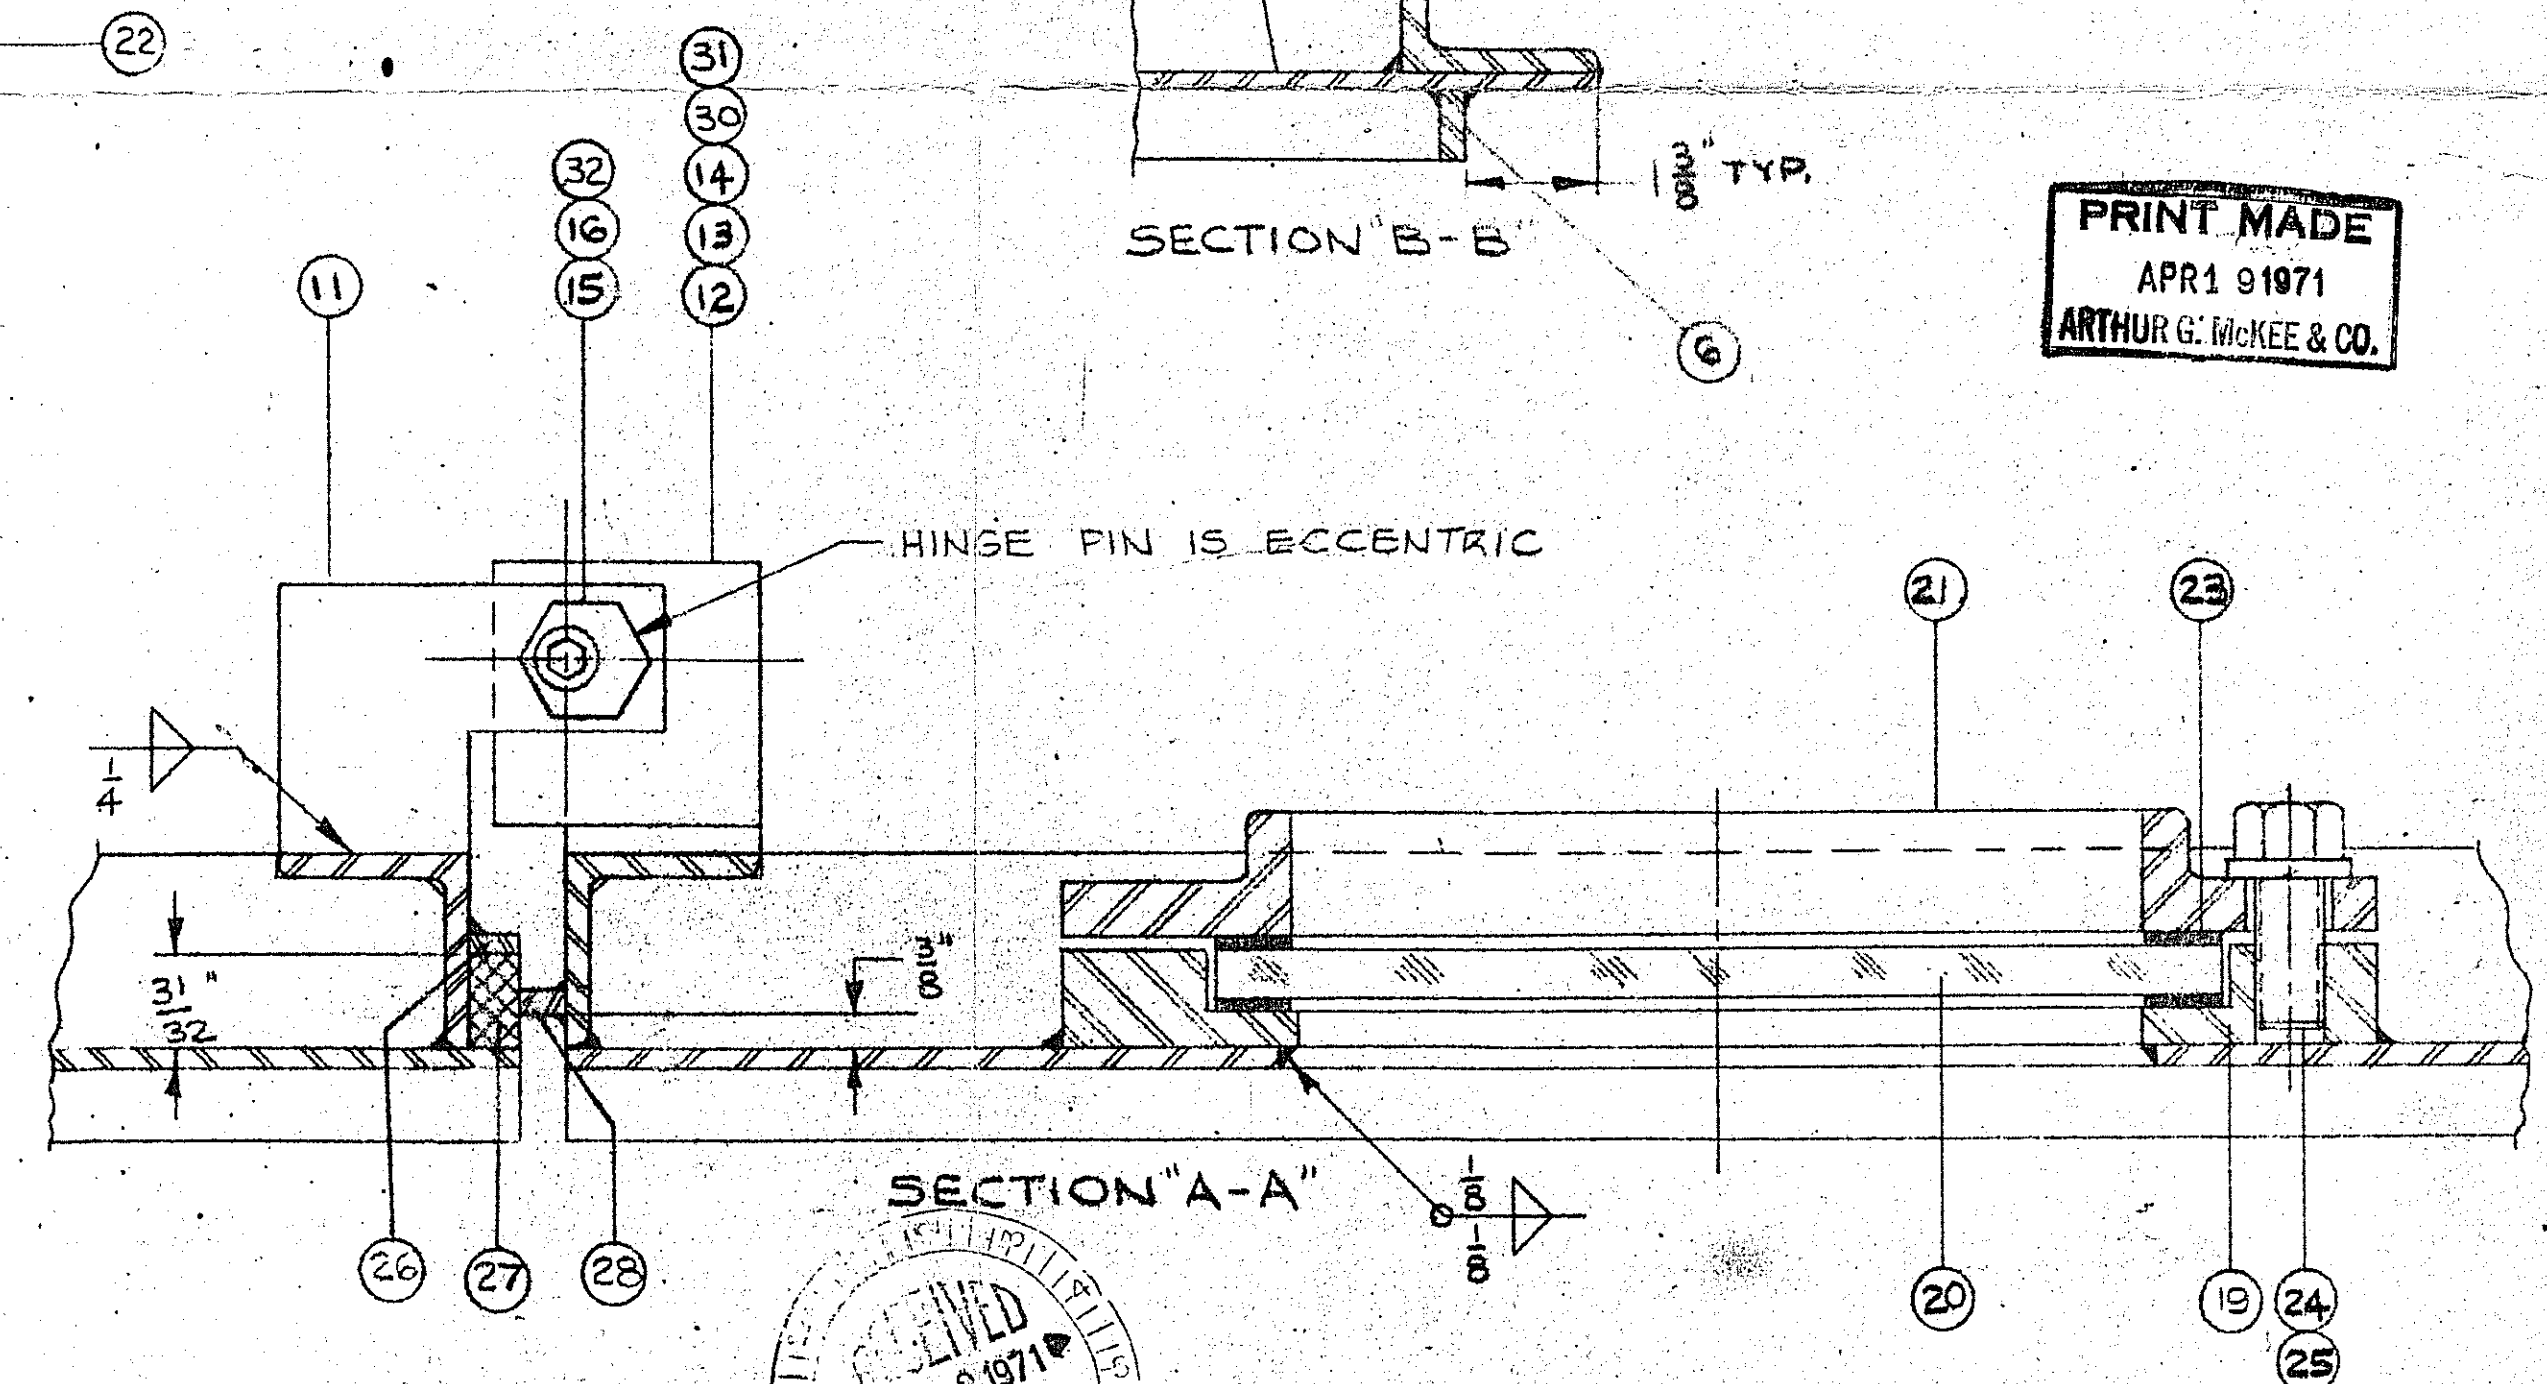

RECEIVED
MAR 22 1971
A. G. MCKEE & CO.
CHICAGO

HOFFMAN LA ROCHE PROJECT 66
BELVIDERE, N.J.
MCKEE DWG. 6680-3

RECORD PRINT
PROJECT 66

B3 6680

HLR P.O. 280654 EQUIP. CODE NO. FT V-337

POSITION # B3-6680 MCK-3726-17

APPROVED
Checked for General Design & Controlling Dimensions Only. This Approval does not relieve the Vendor of Responsibility for Correctness of Design, Details and Dimensions.
APPROVED FOR CONSTRUCTION
APPROVED (PROCEED WITH FABRICATION)
ARTHUR G. MCKEE & CO. CLEVELAND OFFICE
By [Signature] Date 4-16-71

AMETEK

DESCRIPTION		ITEM NO.	MATERIAL	PATTERN OR PART NUMBER
DRAWN	DATE	TITLE	TOP COVER HOOD ASSEMBLY 8" FILTER AMETEK, INC. EAST MOLINE, ILLINOIS	
CHECKED	DATE			
APPROVED	DATE			
INSPECTED	DATE			

K354