

01/22973


		JOB NO. 613144 ITEM NO. 21-MP-107A/B	
CENTRIFUGAL PUMP (API 610-8TH) DATA SHEET U.S. CUSTOMARY UNITS		PURCHASE ORDER NO. _____ SPECIFICATION NO. A121-21-MP-107A/B REVISION NO. 0 DATE 3/1/2004 PAGE 1 OF 5 BY gpm	
1 APPLICABLE TO: ☐ PROPOSALS ☐ PURCHASE ☒ AS BUILT ☐ REFURBISH AND REUSE			
2 FOR Chevron / Texaco		UNIT Ethanol Drier	
3 SITE Refineria Panama		SERVICE Dry ETOH Loading Pumps	
4 NO. REQ 2 PUMP SIZE 15 x 20 x 29		TYPE Centrifugal NO. STAGES ONE	
5 MANUFACTURER SULZER		MODEL HSA SERIAL NO. _____	
6 NOTES: INFORMATION BELOW TO BE COMPLETED: ☐ BY PURCHASER ☐ BY MANUFACTURER ☒ BY MANUFACTURER OR PURCHASER			
7 ☒ GENERAL (3.1.1)			
8 PUMPS TO OPERATE IN (PARALLEL)		NO. MOTOR DRIVEN 2 NO. TURBINE DRIVEN 0	
9 (SERIES) WITH NONE		PUMP ITEM NO. 21-MP-107A/B PUMP ITEM NO. 21-MP-107A/B	
10 GEAR ITEM NO. _____		MOTOR ITEM NO. 21-MP-107A/BM TURBINE ITEM NO. _____	
11 GEAR PROVIDED BY _____		MOTOR PROVIDED BY Vendor TURBINE PROVIDED BY _____	
12 GEAR MOUNTED BY _____		MOTOR MOUNTED BY Vendor TURBINE MOUNTED BY _____	
13 GEAR DATA SHT. NO. _____		MOTOR DATA SHT. NO. _____ TURBINE DATA SHT. NO. _____	
14 OPERATING CONDITIONS		14 SITE AND UTILITY DATA (CONT'D)	
15 CAPACITY, NORMAL 7001 (GPM) RATED 8051 (GPM)		WATER SOURCE _____	
16 OTHER _____		CHLORIDE CONCENTRATION (PPM) (3.5.2.5)	
17 SUCTION PRESSURE MAX./RATED 28 / -6.9 (PSIG)		INSTRUMENT AIR: MAX/MIN PRESS / (PSIG)	
18 DISCHARGE PRESSURE 91 (PSIG)		LIQUID	
19 DIFFERENTIAL PRESSURE 98 (PSI)		TYPE OR NAME OF LIQUID Ethanol	
20 DIFF. HEAD 287 (FT) NPSHA 15.9631 (FT)		PUMPING TEMPERATURE	
21 PROCESS VARIATIONS (3.1.2)		NORMAL 80 (°F) MAX. 125 (°F) MIN. (°F)	
22 STARTING CONDITIONS (3.1.3)		VAPOR PRESSURE 1.3 (PSIA) @ 80 (°F)	
23 SERVICE: ☐ CONT. ☒ INTERMITTENT (STARTS/DAY) 1		RELATIVE DENSITY (SPECIFIC GRAVITY):	
24 PARALLEL OPERATION REQ'D (2.1.11)		NORMAL 0.79 MAX. 1.0 MIN. 0.79	
25 SITE AND UTILITY DATA		SPECIFIC HEAT, Cp 0.7896 (BTU/LB °F)	
26 LOCATION: (2.1.29)		VISCOSITY 0.93 (cP) @ 80 (°F)	
27 ☐ INDOOR ☐ HEATED ☐ UNDER ROOF		MAX. VISCOSITY 1 (cP)	
28 ☒ OUTDOOR ☐ UNHEATED ☐ PARTIAL SIDES		☐ CORROSIVE/EROSIVE AGENT (2.11.1.8)	
29 ☐ GRADE ☐ MEZZANINE ☐ _____		☐ CHLORIDE CONCENTRATION (PPM) (3.5.2.6)	
30 ☐ ELECTRIC AREA CLASSIFICATION (2.1.22 / 3.1.5)		☐ H ₂ S CONCENTRATION (PPM) (2.11.1.11)	
31 ☐ CL ☐ GR ☐ DIV _____		LIQUID (2.1.3) ☐ HAZARDOUS ☒ FLAMMABLE	
32 ☐ WINTERIZATION REQ'D ☐ TROPICALIZATION REQ'D		☐ OTHER _____	
33 SITE DATA (2.1.29)		PERFORMANCE	
34 ALTITUDE 5 (FT) BAROMETER (PSIA)		PROPOSAL CURVE NO. 65079 RPM 1170	
35 RANGE OF AMBIENT TEMPS: MIN/MAX. 104 / 15 (°F)		IMPELLER DIA. RATED 25.88 MAX. 27.25 MIN. 21.5 (IN.)	
36 RELATIVE HUMIDITY: MIN / MAX / 100 (%)		RATED POWER 542 (BHP) EFFICIENCY 85 (%)	
37 UNUSUAL CONDITIONS: (2.1.23) ☐ DUST ☐ FUMES		MINIMUM CONTINUOUS FLOW:	
38 ☐ OTHER Petroleum Refinery Atmosphere		THERMAL (GPM) STABLE 3300 (GPM)	
39 UTILITY CONDITIONS:		PREFERRED OPERATING REGION 5600 TO 8800 (GPM)	
40 STEAM: DRIVERS HEATING		ALLOWABLE OPERATING REGION 3300 TO 9650 (GPM)	
41 MIN 550 (PSIG) (°F) (PSIG) (°F)		MAX HEAD @ RATED IMPELLER 325 (FT)	
42 MAX 650 (PSIG) (°F) (PSIG) (°F)		MAX POWER @ RATED IMPELLER 585 (BHP)	
43 ELECTRICITY DRIVERS HEATING CONTROL SHUTDOWN		NPSHR AT RATED CAPACITY 14 (FT) (2.1.8)	
44 VOLTAGE 176		SUCTION SPECIFIC SPEED 10225 (2.1.9)	
45 HERTZ		☐ MAX. SOUND PRESS. LEVEL REQ'D (dBA) (2.1.14)	
46 PHASE		EST MAX SOUND PRESS. LEVEL 83.5 (dBA) (2.1.14)	
47 COOLING WATER: (2.1.17)		REMARKS: Sulzer standard wear ring clearances.	
48 TEMP. INLET (°F) MAX. RETURN (°F)			
49 PRESS. NORM (PSIG) DESIGN (PSIG)			
50 MIN RETURN (PSIG) MAX ALLOW DP (PSI)			

06/95 SHT 1 OF 5 API610.XLS REV 0

77.5 FLA

SULZER STANDARD CLEARANCES

65079

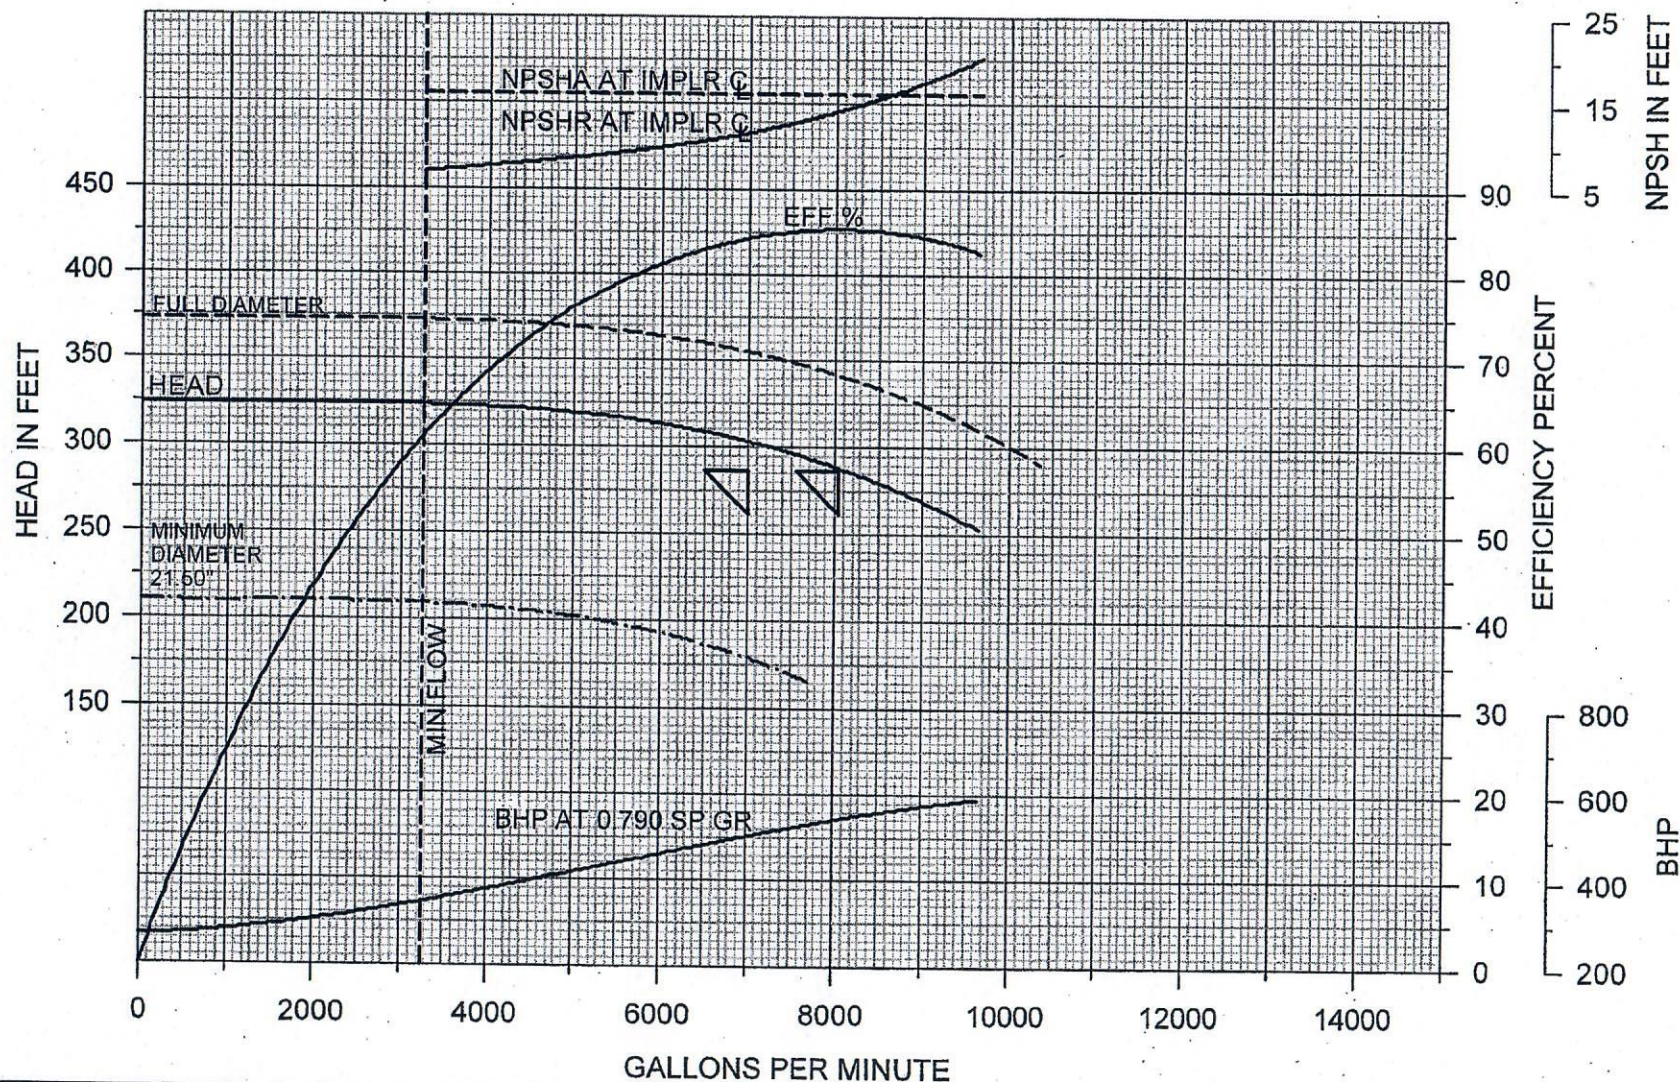

01722973

CBI MATRIX ENGINEERING
CHEVRON TEXACO COMPANY
REFINERIA COLON, PANAMA
DRY ETOH LOADING PUMP
ITEM NO: 21-MP-107A/B

SULZER

PAN.0003 HOU.03.0949-F1
EP 009-0949-JM DLE/LMJ 30-JAN-04

IMPELLER
MAX DIA
27.25"

EYE AREA SQ IN
184

16 X 20 X 29 HSA 1 STAGE

DIA IMPELLER
25.88"

IMPELLER PATT
1613 HSB-7



1170 RPM

REFERENCE
PF-HB-78-1mod

CURVE NO.
65079

REV
-

107722973

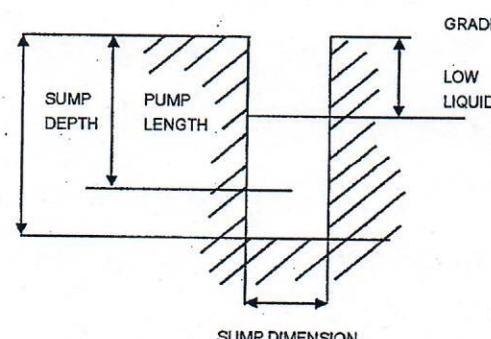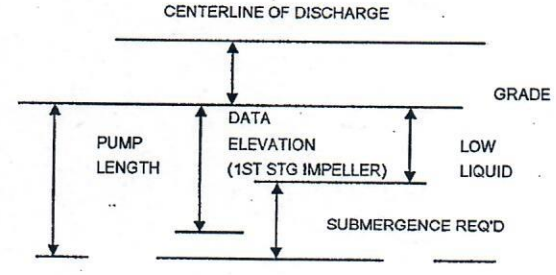		JOB NO. 613144 ITEM NO. 21-MP-107A/B	
VERTICAL PUMP (API 610-8TH) SUPPLEMENTAL DATA SHEET U.S. CUSTOMARY UNITS		REVISION NO. 0 DATE 3/1/2004 PAGE 1 OF 1 BY gpm	
1 VERTICAL TYPE (FIG 1.1) ☐ VS1 ☐ VS2 ☐ VS3 ☐ VS4 ☐ VS5 ☐ VS6 ☐ VS7 ☐ OTHER			
2 REMARKS			
3			
4			
5			
VERTICAL PUMPS		VERTICAL PUMPS (CONT'D)	
7 ☐ PUMP THRUST: (+) UP (-) DOWN		LINE SHAFT: ☐ OPEN ☐ ENCLOSED	
8 AT MIN FLOW _____ (LBS) _____ (LBS)		☐ LINE SHAFT DIAMETER _____ (IN) ☐ TUBE DIAMETER _____ (IN)	
9 AT RATED FLOW _____ (LBS) _____ (LBS)		LINE SHAFT COUPLING:	
10 AT MAX FLOW _____ (LBS) _____ (LBS)		☐ SLEEVE & KEY ☐ THREADED	
11 MAX THRUST _____ (LBS) _____ (LBS)		☐ SUCTION CAN THICKNESS _____ (IN)	
12 ☒ SOLEPLATE _____ (IN) X _____ (IN)		☐ LENGTH _____ (FT)	
13 ☐ SOLEPLATE THICKNESS _____ (IN)		☐ DIAMETER _____ (FT)	
14 COLUMN PIPE: ☐ FLANGED ☐ THREADED		☐ SUCTION STRAINER TYPE	
15 DIAMETER _____ (IN) LENGTH _____ (FT)		☐ FLOAT & ROD ☐ FLOAT SWITCH	
16 GUIDE BUSHINGS:		☐ IMPELLER COLLETS ACCEPTABLE (2.5.2)	
17 ☐ NUMBER _____		☐ HARDENED SLEEVES UNDER BEARINGS (5.3.9.7)	
18 ☐ LINE SHAFT BEARING SPACING _____ (IN)		☐ RESONANCE TEST (5.3.8.2)	
19 GUIDE BUSHING LUBE:		☐ STRUCTURAL ANALYSIS (5.3.4.1)	
20 ☐ WATER ☐ OIL		☐ DRAIN PIPED TO SURFACE (5.3.12.6)	
21 ☐ GREASE ☐ PUMPAGE			
SUMP ARRANGEMENT			
			
SUMP DIMENSION		SUBMERGENCE REQ'D	
☐ SUMP DEPTH _____ (FT)		☐ PUMP LENGTH _____ (FT)	
☐ SUMP DIMENSION _____ (FT)		☐ SUBMERGENCE REQ'D _____ (FT)	
☐ LOW LIQUID _____ (FT)		☐ CENTERLINE DISCHARGE HEIGHT _____ (FT)	
		☐ DATUM ELEVATION _____ (FT)	

06/95 SHT 1 OF 1 API610.XLS REV 0

01722973


 Matrix <i>Business & Technology</i>		JOB NO. <u>613144</u> ITEM NO. <u>21-MP-107A/B</u> REVISION NO. <u>0</u> DATE <u>3/1/2004</u> PAGE <u>4</u> OF <u>5</u> BY <u>gpm</u>	
CENTRIFUGAL PUMP (API 610-8TH) DATA SHEET U.S. CUSTOMARY UNITS			
1	INSTRUMENTATION	MOTOR DRIVE (CONT) (3.1.5)	
2	VIBRATION:	REMARKS <u>DRIVER SHALL COVER THE END OF CURVE</u>	
3	☒ NONCONTACTING (API 670) ☐ TRANSDUCER	<u>REQUIREMENTS FOR THE IMPELLER SELECTED</u>	
4	☒ PROVISION FOR MOUNTING ONLY (2.9.2.11)	<u>PUMPING 1.0 SP GR FLUID</u>	
5	☐ FLAT SURFACE REQ'D (2.9.2.12)		
6	☐ SEE ATTACHED API 670 DATA SHEET		
7	☐ MONITORS AND CABLES (3.4.3.3)		
8	REMARKS _____		
9	_____		
10	_____		
11	TEMPERATURE AND PRESSURE:	SURFACE PREPARATION AND PAINT	
12	☒ RADIAL BRG METAL TEMP ☐ THRUST BRG METAL TEMP	☒ MANUFACTURER'S STANDARD	
13	☒ PROVISION FOR INSTRUMENTS ONLY	☐ OTHER (SEE BELOW)	
14	☐ SEE ATTACHED API-670 DATA SHEET	PUMP:	
15	☐ TEMP GAUGES (WITH THERMOWELLS) (3.4.1.3)	☐ PUMP SURFACE PREPARATION _____	
16	OTHER _____	☐ PRIMER _____	
17	☐ PRESSURE GAUGE TYPE (3.4.2.2) _____	☐ FINISH COAT _____	
18	LOCATION _____	BASEPLATE: (3.3.18)	
19	REMARKS _____	☐ BASEPLATE SURFACE PREPARATION _____	
20	_____	☐ PRIMER _____	
21	_____	☐ FINISH COAT _____	
22	SPARE PARTS (TABLE 6.1)	SHIPMENT: (4.4.1)	
23	☐ START-UP ☐ NORMAL MAINTENANCE	☐ DOMESTIC ☒ EXPORT ☐ EXPORT BOXING REQUIRED	
24	☐ SPECIFY _____	☐ OUTDOOR STORAGE MORE THAN 6 MONTHS	
25	_____	SPARE ROTOR ASSEMBLY PACKAGED FOR:	
26	_____	☐ HORIZONTAL STORAGE ☐ VERTICAL STORAGE	
27	MOTOR DRIVE (3.1.5)	☐ TYPE OF SHIPPING PREPARATION _____	
28	☒ MANUFACTURER <u>Reliance Electric</u>	REMARKS _____	
29	☒ 600 (HP) ☒ 1200 (RPM)	_____	
30	☒ HORIZONTAL ☐ VERTICAL	_____	
31	☒ FRAME	WEIGHTS	
32	☒ SERVICE FACTOR	MOTOR DRIVEN:	
33	☒ VOLTS/PHASE/HERTZ <u>4160 / 3 / 60</u>	WEIGHT OF PUMP (LBS) <u>8147</u>	
34	☒ TYPE	WEIGHT OF BASEPLATE (LBS) <u>5023</u>	
35	☒ ENCLOSURE	WEIGHT OF MOTOR (LBS) _____	
36	☐ MINIMUM STARTING VOLTAGE (3.1.6) _____	WEIGHT OF GEAR (LBS) <u>0</u>	
37	☐ TEMPERATURE RISE _____	TOTAL WEIGHT (LBS) _____	
38	☐ FULL LOAD AMPS _____	TURBINE DRIVEN:	
39	☐ LOCKED ROTOR AMPS _____	WEIGHT OF BASEPLATE (LBS) <u>N/A</u>	
40	☒ INSULATION	WEIGHT OF TURBINE (LBS) _____	
41	☐ STARTING METHOD _____	WEIGHT OF GEAR (LBS) _____	
42	☒ LUBE	TOTAL WEIGHT (LBS) _____	
43	☐ VERTICAL THRUST CAPACITY	REMARKS _____	
44	UP _____ (LBS) DOWN _____ (LBS)	_____	
45	BEARINGS (TYPE / NUMBER):	OTHER PURCHASE REQUIREMENTS	
46	☐ RADIAL _____ / _____	☐ COORDINATION MEETING REQUIRED (6.1.3)	
47	☐ THRUST _____ / _____	☐ REVIEW FOUNDATION DRAWINGS (2.1.27)	
48	REMARKS: _____	☐ REVIEW PIPING DRAWINGS	
49	_____	☐ OBSERVE PIPING CHECKS	
50	_____	☐ OBSERVE INITIAL ALIGNMENT CHECK	
		☐ CHECK ALIGNMENT AT OPERATING TEMPERATURE	
		☐ CONNECTION DESIGN APPROVAL (2.11.3.5.4)	

06/95 SHT 4 OF 5 API610.XLS REV 0

01722973

 Matrix Processes & Technology		JOB NO. <u>613144</u> ITEM NO. <u>21-MP-107A/B</u>	
CENTRIFUGAL PUMP (API 610-8TH) DATA SHEET U.S. CUSTOMARY UNITS		REVISION NO. <u>0</u> DATE <u>3/1/2004</u>	
		PAGE <u>5</u> OF <u>5</u> BY <u>gpm</u>	
OTHER PURCHASER REQUIREMENTS (CONT) ☐ RIGGING DEVICE REQ'D FOR TYPE OH3 PUMP (5.1.2.7) ☐ HYDRODYNAMIC THRUST BRG SIZE REVIEW REQ'D (5.2.5.2.4) ☒ LATERAL ANALYSIS REQUIRED (5.1.3.3/5.2.4.1) ☐ ROTOR DYNAMIC BALANCE (5.2.4.2) ☐ MOUNT SEAL RESERVOIR OFF BASEPLATE (3.5.1.4) ☐ INSTALLATION LIST IN PROPOSAL (6.2.3L) ☐ SPARE ROTOR VERTICAL STORAGE (5.2.9.2) ☐ TORSIONAL ANALYSIS/REPORT (2.8.2.6) ☒ PROGRESS REPORTS REQUIRED (6.3.4) REMARKS: _____ _____ _____ _____ QA INSPECTION AND TEST ☐ REVIEW VENDORS QA PROGRAM (4.1.7) ☐ PERFORMANCE CURVE APPROVAL ☐ SHOP INSPECTION (4.1.4) ☒ TEST WITH SUBSTITUTE SEAL (4.3.3.1.2) <table border="1" style="width: 100%; border-collapse: collapse; margin-top: 5px;"> <thead> <tr> <th style="width: 30%;">TEST</th> <th style="width: 10%;">NON-WIT</th> <th style="width: 10%;">WIT</th> <th style="width: 10%;">OBSERVE</th> </tr> </thead> <tbody> <tr><td>20 HYDROSTATIC (4.3.2)</td><td style="text-align: center;">☒</td><td style="text-align: center;">☐</td><td style="text-align: center;">☐</td></tr> <tr><td>21 PERFORMANCE (4.3.3)</td><td style="text-align: center;">☐</td><td style="text-align: center;">☒</td><td style="text-align: center;">☐</td></tr> <tr><td>22 NPSH (4.3.4.1)</td><td style="text-align: center;">☐</td><td style="text-align: center;">☒</td><td style="text-align: center;">☐</td></tr> <tr><td>23 COMPLETE UNIT TEST (4.3.4.2)</td><td style="text-align: center;">☐</td><td style="text-align: center;">☐</td><td style="text-align: center;">☐</td></tr> <tr><td>24 SOUND LEVEL TEST (4.3.4.3)</td><td style="text-align: center;">☐</td><td style="text-align: center;">☐</td><td style="text-align: center;">☐</td></tr> <tr><td>25 ☐ CLEANLINESS PRIOR TO</td><td style="text-align: center;">☐</td><td style="text-align: center;">☐</td><td style="text-align: center;">☐</td></tr> <tr><td>26 ☐ FINAL ASSEMBLY (4.2.3.1)</td><td style="text-align: center;">☐</td><td style="text-align: center;">☐</td><td style="text-align: center;">☐</td></tr> <tr><td>27 ☐ NOZZLE LOAD TEST (3.3.6)</td><td style="text-align: center;">☐</td><td style="text-align: center;">☐</td><td style="text-align: center;">☐</td></tr> <tr><td>28 ☐ BRG HSG RESONANCE</td><td style="text-align: center;">☐</td><td style="text-align: center;">☐</td><td style="text-align: center;">☐</td></tr> <tr><td>29 ☐ TEST (4.3.4.5)</td><td style="text-align: center;">☐</td><td style="text-align: center;">☐</td><td style="text-align: center;">☐</td></tr> <tr><td>30 ☐ REMOVE/INSPECT</td><td style="text-align: center;">☐</td><td style="text-align: center;">☐</td><td style="text-align: center;">☐</td></tr> <tr><td>31 HYDRODYNAMIC BEARINGS</td><td></td><td></td><td></td></tr> <tr><td>32 AFTER TEST (5.2.8.5)</td><td></td><td></td><td></td></tr> <tr><td>33 ☐ AUXILIARY EQUIPMENT</td><td style="text-align: center;">☐</td><td style="text-align: center;">☐</td><td style="text-align: center;">☐</td></tr> <tr><td>34 ☐ TEST (4.3.4.4)</td><td style="text-align: center;">☐</td><td style="text-align: center;">☐</td><td style="text-align: center;">☐</td></tr> <tr><td>35 ☒ Final Inspection</td><td style="text-align: center;">☐</td><td style="text-align: center;">☒</td><td style="text-align: center;">☐</td></tr> <tr><td>36 ☐</td><td style="text-align: center;">☐</td><td style="text-align: center;">☐</td><td style="text-align: center;">☐</td></tr> <tr><td>37 ☒ MATERIAL CERTIFICATION REQUIRED (2.11.1.7)</td><td></td><td></td><td></td></tr> <tr><td>38 ☒ CASING ☒ IMPELLER ☒ SHAFT</td><td></td><td></td><td></td></tr> <tr><td>39 ☐ OTHER</td><td></td><td></td><td></td></tr> <tr><td>40 ☐ CASTING REPAIR PROCEDURE APPROVAL REQ'D (2.11.2.5)</td><td></td><td></td><td></td></tr> <tr><td>41 ☐ INSPECTION REQUIRED FOR CONNECTION WELDS (2.11.3.5.6)</td><td></td><td></td><td></td></tr> <tr><td>42 ☐ MAG PARTICLE ☐ LIQUID PENETRANT</td><td></td><td></td><td></td></tr> <tr><td>43 ☐ RADIOGRAPHIC ☐ ULTRASONIC</td><td></td><td></td><td></td></tr> <tr><td>44 ☐ INSPECTION REQUIRED FOR CASTINGS (4.2.1.3)</td><td></td><td></td><td></td></tr> <tr><td>45 ☐ MAG PARTICLE ☐ LIQUID PENETRANT</td><td></td><td></td><td></td></tr> <tr><td>46 ☐ RADIOGRAPHIC ☐ ULTRASONIC</td><td></td><td></td><td></td></tr> </tbody> </table> 47 ADDITIONAL REMARKS: _____ 48 _____ 49 _____ 50 _____ 51 _____		TEST	NON-WIT	WIT	OBSERVE	20 HYDROSTATIC (4.3.2)	☒	☐	☐	21 PERFORMANCE (4.3.3)	☐	☒	☐	22 NPSH (4.3.4.1)	☐	☒	☐	23 COMPLETE UNIT TEST (4.3.4.2)	☐	☐	☐	24 SOUND LEVEL TEST (4.3.4.3)	☐	☐	☐	25 ☐ CLEANLINESS PRIOR TO	☐	☐	☐	26 ☐ FINAL ASSEMBLY (4.2.3.1)	☐	☐	☐	27 ☐ NOZZLE LOAD TEST (3.3.6)	☐	☐	☐	28 ☐ BRG HSG RESONANCE	☐	☐	☐	29 ☐ TEST (4.3.4.5)	☐	☐	☐	30 ☐ REMOVE/INSPECT	☐	☐	☐	31 HYDRODYNAMIC BEARINGS				32 AFTER TEST (5.2.8.5)				33 ☐ AUXILIARY EQUIPMENT	☐	☐	☐	34 ☐ TEST (4.3.4.4)	☐	☐	☐	35 ☒ Final Inspection	☐	☒	☐	36 ☐	☐	☐	☐	37 ☒ MATERIAL CERTIFICATION REQUIRED (2.11.1.7)				38 ☒ CASING ☒ IMPELLER ☒ SHAFT				39 ☐ OTHER				40 ☐ CASTING REPAIR PROCEDURE APPROVAL REQ'D (2.11.2.5)				41 ☐ INSPECTION REQUIRED FOR CONNECTION WELDS (2.11.3.5.6)				42 ☐ MAG PARTICLE ☐ LIQUID PENETRANT				43 ☐ RADIOGRAPHIC ☐ ULTRASONIC				44 ☐ INSPECTION REQUIRED FOR CASTINGS (4.2.1.3)				45 ☐ MAG PARTICLE ☐ LIQUID PENETRANT				46 ☐ RADIOGRAPHIC ☐ ULTRASONIC				QA INSPECTION AND TEST (CONT'D) ☐ ADDITIONAL INSPECTION REQUIRED FOR: _____ (4.2.1.3) ☐ MAG PARTICLE ☐ LIQUID PENETRANT ☐ RADIOGRAPHIC ☐ ULTRASONIC ☐ ALTERNATE ACCEPTANCE CRITERIA (SEE REMARKS) (4.2.2.1) ☐ HARDNESS TEST REQUIRED FOR: _____ (4.2.3.2) ☒ WETTING AGENT HYDROTEST (4.3.2.5) ☐ VENDOR SUBMIT TEST PROCEDURES (4.3.1.2/6.2.5) ☒ RECORD FINAL ASSEMBLY RUNNING CLEARANCES ☐ INSPECTION CHECK-LIST (APPENDIX N) _____ (4.1.6) REMARKS _____ _____ _____ _____ GENERAL REMARKS REMARK 1: _____ _____ _____ _____ REMARK 2: _____ _____ _____ _____ REMARK 3: _____ _____ _____ _____ REMARK 4: _____ _____ _____ _____ REMARK 5: _____ _____ _____ _____ REMARK 6: _____ _____ _____ _____	

06/95 SHT 5 OF 5 API610.XLS REV 0

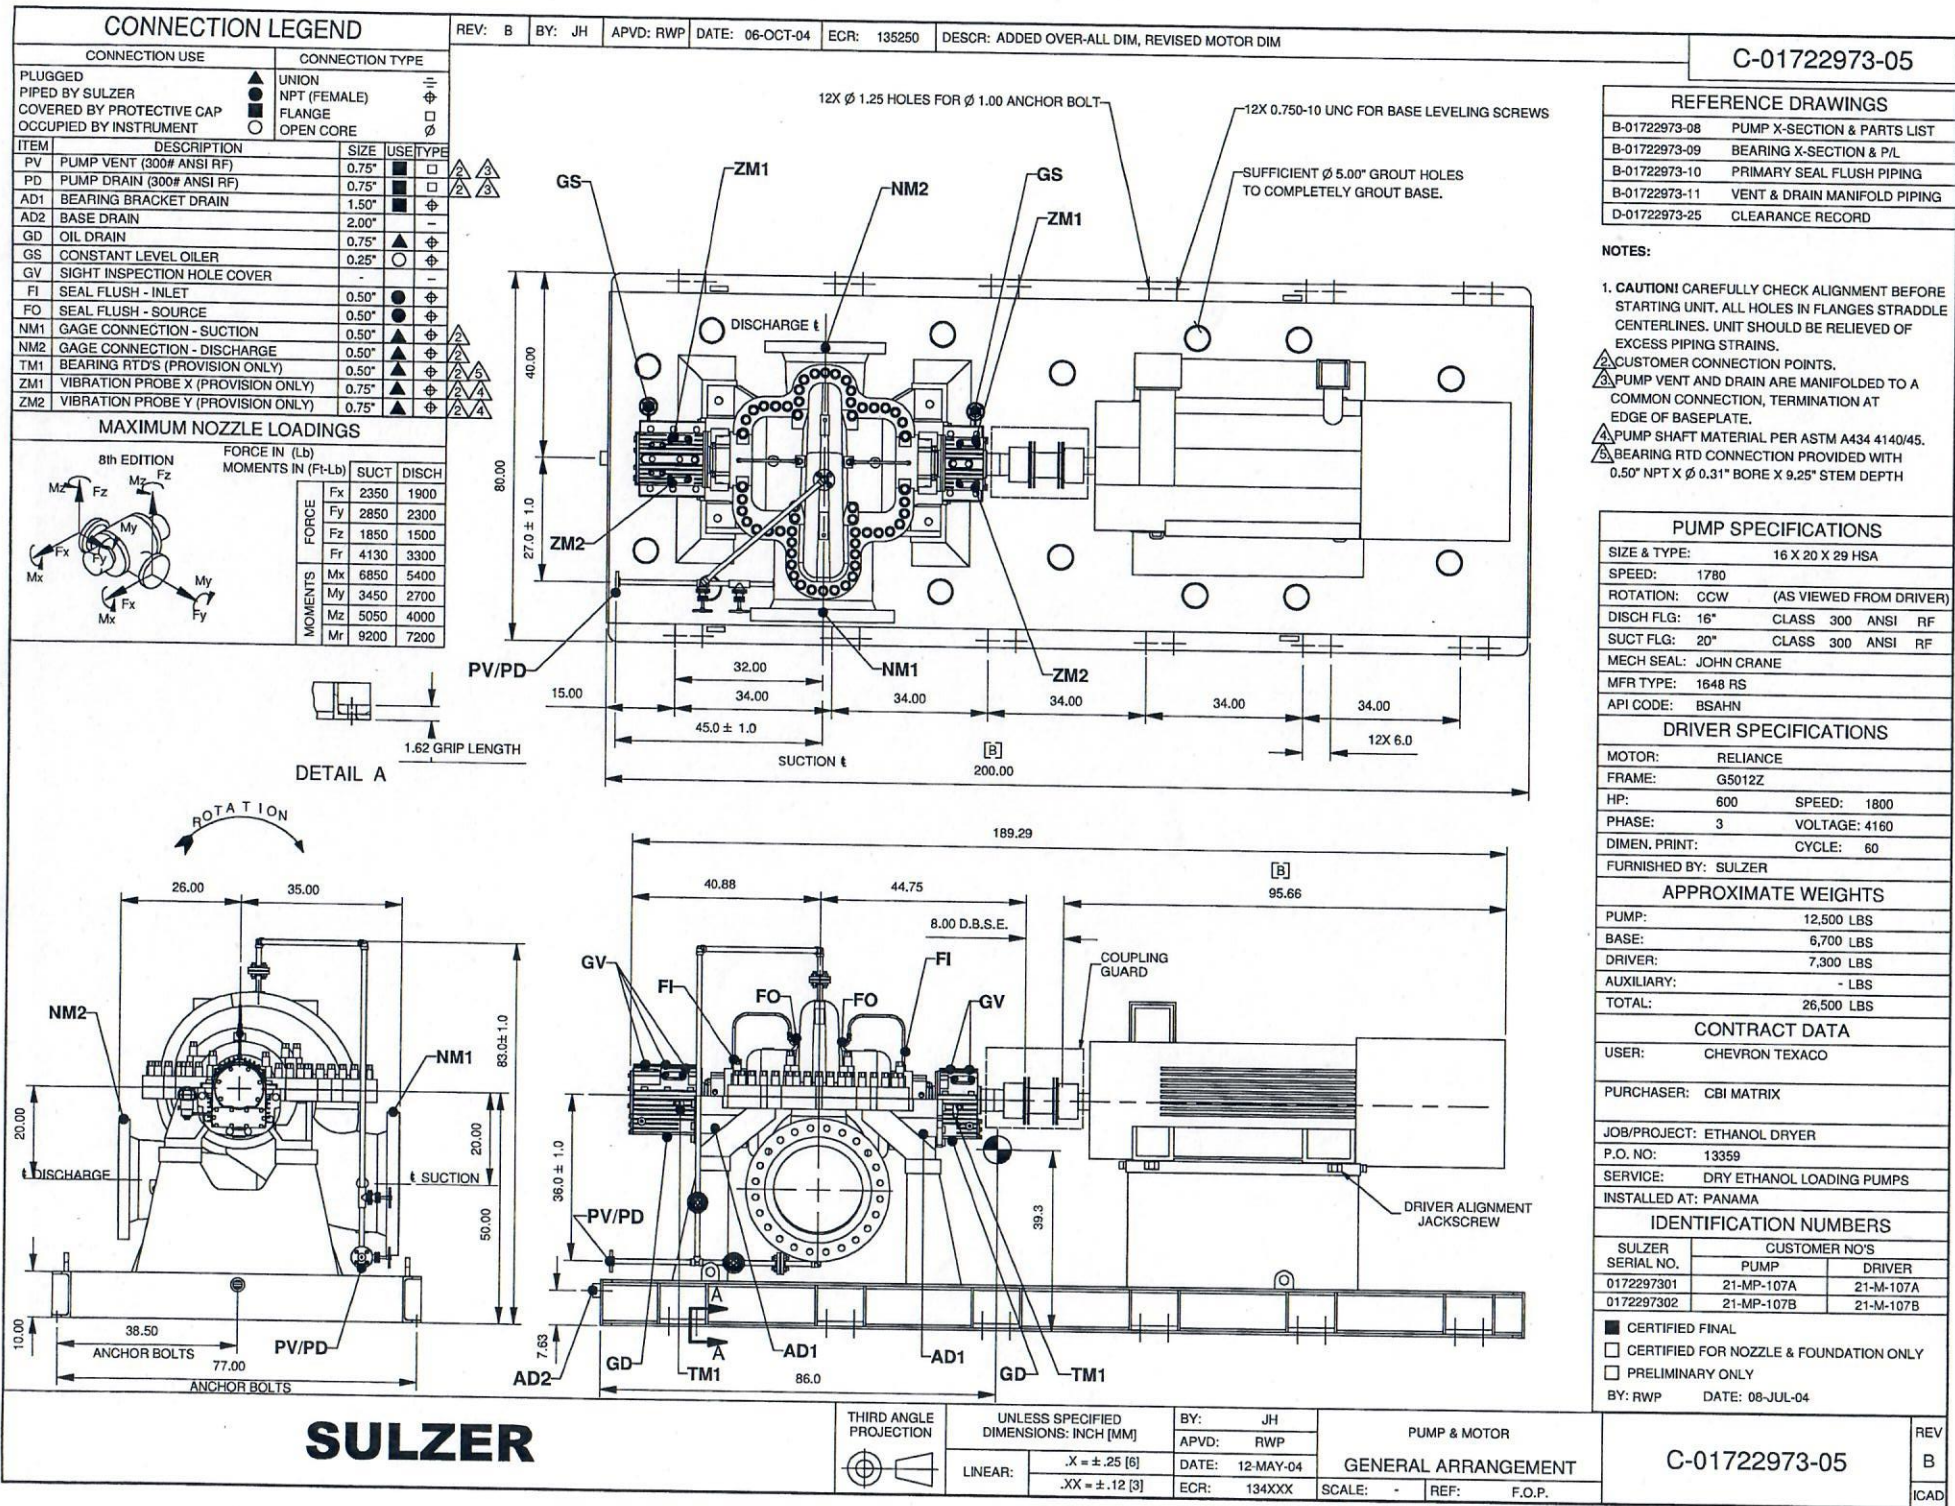

01722973

		JOB NO. <u>613144</u> ITEM NO. <u>21-MP-107A/B</u>	
CENTRIFUGAL PUMP (API 610-8TH) DATA SHEET U.S. CUSTOMARY UNITS		REVISION NO. <u>0</u> DATE <u>3/1/2004</u> PAGE <u>3</u> OF <u>5</u> BY <u>gpm</u>	
BEARINGS AND LUBRICATION (CONT) 2 ☐ OIL HEATER REQ'D ☐ ELECTRIC ☐ STEAM (2.9.2.9/5.2.6.3) 3 ☐ OIL PRESS TO BE GREATER THAN COOLANT PRESS (5.2.6.2.b) 4 REMARKS _____ 5 _____ 6 _____		MECHANICAL SEAL OR PACKING (CONT) ☐ VAPOR PRESSURE _____ (PSIA) @ _____ (°F) ☐ HAZARDOUS ☐ FLAMMABLE ☐ OTHER _____ ☐ FLOW RATE MAX/MIN _____ / _____ (GPM) ☐ PRESSURE REQUIRED MAX/MIN _____ / _____ (PSIG) ☒ TEMPERATURE REQUIRED MAX/MIN _____ / _____ (°F)	
MECHANICAL SEAL OR PACKING 8 SEAL DATA: (2.7.2) 9 ☒ SEE ATTACHED API-682 DATA SHEET (2.7.2) 10 ☐ NON-API 682 SEAL (2.7.2) 11 ☒ APPENDIX H SEAL CODE <u>BSAHN</u> (2.11.1.1) 12 ☒ SEAL MANUFACTURER <u>John Crane</u> 13 ☒ SIZE AND TYPE <u>4.75 / 1648RS-2</u> 14 ☒ MANUFACTURER CODE <u>BP(147)1BD(81)H 316/HC</u> 15 SEAL CHAMBER DATA: (2.1.6/2.1.7) 16 ☒ TEMPERATURE _____ (°F) 17 ☒ PRESSURE _____ (PSIG) 18 ☒ FLOW _____ (GPM) ☐ SEAL CHAMBER SIZE (TABLE 2.3) 20 ☐ TOTAL LENGTH _____ (IN) ☐ CLEAR LENGTH _____ (IN) 21 SEAL CONSTRUCTION: 22 ☒ SLEEVE MATERIAL <u>316 SS</u> 23 ☒ GLAND MATERIAL <u>316 SS</u> 24 ☐ AUX SEAL DEVICE (2.7.3.20) 25 ☒ JACKET REQUIRED (2.7.3.17) 26 GLAND TAPS: (2.7.3.14) 27 ☒ FLUSH (F) ☐ DRAIN (D) ☐ BARRIER/BUFF. (B) 28 ☐ QUENCH (Q) ☐ COOLING (C) ☐ LUBRICATION (G) 29 ☐ HEATING (H) ☐ LEAKAGE ☐ PUMPED FLUID (P) 30 ☒ BAL'NCE FLUID (E) ☐ EXTERNAL FLUID INJECTION (X) 31 SEAL FLUIDS REQUIREMENT AND AVAILABLE FLUSH LIQUID: 32 NOTE: IF FLUSH LIQUID IS PUMPAGE LIQUID (AS IN FLUSH PIPING 33 PLANS 11 TO 41), FOLLOWING FLUSH LIQUID DATA IS NOT REQ'D. 34 ☐ SUPPLY TEMPERATURE MAX/MIN _____ / _____ (°F) 35 ☐ RELATIVE DENSITY (SPECIFIC GRAVITY) _____ @ _____ (°F) 36 ☐ NAME OF FLUID _____ 37 ☐ SPECIFIC HEAT, Cp _____ (BTU/LB °F) 38 ☐ VAPOR PRESSURE _____ (PSIA) @ _____ (°F) 39 ☐ HAZARDOUS ☐ FLAMMABLE ☐ OTHER _____ 40 ☐ FLOW RATE MAX/MIN _____ / _____ (GPM) 41 ☐ PRESSURE REQUIRED MAX/MIN _____ / _____ (PSIG) 42 ☐ TEMPERATURE REQUIRED MAX/MIN _____ / _____ (°F) 43 BARRIER/BUFFER FLUID (2.7.3.21): 44 ☐ SUPPLY TEMPERATURE MAX/MIN _____ / _____ (°F) 45 ☐ RELATIVE DENSITY (SPECIFIC GRAVITY) _____ @ _____ (°F) 46 ☐ NAME OF FLUID _____ 47 ADDITIONAL REMARKS: _____ 48 _____ 49 _____ 50 _____ 51 _____		QUENCH FLUID: ☐ NAME OF FLUID _____ ☐ FLOW RATE _____ (GPM) SEAL FLUSH PIPING: (2.7.3.19 AND APPENDIX D) ☒ SEAL FLUSH PIPING PLAN <u>11</u> ☒ TUBING ☐ CARBON STEEL ☒ PIPE ☒ STAINLESS STEEL ☐ AUXILIARY FLUSH PLAN <u>None</u> ☐ TUBING ☐ CARBON STEEL ☐ PIPE ☐ STAINLESS STEEL ☐ PIPING ASSEMBLY: (3.5.2.10.1) ☐ THREADED ☐ UNIONS ☐ SOCKET WELDED ☐ FLANGED ☐ TUBE TYPE FITTINGS ☐ PRESSURE SWITCH (PLAN 52/53) TYPE _____ ☐ PRESSURE GAUGE (PLAN 52/53) TYPE _____ ☐ LEVEL SWITCH (PLAN 52/53) TYPE _____ ☐ LEVEL GAUGE (PLAN 52/53) TYPE _____ ☐ TEMP INDICATOR (PLANS 21, 22, 23, 32, 41) ☐ HEAT EXCHANGER (PLAN 52/53) REMARKS _____ _____ _____ PACKING DATA: (APPENDIX C) MANUFACTURER _____ TYPE _____ SIZE _____ NO. OF RINGS _____ ☐ PACKING INJECTION REQUIRED ☐ FLOW _____ (GPM) @ _____ (°F) ☐ LANTERN RING _____ STEAM AND COOLING WATER PIPING ☒ COOLING WATER PIPING PLAN _____ (3.5.4.1) ☐ COOLING WATER REQUIREMENTS SEAL JACKET/BRG HSG _____ (GPM) @ _____ (PSIG) SEAL HEAT EXCHANGER _____ (GPM) @ _____ (PSIG) QUENCH _____ (GPM) @ _____ (PSIG) TOTAL COOLING WATER _____ (GPM) ☐ STEAM PIPING: ☐ TUBING ☐ PIPE REMARKS _____ _____ _____	

06/95 SHT 3 OF 5 API610.XLS REV 0

01722973

		CENTRIFUGAL PUMP (API 610-8TH) DATA SHEET U.S. CUSTOMARY UNITS													
1 CONSTRUCTION		CONSTRUCTION (CONT)													
2 APPLICABLE STANDARD: 3 ☒ API 610 8TH EDITION 4 ☐ OTHER (SEE REMARKS)		5 SHAFT DIAMETER BETWEEN BEARINGS <u>5</u> (IN) 6 SPAN BETWEEN BEARING CENTERS <u>59.5</u> (IN) 7 SPAN BETWEEN BEARING & IMPELLER <u>29.75</u> (IN)													
5 PUMP TYPE: (1.1.2) 6 ☐ OH2 ☐ BB1 ☐ VS1 ☐ VS6 7 ☐ OH3 ☐ BB2 ☐ VS2 ☐ VS7 8 ☐ OH6 ☐ BB3 ☐ VS3 ☐ OTHER 9 ☐ BB4 ☐ VS4 10 ☐ BB5 ☐ VS5		REMARKS 													
11 NOZZLE CONDITIONS: (2.3.2)		COUPLINGS: (3.2.2) DRIVER - PUMP													
<table border="1" style="width: 100%; border-collapse: collapse;"> <thead> <tr> <th>SIZE (IN)</th> <th>FLANGE RATING (LBS)</th> <th>FAC'G</th> <th>POSITION</th> </tr> </thead> <tbody> <tr> <td>20</td> <td>300</td> <td>RF</td> <td>SIDE</td> </tr> <tr> <td>16</td> <td>300</td> <td>RF</td> <td>SIDE</td> </tr> </tbody> </table>		SIZE (IN)	FLANGE RATING (LBS)	FAC'G	POSITION	20	300	RF	SIDE	16	300	RF	SIDE	☒ MAKE <u>Metastream</u> ☒ MODEL <u>TSCS-0500</u> ☐ RATING (HP/100 RPM) <u>67</u> ☒ LUBRICATION <u>None</u> ☐ LIMITED END FLOAT REQUIRED <u>Integral</u> ☒ SPACER LENGTH <u>8</u> (IN) ☒ SERVICE FACTOR <u>1</u>	
SIZE (IN)	FLANGE RATING (LBS)	FAC'G	POSITION												
20	300	RF	SIDE												
16	300	RF	SIDE												
12 SUCTION 13 DISCHARGE 14 BALANCE DRUM		DRIVER HALF COUPLING MOUNTED BY: (3.2.11) ☒ PUMP MFR. ☐ DRIVER MFR. ☐ PURCHASER ☐ COUPLING PER API 671 (5.2.7)													
15 PRESSURE CASING CONNECTIONS: (2.3.3)		BASEPLATES: ☐ API BASEPLATE NUMBER <u>N/A</u> (APPENDIX M) ☐ NON-GROUT CONSTRUCTION: (3.3.13/5.3.7.3.5)													
<table border="1" style="width: 100%; border-collapse: collapse;"> <thead> <tr> <th>NO.</th> <th>SIZE (NPS)</th> <th>TYPE</th> </tr> </thead> <tbody> <tr> <td>1</td> <td>0.75</td> <td>Sktd weld & Flg</td> </tr> <tr> <td>1</td> <td>0.75</td> <td>In API Plan 11</td> </tr> </tbody> </table>		NO.	SIZE (NPS)	TYPE	1	0.75	Sktd weld & Flg	1	0.75	In API Plan 11	REMARKS: <u>Fabricated steel</u>				
NO.	SIZE (NPS)	TYPE													
1	0.75	Sktd weld & Flg													
1	0.75	In API Plan 11													
16 DRAIN 17 VENT 18 PRESSURE GAUGE 19 TEMP GAUGE 20 WARM-UP 21 BALANCE / LEAK-OFF		MATERIAL ☒ APPENDIX H CLASS <u>S-4</u> (2.11.1.1) ☒ MIN DESIGN METAL TEMP (2.11.4.5) <u>-20</u> (°F) ☒ BARREL/CASE <u>A216 Gr. WCB</u> IMPELLER <u>A216 Gr. WCB</u> ☒ CASE/IMPELLER WEAR RINGS <u>Cast Iron</u> ☒ SHAFT <u>A434 CI BC (AISI 4140)</u> ☐ DIFFUSERS ☐ COUPLING SPACER/HUBS <u>Steel</u> ☒ COUPLING DIAPHRAGMS (DISKS) <u>Stainless Steel</u>													
22 CYLINDRICAL THREADS REQUIRED (2.3.3) 23 CASING MOUNTING: (SEE SEPARATE SHEET FOR VERTICLES) 24 ☐ CENTERLINE ☒ NEAR CENTERLINE 25 ☐ FOOT ☐ SEPARATE MOUNTING PLATE 26 ☐ IN-LINE 27 CASING SPLIT: 28 ☐ AXIAL ☒ RADIAL 29 CASING TYPE: 30 ☐ SINGLE VOLUTE ☒ MULTIPLE VOLUTE ☐ DIFFUSER 31 ☒ OVERHUNG ☒ BETWEEN BEARINGS ☐ BARREL 32 CASE PRESSURE RATING: 33 MAX ALLOWABLE WORKING PRESSURE <u>465</u> (PSIG) 34 @ <u>100</u> (°F) 35 HYDROTEST PRESSURE <u>700</u> (PSIG) 36 SUCT'N PRESS. REGIONS MUST BE DESIGNED FOR MAWP (2.2.4) 37 ROTATION: (VIEWED FROM COUPLING END) 38 ☐ CW ☒ CCW 39 IMPELLERS INDIVIDUALLY SECURED (5.2.2.2) 40 REMARKS: 41 BOLT OH3 PUMP TO PAD/FOUNDATION (5.1.2.4) 42 SHAFT: 43 SHAFT DIAMETER AT COUPLING <u>4.75</u> (IN) 44 REMARKS: <u>Premcor [Clark] spec 40.01 applies</u>		BEARINGS AND LUBRICATION BEARING (TYPE/NUMBER): ☒ RADIAL <u>Split Sleeve</u> / ☒ THRUST <u>Ball</u> / <u>7317</u> ☐ REVIEW AND APPROVE THRUST BEARING SIZE (5.2.5.2.4) LUBRICATION: (2.10) ☐ GREASE ☐ FLOOD ☒ RING OIL ☐ FLINGER ☐ PURGE OIL MIST ☐ PURE OIL MIST ☐ CONSTANT LEVEL OILER PREFERENCE (SEE REMARKS) (2.9.2.2) ☐ PRESSURE LUBE SYS (5.2.6) ☐ API-610 ☐ API-614 ☐ OIL VISC. ISO GRADE (5.2.6.5)													

06/95 SHT 2 OF 5 API610.XLS REV 0