



GEN NOTES

- 1.) ALL BOLT HOLES STRADDLE NORMAL VESSEL CENTERLINES U.N.
- 2.) ALL S/S TO BE WIRE BRUSH CLEANED AND PAINTED WITH ONE SHOP COAT SPATZ #60 RED OXIDE PRIMER.
- 3.) TEST VESSEL WITH S/S BOLTS AND RED RUBBER GASKETS
- 4.) INSIDE EDGES OF NOZZLES TO BE RADIUS $\frac{1}{8}$ "
- 5.) BLANK ALL OPENINGS FOR SHIPMENT


all nozzles removed of 3/16" S.S. steel ends April 1981

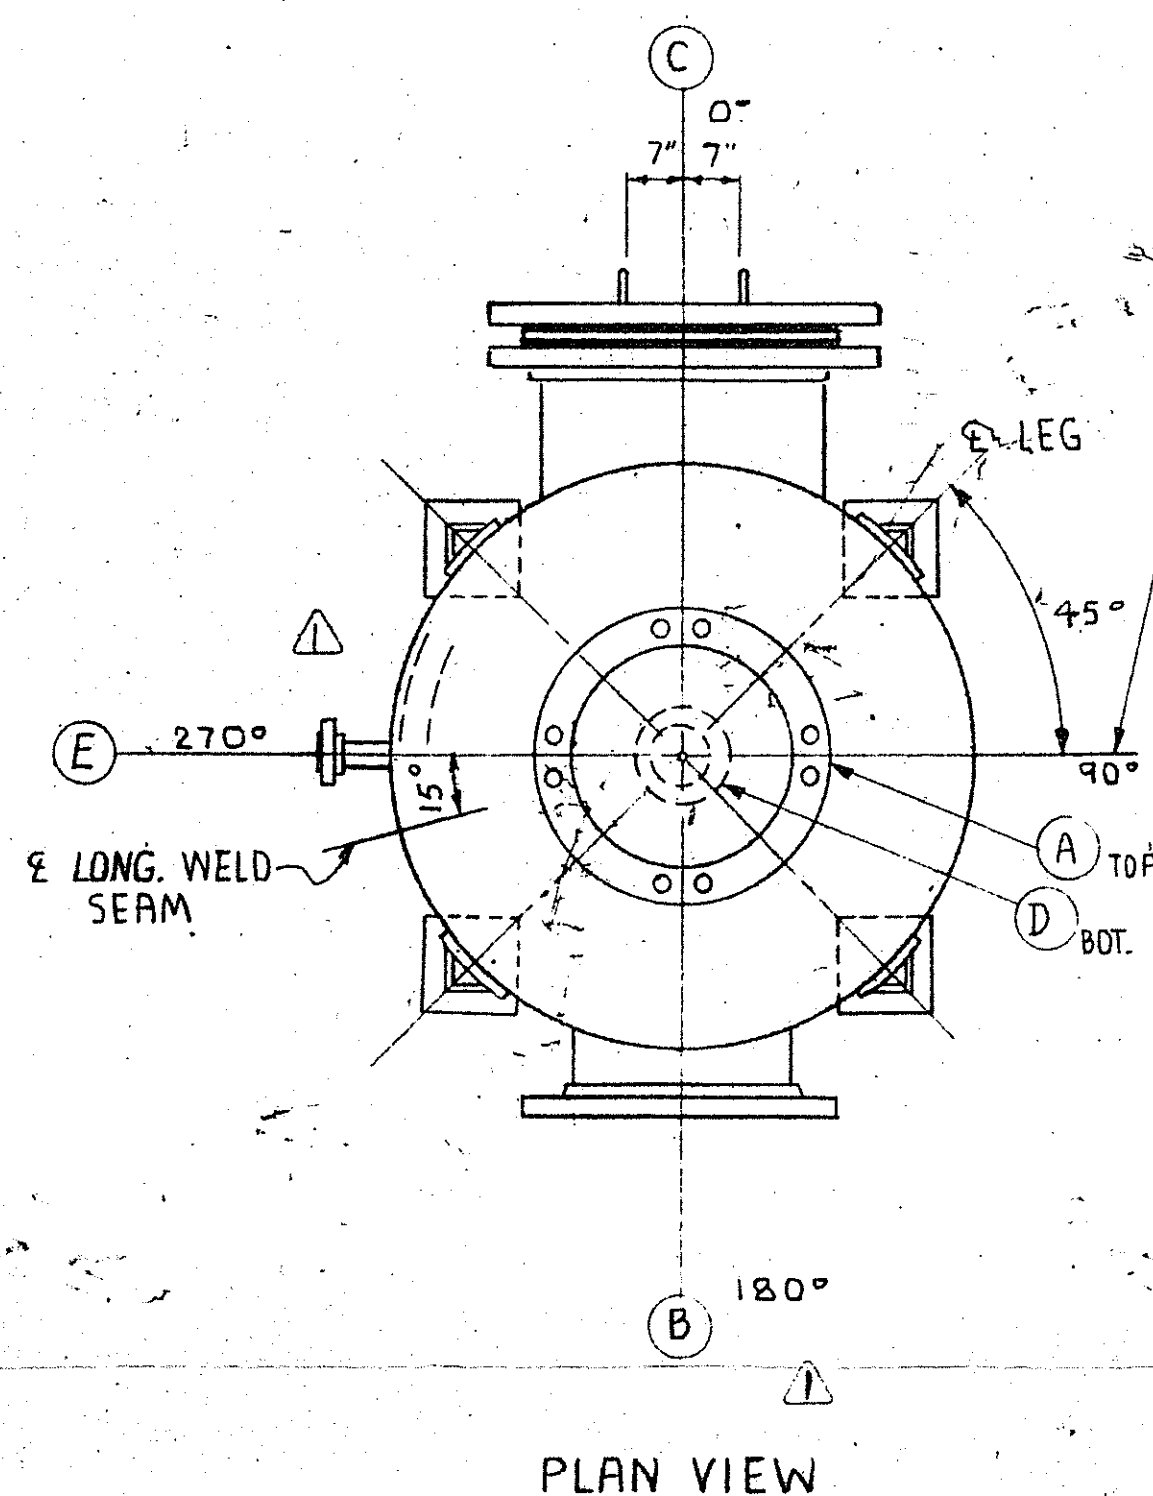


PLAN VIEW

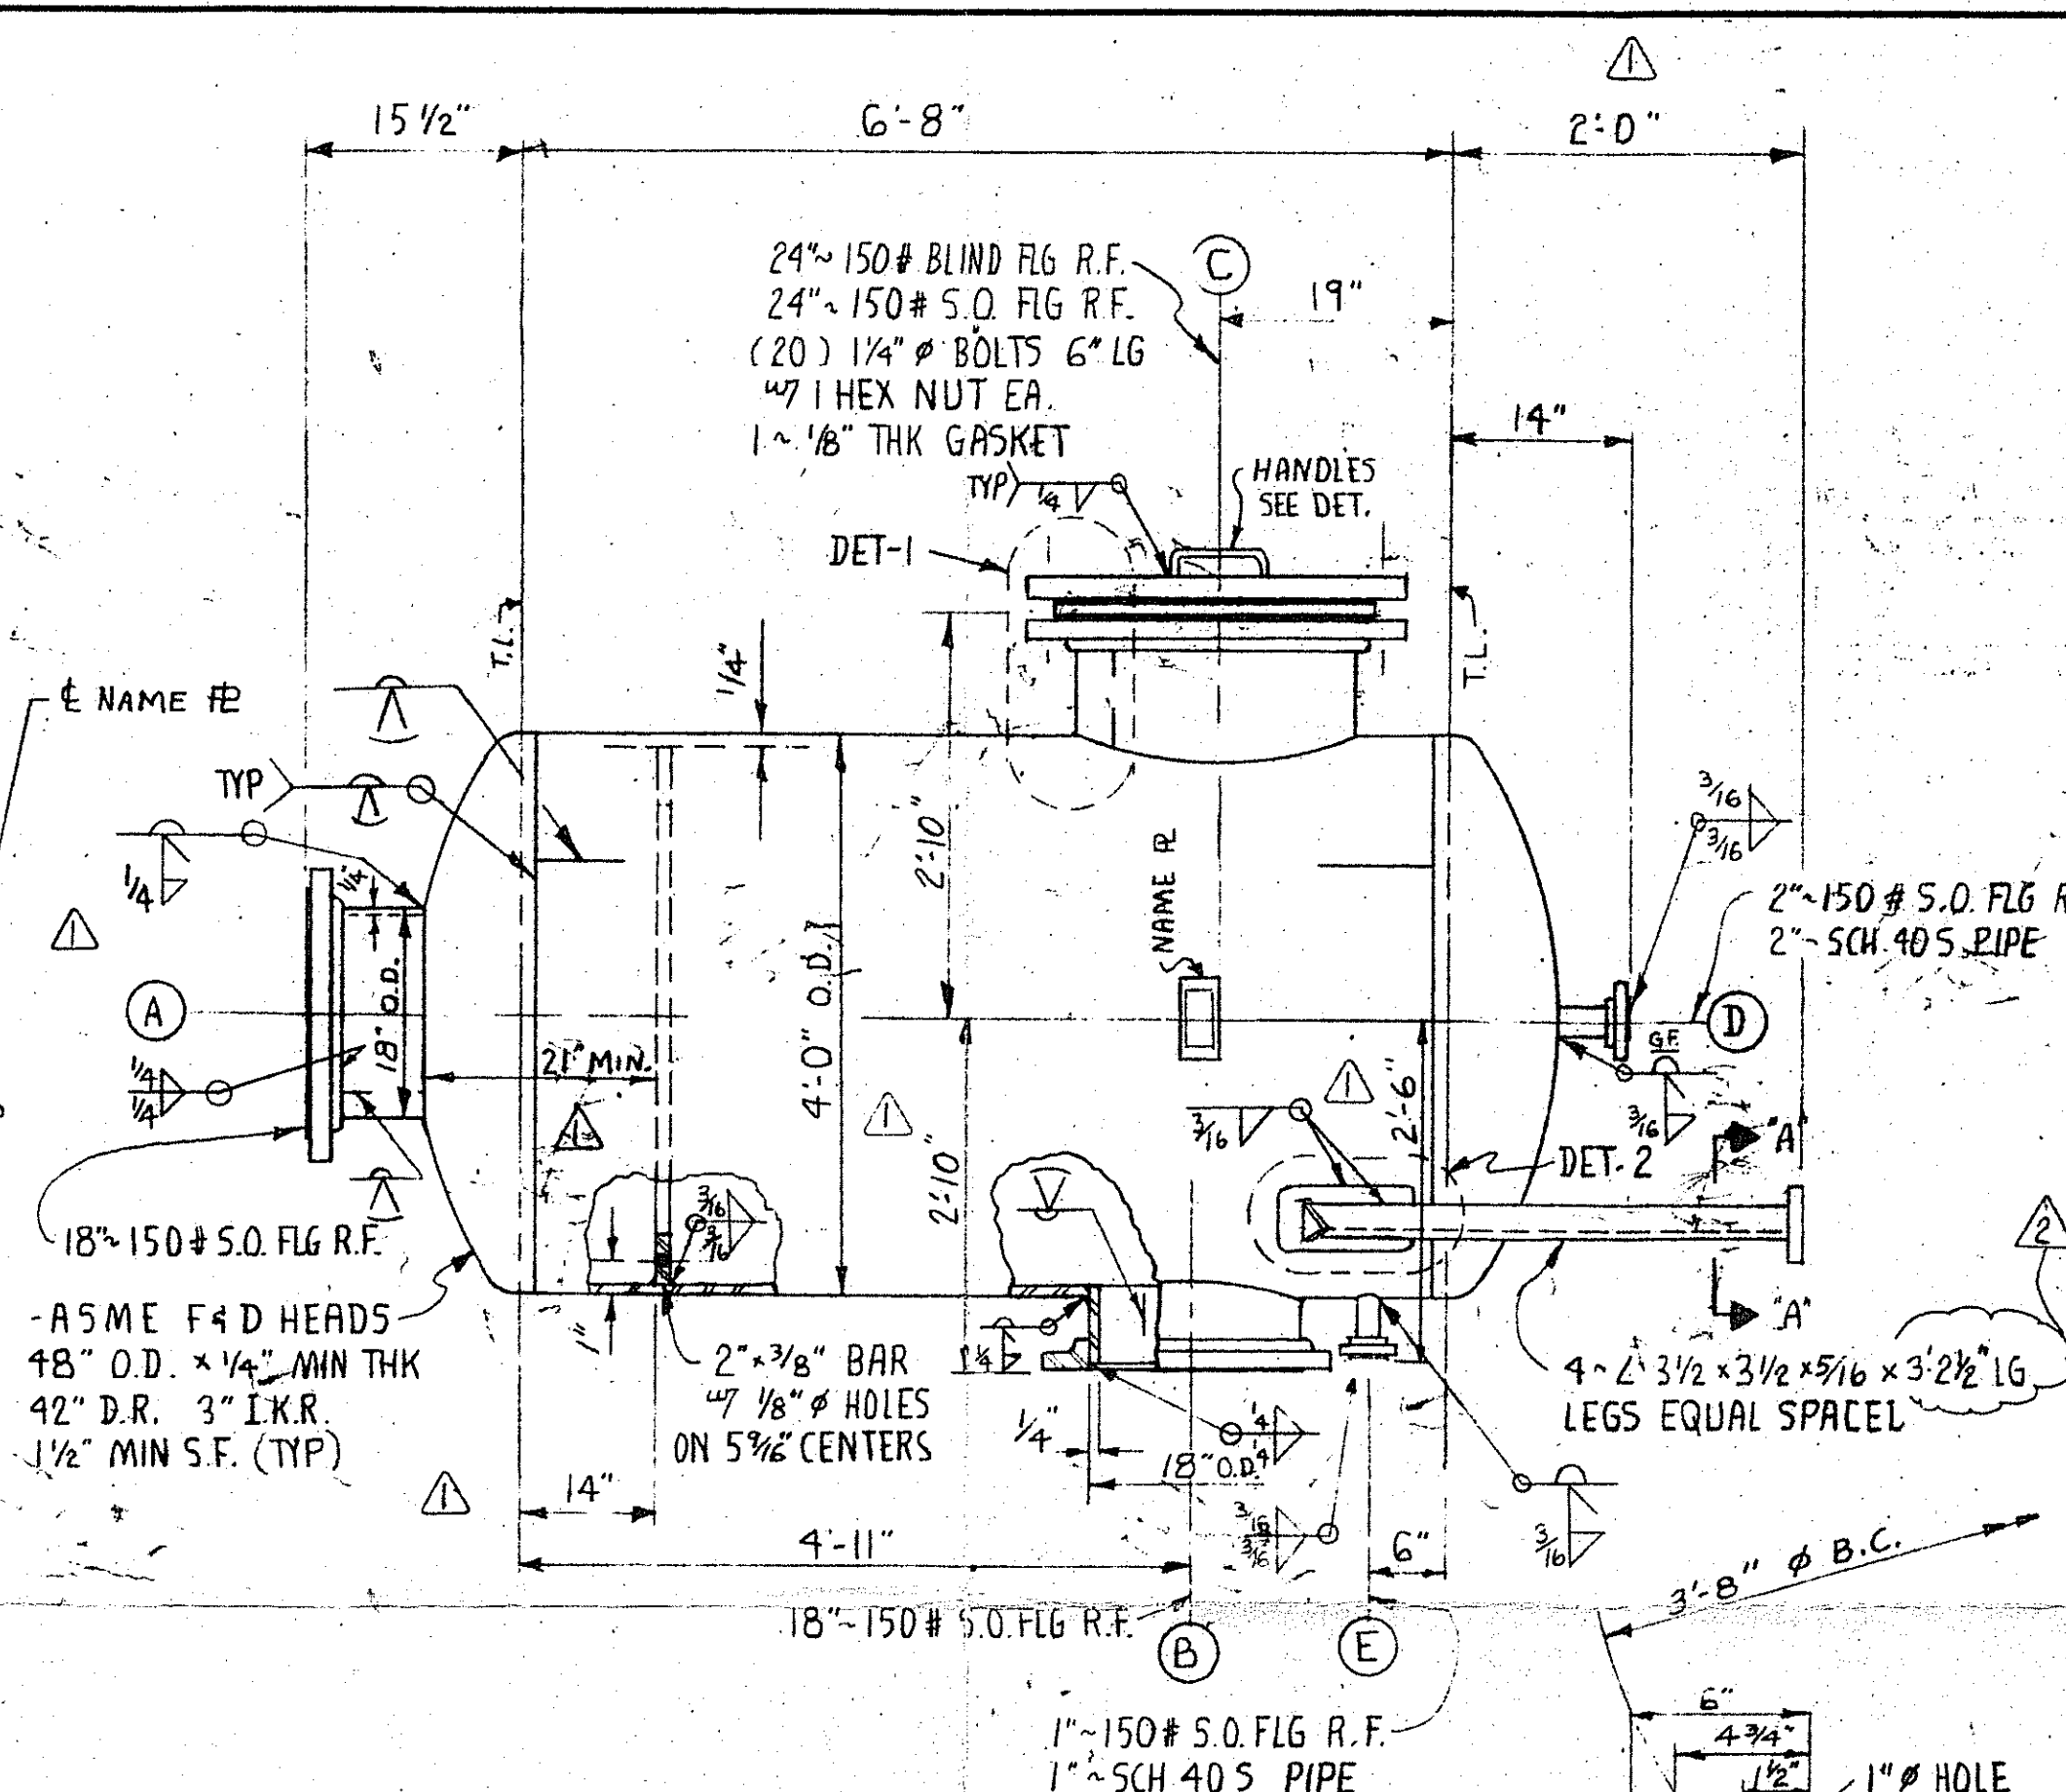


ELEVATION VIEW
DEMISTER KO POT
ONE REQ'D

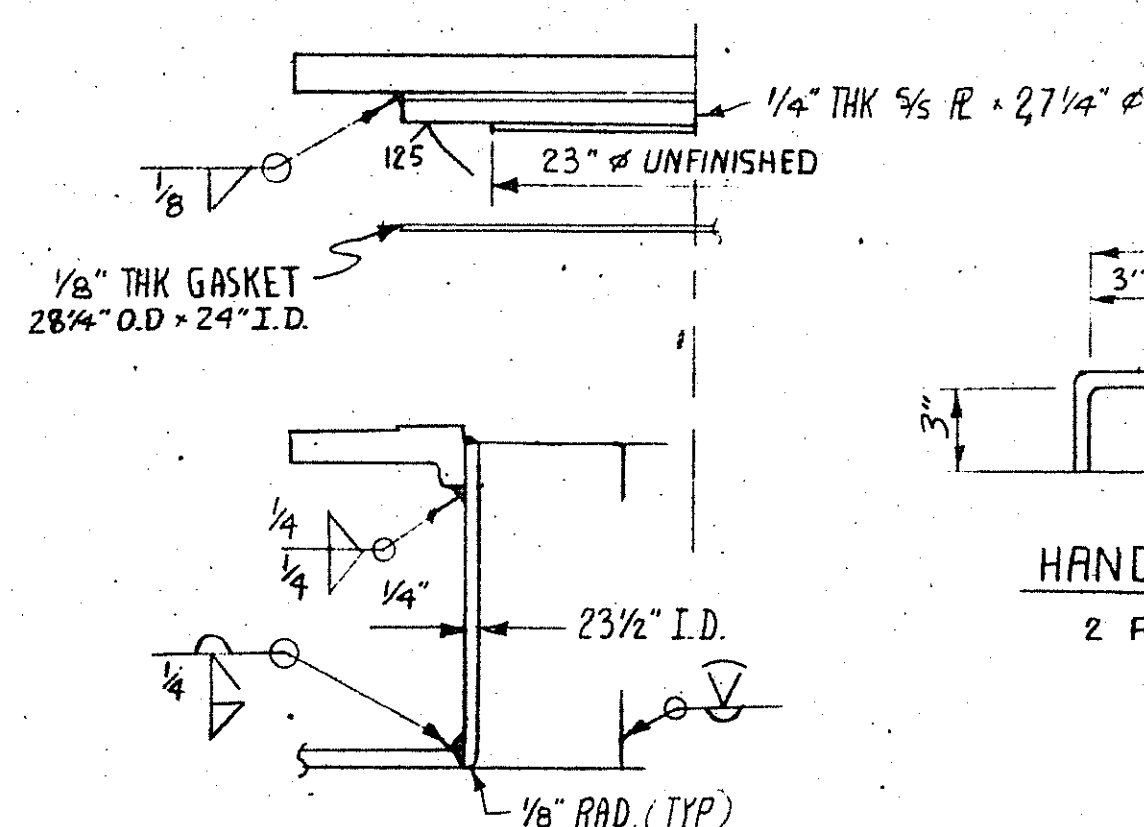

DET-1 NOZZ-C

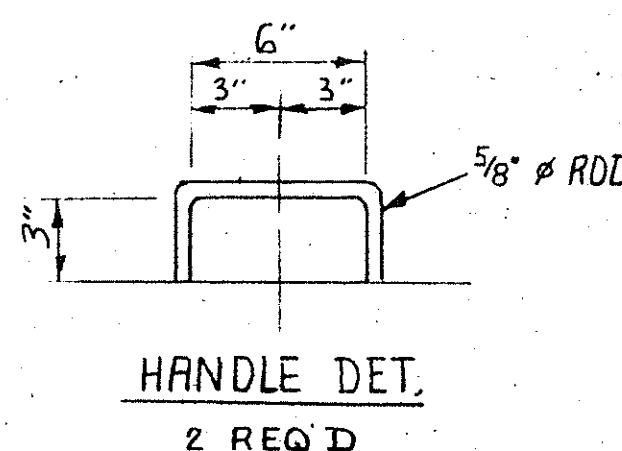

HANDLE DET.
2 REQ'D

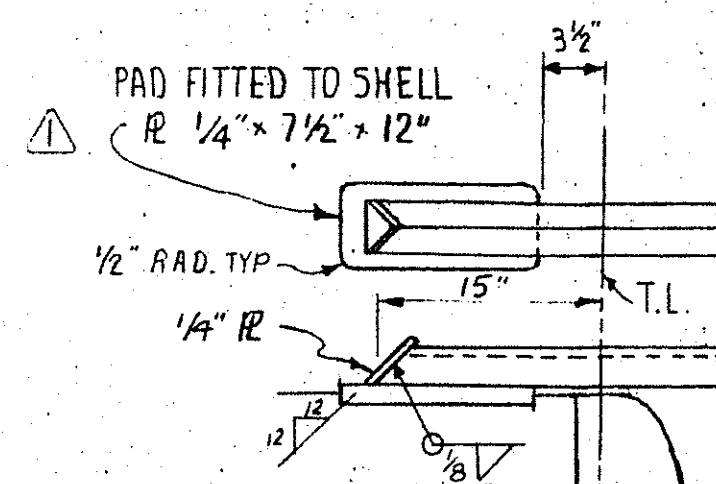

SECTION A-A

Mark	Quan.	Size	Rating	Type-Face	Service
E	1	1"	150#	S.O. FLG R.F.	OVERFLOW
D	1	2"	150#	S.O. FLG R.F.	LIQUID DRAIN
C	1	24"	150#	S.O. FLG R.F.	MANHOLE W/ BLIND
B	1	18"	150#	S.O. FLG R.F.	VAPOR INLET
A	1	18"	150#	S.O. FLG R.F.	VAPOR OUTLET

NOZZLE SCHEDULE

NO.	DR.	CH.	DATE	DESCRIPTION

REVISIONS

GENERAL SPECIFICATIONS

DESIGN, CONSTRUCT AND TEST IN ACCORDANCE WITH THE 1977 EDITION OF THE ASME CODE, SECTION VIII, DIV 1 AND SUMMER 78 ADDENDA.

INSPECTION: INS. CO. YES CUSTOMER: NO

ASME STAMPING YES

RADIOGRAPH SPOT X-RAY PER ASME CODE

HEAT TREATING NONE REQ'D

INTERNAL DESIGN PRESS. 15 PSI @ 100 OF

EXTERNAL DESIGN PRESS. 15 PSI @ 100 OF

EFFICIENCY: HEAD 85% SHELL 85%

CORROSION ALLOWANCE NONE

MAWP 15 PSI LIMITED BY DESIGN

SHOP TEST PRESSURE 22.5 PSI HYDROSTATIC

MATERIAL SPECIFICATIONS:

HEADS SA 240-T304

SHELL SA 240-T304

REINFORCEMENT

SUPPORTS A-36

FLANGES SA-105

NOZZLES: PIPE SA 312-T304 PLATE SA-240-T304

INTERNAL SA 477-T304

COUPLINGS

BOLTS/STUDS SA-193-B7

NUTS SA-194-2H

GASKETS COMPRESSED ASBESTOS

ESTIMATED SHIPPING WEIGHT 2300 #

WEIGHT FULL OF WATER 8,250 #

TAG ITEM 19-V-34R

NO. REQ'D ONE

Continental
Boiler Works, Inc.
5620 West Park Avenue Saint Louis, Missouri 63110

DEMISTER KNOCK OUT POT
19-V-34R #110377

FOR CLARK OIL AND REFINING CORP.
LOCATION BLUE ISLAND, ILLINOIS

DR T.L.S. APPD. X SCALE NONE CUSTOMERS NO. 55779

DATE MAY 24/79

ORDER NO. H-2519 SHEET NO. 1 TOTAL 1 DRAWING NO. 6353-F. 2