
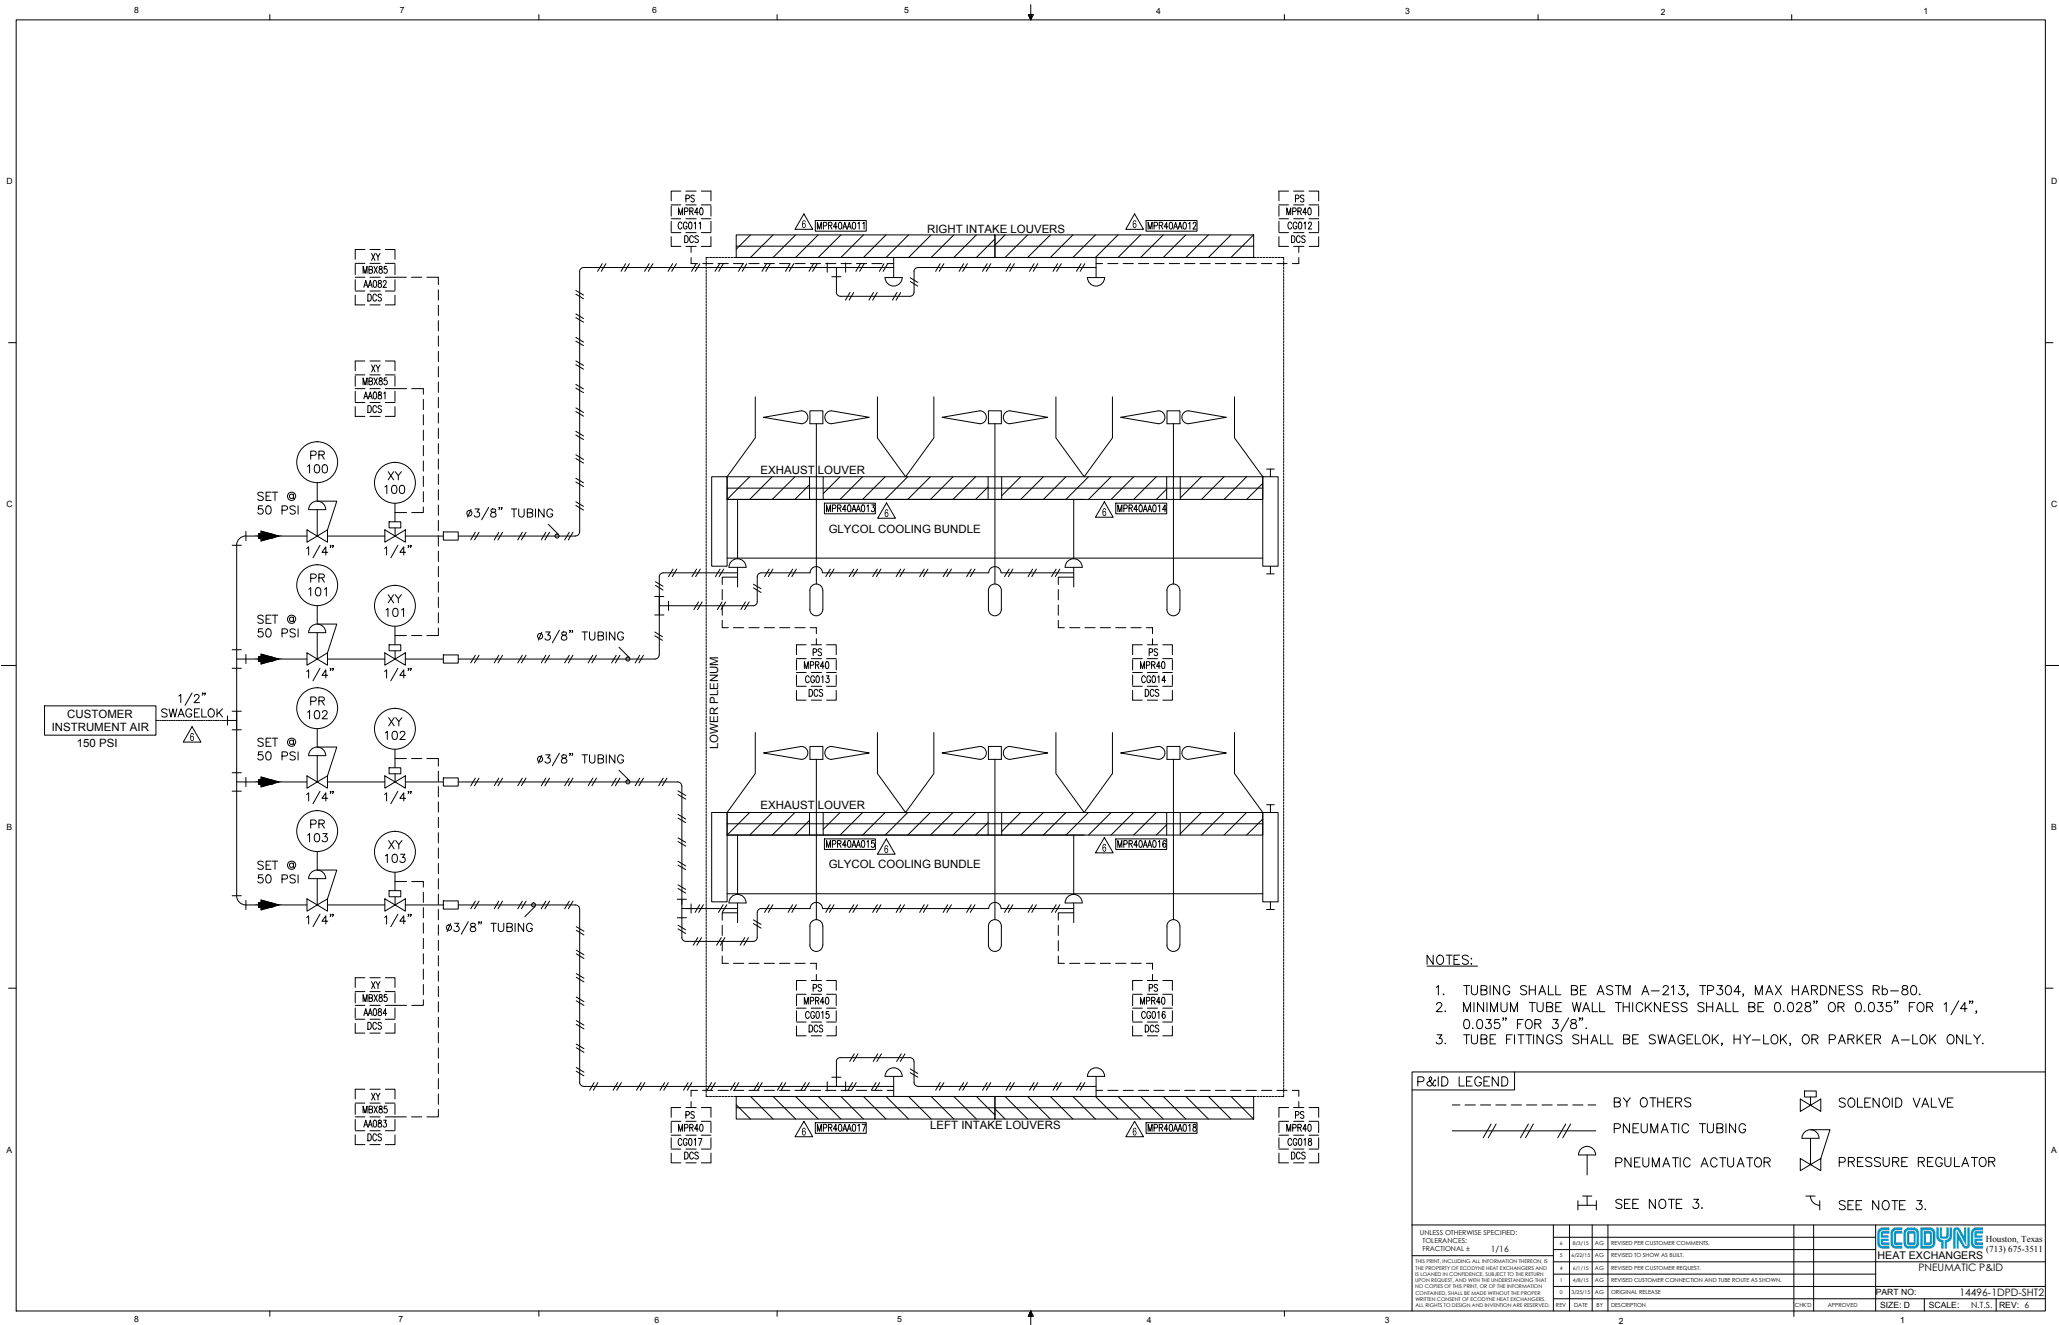



RELATED DRAWINGS

14496-001 SH1 1 GENERAL ARRANGEMENT

14496-001 SH1 2 ANCHOR BOLT PLAN

UNLESS OTHERWISE SPECIFIED: TOLERANCES: FRACTIONAL = 1/16				 Houston, Texas (713) 675-3511			
THIS PRINT INCLUDING ALL INFORMATION THEREON IS THE PROPERTY OF ECODYNE HEAT EXCHANGERS AND IS LOANED TO YOUR FIRM. IT IS TO BE USED ONLY FOR THE PROJECT AND NOT BE REPRODUCED OR COPIED IN ANY MANNER WITHOUT THE WRITTEN CONSENT OF ECODYNE HEAT EXCHANGERS. ALL RIGHTS TO DESIGN AND INVENTION ARE RESERVED.				P & ID DRAWING			
REV	DATE	BY	DESCRIPTION	PART NO: 14496-IDPD-SHT1			
1	02/10/16	AG	REVISED SHEET 2 PER CUSTOMER COMMENTS.	SIZE: D SCALE: N.T.S. REV: 8			
2				1			



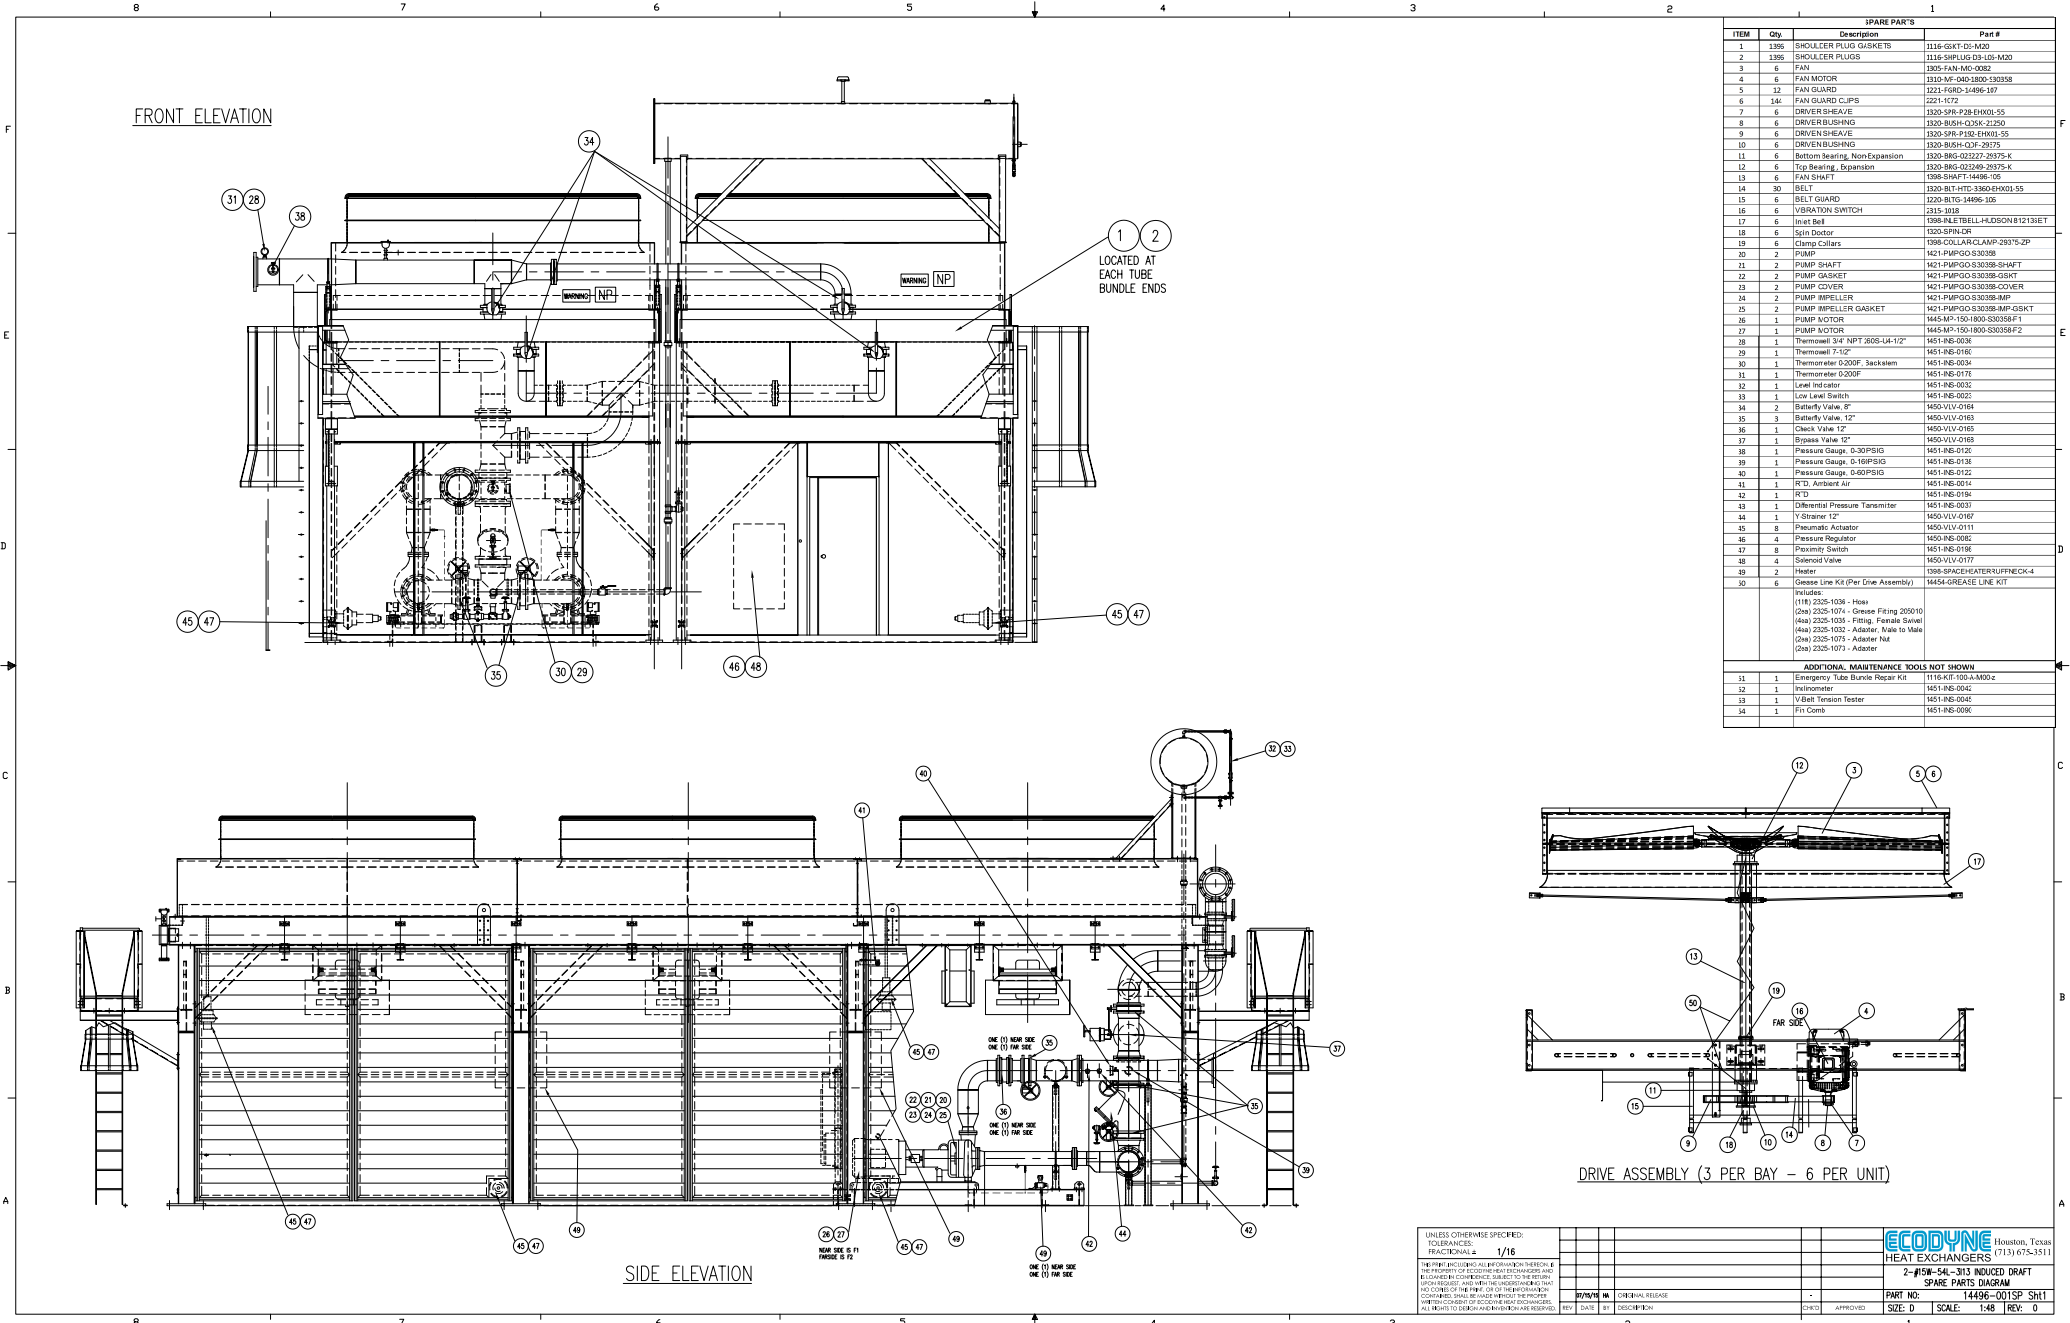

SPARE PARTS			
ITEM	Qty.	Description	Part #

ADDITIONAL MAINTENANCE TOOLS NOT SHOWN

