


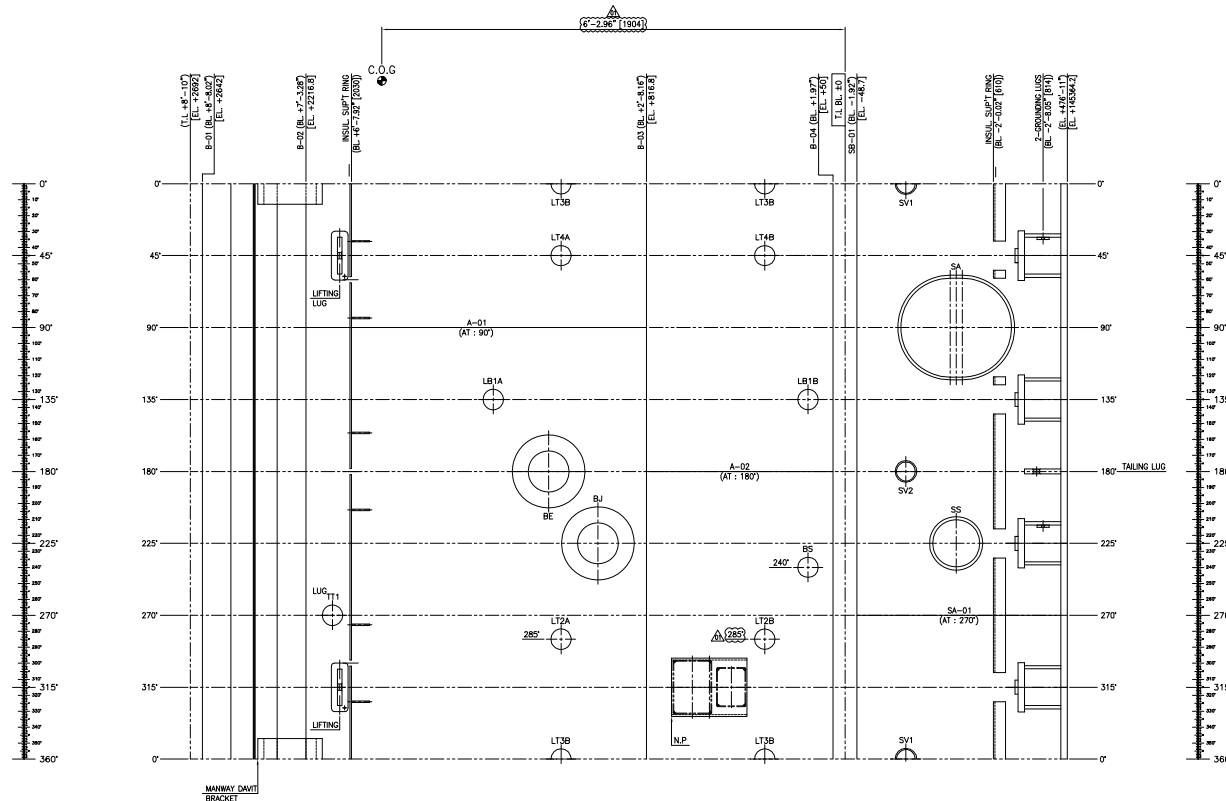

KBR	
ACCEPTANCE FOR ENGINEERING USE	
ACCEPTED	(Date 11)
ACCEPTED WITH COMMENTS	(Date 11)
NOT ACCEPTED	(Date 11)
NOT REVIEWED	(Date 11)
ACCEPTANCE DOES NOT RELIEVE SUPPLIER FROM FURNISHING MATERIAL IN CONFORMANCE WITH ORDER. REFER TO SPEC FOR FULL DEFINITION OF ACCEPTANCE CONDITIONS.	
DISCIPLINE	BY
DATE	DATE

FOR APPROVAL
2011.10.14
SUNGJIN GEOTECH CO., LTD.

ASME CODE STAMPED WORK (U)

12. Oct. '11	REVISED AS COMMENTS	B.M. ENG	D.H. HYUN	H.C. JUN
18. Aug. '11	ISSUED FOR APPROVAL	B.M. ENG	D.H. HYUN	H.C. JUN
REV.	DATE	DESCRIPTION	DRWN	CHKD.
PROJECT:				
Kemper County IGCC Unit 1 Project				
KBR Engineering services by KBR Technical Services TBPE Reg. No. F-2397				
SOUTHERN COMPANY Southern Company, Inc.				
SUNGJIN SONGJIN GEOTECH CO., LTD ULSAN, KOREA				
TITLE: DR2080 AGR FLASH GAS COMPRESSOR KO DRUM DEVELOPMENT DRAWING (2/2)				
ANGLE 3	SCALE	REV'D NO.	P.O. NO.	SHEET NO.
1/9	1	1	MPC17984-0001	2 of 2
PLANT	SET	NO.	NO.	NO.
Kemper County	SET	NO.	SGT11-SP11-DR2080-012	11SP11
DRAWING NO.	NO.	NO.	NO.	NO.
B1	MM87645	NO.	NO.	NO.

SGT JOB NO. : 11-SP-11

MM87645 A

Plant: Kemper County SONGJIN GEOTECH
 Southern Company Generation
 SGT11-SP11-DR2080-012 SH 2 Rev: 1
 PO: MPC17984-0001