


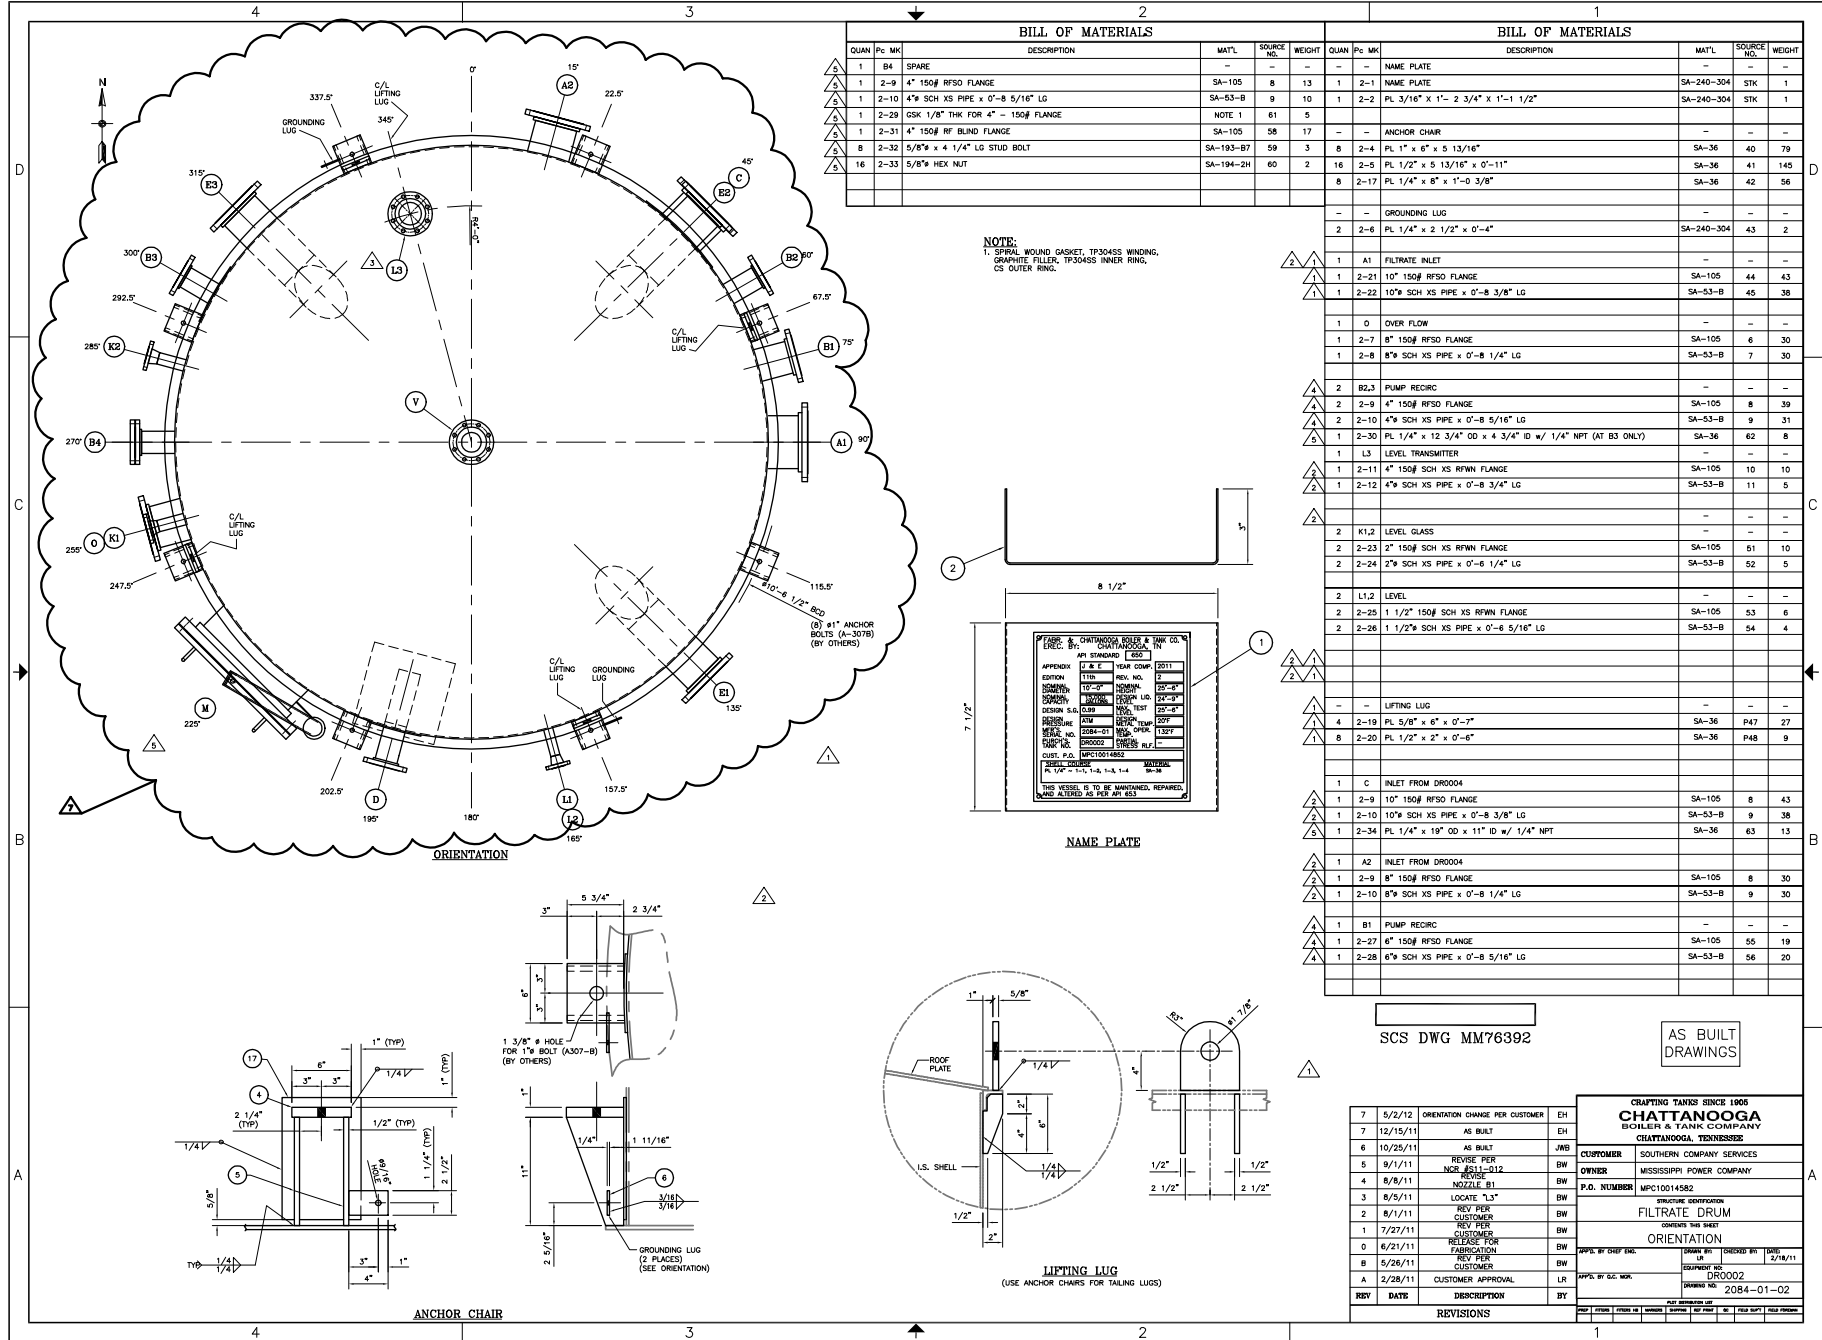

Southern Company Generation

MM76392

Kemper County

Unit 1

CHATTANOOGA BOILER & TANK CO. PO: MPC10014852

2084-01-02 Rev: 7

IGCC - GASIFIER - FILTRATE DRUM - ORIENTATION - EQUIPMENT NO DR00

Approved