
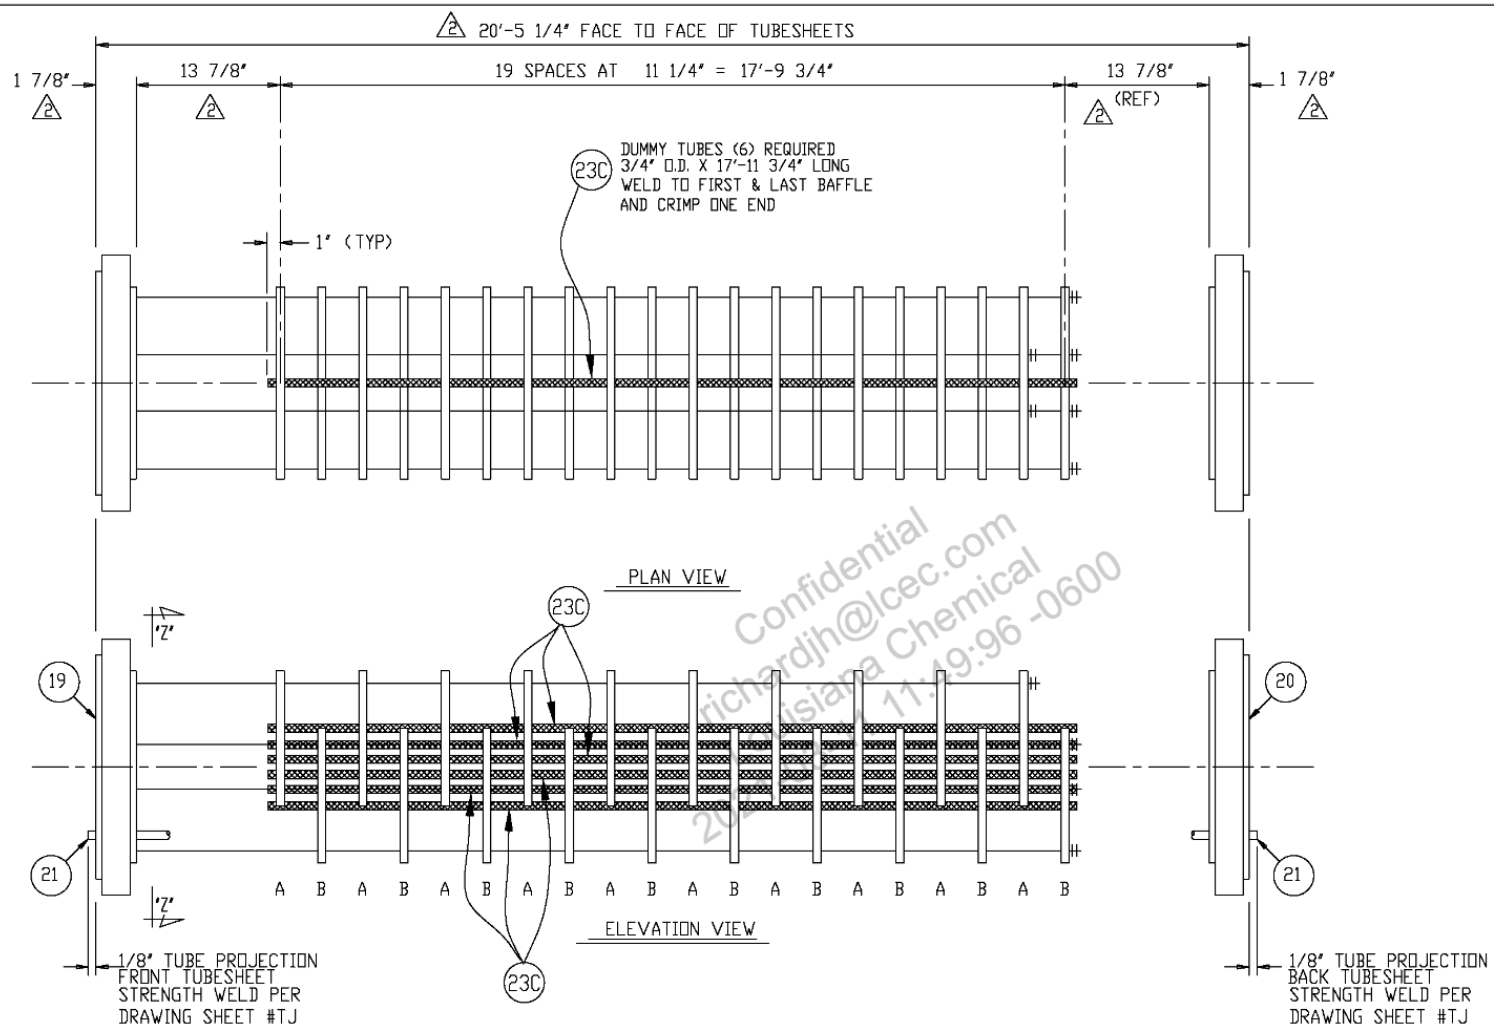


REQ'D.	"A"
2	18'-2" $\triangle$
6	19'-1 3/8" $\triangle$

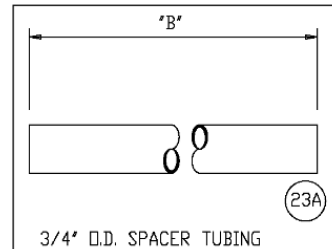

REQ'D.	"B"
6	13 3/4" $\triangle$
2	25" $\triangle$
76	11"
36	22 1/4"

NOTES:

- 1) FOR SECTION AND VIEW DETAILS SEE DRAWING SHEET #BF.
- 2) FOR DUMMY TUBE TO BAFFLE WELDING USE WPS #S/P8-8

2	REVISED PER CUSTOMER REQUEST	BR	PI	01/02/14
1	REV PER CUST. COMMENTS	RC	PI	12/27/13
0	RELEASE FOR FAB/CUST. REVIEW	BR	PI	12/09/13
NO.	REVISIONS	BY	CHK.	DATE CHK.

CUSTOMER: INVISTA
OHMSTEDE JOB NO.: 328446
P. O. NO.: 3801214850/66416553 $\triangle$
ITEM NO.: 5001-7017-04
SERVICE: SOUTH RECYCLE COLUMN BOTTOMS COOLER

BUNDLE DETAILS

OHMSTEDE

DRAWING NO.
328446-BU