




- 1) Fit the Nozzle length between X-4480 and X-4450 during the fabrication!

[illegible][illegible]

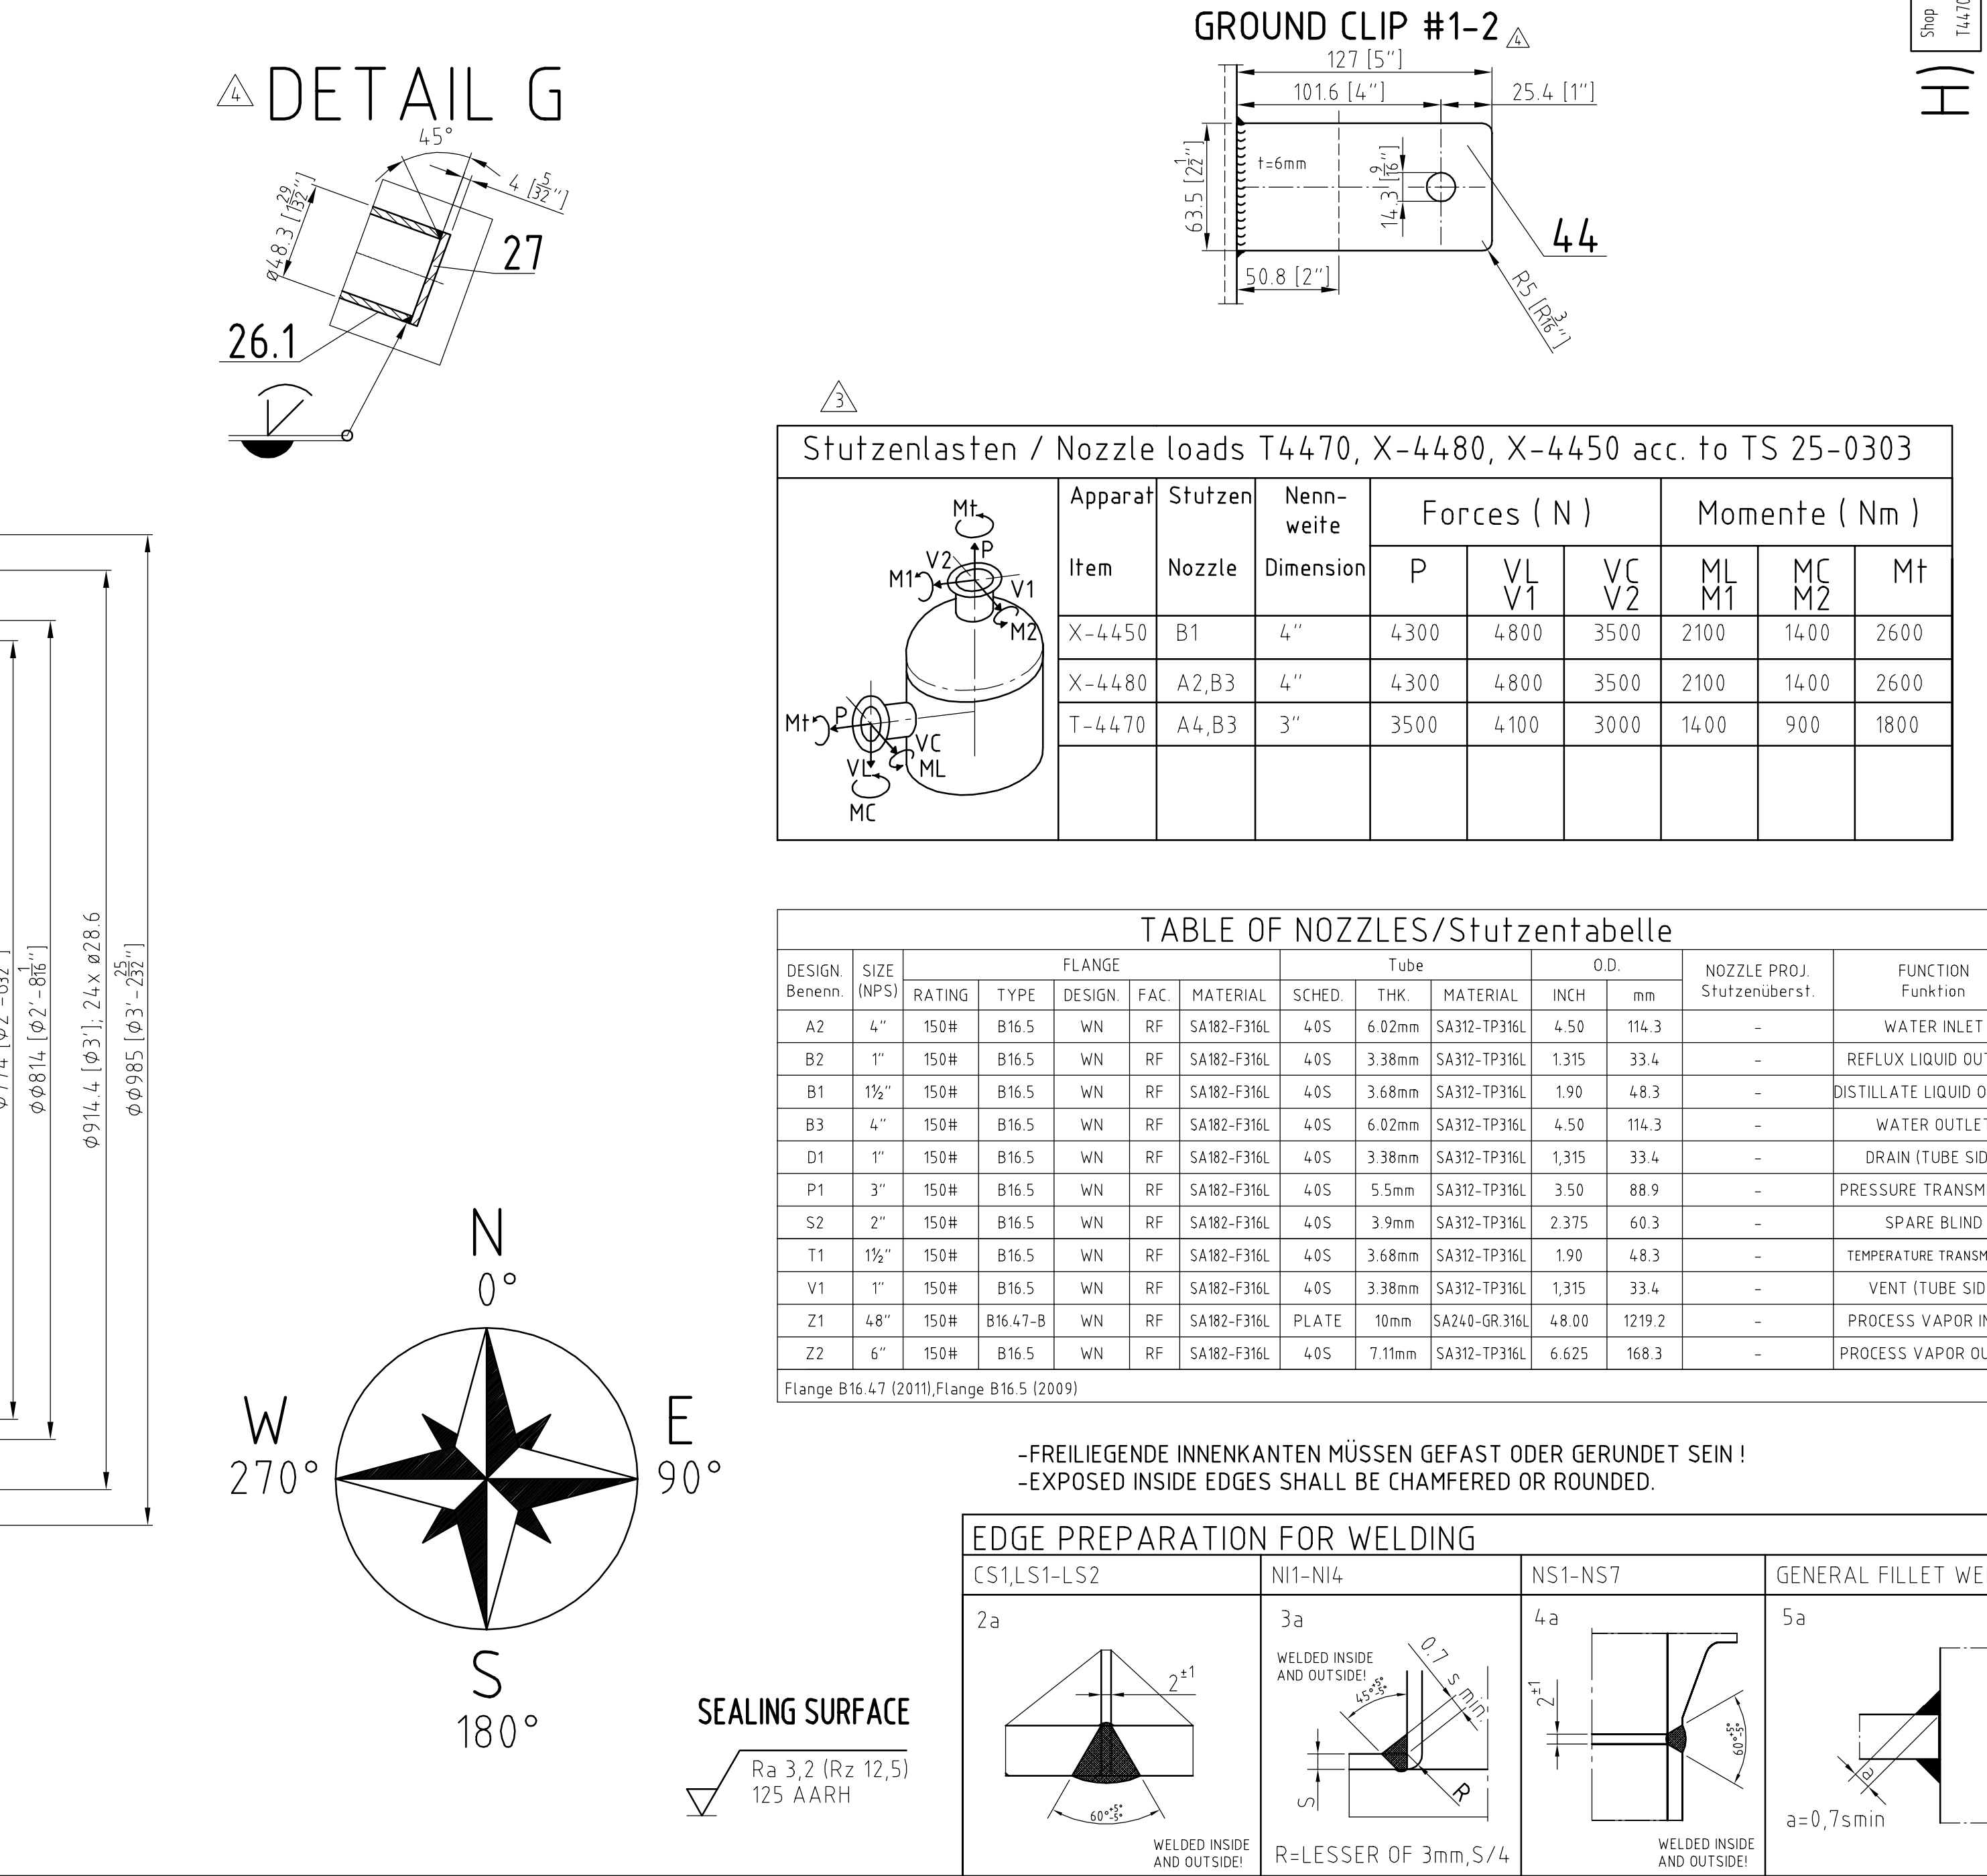

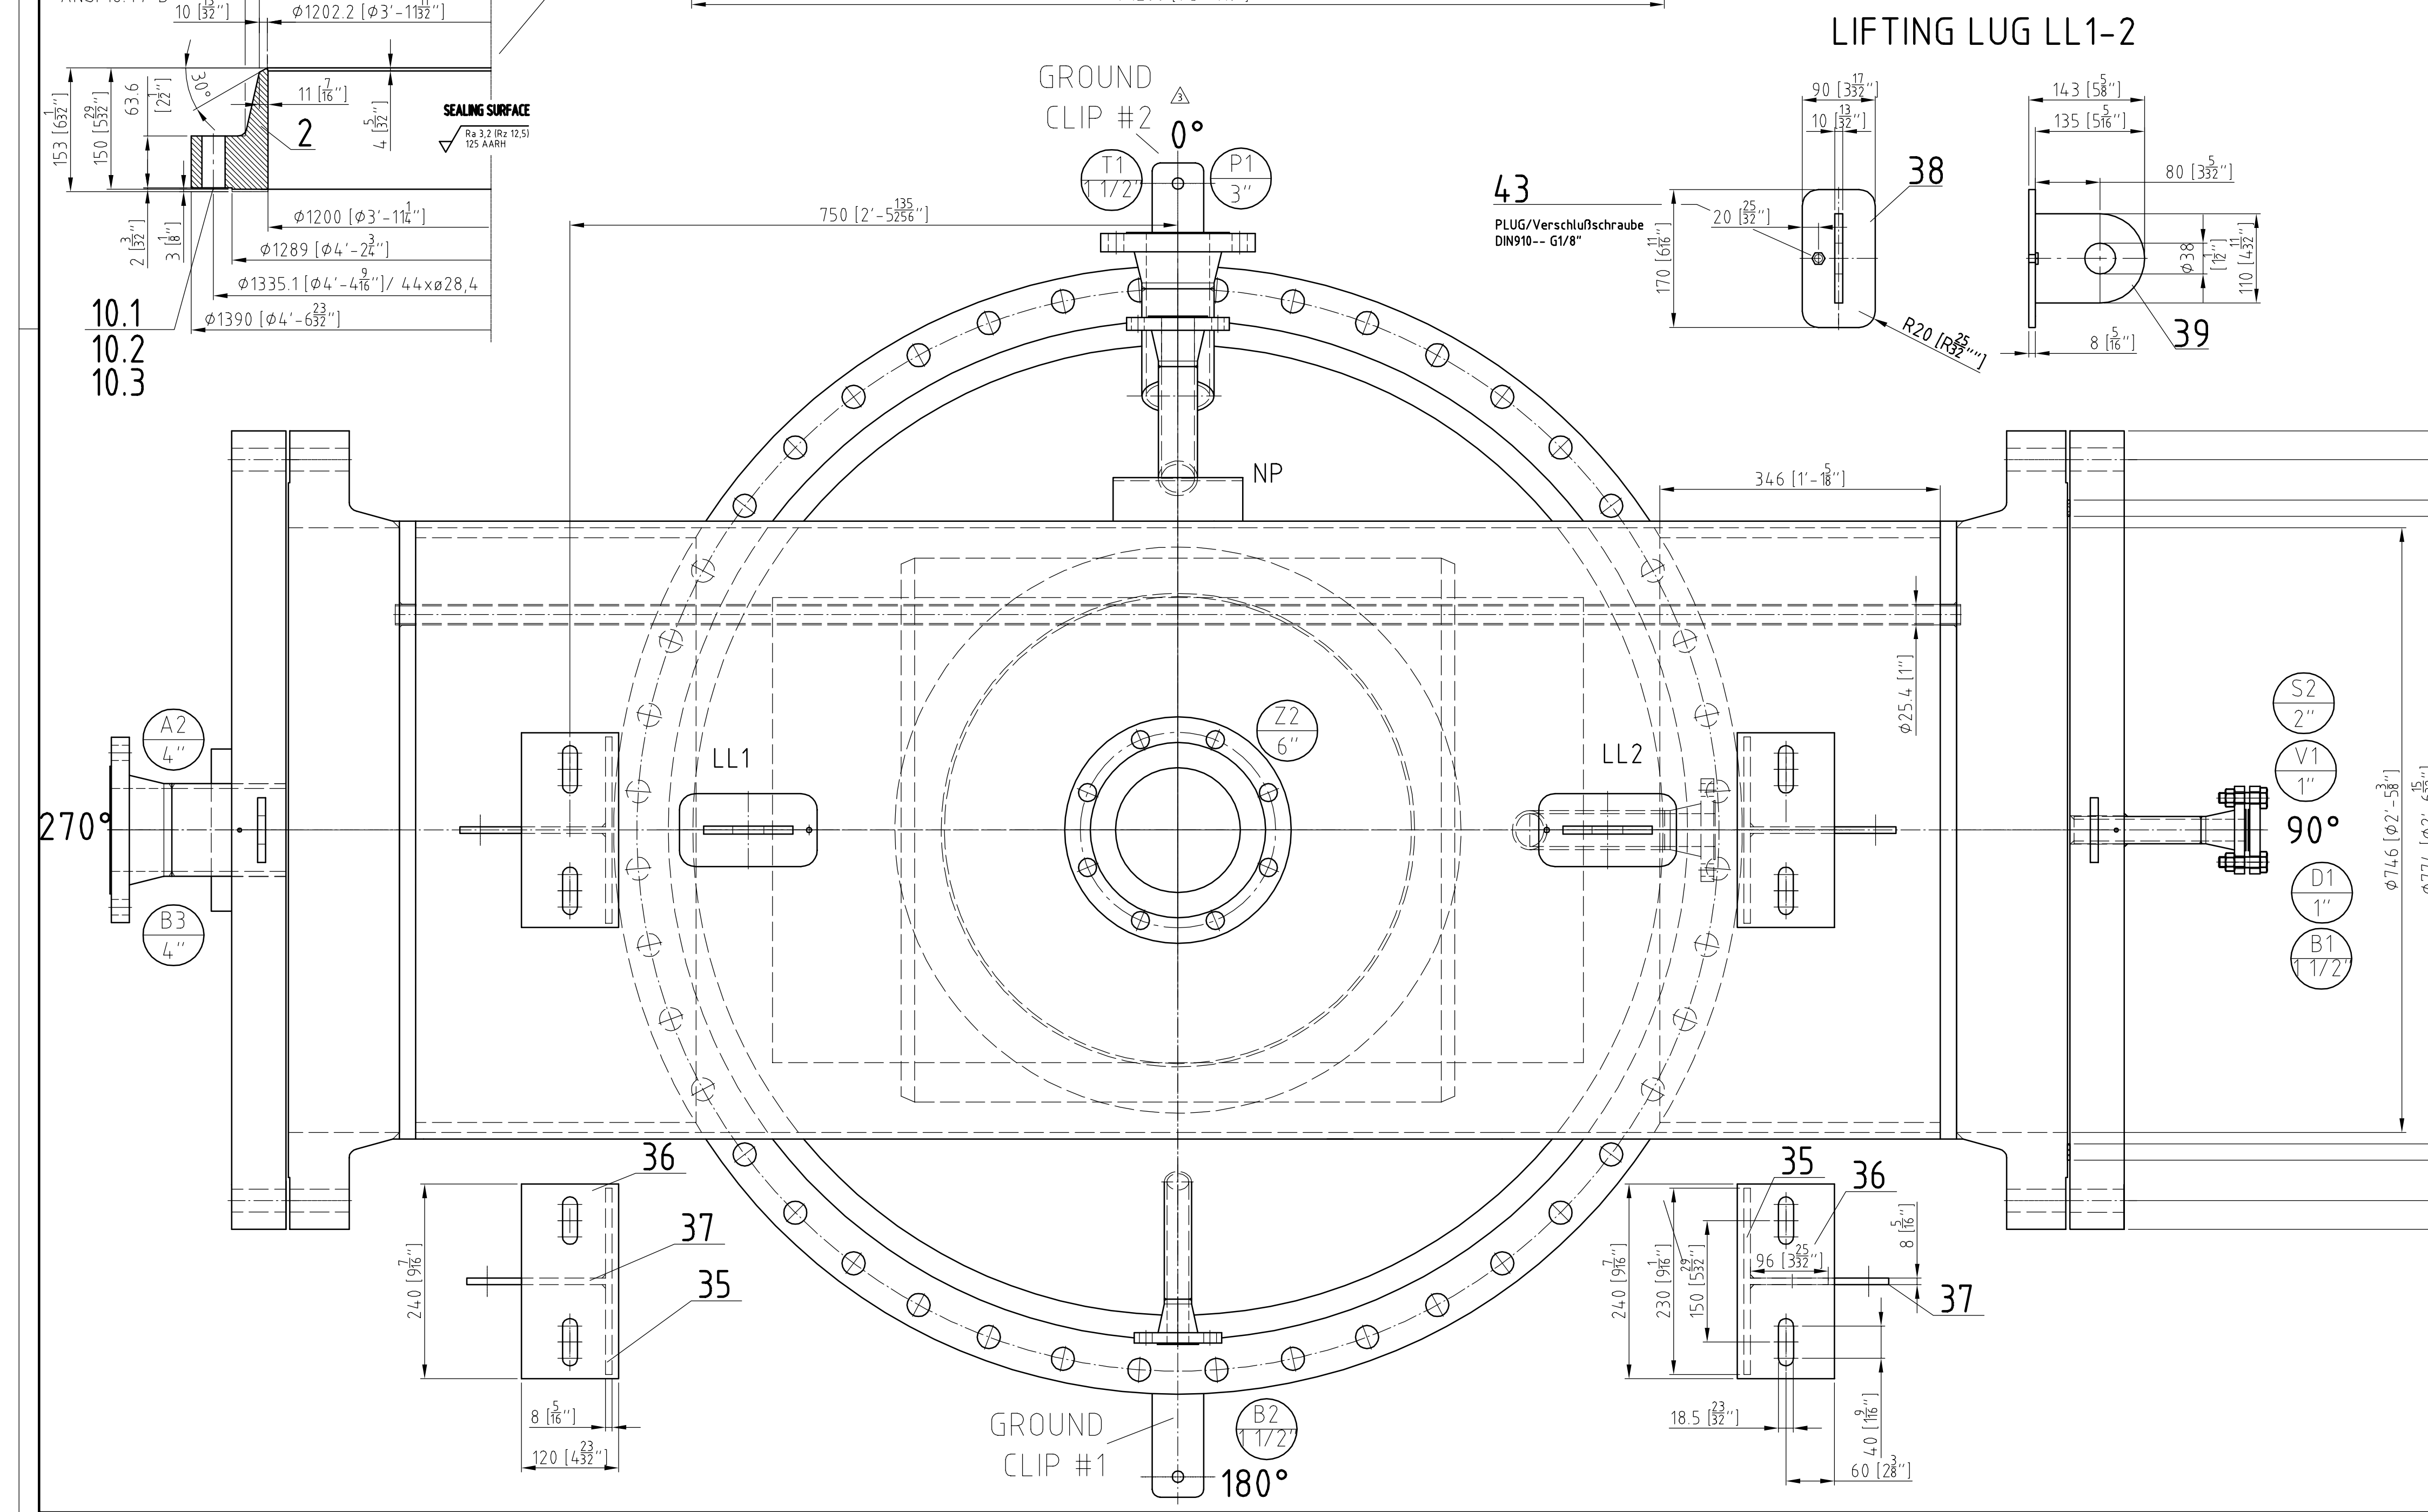



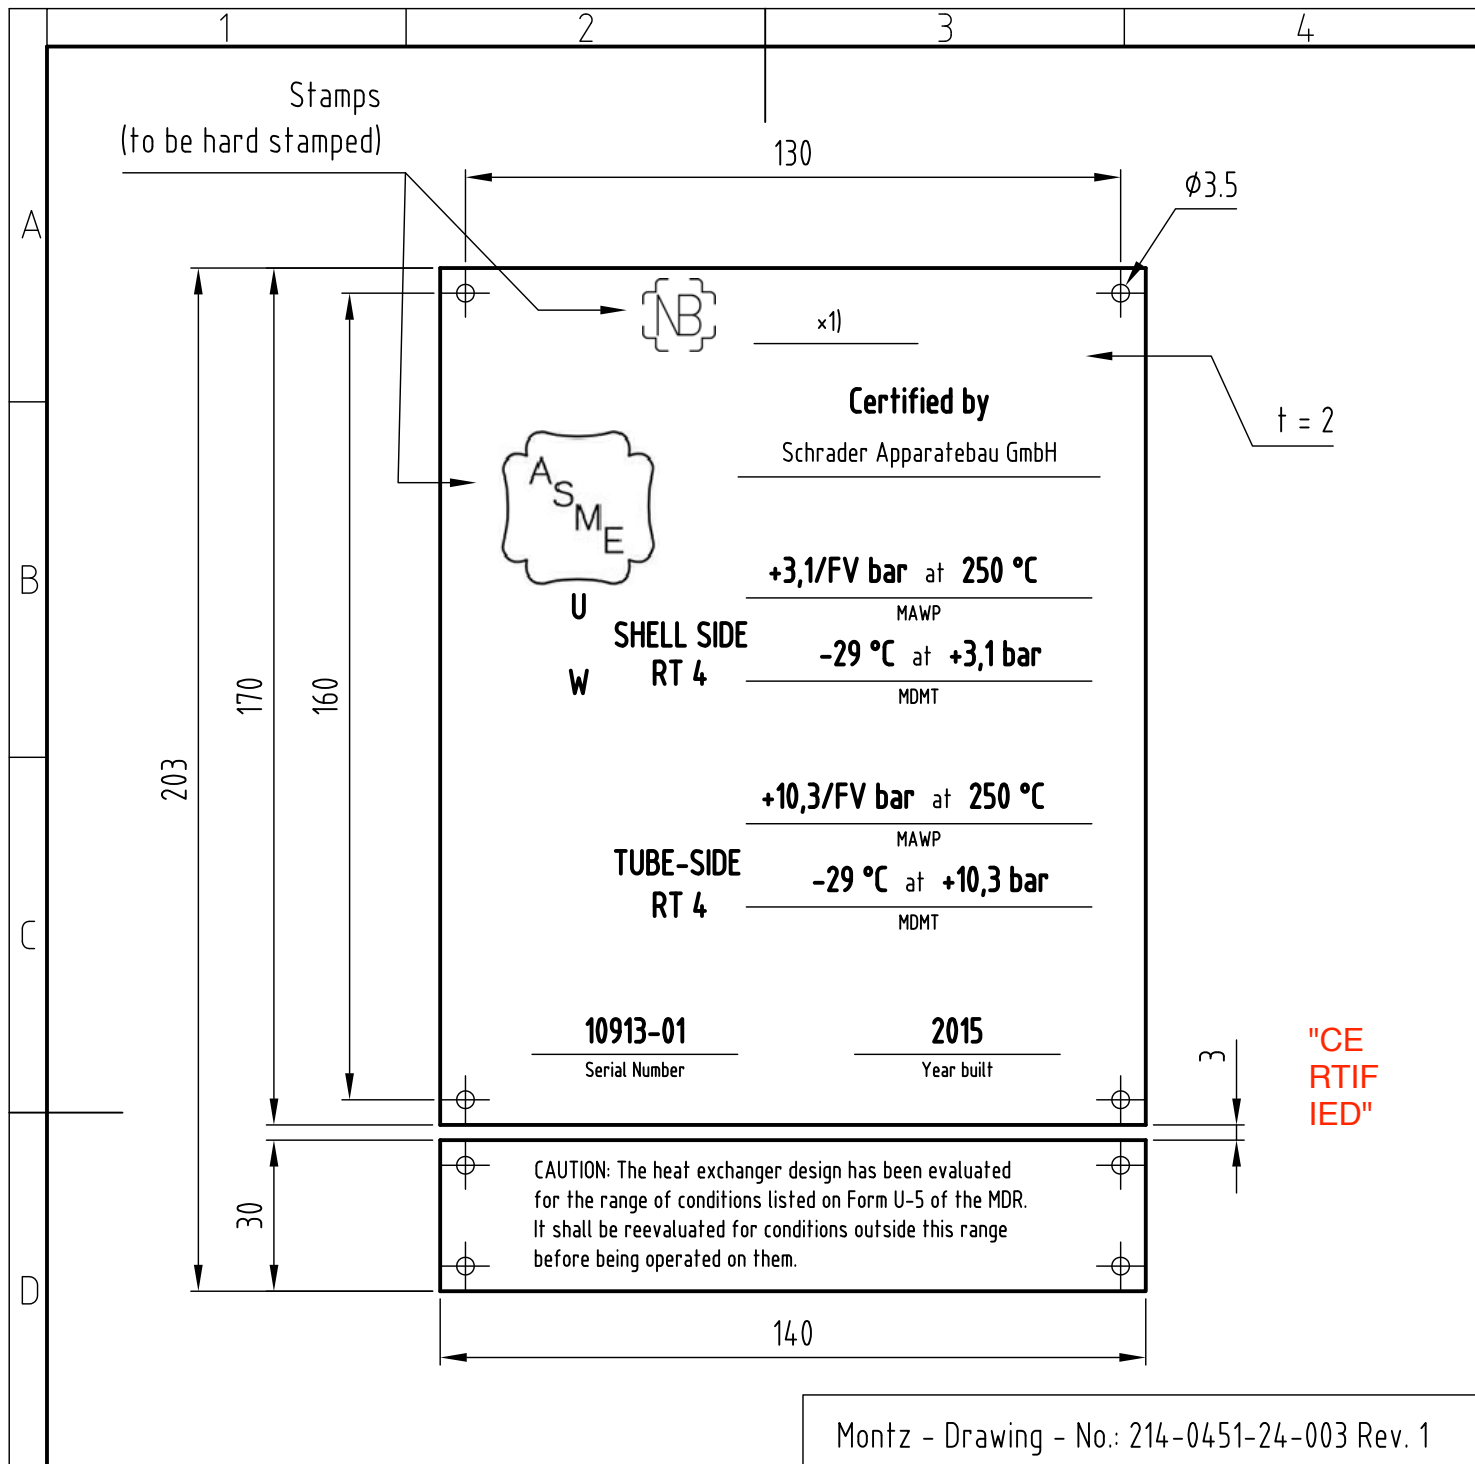

Montz - Drawing - No.: 214-0451-24-003 Rev. 1

	Change radiographic examination	13.11.2015	Haertel
	Art der Aenderung / kind of revision	Datum	Name
Aenderungen / revisions			
CAD	Zeichng. darf nicht manuell geaendert werden		Schutzvermerk n. DIN ISO 16016 beachten protection mark acc. to DIN ISO 16016
Auftrag Order	A15 / 10913		<b>SCHRADER</b> <b>APPARATEBAU GMBH</b> <small>Schleebergstr. 12 • D-59320 Ennigerloh  Tel.: +49 (0) 2524 266 0 • Fax: +49 (0) 2524 266 50  E Mail: info@schrader.de • Internet: www.schrader.de</small>
Zchnng. Drawg.	10913-01099	Revision 1	
Ers. fuer ers. durch		Maßstab scale 1:1.5	
	Datum/date	Name	Benennung/Denomination
gez./drwd.	08.10.2015	Haertel	<b>Name Plate</b>
gepr./appr.	09.10.2015	Poppenborg	Material : SA240 - 304L
			Project :
			Blatt sheet 1 von/of 1 A4