

5116-7305-5

***** EQUIPMENT SPECIFICATIONS *****

RECORD # 2574
 ID #= 5116-7305-5 ISO? N ISO TEST EQ? N LOC ? N
 DESC: TANK; DECANTER FEED PUMP TANK CRIT LEV: SPECS : 9
 RM: Y HISTORY: 9
 AREA: MMA SUB AREA: REFCOL SYS: WRT WD ? Y SPR PTS: 9
 MANUF: KOPETZ, S. R. COMPANY, INC. LOC ID: ADL COM: 9
 FAA : 22035116 ORG PRICE: SERVICE: ORGANIC LIQUID
 MODEL NO: INST COST: ENGR #:
 SER NO: 89260 PROJ/WD : 6432 SPARE/EN:
 HIST RET: NONE? N 5 YR? Y 10 YR? N INFIN? N P.O.: BLDG: MMA

TYPE : VERTICAL INSUL CODE :
 SIZE : 7' X 4';FT PAINT CODE :
 CAPACITY : 740;GAL POSITION :
 WEIGHT: EMPTY : 2800;LBS JACKET TYPE :
 FULL (H2O) : 9000;LBS DESIGN CODE : ASME
 PROCESS FLUID: SECTION: 8 DIV: 1 YR: 1987
 SHELL : ORGANIC LIQUID STAMPED: STRESS RELIEVED:
 JACKET : NAT'L BOARD NO:
 GASK CD: SHELL: G-58 GASK CD: J'CKT:

DESIGN: SHELL JACKET
 TEMP : 250;DEGF
 PRESS : 15;PSIG
 TEST : 30;PSIG

OPERATING: SHELL JACKET
 TEMP :
 PRESS. :

	POS	MATERIAL SPEC	MATERIAL	SPECIFIED CORR THICKNESS ALLOW
HEAD 1	: TOP	SA-240	316L SS	1/8"
HEAD 2	: BTM	SA-240	316L SS	1/8"
SHELL 1	:	SA-240	316L SS	1/8"
SHELL 2	:			
J'CKT HD	:			
J'CKT SHEL:				
SHELL NOZZ: ALL		SA-312	316L SS	1/8"
J'CKT NOZZ:				

SPECIAL FEATURES:

ROOF:
 TYPE :
 MATL :
 CORR ALLOW:
 LOAD :
 TRAYS:
 SPRAY NOZZLES:
 MODEL NO :
 NO OF :
 SIZE :

TYPE :
 MATL :
 NO OF :
 WEIGHT :
 CORR ALLOW :
 BAFFLES :
 TYPE :
 MATL :

GEAR BOX :
 MANUF :
 MODEL NO :
 RATIO :
 OUTPUT SPEED :
 ROTATION :
 LUB : TYPE :
 CAPACITY :
 FREQUENCY :
 WEIGHT-TOTAL :
 BLADE/IMPELLER :
 MATL :
 SHAFT MATL :

TRACING :
 PRESS :
 TYPE :
 BOTTOM :
 CORR ALLOW :
 SLOPE :
 ANCHOR BOLTS :
 NO :
 SIZE :
 DRIVER :
 HF/RPM :
 ROTATION :
 FRAME :
 CPLG BORE :
 PROCESS SEAL/PACKING :
 TYPE :
 MANUF :
 RING QTY :

QUANTITY :
 PITCH :

INPUT SHAFT :
 SIZE :
 KEYWAY :
 SLEEVE SIZE :
 COUPLING :
 MANUF :
 SIZE :
 BORE :
 GREASE :


OUTPUT SHAFT :
 SIZE :
 KEYWAY :
 SLEEVE :
 COUPLING :
 MANUF :
 SIZE :
 BORE :
 GREASE :

***** EQUIPMENT REFERENCE DRAWINGS *****
 DRAWING NO PG# REV# TITLE DESIGN TYPE




BPF-285634 01 DECANTER FEED TANK 45

***** EQUIPMENT SPARE PARTS LIST *****

NAME	MANUF	PART NO	DESCRIPTION	UNITS	CTI	O/H	QTY
NUT,		NUT, .HEX	- HEAVY COMM	ASTM A194 2H 1/2"-13	EA	011920	
NUT,		NUT, .HEX	- HEAVY COMM	ASTM A194 2H 5/8"-11	EA	011940	
NUT,		NUT, .HEX	- HEAVY COMM	ASTM A194 2H 3/4"-10	EA	011970	
NUT,		NUT, .HEX	- HEAVY COMM	ASTM A194 2H 1-1/4"-8	EA	012060	
STUD,		STUD, .	COMM	ASTM A193-B7 1/2"-13 X 2-1/4" T	EA	017500	
STUD,		STUD, .	COMM	ASTM A193-B7 1/2"-13 X 2-3/4" T			

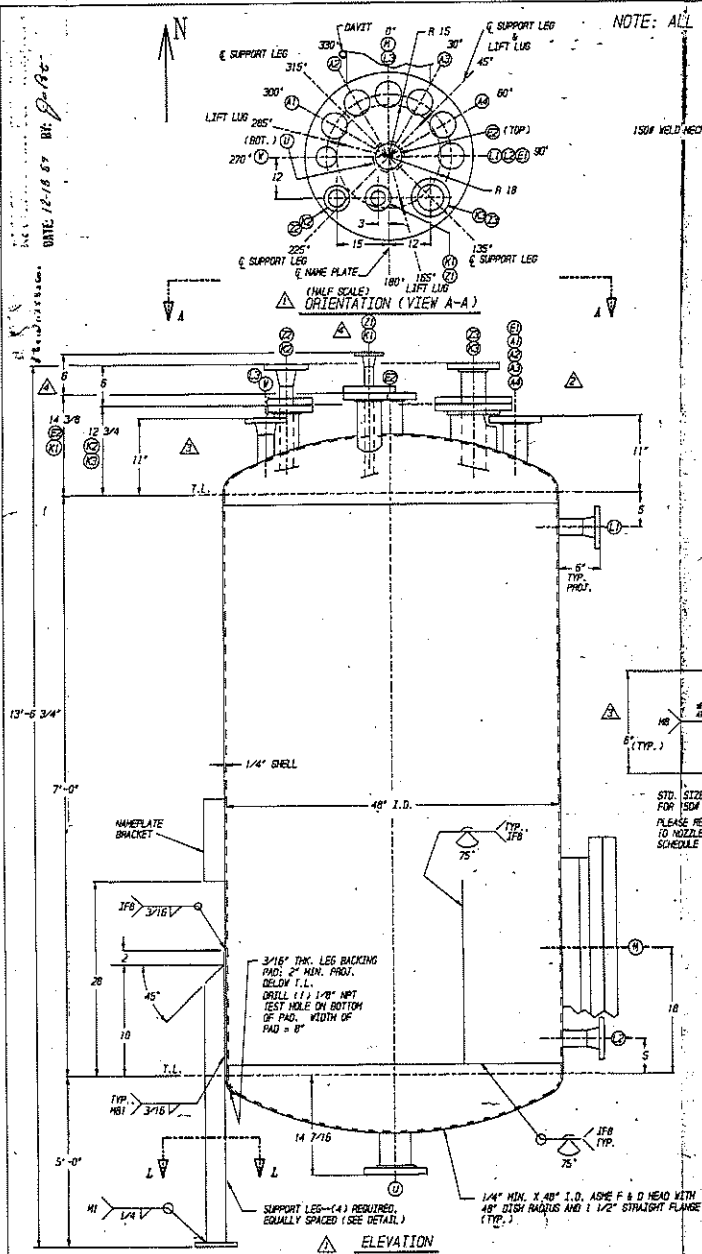

NOTE: ALL FLANGE FACES SHALL BE FINISHED TO 125 AA

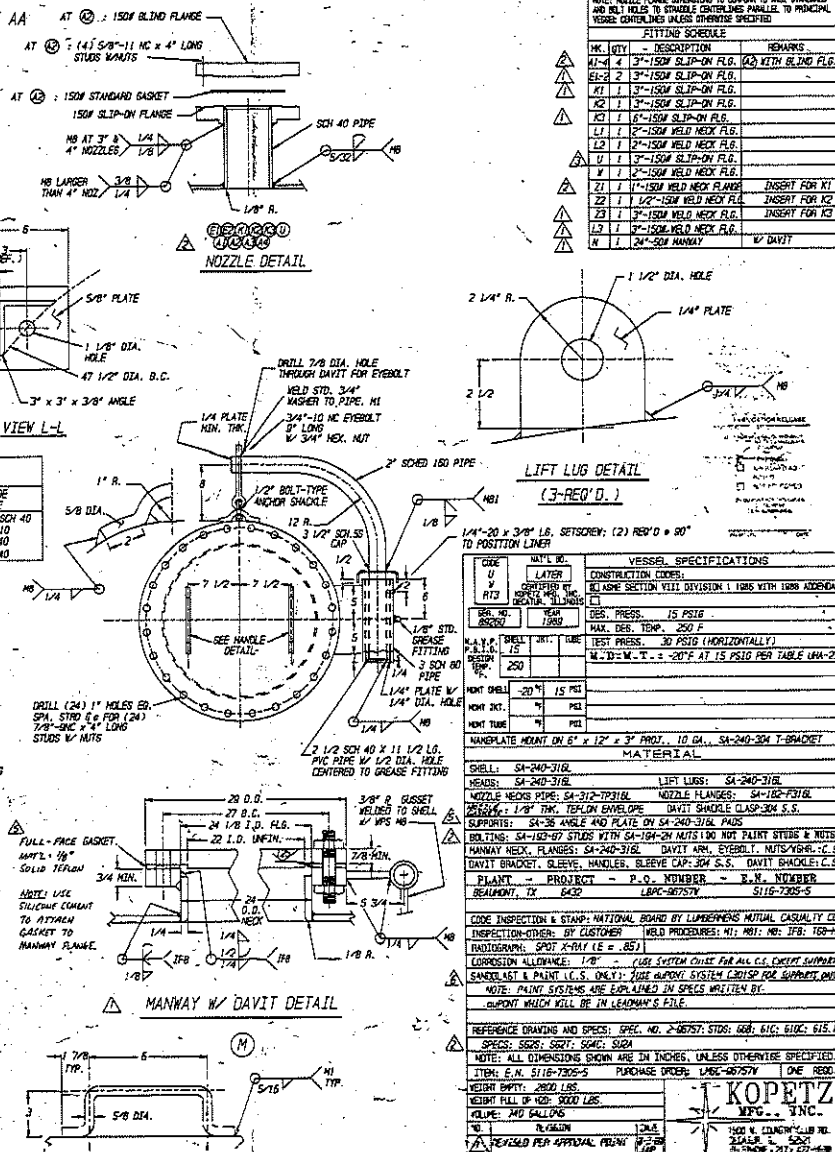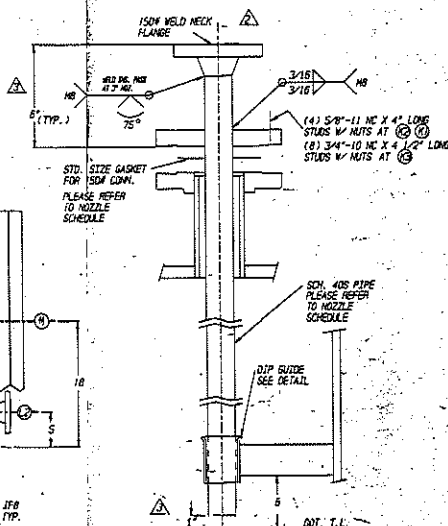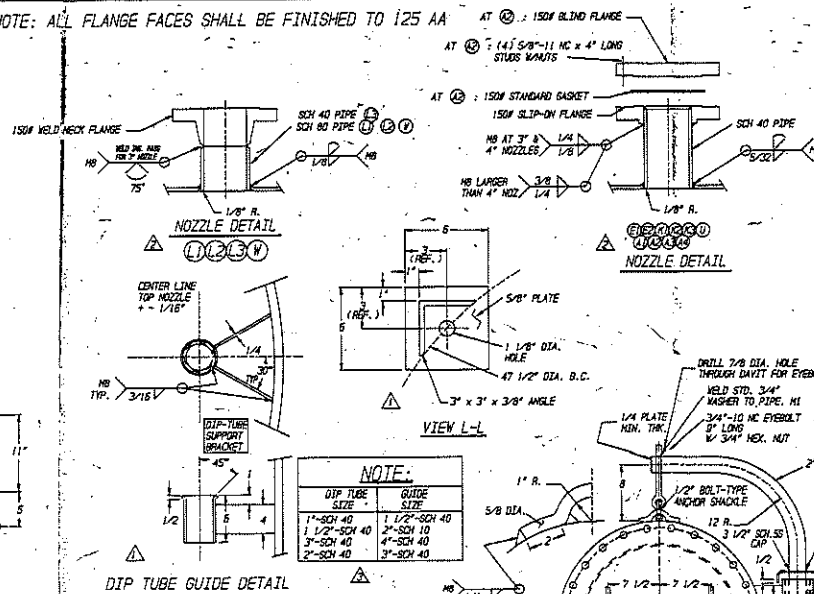

▲ HANDLE (2 REQUIRED)

JAN 16 1990
BPF 285636

SHEET # _____
CLARIFIED PAINT SPECS

FITTING SCHEDULE				
	WK.	RTY	DESCRIPTION	REMARKS
▲	41-4	4	3" ¹ 1/2" SLIP-ON FLS.	W/ KITH FLS.
▲	51-2	2	3" ¹ 1/2" SLIP-ON FLS.	
▲	R1	1	3" ¹ 1/2" SLIP-ON FLS.	
▲	R2	1	3" ¹ 1/2" SLIP-ON FLS.	
▲	R3	1	4" ¹ 1/2" SLIP-ON FLS.	
▲	L1	1	2" ¹ 1/2" WELD NECK FLS.	
▲	L2	1	2" ¹ 1/2" WELD NECK FLS.	
▲	U	1	3" ¹ 1/2" SLIP-ON FLS.	
▲	V	1	2" ¹ 1/2" WELD NECK FLS.	
▲	Z1	1	1 1/2" WELD NECK FLANGE	INSERT FOR X1
▲	Z2	1	1 1/2" WELD NECK FLS.	INSERT FOR X2
▲	Z3	1	2" WELD NECK FLS.	INSERT FOR X3
▲	L3	1	2" WELD NECK FLS.	
▲	N	1	24" SSW MANWAY	W/ DAYT?

W.P.P. P.B.C. DESIGN	SHELL 15	TEST PRESS. 30 PSIG (HORIZONTALLY) W.D.-W.T. = -20°F AT 15 PSIG PER TABLE UHA-27

MATERIAL			
SHELL: SA-240-316L		LEFT LUGS: SA-240-316L	
HEADS: SA-240-316L		NOZZLE FLANGES: SA-182-F301L	
NOZZLE NECKS PIPE: SA-312-TP316L		NOZZLE FLANGES: SA-182-F301L	
NOZZLE: 1/8" TH. TEFELON ENVELOPE		DAVIT SHOULDER CLASP: 304 S.S.	
SUPPORTS: SA-28 ALUM. AND PLATE ON SA-240-316L PAIDS			
BOLTING: SA-182-F8 STUDS WITH SA-194-2M 1/20 100 NOT PLANT STUDS & NUTS			
HANWAY HOOK, FLANGES: SA-240-316L		DAVIT ARM, EYEBOIT: 304 S.S.	
DAVIT BRACKET, SLEEVE, HANDLES, BREEZE CAP: 304 S.S.		DAVIT BRACKET: C.S.	
PIANT - PROJECT - P.O. NUMBER - E.N. NUMBER			
BEAUMONT, TX 6430		6806-6575V	5116-7205-S

CODE INSPECTION STAND: NATIONAL BOARD BY LUMBERMEN'S MUTUAL CASUALTY CO.
INSPECTION OTHER: BY CUSTOMER WELD PROCEDURES: M1; M01; M0: IFB: 100-M
RADIOGRAM: SPOT X-RAY (E = .85)
CORROSION ALLOWANCE: 1/8" - FUSE SYSTEM CHISEL FOR ALL C.S. EXCEPT SUPPORTS
SAVED AND PAINT (L.S. ONLY): FUSE SYSTEM SYSTEM CHISEL FOR SUPPORT ONLY
NOTE: PAINT SYSTEMS ARE EMPLOYED IN SPECS WRITTEN BY:
REPORT WHICH WILL BE IN LEADMAN'S FILE.

REFERENCE DRAWING(S) AND SPEC(S), EPEL NO. 2-60575; STOCK: 600; 610; 610C; 615; 10	
SPEC(S): 500S, 507S, 508S, 509S,