
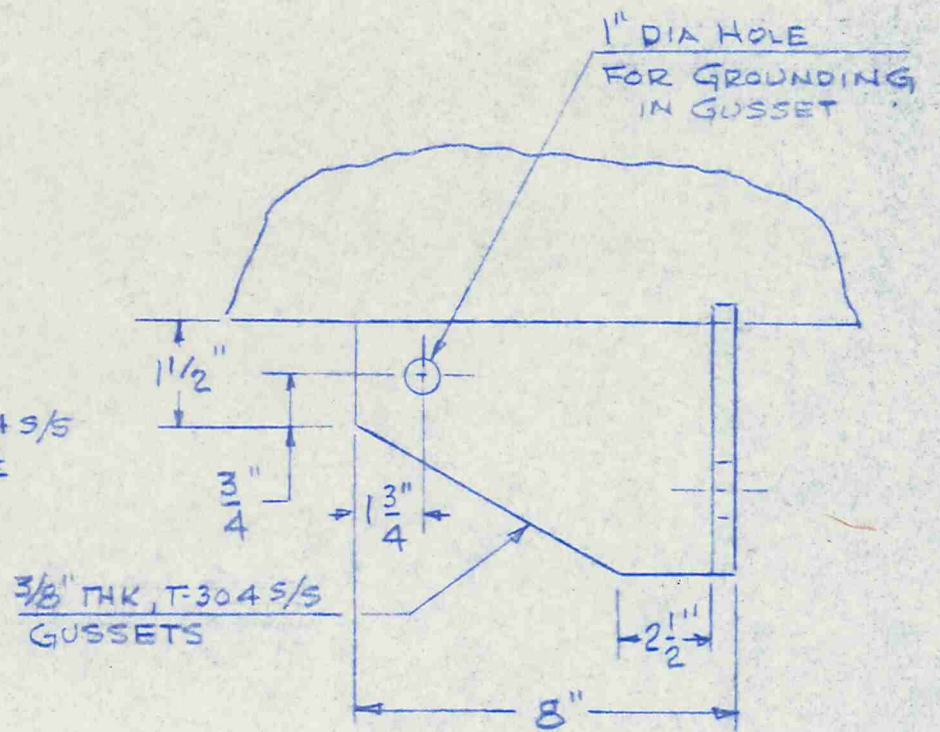


FOR LOCATION SEE DWG D-91127

ALL MATERIAL T-304 S.S.L.

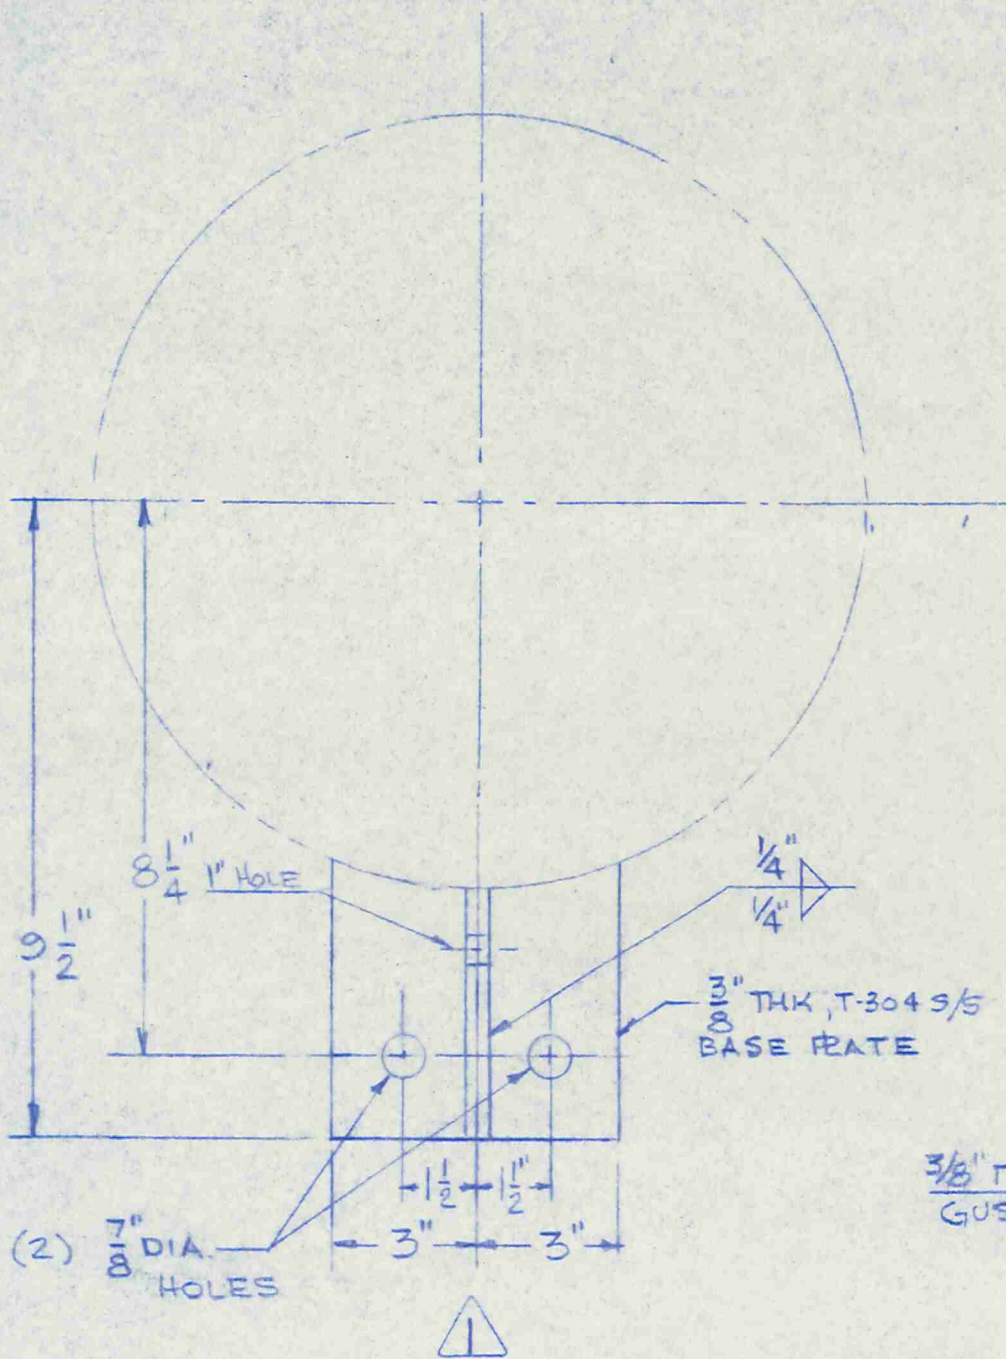

RECEIVED
JUL 22 1991
P. PROD.

CERTIFIED FOR FABRICATION
DATE 7/22/91 P. PROD.

J. J. Quadrato

1	7/10/91	<i>J. J. Quadrato</i>	REVISED SUPPORT LUGS TO SUIT CUSTOMER'S REQUEST
NO.	DATE	BY	REVISIONS

PERRY PRODUCTS CORPORATION

MOUNT LAUREL ROAD • HAINESPORT, NEW JERSEY 08036

THIS DRAWING IS THE PROPERTY OF PERRY PRODUCTS CORP. AND IS NOT TO BE DUPLICATED. ANY INFORMATION SHOWN HEREIN IS NOT TO BE DISCLOSED WITHOUT WRITTEN PERMISSION.

DRN. <i>J. J. Quadrato</i>	SUPPORT LUG DETAILS T-304 S/S (FOR HEAT EXCHANGER)		
DATE 6/1/91			
CHKD. <i>J. J. Quadrato</i>			
SER. NO. B-4622	JOB NO. 13968	DWG. NO. B-91129	①

114441