

E

E

D

D

C


C

B

B

A

A

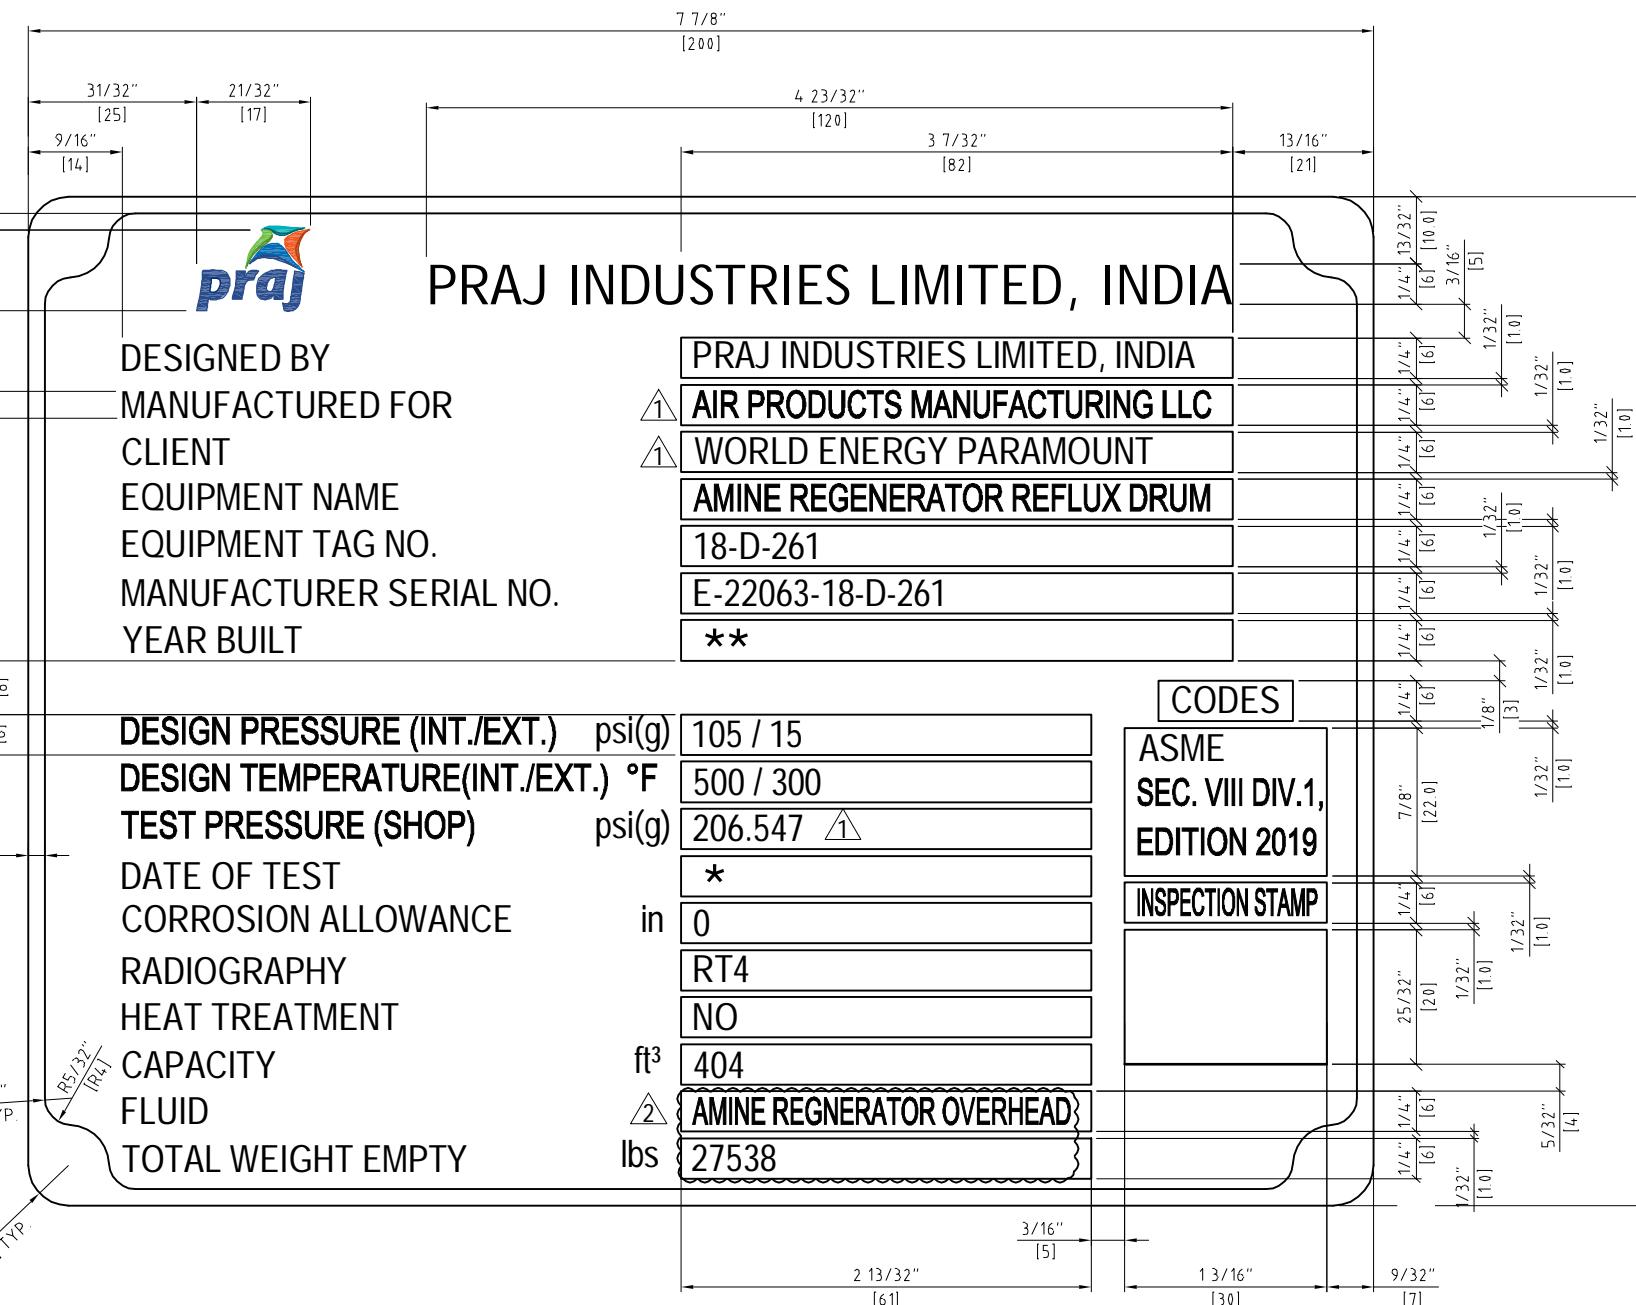

MFG. NAME PLATE DETAILS

NOTES :-

- 1) ALL DIMENSIONS ARE IN INCH/(MM) UNLESS OTHERWISE SPECIFIED.
- 2) TEXT ON THE NAME PLATE SHALL BE INDENTED BY ETCHING AND LETTER SHALL BE BLACK COLOUR MIN CHARACTER SIZE SHALL BE 0.1575" [4 mm] & DEPTH OF INDENTATION SHALL BE MIN 0.01" [0.25mm]. (e.g - Pressure)
- 3) MATERIAL OF CONSTRUCTION OF NAME PLATE - AISI304
- 4) REFER G.A. DRAWING NUMBER : E-22063-ME-11-GAD-0001 (EN207121-PRAJ-9V3-00020)
- 5) NAME PLATE THICKNESS 0.0788" [2mm].
- 6) TOTAL QTY.- 01 No.
- 7) **YEAR OF BUILT SHALL CORRESPOND TO THE DATE OF APPLYING "CODE STAMP" AND SHALL BE HARD PUNCHED PHYSICALLY.
- 8) LETTERS SHALL BE AS FOLLOWS :-
PRAJ INDUSTRIES LTD : TREBUCHET MS.
OTHERS : ARIAL NARROW (EXCEPT "LOGO", WHICH WILL BE AS PER PRAJ NORMS)
- 9) NAME PLATE SHALL BE RIVETED TO BRACKET.
- 10) *ACTUAL DATE SHALL BE PUNCHED (ENGRAVING OR HARD STAMPING) AFTER HYDRO TESTING IN DD-MM-YYYY FORMAT & MUST BE CLEARLY LEGIBLE.
- 11) INSPECTION STAMP SHALL BE HARD PUNCH AFTER OBTAINING APPROVAL FROM AI.

ASME

5 29/32" [150]

CODES
ASME
SEC. VIII DIV.1,
EDITION 2019
INSPECTION STAMP

2	REVISED AS PER CLIENT COMMENTS	RKC	AVM/SRW	BK	29-12-2022
1	REVISED AS PER CLIENT COMMENTS	RKC	AVM/SAT	BK	26-07-2022
0	ISSUED FOR APPROVAL	RKC	AVM/SAT	B.K.	04-01-2022
REV. NO.	DESCRIPTION	DRAWN	CHKD.	APPD.	DATE

CLIENT : WORLD ENERGY PARAMOUNT	P.O. NO. : 4505426378
EQUIPMENT OWNER : AIR PRODUCTS MANUFACTURING LLC	CLIENT DOC. NO. : EN207121-PRAJ-9V3-00041
PROJECT : WORLD ENERGY RENEWABLES PROJECT	CLIENT REV. NO.
PROJECT LOCATION : WORLD ENERGY, PARAMOUNT, CA, USA	


THIS DWG. IS THE PROPERTY OF PRAJ INDUSTRIES LTD. AND
SHOULD NOT BE REPRODUCED WITHOUT WRITTEN CONSENT FROM
PRAJ INDUSTRIES LTD.
"PRAJ TOWER", Bhumkar Chowk, Hinjewadi, Pune-411 057. (INDIA)



TITLE : NAME PLATE DETAIL DRAWING FOR 18-D-261 AMINE REGENERATOR REFLUX DRUM		DRG. PAPER SIZE: A3
DWG. NO.	E-22063-ME-11-NPD-0001	SCALE NTS
SHEET 1 OF 2		PIL JOB CODE E-22063

REV. 2

E D C B A

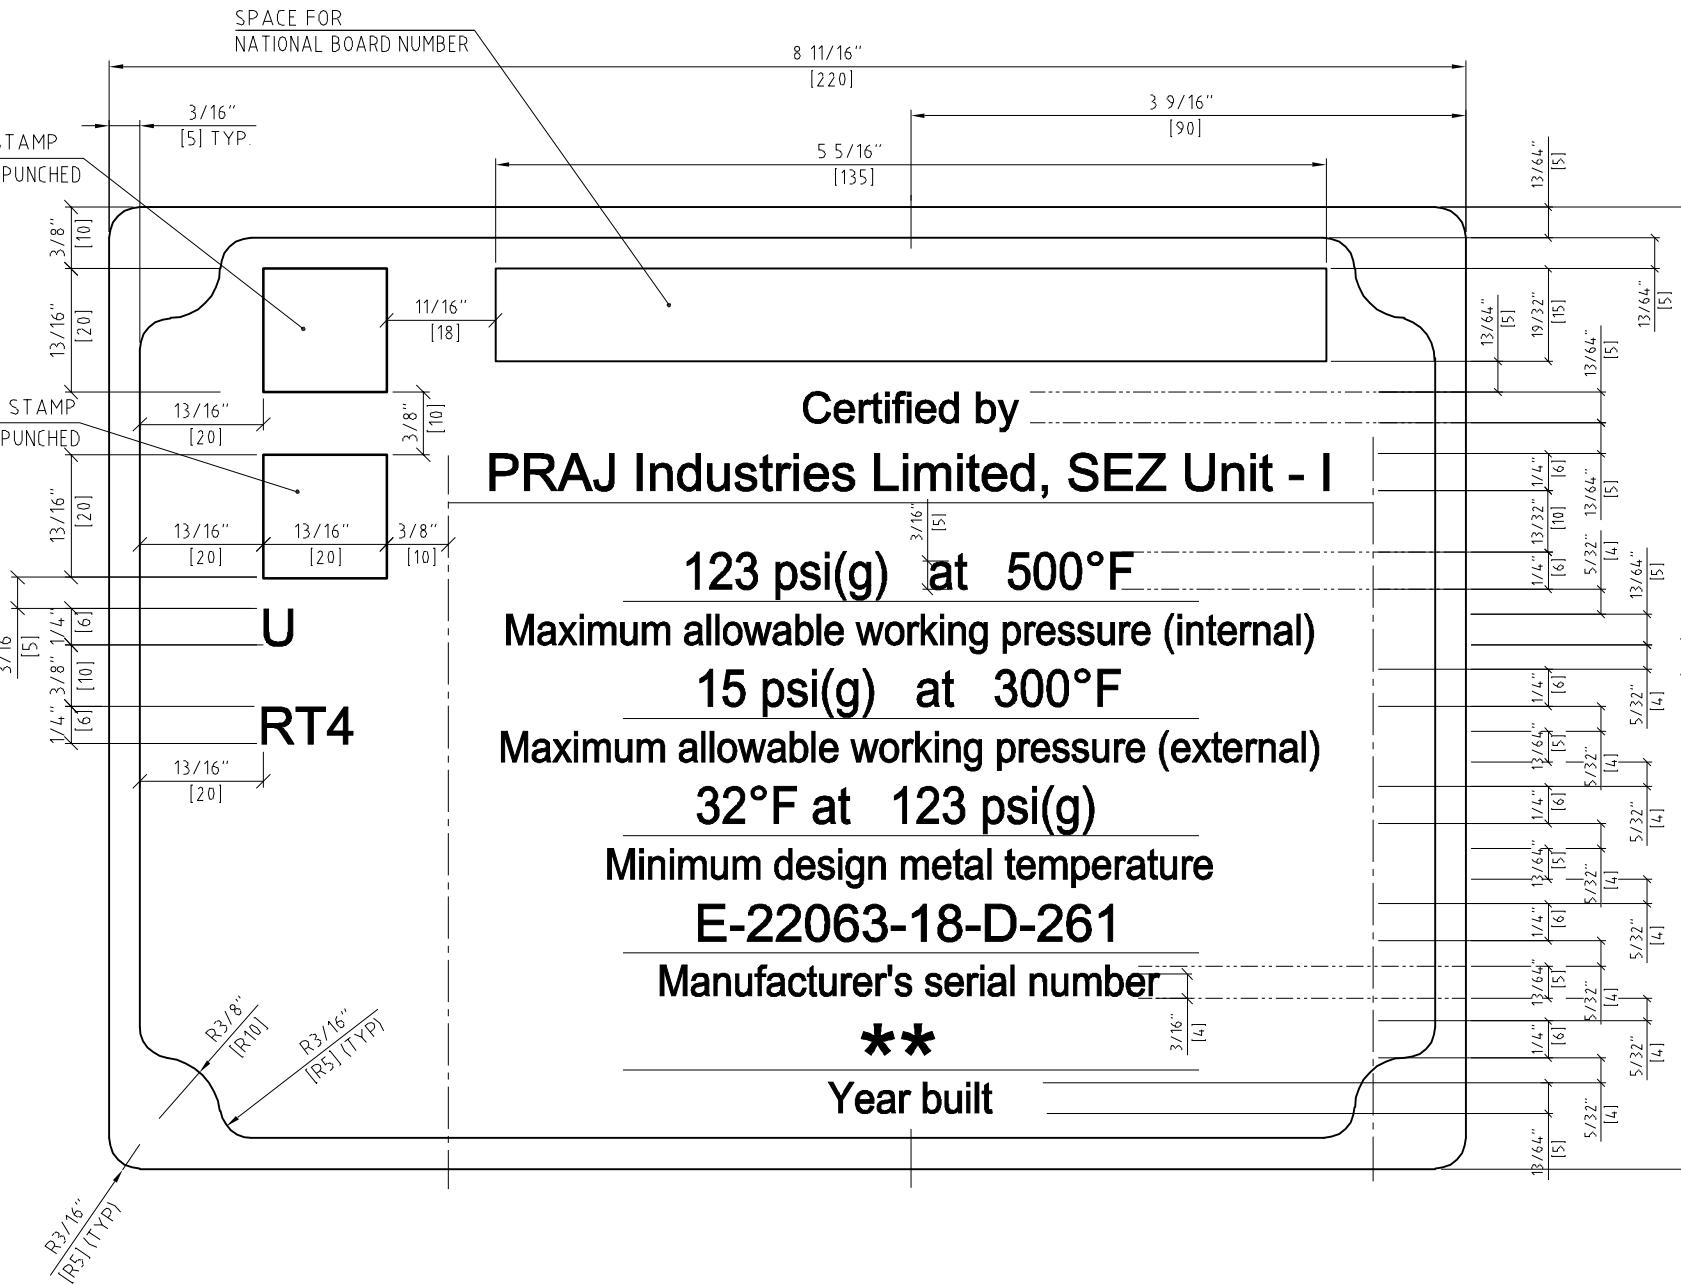

Certified by

PRAJ Industries Limited, SEZ Unit - I

123 psi(g) at 500°F

Maximum allowable working pressure (internal)

15 psi(g) at 300°F

Maximum allowable working pressure (external)

32°F at 123 psi(g)

Minimum design metal temperature

E-22063-18-D-261

Manufacturer's serial number

**

Year built

ASME

NOTES :-

- 1) ALL DIMENSIONS ARE IN INCH/MM UNLESS OTHERWISE SPECIFIED.
- 2) TEXT ON THE NAME PLATE SHALL BE INDENTED BY ETCHING. AND LETTER SHALL BE BLACK COLOUR.
- 3) MIN. CHARACTER SIZE SHALL BE 0.1575" [4 mm] & DEPTH OF INDENTATION SHALL BE MIN. 0.01" [0.25mm]. (e.g.- Pressure)
- 4) MATERIAL OF CONSTRUCTION OF NAME PLATE - AISI304
- 5) ASME CERTIFICATION SYMBOL STAMP TO BE PUNCHED AFTER OBTAINING AUTHORIZATION FROM 'AI' AND IN HIS PRESENCE.
- 6) REFER G.A. DRAWING NUMBER : E-22063-ME-11-GAD-0001 (EN207121-PRAJ-9V3-00020)
- 7) NAME PLATE THICKNESS 0.0788" [2mm].
- 8) TOTAL QTY. - 01 NO.
- 9) ** YEAR OF BUILT SHALL CORRESPOND TO THE DATE OF APPLYING "CODE STAMP" AND SHALL BE HARD PUNCHED PHYSICALLY.
- 10) NATIONAL BOARD SYMBOL SHALL BE HARD PUNCH AFTER OBTAINING APPROVAL FROM AI
- 11) NATIONAL BOARD SR. NO. TO BE ALLOCATED BY MANAGER QAC. AND SHALL BE HARD PUNCHED USING LETTERS OF AT LEAST 0.236" [6MM] HEIGHT.
- 12) LETTERS SHALL BE AS FOLLOWS -
PRAJ INDUSTRIES LTD. : TREBUCHET MS.
OTHERS : ARIAL NARROW

REV. NO.	DESCRIPTION	DRAWN	CHKD.	APPD.	DATE
2	REVISED ASS PER CLIENT COMMENTS	RKC	AVM/SRW	BK	29-12-2022
1	REVISED AS PER CLIENT COMMENTS	RKC	AVM/SAT	BK	26-07-2022
0	ISSUED FOR APPROVAL	RKC	AVM/SAT	B.K.	04-01-2022

CLIENT : WORLD ENERGY PARAMOUNT	P.O. NO. : 4505426378
EQUIPMENT OWNER : AIR PRODUCTS MANUFACTURING LLC	CLIENT DOC. NO. : EN207121-PRAJ-9V3-00041
PROJECT : WORLD ENERGY RENEWABLES PROJECT	CLIENT REV. NO.
PROJECT LOCATION : WORLD ENERGY, PARAMOUNT, CA, USA	

THIS DWG. IS THE PROPERTY OF PRAJ INDUSTRIES LTD. AND
SHOULD NOT BE REPRODUCED WITHOUT WRITTEN CONSENT FROM
PRAJ INDUSTRIES LTD.
"PRAJ TOWER", Bhumkar Chowk, Hinjewadi, Pune-411 057. (INDIA)



TITLE : NAME PLATE DETAIL DRAWING FOR 18-D-261 AMINE REGENERATOR REFLUX DRUM		DRG. PAPER SIZE: A3
SCALE NTS		PIL JOB CODE E-22063
DWG. NO. E-22063-ME-11-NPD-0001	SHEET 2 OF 2	REV. 2