ACCORDING THE LAW OUR SURVEYS AND DRAWINGS ARE OUR EXCLUSIVE PROPERTY AND MAY NEITHER BE REPRODUCED NOR COMMUNICATED TO THIRD PARTIES EVEN AFTER MODIFICATIONS WITHOUT OUR WRITTEN CONSENT

DE CONFORMIDAD CON LA LEY, NUESTROS ESTUDIOS Y DIBUJOS SON PROPIEDAD EXCLUSIVA DE NUESTRA FIRMA Y NO PUEDEN SER REPRODUCIDOS NI COMUNICADOS A TERCERAS PERSONAS SIN NUESTRA AUTORIZACION ESCRITA AUNQUE HAYAN SIDO MODIFICADOS

CONFOREMENT A LA LOI NOS ETUDES ET DESSINS SONT NOTRE PROPRIETE EXCLUSIVE ET NE PEUVENT ETRE REPRODUITS OU COMMUNIQUES A DES TIERS MEME APRES MODIFICATIONS SANS NOTRE AUTORISATION ECRITE

IF IN DOUBT, ASK – DO NOT SCALE !

NAMEPLATE

4 HOLES DIA 4.1
FOR RIVETS DIA 4

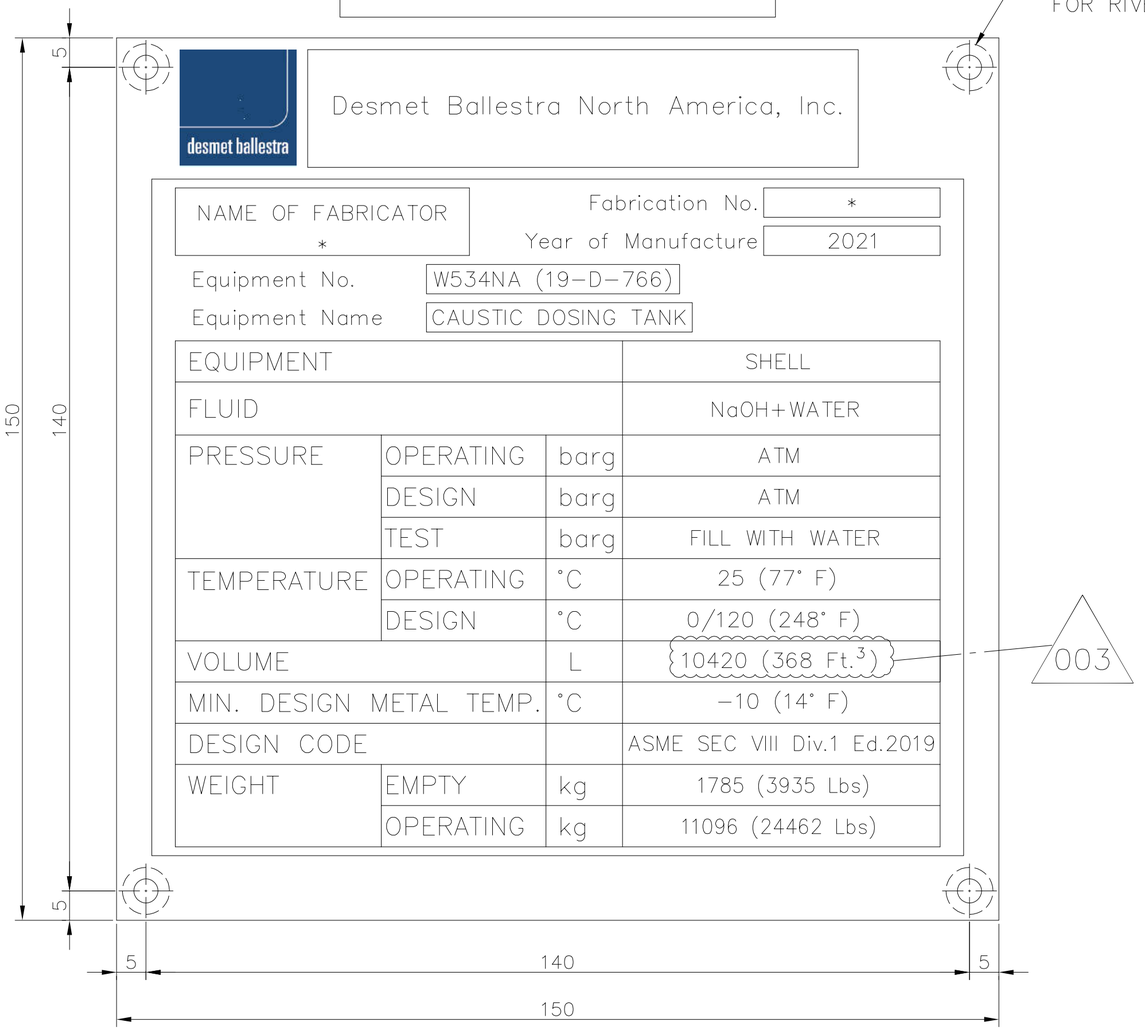

SUPPORT

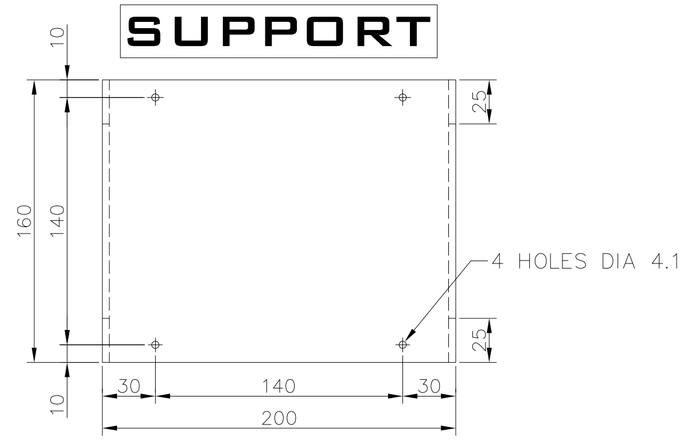

FOR SUPPORT MATERIAL: SEE ASSY DRAWING
MINIMUM THICKNESS: 4 mm–SS
5 mm–CS

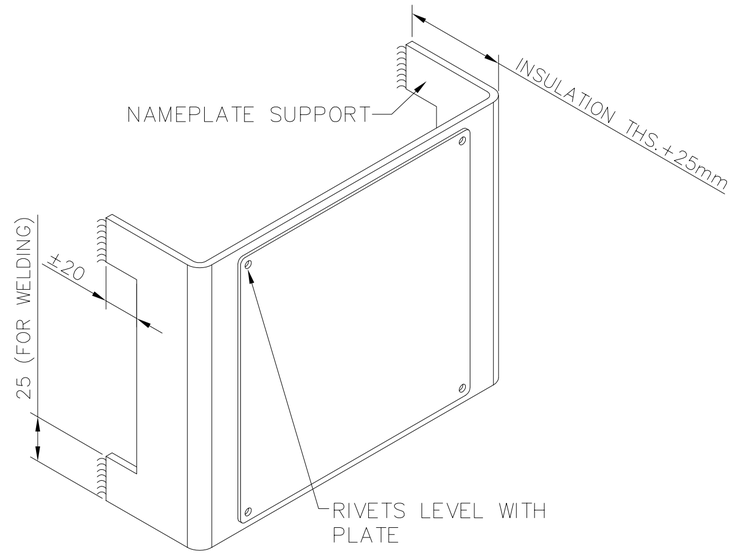

NOTES:

- CONSTRUCTION PRINTED.
- DIMENSIONS AS INDICATED, MINIMUM THICKNESS OF NAMEPLATE 1 mm.
- THE RECTANGLES, WRITINGS & EDGES HAVE TO BE WRITTEN IN BLACK.
- RECTANGLES & DASHED LINES DELIMIT THE MAXIMUM SPACE TO BE USED FOR THE INDICATED WRITINGS.
- RIVETS OR BOLTS : STAINLESS STEEL WITH COUNTERSUNK HEAD.
- MATERIAL NAMEPLATE : ALUMINIUM.
- LETTERING SIZE = 2.5 mm (EXCEPT HEADINGS).
- HEADINGS SIZE = 3 mm.
- * INFORMATION GIVEN BY VESSEL FABRICATOR.

REV	DATE	DESCRIPTION OF MODIFICATION	NBR OF MOD	BY
003	28.10.2021	UPDATED AS MARKED		RSS

Desmet Ballestra Group		DOCUMENT TYPE	ASSY	
		PROJECT DESCRIPT	WORPAR	
ITEM NBR DISPOSITION	W534NA (19–D–766)	SECD	SAA	SCALE / FORMAT
		PROC.E	GVK	A3
DOCUMENT DESCRIPTION	CAUSTIC DOSING TANK	PROJ.M	JCG	
		DOM	PRA	AUTHOR RSS
NAMEPLATE		DATE	DRAWING NUMBER	REVISION
		06.01.2021	100174064	003