
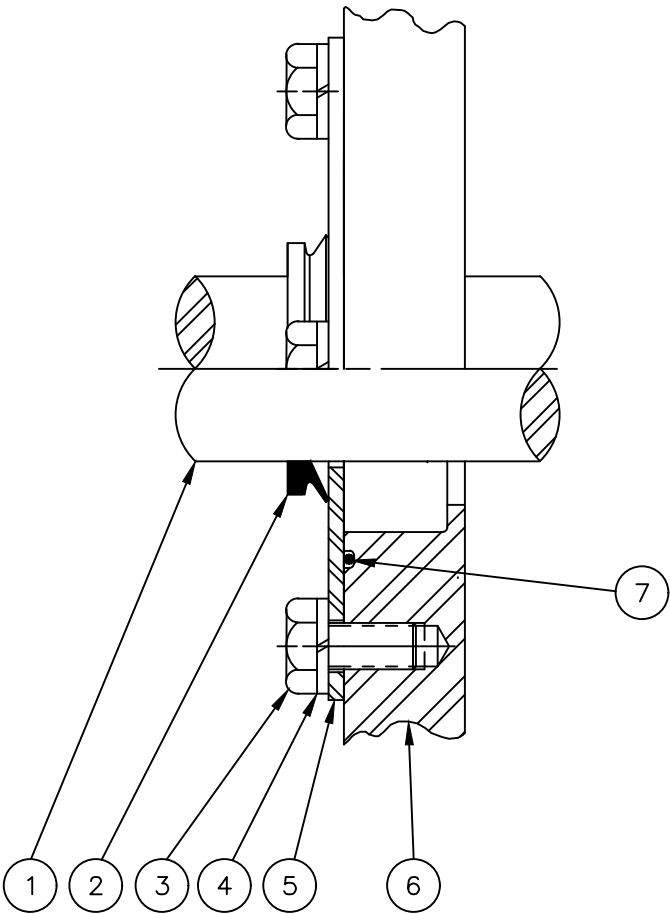


NO.	DATE	REVISION	BY	ECR#
01	06/08/21	FOR CUSTOMER APPROVAL	AJK	----
02	08/02/21	RELEASE FOR MANUFACTURE	AJK	3008
03	08/17/21	ADDED CUSTOMER NOTE	AJK	3058

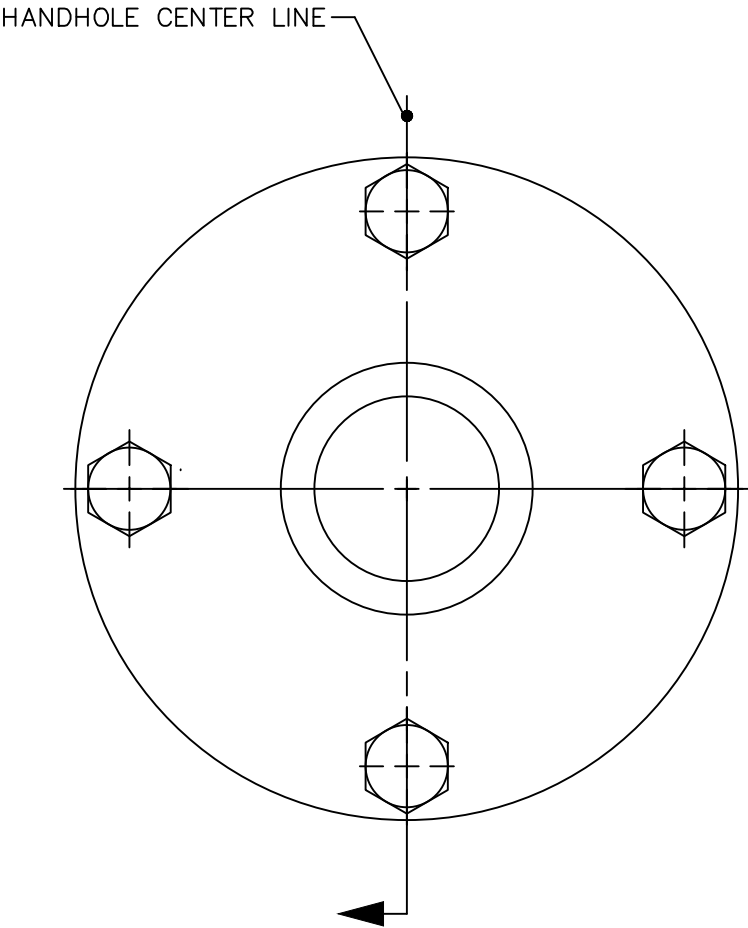

SEAL OPERATING PARAMETERS:
1) VESSEL TEMPERATURE: 225° F
2) VESSEL PRESSURE: 0 PSIG

PROJECT - WORPAR
ITEM NBR - W534NA-A
eB NBR - 100199419.001
DATE - 19.10.2021

Do not repeat tag and
eB number data

PROJECT - WORPAR
ITEM NO - W534NA-A
EB NBR - 100199417.000
DATE - 06.07.2021

Label as World Energy tag number

CUSTOMER EQ.# (W534NA-A) 19-A-766

CHEMINEER WILL SUPPLY, AT ITS
DISCRETION, 316SS WETTED PARTS
WHEN CARBON STEEL OR 304SS IS
SPECIFIED.

7	O-RING	1	VITON
6	MOUNTING FLANGE, 14"-150#	1	STEEL
5	SEAL PLATE	1	316SS
4	SPRING LOCKWASHER	4	STEEL
3	HEX HEAD CAP SCREW	4	STEEL
2	V-RING	1	NITRILE
1	SHAFT, 2" DIAMETER	1	STEEL
NO.	DESCRIPTION	QUAN	MAT'L / TYPE

NOTICE: This document contains National Oilwell Varco (NOV) proprietary and confidential information protected by applicable laws. It may only be used in accordance with the terms and conditions, license, or other contractual agreement under which it was released or provided by NOV. No reproduction, in whole or in part, distribution, publication, release, or other uses are permitted or authorized without express written authorization from NOV. NOV retains all ownership and intellectual property rights relating to this work and intends to enforce its rights under applicable laws. This document is to be returned to NOV upon request. © 2015 National Oilwell Varco, All rights reserved.

CUSTOMER P.O.#	PO-00028323
CUSTOMER EQ.#	SEE NOTE 2
NOV SALES ORDER #	4572878
CHEMINEER SERIAL #	4572878-11-01
QTY.	1
REF. ASS'Y. DWG.#	4572878-11-AS1
CERTIFIED BY	AJK
DATE	8/2/21

 Chemineer™		
V-RING SEAL ASSEMBLY FOR: DESMET / PROJECT WORPAR		
DRAWING NUMBER	4572878-11-SL1	REV. 03
AGS5.6	06/08/21	B