


SECTION / DESCRIPTION	MAWP	TEST PRESS	DESIGN TEMP	MDMT	ALTERNATE DESIGN	BUNDLE VOL	BUNDLE WT	LOUVER	HAILSCREENS	MOTOR HP:	FAN MFGR:	DIAM (FT):	SPECIFICATION NOTES:	COOLER WT #:
UNITS	PSIG	PSIG	DEG F	DEG F	CONDITION	CU FT	LBS			TYPE:	MOORE	11		SEE TABLE
18-XF-354 OFF SPEC PRODUCT COOLER	250	353	675	32	FV @ 525F	43	29987	MANUAL	NONE	TEFC	10000	113939	VIBE SENSOR: WILCOXON	STRUCTURE FINISH: PER A8KM-PP-000-500540-A
										RPM:	4	19.12	VIBE SENSOR MODEL NO.:	NON FIREPROOFED STR TO BE GALVANIZED
										VAC:	5.27		786A-D2	HEADER FINISH: PER A8KM-PP-000-500520-A
										FRAME:	313	HTD		COATING SYSTEM 5 AFTER HYDROTEST
										SHAFT:	36	5.75:1		
										MOTOR WT:	EC	DRIVE WIDTH:		
										QTY:	VE	AIR BRAKE:		
											2			
STEAM COIL	232	302	430	32	FV @ 430F	5	6365	NONE	NONE					

WEIGHTS PER BAY(LBS)	
ITEM	WEIGHT
COOLER	48551
SPAN BEAMS	3433
LOUVER	1042
WALKWAY	1751
PROCESS H2O	2674
STEAM H2O	327
PROCESS FLUID	1935
TOTAL DRY	57486
TOTAL FULL H2O	60487
TOTAL OPERATING	59421

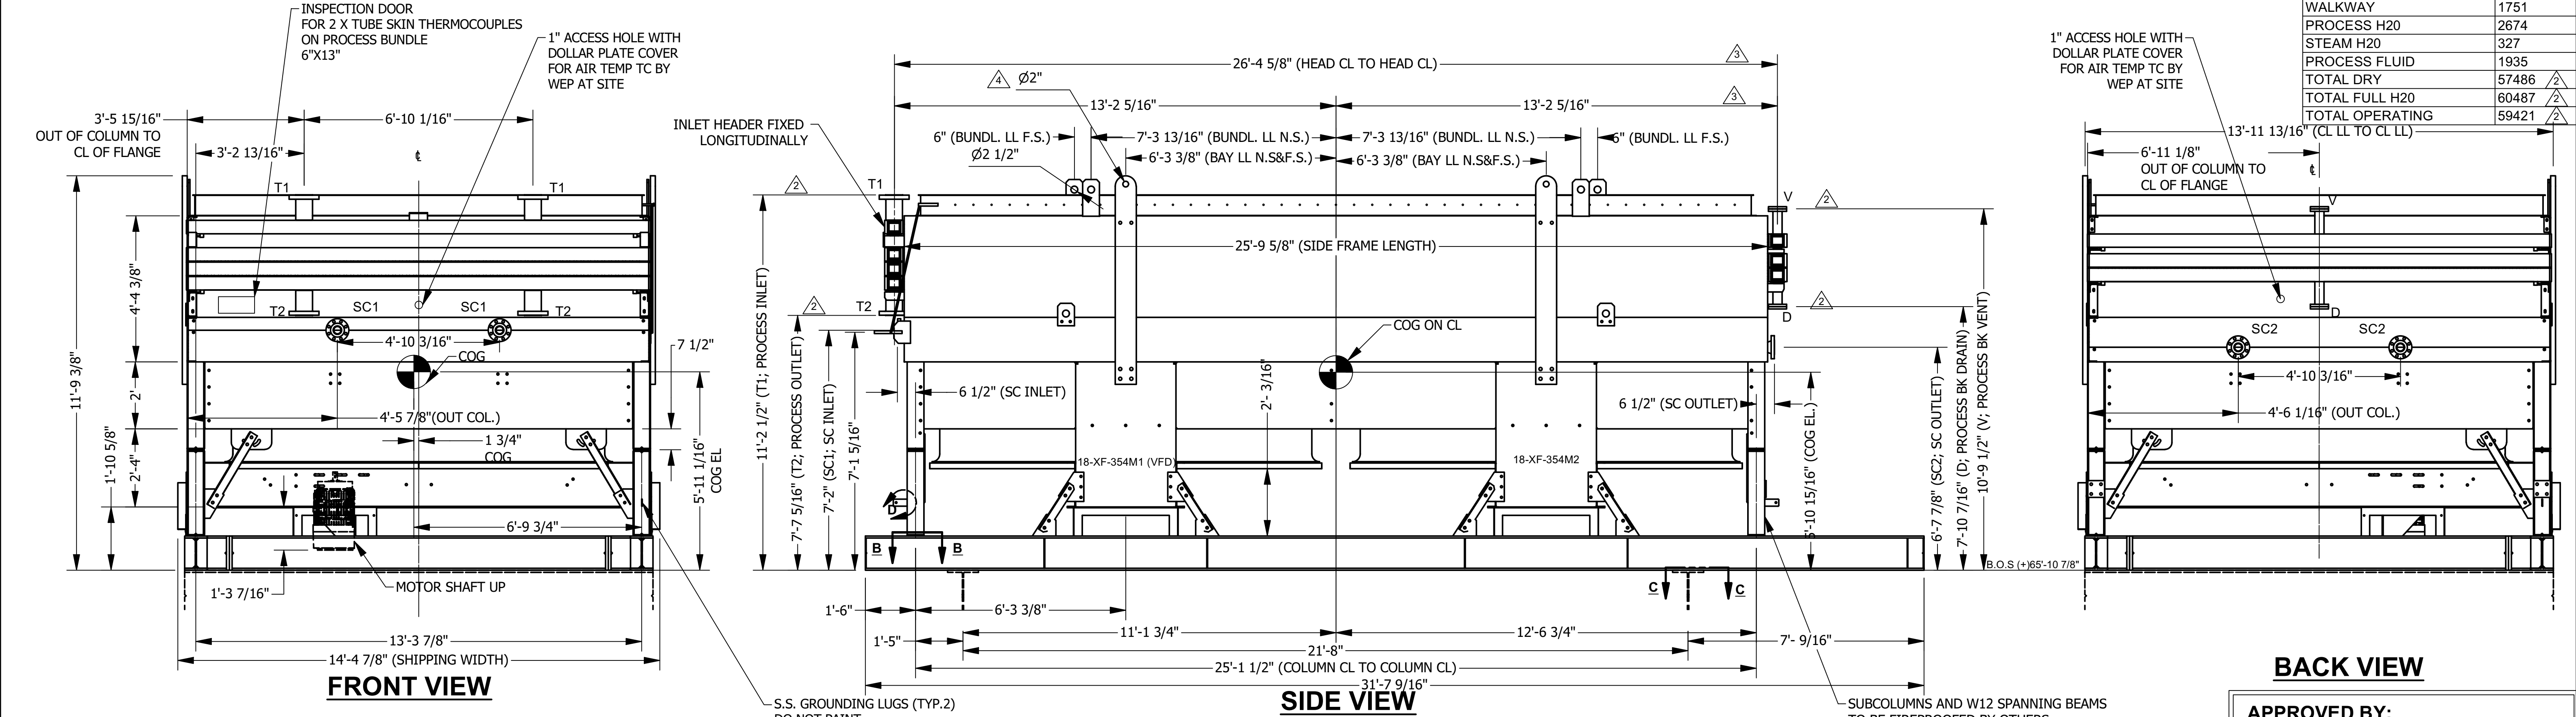




APPROVED BY: _____
DATE: _____

NOZZLE SCHEDULE			
LABEL	ITEM	QTY	FLANGE
T1	PROCESS INLET	2	4" 600# RFLWN, 4" ID 6"OD
T2	PROCESS OUTLET	2	4" 600# RFLWN, 4" ID 6"OD
V	PROCESS BK VENT	1	2" 300# RFLWN; BLIND
D	PROCESS BK DRAIN	1	2" 300# RFLWN; BLIND
SC1	STEAM INLET	2	3" 300# RFWN
SC2	STEAM OUTLET	2	3" 300# RFWN

- NOTE: 1. (1) BAYS REQUIRED
2. SPANNING BEAMS, STUB COLUMNS, TRANSV & LONL DIAG BRACES, AND MANUAL LOUVER ROD REMOVED FOR SHIPPING.
3. ALL MOTORS ARE VFD COMPATIBLE, NO SPACE HEATER.
4. UNIT ADJACENT TO 18-XF-350 WITH CONNECTING HEADER WALKWAYS AND AIR SEALS
5. MOTOR REMOVAL BEAM PROVIDED
6. MOTORs SHALL BE RATED FOR CLASS 1, DIV. 2, GROUPS B,C,D AND A T3C TEMPERATURE CODE
7. "COOLER WEIGHT" LISTED ABOVE INCLUDES BUNDLE, STEAM COIL FAN, MOTOR, STUB COLUMNS AND BRACES PER BAY.

NOZZLE LOADS	QTY/HEAD	SIZE	CLASS, #	2 X API 661		
FRONT HEAD	2	4	600			
SIZE	FX	FY	FZ	MX	MY	MZ
	LBS	LBS	LBS	FT LB	FT LB	FTLB
4	1500	1200	1500	1200	1800	1200
4	1500	1200	1500	1200	1800	1200
COMBINED	6000	4800	6000	4800	7200	4800
MAX API PER HEAD	2250	4500	3750	4500	6000	3000
STR DESIGN LOAD	6000	4800	6000	4800	7200	4800

NOZZLE LOADS	QTY/HEAD	SIZE	CLASS, #	2 X API 661		
STEAM COIL	2	3	300			
SIZE	FX	FY	FZ	MX	MY	MZ
	LBS	LBS	LBS	FT LB	FT LB	FTLB
3	900	760	900	600	900	600
COMBINED	1800	1520	1800	1200	1800	1200
MAX API	2250	4500	3750	4500	6000	3000
DESIGN LOAD	1800	1520	1800	1200	1800	1200

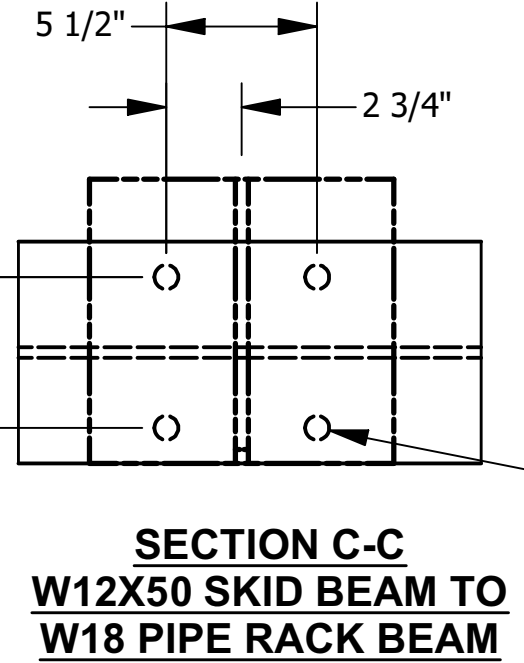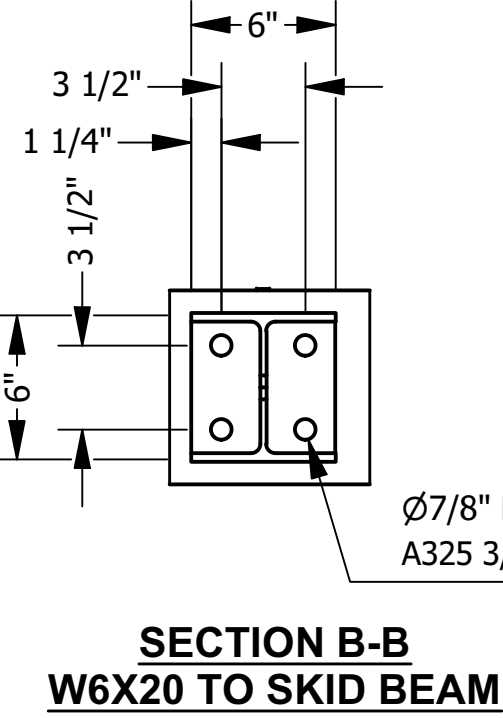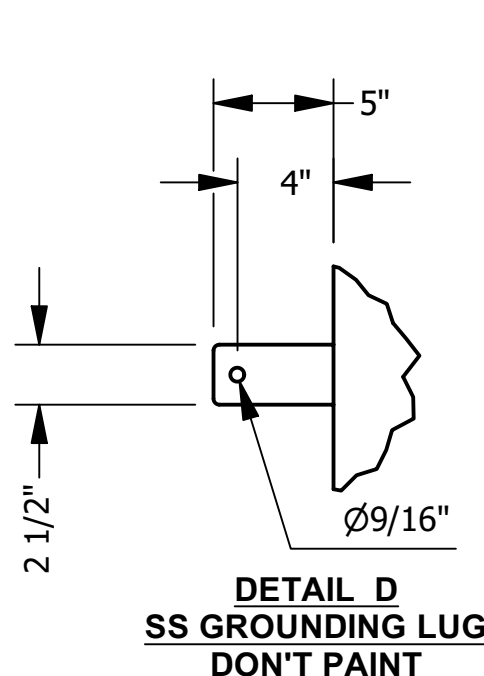

EQ. TAG #S	2	4
COOLER	EQUIPMENT	TAG #
18-XF-354	MOTOR	18-XF-354M1 (VFD)
18-XF-354	MOTOR	18-XF-354M2
18-XF-354	FAN	18-XF-354-F01
18-XF-354	FAN	18-XF-354-F02
18-XF-354	VIB SENSOR	18-VE-XF354A
18-XF-354	VIB SENSOR	18-VE-XF354B

GENERAL ARRANGEMENT - 18-XF-354		
REV.	DATE	DESCRIPTION
0	2/10/2022	FOR APPROVAL
1	7/11/2022	CUST. COMM.
2	12/8/2022	DESIGN CHANGE/ SPLIT EACH PASS
3	2/7/2023	CUST. COMM.
4	3/9/2023	CUST. COMM. / UPDATED LL. DIMS

REFERENCE DOCUMENTS	
FABSCO DOC. #	APCI DOC. #
A22-13312-6A-300	EN207119-FAB-9V3-00044
A22-13312-6SC-300	EN207119-FAB-9V3-00045
A22-13312-6A-ASME	EN207119-FAB-9V3-00210
A22-13312-6SC-ASME	EN207119-FAB-9V3-00211
A22-13312-6 LL	EN207119-FAB-9V3-00048
A22-13312-1.6 LAYOUT	EN207119-FAB-9V3-00043
A22-13312-6 NOTES	EN207119-FAB-9V3-00285
A22-13312-6 STR	EN207119-FAB-9V3-00055

PROJECT NAME:	World Energy Renewables Project
PROJECT NO./UNIT:	EN-20-7119 / RFJU-B
CUSTOMER/CLIENT:	World Energy Paramount
EQUIPMENT OWNER:	Air Products Manufacturing LLC
ITEM NO.:	18-XF-354
SERVICE:	Off Spec Product Cooler
LOCATION:	World Energy, Paramount, CA, USA
PO NO.:	4505606036 / A8KM-4-406-PO-1
FABSCO JOB NO.:	A22-13312-6

DRAWING PROPRIETARY TO FABSCO, LLC AND IS NOT TO BE RELEASED TO ANY THIRD PARTY, EXCEPT WITH NOTIFICATION AND APPROVAL IN WRITING OF FABSCO, LLC OFFICER.

DRAWN BY:

BH

DATE:

2/10/2022

CHECKED BY:

DRAWING NO:

A22-13312-6-100

REV:

4



WORLD ENERGY RENEWABLE FUELS CONVERSION PROJECT




Project No: A8KM

Vendor Input to PCMS




Doc number: A8KM-PCMS-001, Rev. 0

Vendor Doc Number: EN207119-FAB-9V3-00134
PCMS_PO Number: 4505606036
Rev: 0

Identification					
1: Tag No.	18-XF-354				
2: Model No.	A22-13312-6				
3: Serial No.	there is a serial no. on nameplate				
4: Registration No.	add after Code stamp received				Code Vessels Only
5: Code Stamped	yes				Drop Down
General Design					
15: Build Date	2023				
17: Manufacturer	FABSCO FIN AIR				
19: General Material	CS				
20: Insulation Type	None				Drop Down
21: Support Type	Baseplate				Drop Down
22: External Coating	Epoxy				Drop Down
23: MAWP (psig)	250				
24: MAWT (F)	675				
25: Design Pressure (psig)	250				
26: Full Vacuum	yes				Drop Down
27: Design Temp (F)	675				
28: MDMT (F)	32				
29: Weight Empty (lbs)	57486				
30: Weight Full (lbs)	60487				
31: Equipment Length (inches)	31'-8"				
32: Orientation	Horizontal				Drop Down
33: Equipment Width (inches)	14'-5"				
34: Equipment Height (inches)	11'-10"				
35: Storage Volume (bbls)	NA				Vessels Only
36: Outer Diameter (inches)	NA				
37: PWHT	yes				
38: Fire Proofing	no			yes, by others	
39: Heat Tracing	None				
40: Test Medium	Water				Pressure Testing

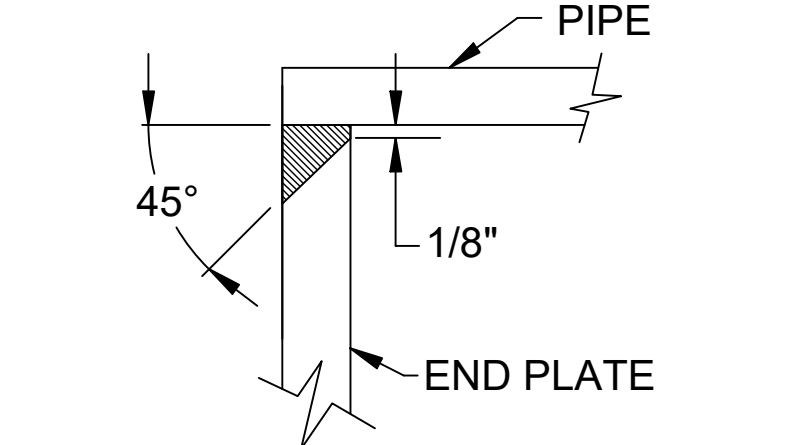
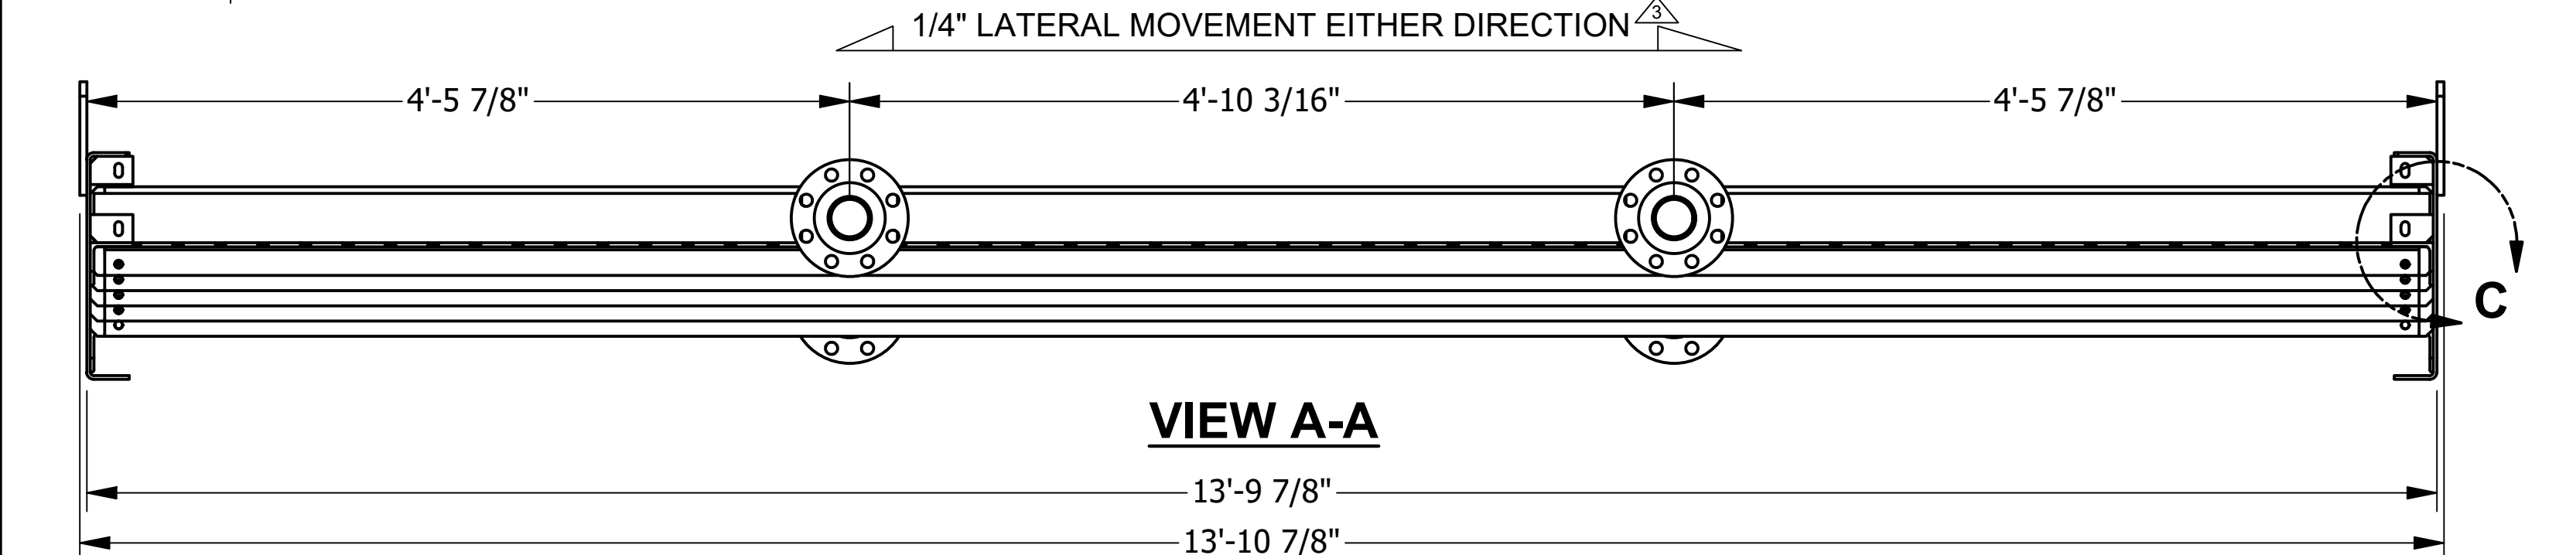
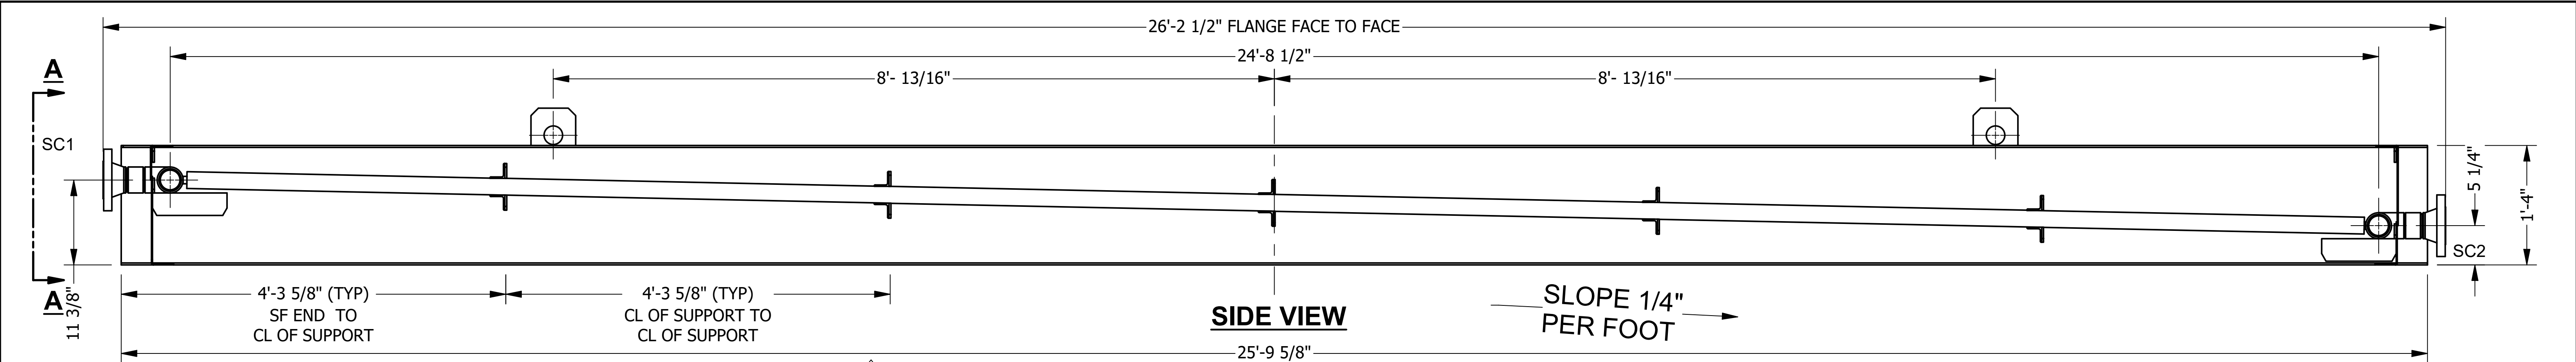


END PLATE WELD DETAIL

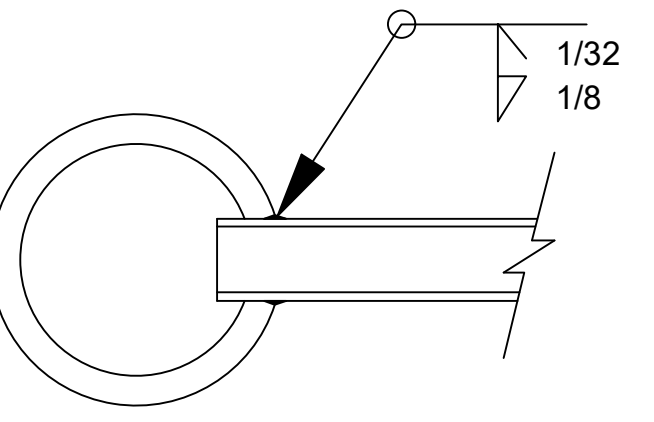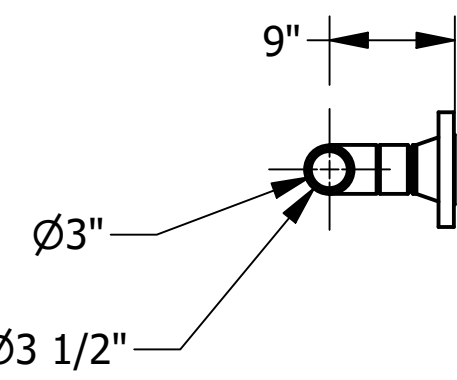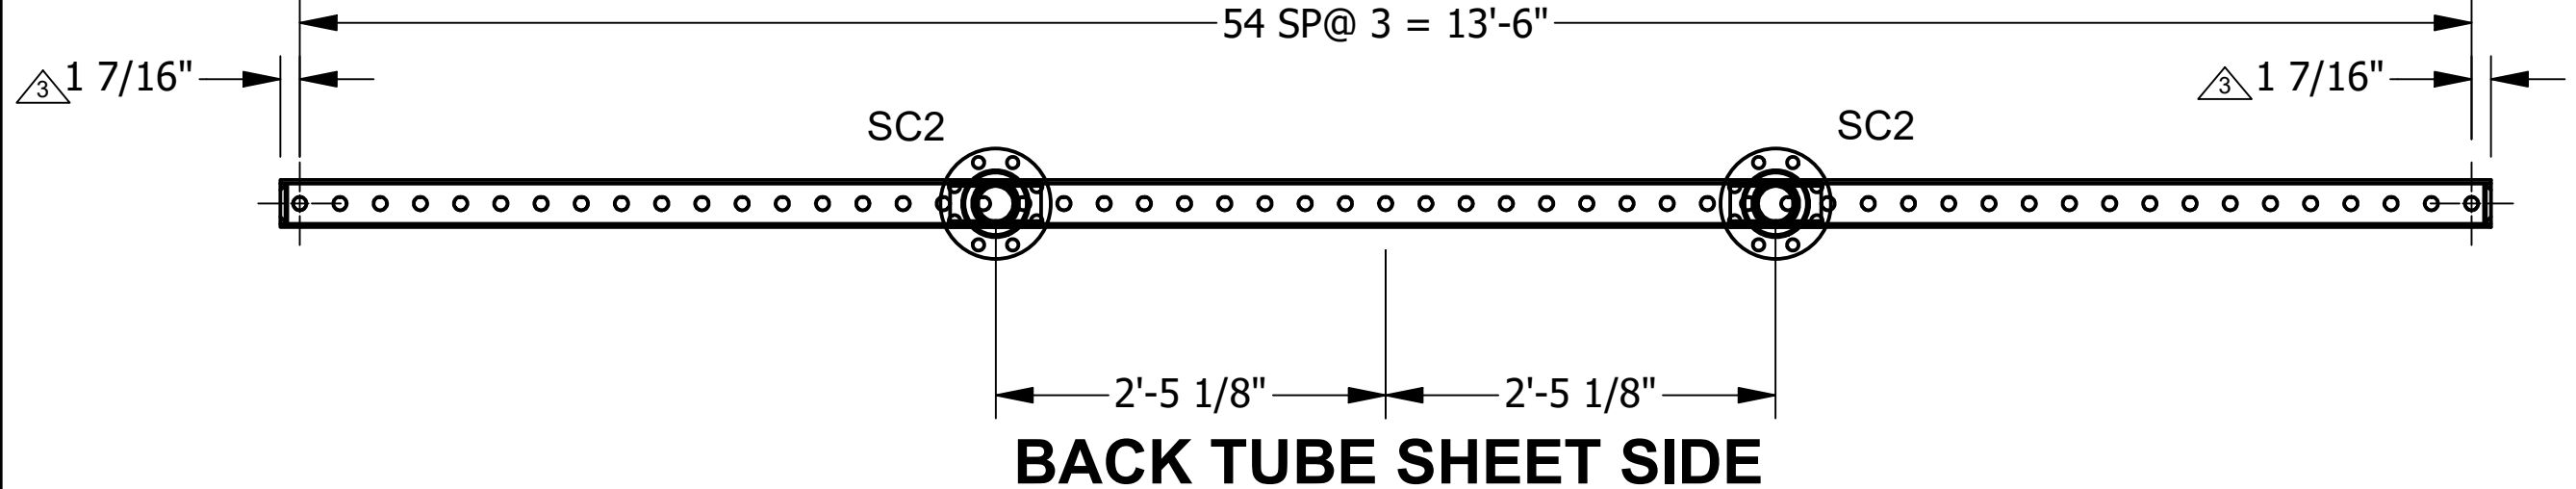

TUBE TO PIPE HEAD DETAIL


NOTE:
1) TUBES TO BE WELDED TO PIPE HEADER.

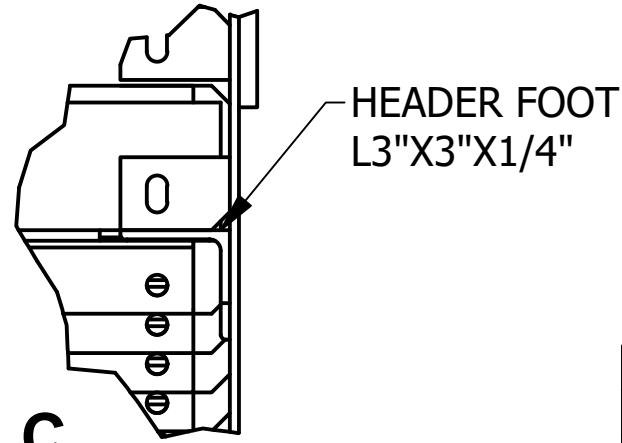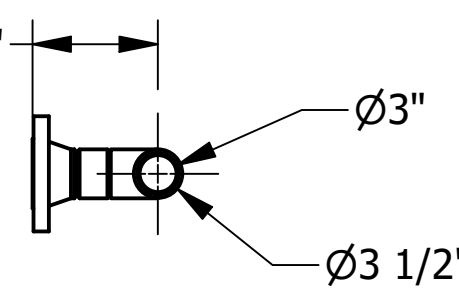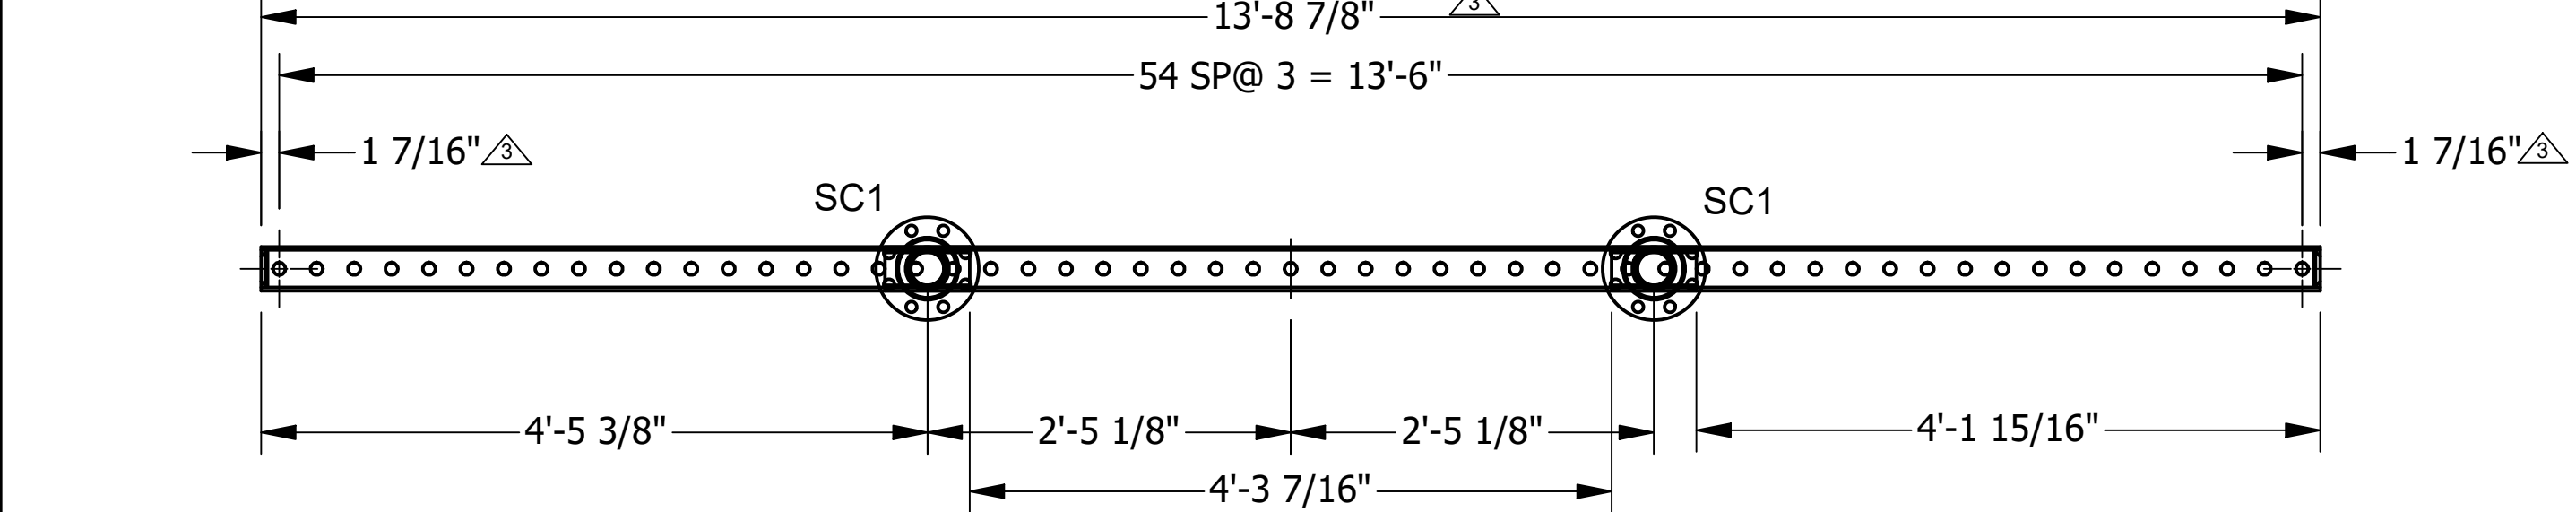

DETAIL C
HEADER SUPPORT
TYP. BOTH ENDS

DESIGN INFORMATION	
DESIGN PRESS. PSIG:	232 / FV
DESIGN TEMP. DEG F:	430 / 430
MDMT DEG F:	35
CORROSION ALLOW. IN.:	0.125
NDE: MT OR PT EDGES	
100% RT BUTT WELDS	
RT SPOT API 661	
HYDROTEST PSIG:	302
DESIGN & STAMP:	ASME
ASME SECT. VIII, DIV. 1 ED. 2021	
CHARPY EXEMPT UG20(f) AND/OR UCS 66	

TUBE HOLE INFORMATION	
PREDRILL DIAMETER	0.9688
TUBE REAM	1.01
TPI	12

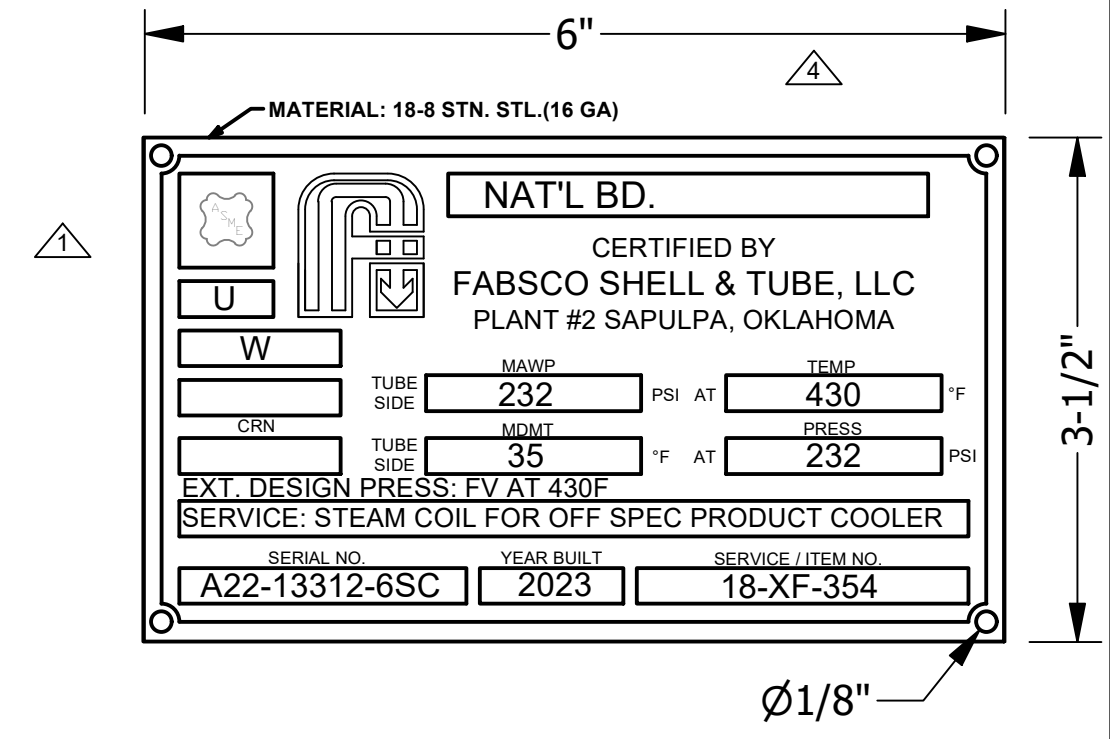

REV:	DATE	COMMENT	BY
0	03-16-2022	FOR APPROVAL	BH
1	7/12/22	CUST. COMM.	BH
2	10/25/23	CUST. COMM.	BH
3	11/27/23	CUST. COMM.	BH
4	2/12/2024	CUST. COMM.	BH


CERTIFIED

BY: _____ DATE: _____

NOZZLE:	CONNECTIONS:	FRONT HEAD (PIPE)	BACK HEAD (PIPE)	FRONT END	BACK END	BEVELS	MATERIALS:	STRUCTURAL:	TUBE SPACERS:
SC1 (INLET)	(2) 3" 300# - SCH XXH - RFWN	3" SCH XXH PIPE - 51.1875" (1)	3" SCH XXH PIPE - 51.1875" (1)			BBE	PLATE: SA 516-70N	SIDEFRAME: C 0.25" 16" 309.625	TUBE SPACERS REQD.: 52
	3" PIPE - SCH XXH - 2.25" LG - BBE	3" SCH XXH PIPE - 49.7500" (2)	3" SCH XXH PIPE - 49.7500" (2)			BOE	PIPE: SA 106B	SUPPORT: (5) - L 3 x 3 x .25	SCALLOPED CHANNELS:
	3" TEE - SCH XXH	3" SCH XXH PIPE - 51.1875" (1)	3" SCH XXH PIPE - 51.1875" (1)			BBE	FLANGE: SA-350-LF2	BINDER: (5) - L 2 X 2 X .25	1" X 1.5" PITCH
SC2 (OUTLET)	(2) 3" 300# - SCH XXH - RFWN	3" SCH XXH PIPE - 49.7500" (2)	3" SCH XXH PIPE - 49.7500" (2)			BOE	SIDE FRAME: A36	TP AIRSEAL: L SHAPE	ALUMINUM
	3" PIPE - SCH XXH - 2.25" LG - BBE	THICK	DIA				TUBE: SA-179	BTM AIRSEAL: L SHAPE	
	3" TEE - SCH XXH	0.5000	2.0500			45 ALL	FIN: ALUMINUM	LUG: A36 603 BOLTED	TOLERANCES:
		0.5000	2.0500			45 ALL	TEE: SA-350-LF2		LENGTH: ± 0.125
								HDR FINISH: SSPC SP 10	WIDTH: ± 0.125
								System 5 after hydro	TUBE PROJECTION: 0.0625 ± 0.125
								PER A8KM-PP-000-500520-A	
								SFR FINISH: HAND TOOL CLEAN	
								Galvanized	
								PER A8KM-PP-000-500540-A	
									DRY WEIGHT LBS: 6365
									HYDRO WEIGHT LBS: 6692

PROJECT NAME:	World Energy Renewables Project
PROJECT NO./UNIT:	EN-20-7119 / RFJU-B
CUSTOMER/CLIENT:	World Energy Paramount
EQUIPMENT OWNER:	Air Products Manufacturing LLC
ITEM NO.:	18-XF-354
SERVICE:	STEAM COIL FOR OFF SPEC PRODUCT COOLER
LOCATION:	World Energy, Paramount, CA, USA
PO NO.:	4505606036 / A8KM-4-406-PO-1
FABSCO JOB NO.:	A22-13312-6SC

DRAWING PROPRIETARY TO FABSCO, LLC AND IS NOT TO BE RELEASED TO ANY THIRD PARTY, EXCEPT WITH NOTIFICATION AND APPROVAL IN WRITING OF FABSCO, LLC OFFICER.		
DRAWN BY:	FABSCO, LLC	
BH		
DATE:	BUNDLE DETAIL - 18-XF-354 STEAM COIL	
03-16-2022		
CHECKED BY:	DRAWING NO:	REV:
	A22-13312-6SC-300	4

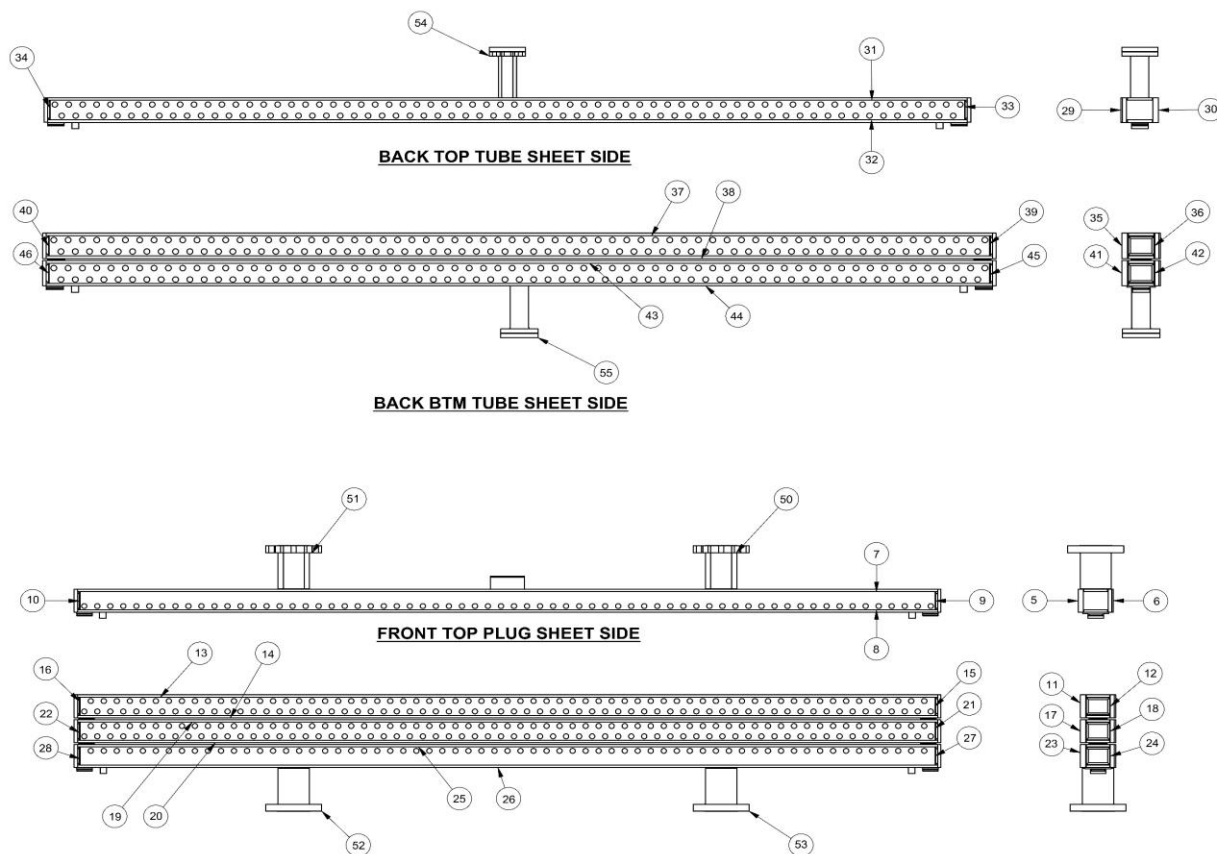

Mark No	MATERIAL DESCRIPTION		
	SUPPLIERS	HEAT No.	MATERIAL
5/6/11/12	SSAB	W3B536	SA-516-70N
7/8/13/14	CLEVELAND CLIFFS	823C61510	SA-516-70N
9/10	NUCOR	3604954	SA-516-70N
15/16	NUCOR	3604954	SA-516-70N
17/18	SSAB	W3B536	SA-516-70N
19/20	CLEVELAND CLIFFS	823C61510	SA-516-70N
21/22	NUCOR	3604954	SA-516-70N
23/24	SSAB	W3B536	SA-516-70N
25/26	CLEVELAND CLIFFS	823C61510	SA-516-70N
27/28	NUCOR	3604954	SA-516-70N
29/30	SSAB	W3B536	SA-516-70N
31/32	CLEVELAND CLIFFS	823C61510	SA-516-70N
33/34	NUCOR	3604954	SA-516-70N
35/36	SSAB	W3B536	SA-516-70N
37/38	CLEVELAND CLIFFS	823C61510	SA-516-70N
39/40	NUCOR	3604954	SA-516-70N
41/42	SSAB	W3B536	SA-516-70N
43/44	CLEVELAND CLIFFS	823C61510	SA-516-70N
45/46	NUCOR	3604954	SA-516-70N
50/51	GIBSON PRODUCTS	ZX50	SA-350LF2
54/55	GIBSON PRODUCTS	ZP44	SA-350LF2
TUBES	MANNESMANN	323090	SA-179
CUSTOMER: AIR PRODUCT MANUFACTURING LLC.		DATE	 FABSCO SHELL & TUBE, LLC
PO NO:	4505606036 / A8KM-4-406-PO-1		
ITEM NO:	18-XF-354	AC	
		DWG No	A22-13312-6A-HS 0



MTR 9423

Test Certificate

12400 Highway 43 North, Axis, Alabama 36505, US

⚠ WARNING: This product can expose you to chemicals including nickel and nickel compounds, which are known to the State of California to cause cancer. For more information go to www.P65Warnings.ca.gov.

Form TC1: Revision 5: Date 22 Aug 2022

Customer: LEECO STEEL PRODUCTS, INC. 1011 WARRENVILLE ROAD SUITE 500 LISLE IL 60532	Customer P.O.No.: V29753	Mill Order No. 41-698510-01	Shipping Manifest: AR374997
	Product Description: ASME SA516-70/SA516-65/SA516-60(21) ASTM A516-70/A516-65/A516-60(17) LCVN 20/15 FT.LBS @ -50F/A673-P CEV .43% MAX		Ship Date: 08 Mar 23 Cert Date: 08 Mar 23 Cert No: 081099417 (Page 1 of 1)
	Size: 1.000 X 96.00 X 480.0 (IN)		Heat Treat Type: NORMALIZED

Tested Pieces:				Tensiles:					Charpy Impact Tests											BDWTT Tmp %Shr	
Heat Id	Piece Id	Tested Thickness	Tst Loc	YS (KSI)	UTS (KSI)	%RA	Elong % 2in 8in	Tst Dir	Hardness	Abs. Energy(FTLB) 1 2 3 Avg				% Shear 1 2 3 Avg				Tst Tmp	Tst Dir		
W3B536	D26	1.008 (DISCRT)	C 52	76			47	T		37	85	66	63					-50F	L	10.	
Chemical Analysis																					
Heat Id	C	Mn	P	S	Si	Tot Al	Sol Al	Cu	Ni	Cr	Mo	Cb	V	Ti	B	IIW	ORIGIN				
W3B536	.19	1.00	.010	.001	.23	.032	.031	.33	.17	.12	.03	.005	.003	.010	.0003	.42	USA				
KILLED STEEL																					

ORGN
USA

KILLED STEEL
MERCURY IS NOT A METALLURGICAL COMPONENT OF THE STEEL AND NO MERCURY WAS INTENTIONALLY ADDED DURING THE MANUFACTURE OF THIS PRODUCT.
KILLED STEEL, PRODUCED TO A FINE GRAIN PRACTICE
CEV (IIW) = C + MN/6 + (CR+MO+V)/5 + (NI+CU)/15
NACE MR0175/ISO15156-2:2015 ANNEX A2.1.2 COMPLIANT
NACE MR0103/ISO 17495-1:2015 13.1.1(A) AND 13.1.1(C) COMPLIANT
MTR EN 10204:2004 INSPECTION CERTIFICATE 3.1 COMPLIANT
100% MELTED, POURED, AND ROLLED IN THE USA
NO WELD REPAIR HAS BEEN PERFORMED ON THIS MATERIAL.
NORMALIZED PLATES. HEATED AT 1665F FOR 45 MINUTES.
TEST COUPONS TAKEN FROM HEAT TREATED PLATE.
PRODUCTS SHIPPED:
W3B536 D26 40103304 PCS: 1, LBS: 13068

ANTHONY CARDWELL
02/28/2024

CEQ=.42

(P) Cust Part #:100096480A516-70N

WE HEREBY CERTIFY THAT THIS MATERIAL WAS
TESTED IN ACCORDANCE WITH, AND MEETS THE
REQUIREMENTS OF, THE APPROPRIATE SPECIFICATION

Jason Thomas

Director Technical Services

MTR 9376

Cleveland-Cliffs Burns Harbor LLC
QUALITY ASSURANCE REPORT OF TEST AND ANALYSIS

US HWY 12 Burns Harbor, Indiana

SHIPMENT NO. 802-40363		DATE SHIPPED 08-10-23		CAR OR VEHICLE NO. CN-CHGO-BNSF		CN 622239					
AMERICAN ALLOY STEEL INC PO BOX 40469 HOUSTON TX 77240				AMERICAN ALLOY STEEL INC C/O SKOL TRACK #21 6350 N ERIE AVE OWASSO, OK 74055							
SERIAL NUMBER	PAT NO.	HEAT NUMBER	NO. PCS.	THICKNESS	WIDTH OR DIA.	LENGTH	WEIGHT	YIELD POINT	TENSILE STRENGTH	AF FRAC. ELONG.	RED.

QUALITY STEEL MELTED & MANUFACTURED IN THE U. S. A.
PLATES - ASTM A516-17 Grade 70; FVQ Killed Fine Grain Practice; Plate:NORMALIZED & COOLED IN STILL AIR; VACUUM DEGASSED; CH-V SA2085 PLT
L 15/12 FT LBS AT -50F; ASTM A516-17 Grade 65; ASTM A516-17 Grade
60; ASME SA516 21ED Grade 70; A SME SA516 21ED Grade 65; ASME SA516
21ED Grade 60; TEST CERTS ARE PREPARED IN ACCORD WITH PROCEDURES
OUTLINED IN EN; 10204:2004 TYPE 3.1
NO WELD REPAIR WAS PERFORMED ON BELOW PLATE(S)

CO# 135379-OK GH 391-1366C

PLATES HEAT TREATED - TEST SPECIMENS ATTACHED & YIELD STRENGTH @ .5% EUL
MERCURY IN ANY FORM HAS NOT BEEN USED IN THE PRODUCTION OF THIS ORDER

C730043	823C61510	3	1/2	96	480	19602	52300	75500	8	25
				N 1650 DEG F - 24 MIN						

(M55)MFST REF#: (PART #)

C730044	823C61510	3	1/2	96	480	19602	53500	75800	8	26
				N 1650 DEG F - 24 MIN						

(M55)MFST REF#: (PART #)

C730045	823C61510	2	1/2	96	480	13068	53000	75700	8	25
				N 1650 DEG F - 24 MIN						

(M55)MFST REF#: (PART #)

Q-TREATMENT TEMPERATURE

T-TREATMENT TEMPERATURE

N-NOT MARKED TEMPERATURE
original, retained in our file.
AMERICAN ALLOY STEEL
Reviewed By:

08-20-23

SERIAL NUMBER	PAT NO.	HEAT NUMBER	HARD BHN	BEND	THICKNESS INCHES	TYPE	SIZE	D R	TEST TEMP F	ENERGY FT LBS	CHARPY IMPACT SHEAR(X)	LAT. EXP MILS
C730043		823C61510			.500	V FULL	L	-50	50	87	56	
C730044		823C61510			.500	V FULL	L	-50	108	130	121	
C730045		823C61510			.500	V FULL	L	-50	61	114	89	

HEAT NUMBER

CHEMICAL ANALYSIS

C	Mn	P	S	Si	Cl	Ni	Cr	Mo	V	Ti	Al	S	Ch	N	Sn	IMMEDIATE GRAIN SIZE
---	----	---	---	----	----	----	----	----	---	----	----	---	----	---	----	----------------------------

823C61510 .16 1.02 .018 .004 .329.220 .17 .03.004.001.002.029.0002 .002.004.001

CEQ=.43

I certify that the above results are a true and correct copy of actual results contained in records
maintained by Cleveland-Cliffs Burns Harbor LLC and are in full compliance with the requirements
of the specification cited above. This test report cannot be altered and must be transmitted intact
with any subsequent third party test reports, if required.SUPV. QUALITY ASSURANCE
Form BMLTR/PT-TR

MATERIAL CONFORMS TO

NACE MR0175

3HN 100 TO 150

CERTIFIED BY

AMERICAN ALLOY STEEL

BY PO DATE 10/28/2024

ANTHONY CARDWELL

02/28/2024

MICHAEL KAPUSTEN MNT

AMERICAN ALLOY
PLATE # 527987

MTR 9377

NUCOR
PLATE MILL GROUPP.O. Box 279
Winton, NC 27986
(252) 358-3700

Mill Test Report

1505 River Rd
Coffield, NC 27922
(252) 358-3700AMERICAN ALLOY
PLATE # 5282895

Issuing Date : 09/17/2023 B/L No. : 857581 Load No. : 876894 Our Order No. : 2081972 Cust. Order No. : 136394-OK

Vehicle No: SNC 62593 Sold To: AMERICAN ALLOY STEEL INC
6230 N HOUSTON ROSSLYN RD
PO BOX 40469
NORTH HOUSTON, TX 77091

Specification: 0.5000" x 120.000" x 480.000"
ASTM A516 70/65/60-17/ASME SA516-70/65/60 PVQ 2019/2021
Normalized Plate NACE MR0175 Annex 2.1.2 (2015), MR0103 (2010)
Section 2.1.2 Compliant (2015) 13.1.1, 13.1.2 Vacuum Degassed

Shipment To: AMERICAN ALLOY STEEL
6350 N ERIE AVE
C/O SKOL TRACK #21
OWASSO, OK 74055

Marking : 136394-OK

Heat No	C	Mn	P	S	Si	Cu	NI	Cr	Mo	Al(tot)	V	Nb	Ti	N	Ca	B	Sn	Ceq	Pcm
3604954	0.20	1.01	0.011	0.001	0.19	0.28	0.10	0.11	0.02	0.031	0.004	0.005	0.002	0.0074	0.0008	0.0002	0.008	0.42	0.28

Plate Serial No	Pieces	Tons	Dir.	Tensile Test				Heat Treat			
				Yield (psi)	Tensile (psi)	Elong. % in 2"	Elong. % in 8"	Norm (°F)	Time (min)	Temper (°F)	Time (min)
3604954-05	2	8.16	H-T	52,000	75,900	44.5		1650	23		
3604954-06	4	16.33	H-T	49,400	73,300	41.7		1650	23		

Plate Serial No	Pieces	Tons	Dir.	Absorbed Energy (Ft-lbs)				Min	Charpy Impacts				Shear (%)				Min	Temp (°F)	Size
				(Ft-lbs) 1	(Ft-lbs) 2	(Ft-lbs) 3	(Ft-lbs) Ave		(in.) 1	(in.) 2	(in.) 3	(in.) Ave	(in.) Min	(%) 1	(%) 2	(%) 3	(%) Ave		
3604954-05	2	8.16	H-L	81.9	110.7	51.9	74.8	15										-50	10mm
3604954-06	4	16.33	H-L	130.6	167.5	122.8	140.3	15										-50	10mm

CEQ=.42

MATERIAL CONFORMS TO

NACE MR0175

SHN 120 TO 146

CERTIFIED BY

AMERICAN ALLOY STEEL

BY PK DATE 11/9/23Certified a true copy of the
original, retained in our file.
AMERICAN ALLOY STEEL, INC.

Reviewed By:

PCV 1/23HOT ROLLED CARBON STEEL PLATE
TEST COUPONS TAKEN FROM HEAT TREATED PLATE
Piece frequency charpy:ANTHONY CARDWELL
02/28/2024

Manufactured to fully killed fine grain practice by Electric Arc Furnace. Welding or weld repair was not performed on this material.
Mercury has not been used in the direct manufacturing of this material. Produced as continuous cast discrete plate, unless otherwise noted
in Specification. For Mexico shipments: rnc-Sales.MX@nucor.com
Yield by 0.5ELU method unless otherwise specified. $Ceq = C + (Mn/5) + ((Cr+Mo+V)/5) + ((Cu+Ni)/15)$
 $Pcm = C + (Si/30) + (Mn/20) + (Cu/20) + (Ni/60) + (Cr/20) + (Mo/15) + (V/10) + 5B$
Melted and Manufactured in the USA. ISO 9001:2015 certified. PED 2014/68/EU, 97/23/EC 7/2 Annex 1, Para. 4.3 Compliant. API Q1-1851
DIN 50048-3.1/EN 10204-3.1(2004) 3.1B(1993)/DIN EN 10204-3.1(2005) compliant. ABS QA-3824366

We hereby certify that the contents of this report are accurate and correct. All test results and
operations performed by the material manufacturer are in compliance with the applicable
specifications, including customer specifications.

C. L. Cooper, Metallurgist

9/18/2023 11:27:54 AM



Gibson Products, Inc.
5691 SURREY SQUARE STREET
HOUSTON, TX 77017
Phone: (713) 941-4890

Material Test Report

50
51

23-13312-6 FL | | | ZX50 | LN: 1 | T0554179-1 | *GIBSON | |

Page: 1 of 4

SOLD TO: I.P.S.
P.O. BOX 581270
TULSA, OK 74158

SHIP TO: I.P.S.
606 NORTH 145TH EAST AVE.
TULSA, OK 74116

DATE	SALES ORDER #	CUST P.O. #	TAG NUMBER			
02/19/24	296886	TP842961X				
ITEM#	ITEM DESCRIPTION	SPEC/GRADE	QTY	HEAT CODE	HEAT NUMBER	STARTING MATERIAL
1	4" 600# RF LWN FLG X 9" LG	ASTM/ASME A/SA350 LF2 CL1	2	ZX50	281439	ASTM/ASME A/SA350 LF2/A/SA105 2021 ED.

CHEMICAL ANALYSIS

C	SI	MN	P	S	CR	NI	MO	CU	V	NB	CE	TI	
.204	.19	.98	.011	.002	.08	.07	.02	.09	.004	.001	.399	.002	

PHYSICAL PROPERTIES

Tensile (PSI)	Yield (PSI)	Elongation (2" or 4D)	Reduction of Area %	Hardness *BHN unless noted	Hardness 2	
74,000	46,000	29.8	70	187 HB	152 HB	

IMPACT TESTING

TYPE	TEMP	SMPL # 1	# 2	# 3	AVG	% SHEAR	LAT EXP
CHARPY1	-50 Deg. F	20 FT. LBS.	54 FT. LBS.	60 FT. LBS.	45 FT. LBS.	43-50-53	.033-.045-.050

SUPPLEMENTAL INFORMATION

NORMALIZED @ 890°C X 300' AIR. FINE GRAIN STEEL. FULLY KILLED Country of Origin: ITALY. IN ACCORDANCE WITH EN 10204 3.1.

WE CERTIFY THAT THE MATERIAL FURNISHED ON THIS ORDER COMPLIES WITH THE SPECIFICATIONS AS STATED. IAW GIBSON PRODUCTS Q.A. PROGRAM AND QUALITY MANUAL, COMPLYING WITH ISO 9001 AND PRESSURE EQUIPMENT DIRECTIVE (PED) REQUIREMENTS. THE ISSUE YEAR & ADDENDA FOR THE ABOVE DESCRIBED MATERIAL IS THE SAME AS THE STARTING MATERIAL UNLESS OTHERWISE NOTED.

ANTHONY CARDWELL
03/04/2024

Dawn Sexton
QUALITY ASSURANCE



Gibson Products, Inc.
5691 SURREY SQUARE STREET
HOUSTON, TX 77017
Phone: (713) 941-4890

Material Test Report

54
55

Page: 3 of 4

SOLD TO: I.P.S.
P.O. BOX 581270
TULSA, OK 74158

SHIP TO: I.P.S.
606 NORTH 145TH EAST AVE.
TULSA, OK 74116

DATE	SALES ORDER #	CUST P.O. #	TAG NUMBER			
02/19/24	296886	TP842961X				
ITEM#	ITEM DESCRIPTION	SPEC/GRADE	QTY	HEAT CODE	HEAT NUMBER	STARTING MATERIAL
3	2" 300# RF LWN FLG X 9" LG	ASTM/ASME A/SA350 LF2 CL1	2	ZP44	65809	ASTM/ASME A/SA350 LF2/A/SA105 2019 ED.

CHEMICAL ANALYSIS

C	SI	MN	P	S	CR	NI	MO	CU	V	NB	CE	TI
.190	.26	1.00	.009	.005	.07	.11	.03	.18	.002	.001	.40	.001

PHYSICAL PROPERTIES

Tensile (PSI)	Yield (PSI)	Elongation (2" or 4D)	Reduction of Area %	Hardness *BHN unless noted	Hardness 2
70,778	45,686	33.6	70	145 HB	156 HB

IMPACT TESTING

TYPE	TEMP	SMPL # 1	# 2	# 3	AVG	% SHEAR	LAT EXP
CHARPY1	-50 Deg. F	27 FT. LBS.	40 FT. LBS.	60 FT. LBS.	43 FT. LBS.	---	.024-.033-.048

SUPPLEMENTAL INFORMATION

NORMALIZED 1650°F HELD 4.0 HRS, AIR COOLED. Grain size 6-8 (fine grain) IN ACCORDANCE WITH EN 10204 3.1.

ANTHONY CARDWELL
03/04/2024

WE CERTIFY THAT THE MATERIAL FURNISHED ON THIS ORDER COMPLIES WITH THE SPECIFICATIONS AS STATED. IAW GIBSON PRODUCTS Q.A. PROGRAM AND QUALITY MANUAL, COMPLYING WITH ISO 9001 AND PRESSURE EQUIPMENT DIRECTIVE (PED) REQUIREMENTS, THE ISSUE YEAR & ADDENDA FOR THE ABOVE DESCRIBED MATERIAL IS THE SAME AS THE STARTING MATERIAL UNLESS OTHERWISE NOTED.

Dawn Sexton

QUALITY ASSURANCE



**MANNESMANN
PRECISION TUBES**
A Mannesmann Group Company

Inspection Certificate

Page 1 of:

2 Pages

acc to EN 10204/3.1

Certificate no.:

9220350

Purchaser: Webco Industries, Inc
74063 Sand Springs OK
Your order no.: 10075464
Manufacturer: Mannesmann Precision Tubes Netherlands B.V.
NL-Helmond
Our order no.: 3400033
Product: Seamless cold drawn low-carbon steel heat exchanger and condenser tubes
Specification: (S)A 179 / (S)A 450 / NACE MR0103-05 / NACE MR0175
Steelgrade: A 179 acc. to norm: A179 Edition: 2021
SA 179 SA179 2021
Marking: On tubes / On tags
Manufacturer's mark: MPT-HE
Process: Basic oxygen steel
Stamp of the mill's inspector: (Q-MPT NL)
Steelmarks: (S)A 179 + N
Shipping no.: 4400608
Our shipping date: 01-06-2022
Extent of the delivery:

Item	Numbers	Dimension	Heat no	Sample no.
30	405	1,000" OD x 0,109" MW x 26'0"	3209,64 m 5293 kg 323090	1-2

Shipping marks:

PO : 10075464
Item : 00003
Mat : A32010001090B
Quantity : 405pcs
Tag Nr. : PO# A22-13312 T-6
ASTM/ASME A/SA 179 SMLS
Grade 1010
OD: 1,0000" inches
Wall: 0.1090 inches MW Wall
Melting Western Europe
Hot finished tube fabrication in Germany
Cold drawn in The Netherlands
Max 1 heat per bundle - Max 1 heat per box

	C	Mn	P	S	Cr	Heat no
Requirements:	0,06-0,18	0,27-0,63	≤0,035	≤0,035		
Heat analysis (%)	0,15	0,51	0,011	0,001	0,04	323090

	Mo	V	Cu	Ni	Sn	Heat no
Requirements:						
Heat analysis (%)	0,01	0,001	0,02	0,03	0,001	323090

Heat treatment: Normalized at 920 °C

Remarks: It is certified that the products have been tested in accordance to purchase specifications and found satisfactory

Helmond(NL.) : 30-06-2022

Mannesmann Precision Tubes - NL
Inspector
B. van Lier

ANTHONY CARDWELL
10/24/2022



**MANNESMANN
PRECISION TUBES**
A Member of the ThyssenKrupp Group

Test results

Page 2 of:

2 Pages

Certificate no.:


9220350

1. Visual inspection and control of dimensions: OK
2. Eddy current test acc. to: E309: OK
3. Flattening test: OK
Flaring test: OK
4. Hardness test: OK



Mechanical data	Dimensions of the test tube mm	Hardness HRB
Requirements:		Max 72
1	25,40 x 2,95	88
2		67

Helmond: 30-06-2022

Mannesmann Precision Tubes - NL
Inspector
B. van Lier

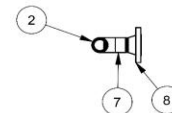

FRONT PLUG SHEET SIDE

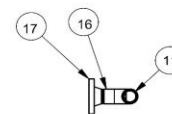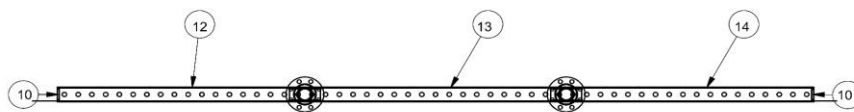[illegible]

NUCOR®
PLATE MILL GROUP

P.O.Box 279
Winton, NC 27986
(252) 356-3700

MTR 9574

Mill Test Report

Page 1

1505 River Rd
Cofield, NC 27922
(252) 356-3700

Issuing Date :	05/05/2023	B/L No. : 648011	Load No. : 666573	Our Order No. : 204829/1	Cust. Order No. : V30717
Vehicle No:	NOKL 725084		Sold To:	LEECO STEEL PRODUCTS 1011 WARRENVILLE RD STE 500 LISLE,IL 60532	Ship To: LEECO STEEL, LLC 8655 GOLDEN SPIKE LN HUDSON,TX 77064
Specification:	0.5000" x 96.000" x 480.000" ASTM A516 70/65/60/485-17/ASME SA516-70/65/60/485 PVQ 2019/2021 Normalized Plate NACE MR0175 Annex 2.1.2 (2015), MR0103 (2010) Section 2.1.2 (2015) 13.1.1, 13.1.2)Compliant				

Plate Serial No: 3602357-04-1-01

Marking : V30717

Heat No	C	Mn	P	S	Si	Cu	Ni	Cr	Mo	Al(tot)	V	Nb	Ti	N	Ca	B	Sn	Ceq	Pcm
3602357	0.19	1.06	0.008	0.001	0.18	0.13	0.07	0.13	0.02	0.036	0.003	0.001	0.002	0.0050	0.0027	0.0002	0.008	0.41	0.27

Plate Serial No	Pieces	Tons	Tensile Test					Heat Treat			
			Dir.	Yield (psi)	Tensile (psi)	Elong. % in 2"	Elong. % in 8"	Norm (°F)	Time (min)	Temper (°F)	Time (min)
3602357-04	1	3.26	H-T	49,600	74,300	44.7		1650	23		

Plate Serial No	Pieces	Tons	Dir.	Absorbed Energy (Ft-lbs)				Min	Lateral Expansion (in.)				Min	Shear (%)				Temp (°F)	Size
				(ft-lbs) 1	(ft-lbs) 2	(ft-lbs) 3	(ft-lbs) Ave		(in.) 1	(in.) 2	(in.) 3	(in.) Ave		(%) 1	(%) 2	(%) 3	(%) Ave		
3602357-04	1	3.26	H-L	69.5	74.1	105.6	83.1	20										-50	10mm

ANTHONY CARDWELL
03/04/2024

CEQ=.41

HOT ROLLED PLATE

Piece frequency charpy :

Manufactured to fully killed fine grain practice by Electric Arc Furnace. Welding or weld repair was not performed on this material. Mercury has not been used in the direct manufacturing of this material. Produced as continuous cast discrete plate, unless otherwise noted in Specification. For Mexico shipments: nbc-SalesMX@nucor.com

Yield by 0.5EUL method unless otherwise specified. Ceq = C+(Mn/6)+((Cr+Mo+V)/5)+((Cu+Ni)/15)

Pcm = C+(Si/30)+(Mn/20)+(Cu/20)+(Ni/60)+(Cr/20)+(Mo/15)+(V/10)+6B

Melted and Manufactured in the USA. ISO 9001:2015 certified. PED 2014/68/EU, 97/23/EC 7/2 Annex 1, Para. 4.3 Compliant. API Q1-1851
DIN 50049 3.1.B/EN 10204 3.1(2004) 3.1B(1993)/ DIN EN 10204 3.1(2005) compliant. ABS QA-3624366

We hereby certify that the contents of this report are accurate and correct. All test results and operations performed by the material manufacturer are in compliance with the applicable specifications, including customer specifications.



C. L. Cooper, Metallurgist

5/8/2023 8:17:25 AM



Certificate Q5377

CERTIFICADO DE CALIDAD No.: CERTIFIED TEST REPORT:	8905	LISTA DE EMPAQUE: PACKING LIST:	5349	FECHA: DATE:	JULIO 10 de 2002
VENDIDO A: SOLD TO:				PEDIDO DEL CLIENTE No. CUSTOMERS ORDER No.	EMBARCADO A: SHIP TO:

PRUEBAS MECÁNICAS

CANT.	COLADA HEAT CODE	DESCRIPTION	ESF. DE CEDENCIA YIELD STRENGTH (PSI)	ESF. RUPTURA TENSILE STRENGTH (PSI)	ELONGACION ELONGATION % 2"	DUREZA HARDNESS HB
6	FA5	CODO R.L. 3 X 90 CED XS	54356	70659	40	131
100	EK5	CODO R.L. 3 X 90 CED STD	52535	74785	36	129
25	CP5	CODO R.L. 3 1/2 X 90 CED XS	49576	68511	42	124
102	EG5	CODO 4 X 45 CED STD	52322	72423	41	131
1	VS4	CODO 4 X 45 CED STD	47501	76367	30	133
177	ZF4	CODO 4 X 45 CED STD	57165	81017	30	141
59	SU3	CODO 4 X 45 CED XS	47456	74394	35	120
42	YV4	CODO 4 X 45 CED XS	53957	72621	34	136
19	BQ5	CODO 4 X 45 CED XS	47856	72240	33	139
43	TU4	CODO 5 X 45 CED STD	58488	76958	30	139
7	BP5	CODO 5 X 45 CED STD	52668	80933	31	132

ANÁLISIS QUÍMICO

COLADA HEAT CODE	C.E.	C	Mn	P	S	Si	Cr	Cu	Mo	Ni	V	Nb
FA5	0.302	0.170	0.660	0.008	0.003	0.280	0.050	0.076	0.023	0.040	0.000	0.000
EK5	0.336	0.190	0.710	0.008	0.003	0.280	0.060	0.064	0.042	0.040	0.000	0.000
CP5	0.305	0.170	0.670	0.007	0.003	0.270	0.050	0.066	0.029	0.040	0.000	0.000
EG5	0.316	0.180	0.660	0.006	0.002	0.290	0.050	0.079	0.042	0.040	0.000	0.000
VS4	0.354	0.185	0.793	0.011	0.001	0.339	0.055	0.058	0.050	0.169	0.004	0.000
ZF4	0.327	0.185	0.768	0.007	0.000	0.338	0.034	0.032	0.019	0.020	0.002	0.000
SU3	0.297	0.178	0.664	0.014	0.000	0.264	0.026	0.040	0.002	0.001	0.002	0.000
YV4	0.299	0.155	0.727	0.003	0.002	0.358	0.044	0.096	0.021	0.040	0.006	0.000
BQ5	0.298	0.170	0.660	0.008	0.004	0.270	0.040	0.052	0.021	0.030	0.000	0.000
TU4	0.343	0.190	0.786	0.006	0.000	0.344	0.036	0.048	0.011	0.128	0.002	0.000
BP5	0.325	0.180	0.770	0.010	0.002	0.290	0.030	0.076	0.020	0.026	0.001	0.001

LOS PRODUCTOS MANUFACTURADOS POR EMPRESAS RIGA, S.A. de C.V. ESTÁN CONFORME A LAS SIGUIENTES ESPECIFICACIONES:

CC-008

PRODUCTS MANUFACTURED BY EMPRESAS RIGA, S.A. de C.V. ARE CONFORMING TO FOLLOWING SPECIFICATIONS:

STARTING MATERIAL SEAMLESS PIPE ASTM A 106 GRADE B. ACCORDING TO DIN 50019/3.1. B / EN 10204/3.1. B

ASTM A 234 / ASME SA 234 WPB, ASME B16.9, ASME B16.28 AND NACE MR 0175.

CONEXIONES SIN COSTURA, FORJADO EN CALIENTE Y NORMALIZADO
SEAMLESS FITTINGS, HOT FORMED AND NORMALIZED

GERENTE DE ASEGURAMIENTO DE CALIDAD:

QUALITY ASSURANCE MANAGER:

ING. JOSE MARTINEZ NAJAS.

e-mail jmartinez@empresasriga.com

ANTHONY CARDWELL
03/04/2024

Benteler Stahl/Rohr GmbH
Postfach 13 40
33043 Paderborn
Deutschland
Tel.: +49.5254.81-0 Fax: +49.5254.13666

INSPECTION CERTIFICATE EN 10204-3.1 EN 10204:2005-01 Benteler Stahl/Rohr GmbH - Postfach 1340 - 33043 Paderborn - Deutschland	Document No.:	465-1416815/001/E	Inspection No.:	Page: 1 / 3
	Purchase Order No.:	10P42267	Manufacturer:	BSTMC Shreveport USA
	Benteler Order No.:	48010036	Manufacturer's brand:	
	Dispatch Note No.:		Stamp of the inspection representative:	MI
	Product:	SEAMLESS STEEL TUBES	Steelmaking process:	ELECTRIC FURNACE

Terms of delivery:	ASTM-A 53-2020, ASME SA-53, ASME BPVC.II.A-2021, ASTM-A 106-19a, ASME SA-106, ASME BPVC.II.A-2021, API Specification 5L Forty-Sixth Edition April 2018 incl. Errata 1, May 2018, PSL 2, ANSI/NACE MR0175/ISO 15156-1: 2020, ANSI/NACE MR0175/ISO 15156-2: 2020, ANSI/NACE MR0103/ISO 17945:2015
Dimensions-tolerances:	ASTM-A 106-19a, ASME SA-106, ASME BPVC.II.A-2021, ASTM-A 53-2020, ASME SA-53, ASME BPVC.II.A-2021, API Specification 5L Forty-Sixth Edition April 2018 incl. Errata 1, May 2018
Steel grade:	GRADE B, GRADE C, GRADE BN, GRADE X42N
Delivery condition:	N
Product marking:	FS: BENTELER BENTELER-Sign API 5L-1072 API-Sign Month/Year Conditions Dimension: O.D. * t inch Steel Grade PSL2 SMLS Heat No. Tube length feet Test Pressure PSI Production No. Customer's material no.

AEZ = Etching ink marking FK = color marking FS = paint stenciling FSD = Color jet printer FSI = Color jet printer inside LK = Laser marking PKE = tag marking PS = die stamp TS = Ink jet spray marking

Item	Dimensions	Heat No.	Test pressure	
			PSI	sec
0005	3 NPS - XXS 35,000 FT - 45,000 FT	316423	2970	5

Country of melt and pour

Melted & Manufactured in USA
Nucor, Jewett, TX, US

Heat analysis [%]

Item	Heat No.	C	SI	MN	P	S	CR	MO	NI	CU	V	NB	TI	B
0005	316423	0.180	0.254	1.00	0.012	0.005	0.15	0.04	0.09	0.18	0.004	0.001	0.002	0.0003

1. Formula: $CE_{IIW} = C + (Mn/6) + ((Cr + Mo + V)/5) + ((Cu + Ni)/15) \leq 0.43 \%$
2. Formula: $Cr + Cu + Mo + Ni + V \leq 1.00 \%$
3. Formula: $Nb + V \leq 0.06 \%$
4. Formula: $Nb + Ti + V \leq 0.15 \%$

ANTHONY CARDWELL
03/04/2024

Formula results

Item	Heat No.	1. Formula	2. Formula	3. Formula	4. Formula
0005	316423	0,403	0,464	0,005	0,007

Product analysis [%]

Item	Heat No.	C	SI	MN	P	S	CR	MO	NI	CU	V	NB	TI	B
0005	316423	0.150	0.260	0.96	0.012	0.003	0.13	0.04	0.09	0.18	0.004	0.001	0.003	0.0002
0005	316423	0.160	0.260	0.96	0.012	0.004	0.14	0.04	0.08	0.18	0.004	0.001	0.003	0.0002

1. Formula: $CE_{IIW} = C + (Mn/6) + ((Cr + Mo + V)/5) + ((Cu + Ni)/15) \leq 0,43 \%$
2. Formula: $Cr + Cu + Mo + Ni + V \leq 1.00 \%$
3. Formula: $Nb + V \leq 0.06 \%$
4. Formula: $Nb + Ti + V \leq 0.15 \%$

Formula results

Item	Heat No.	1. Formula	2. Formula	3. Formula	4. Formula
0005	316423	0,363	0,444	0,005	0,008
0005	316423	0,374	0,444	0,005	0,008

Test results

The tubes have been submitted to a leak tightness test by:	Hydrostatic test: acc. to API 5L, Test pressure/Time-record, the test records/charts shall be available for examination by the inspector	PASSED
The tubes are non destructive tested:	ET - Test standard: acc. to API 5L; ET - Test method: acc. to ASTM-E 309; ET - Test drilled hole: 0,125 IN.; ET - Notch shape/hole: drilled hole	PASSED
Visual inspection:	PASSED	Dimensions examination: PASSED

Results of mechanical testing

Tensile test longitudinal at RT, Strip test specimen

Item	Specimen No.	Heat No.	Specimen dimensions	Yield strength	Tensile strength	Elongation	1. Formula	Rt 0,5/Rm
Requirements			IN	RT 0,5 % PSI 42100-71800	Rm PSI 70000-95000	A2" %		MAX 0,93
0005	000011	316423	0,750 X 0,585	48153	75565	44,00	37,00	0,64

Elongation formula

1. Formula $AF = 625000 * AXC^{0,2} / U^{0,9}$

Protection

outside surface varnished

Item	Heat No.	Production No.
0005	316423	15030660

Remark

NACE Standard: Hardness acc. to ANSI/NACE MR0175/ISO 15156: HRC max 22 as per ASTM A370 table 2&3., Hardness acc. to ANSI/NACE MR0103/ISO 17945: HRC max. 22 as per ASTM A370 table 2&3.; Certificate remarks: material free from mercury contamination, Data converted from SI units, No weld repair has been carried out;
Certificate-Remark: LONGHORN

BENTELER Steel/Tube
1 Benteler Drive|Shreveport|LA 71115|USA
Tel. +1 318-216-4149
qms.shreveport@benteler.com

INSPECTION CERTIFICATE EN 10204-3.1 EN 10204 2005-01	Document No.: 465-1270937/001/P	Inspection No.:	Page: 1 / 3
	Purchase Order No.: 10965	Manufacturer: BSTMC Shreveport USA	
	Benteler Order No.: 48002112	Manufacturer's brand: 	
	Dispatch Note No.:	Stamp of the inspection representative: MI	
	Product: SEAMLESS STEEL TUBES	Steelmaking process: ELECTRIC FURNACE	

Terms of delivery:	ASTM-A 53-2018, ASME SA-53, ASME BPVC.II.A-2019, ASTM-A 106-19a, ASME SA-106, ASME BPVC.II.A-2019, API Specification 5L Forty-Sixth Edition April 2018 incl. Errata 1, May 2018, PSL 2, ANSI/NACE MR0175/ISO 15156-1 2015, ANSI/NACE MR0175/ISO 15156-2 2015, ANSI/NACE MR0103/ISO 17945 2015
Dimensions-tolerances:	ASTM-A 106-19a, ASME SA-106, ASME BPVC.II.A-2019, ASTM-A 53-2018, ASME SA-53, ASME BPVC.II.A-2019, API Specification 5L Forty-Sixth Edition April 2018 incl. Errata 1, May 2018
Steel grade:	GRADE B, GRADE C, GRADE BN, GRADE X42N
Delivery condition:	N
Product marking:	FS: BENTELER BENTELER-Sign API 5L-1072 API-Sign Month/Year Conditions Dimension: O.D. * t inch Steel Grade PSL2 SMLS Inspector's sign Heat No. Tube length feet Test Pressure PSI Production No. Customer's material no.

AEZ = Etching ink marking FK = color marking FS = paint stenciling FSD = Color jet printer FSI = Color jet printer inside LK = Laser marking PKE = tag marking PS = die stamp TS = Ink jet spray marking

Item	Number	Dimensions	Length total feet	Weight lbs	Heat No.	Test pressure PSI	sec
0007	52	3 NPS - XXS 35 FT - 45 FT	2134.62	40082	309901	2970	5

Country of melt and pour
Melted & Manufactured in USA
Nucor, Jewett, TX, US

Heat analysis [%]														
Item	Heat No.	C	SI	MN	P	S	CR	MO	NI	CU	V	NB	TI	B
0007	309901	0.160	0.262	0.98	0.007	0.007	0.10	0.02	0.06	0.17	0.005	0.0000	0.002	0.0002

- 1. Formula: $CE_{IIW} = C + (Mn/6) + ((Cr+Mo+V)/5) + ((Cu+Ni)/15) \leq 0.43 \%$
- 2. Formula: $Cr+Cu+Mo+Ni+V \leq 1.00 \%$
- 3. Formula: $Nb+V \leq 0.06 \%$
- 4. Formula: $Nb+Ti+V \leq 0.15 \%$

BENTELER Steel/Tube
1 Benteler Drive|Shreveport|LA 71115|USA
Tel. +1 318-216-4149
qms.shreveport@benteler.com

INSPECTION CERTIFICATE EN 10204-3.1

Document No.:

465-1270937/001/P

Inspection No.:

Page: 2 / 3

Formula results

Item	Heat No.	1. Formula	2. Formula	3. Formula	4. Formula
0007	309901	0.364	0.333	0.009	0.007

Product analysis [%]

Item	Heat No.	C	SI	MN	P	S	CR	MO	NI	CU	V	NB	TI	B
0007	309901	0.170	0.280	0.96	0.009	0.007	0.10	0.02	0.06	0.16	0.004	0.001	0.002	0.0001
0007	309901	0.170	0.280	0.96	0.009	0.008	0.10	0.02	0.06	0.16	0.004	0.001	0.002	0.0001

1. Formula: $CE_{IIW} = C + (Mn/6) + ((Cr+Mo+V)/5) + ((Cu+Ni)/15) \leq 0.43 \%$
2. Formula: $Cr+Cu+Mo+Ni+V \leq 1.00 \%$
3. Formula: $Nb+V \leq 0.06 \%$
4. Formula: $Nb+Ti+V \leq 0.15 \%$

Formula results

Item	Heat No.	1. Formula	2. Formula	3. Formula	4. Formula
0007	309901	0.369	0.344	0.005	0.007
0007	309901	0.369	0.344	0.005	0.007

Test results

The tubes have been submitted to a leak tightness test by:	Hydrostatic test: acc. to API 5L, Test pressure/Time-record, the test records/charts shall be available for examination by the inspector	PASSED
The tubes are non destructive tested:	ET - Test standard: acc. to API 5L; ET - Test method: acc. to ASTM-E 309; ET - Test drilled hole 0.125 IN.; ET - Notch shape/hole: drilled hole	PASSED
Visual inspection:	PASSED	Dimensions examination: PASSED

Results of mechanical testing

Tensile test longitudinal at RT, Strip test specimen

Item	Specimen No.	Heat No.	Specimen dimensions	Yield strength	Tensile strength	Elongation	1. Formula	Rt 0.5/Rm
Requirements			IN	RT 0.5 % PSI 42100-71800	Rm PSI 70000-95000	A2+ %		MAX 0.93
0007	000011	309901	0.749 X 0.615	48733	75565	41.00	23.00	0.64

Elongation formula

1. Formula: $AF = 625000 \cdot AXC^{0.2} / U^{0.9}$

BENTELER Steel/Tube
 1 Benteler Drive|Shreveport|LA 71115|USA
 Tel.: +1 318-216-4149
 qms.shreveport@benteler.com

INSPECTION CERTIFICATE EN 10204-3.1

Document No.:

465-1270937/001/P

Inspection No.:

Page: 3 / 3

Protection

outside surface varnished

Item	Heat No.	Production No.
------	----------	----------------

0007	309901	18019710
------	--------	----------

Remark

NACE Standard: Hardness acc. to ANSI/NACE MR0175/ISO 15156 HRC max 22., Hardness acc. to ANSI/NACE MR0103/ISO 17945 HRC max. 22., Certificate remarks material free from mercury contamination, Data converted from SI units, No weld repair has been carried out, Certificate-Remark: LONGHORN

Mill Test Reports
 For PO# _____
 Dixie Pipe Sales, Inc.

Plant 465, 1 BENTELER DRIVE, LA 71115 Shreveport, 08/02/2021, TEL.: 0318-216-4149

Inspection representative
 Pidicheti / KM

We certify that the supplied product has been processed, sampled, tested, and inspected in accordance with the agreed specifications and/or references mentioned herein and meet the requirements for the grade indicated. This document was prepared by means of electronic data processing and is valid without signature.

BEN188 / 309901 / 3.0A106XXHD / 3 XXH A106B SMLS PIPE

BENTELER Steel/Tube
1 Benteler Drive|Shreveport|LA 71115|USA
Tel.: +1 318 780 9545
qms.shreveport@benteler.com

Steel/Tube

INSPECTION CERTIFICATE EN 10204-3.1

EN 10204:2005-01

Document No.: 465-1020339/001/P
Purchase Order No.: 1284-00
Benteler Order No.: 48000372
Dispatch Note No.:
Product: SEAMLESS STEEL TUBES

Inspection No.: Page: 1 / 3
Manufacturer: BSTMC Shreveport USA
Manufacturer's brand: 
Stamp of the inspection representative: MI
Steelmaking process: ELECTRIC FURNACE

Terms of delivery: ASTM-A 53-2012, ASME SA-53, ASME BPVC.II.A-2015, ASTM-A 106-2015, ASME SA-106, ASME BPVC.II.A-2015, API Specification 5L Forty-Fifth Edition, December 2012 incl. Errata (2015), PSL 2, ANSI/NACE MR0175/ISO 15156-1: 2015, ANSI/NACE MR0175/ISO 15156-2:

2015, NACE Standard MR0103-2010

Dimensions-tolerances: ASTM-A 106-2015, ASME SA-106, ASME BPVC.II.A-2015, ASTM-A 53-2012, ASME SA-53, ASME BPVC.II.A-2015, API Specification 5L Forty-Fifth Edition, December 2012 incl. Errata (2015)

Steel grade: GRADE B, GRADE C, GRADE BN, GRADE X42N

Delivery condition: N

Product marking: FS: BENTELER BENTELER-Sign API 5L-1072 API-Sign Month/Year Conditions Dimension: O.D. * t inch Steel Grade
PSL2 SMLS Inspector's sign Heat No. Tube length feet Test Pressure PSI Customer's material no. Dimension: NPS
inch Weight Class Productio No.

AEZ = Etching ink marking FK = color marking FS = paint stenciling FSD = Color jet printer LK = Laser marking PKE = tag marking PS = die stamp TS = Ink jet spray marking

Item	Number	Dimensions	Length total feet	Weight lbs	Heat No.	Test pressure PSI sec	
0017	201	3 NPS - XXS 38 FT - 42 FT	8028.45	148955	302142	2970	5

Heat analysis [%]

Item	Heat No.	C	SI	MN	P	S	CR	MO	NI	CU	V	NB	TI	B
0017	302142	0.170	0.260	0.98	0.010	0.003	0.06	0.01	0.04	0.09	0.005	0.003	0.002	0.0004

1. Formula: $CE_{I\&W} = C + (Mn/6) + ((Cr+Mo+V)/5) + ((Cu+Ni)/15) \leq 0.43\%$

2. Formula: $Cr+Cu+Mo+Ni+V \leq 1.00\%$

3. Formula: $Nb+V \leq 0.06\%$

4. Formula: $Nb+Ti+V \leq 0.15\%$

Formula results

Item	Heat No.	1. Formula	2. Formula	3. Formula	4. Formula
0017	302142	0.357	0.205	0.008	0.010

INSPECTION CERTIFICATE EN 10204-3.1

Document No.:

465-1020339/001/P

Inspection No.:

Page: 2 / 3

Product analysis [%]

Item	Heat No.	C	SI	MN	P	S	CR	MO	NI	CU	V	NB	TI	B
0017	302142	0.170	0.260	0.92	0.010	0.004	0.06	0.01	0.04	0.09	0.004	0.001	0.003	0.0003
0017	302142	0.170	0.260	0.92	0.010	0.004	0.06	0.01	0.04	0.09	0.004	0.001	0.003	0.0003

1. Formula: $CE_{IW} = C + (Mn/6) + ((Cr + Mo + V)/5) + ((Cu + Ni)/15) \leq 0.43 \%$ 2. Formula: $Cr + Cu + Mo + Ni + V \leq 1.00 \%$ 3. Formula: $Nb + V \leq 0.06 \%$ 4. Formula: $Nb + Ti + V \leq 0.15 \%$

Formula results

Item	Heat No.	1. Formula	2. Formula	3. Formula	4. Formula
0017	302142	0.347	0.204	0.005	0.008
0017	302142	0.347	0.204	0.005	0.008

Test results

The tubes have been submitted to a leak tightness test by:
 available for examination by the inspector

Hydrostatic test: acc. to API 5L, Test pressure/Time-record, the test records/charts shall be

PASSED

The tubes are non destructive tested:

UT-Test standard: acc. to API 5L; longitudinal testing; UT-Test method: acc. to ASTM-E 213;
 UT-Outside notch depth: 12.5 %; UT-Inside notch depth: 12.5 %; UT-Notch length max: 2.000 IN.;
 UT-Notch width max: 0.040 IN.

PASSED

Visual inspection:

PASSED

Dimensions examination:

PASSED

Results of mechanical testing

Tensile test longitudinal at RT, Strip test specimen

Item	Specimen No.	Heat No.	Specimen dimensions	Yield strength	Tensile strength	Elongation	1. Formula	Rt 0,5/Rm
Requirements			in	RT 0,5 % PSI 42100-71800	Rm PSI 70000-95000	A2" %		MAX 0.93
0017	00001N	302142	0.75 X 0.61	44817	70198	42.00	23.00	0.64

Elongation formula

1. Formula $AF = 625000 \cdot AXC^{0,2} / U^{0,9}$

Protection

outside surface varnished

INSPECTION CERTIFICATE EN 10204-3.1

Document No.:

465-1020339/001/P

Inspection No.:

Page: 3 / 3

Item	Heat No.	Production No.
0017	302142	15004195

Remark

NACE Standard: Hardness acc. to ANSI/NACE MR0175/ISO 15156: HRC max 22., Hardness acc. to Standard MR0103 HRC max. 22.; Certificate remarks: Data converted from SI units Steel Mill Nucor – Jewett, Texas USA; Melted and Manufactured in the USA; Of Domestic Origin-USA

Shreveport, 08-01-2017, TEL.: PROGRAMME SUPPORT/SERVICE

Inspection representative

Pidicheti /Hudson

We certify that the supplied products comply with the order specification. This document was prepared by means of electronic data processing and is valid without signature.

CLIENTE / Customer / Client

CERTIFICADO DE INSPECCION

Inspection Certificate - Certificat de Réception

FECHA:
Date: 09/06/2023N.º
No. 225662HOJA:
Page: 1

Company management certifications:

ISO 9001: 2015
ISO 14001: 2015
ISO 45001: 2018

ULMA FORJA, S.COOP.

Management Systems certified by LRQA

Certified acc. PED 2014/68/EU-AD2000-W0
by TÜV Rheinland
N.º 01 202 E/Q 02 7443
UNE EN 10204 06 / 3.1
ISO 10474.13 / 3.1Bº Zubillaga, 3 - Apdo. 14
20560 ONATI (Gipuzkoa) SPAIN
Tel.: 34 - 943 780552
Fax: 34 - 943 781808
E-mail: ulma@ulmatorge.comMARCA DEL FABRICANTE
Mark of factory
Marque du fabricantPacking List: 176871
Expedition: 430334PRODUCTO
Article - Produit

FLANGES

SU PEDIDO N.º
Your Order No. 338406-408
Votre Cde. N.ºDE
of - de 12/12/2022NORMAS APLICABLES
Requirements - Normes Applicables

ASME B16.5-20

MATERIAL CORRESPONDIENTE
Material Correspondent - QualitéASME SA350LF2CL1-2-21, ASTM A350LF2CL1-2-23
ASME SA105N-17, ASTM A105N-18

MODO DE FUSION (*)

Steel Making - Elaboration de l'acier
E = Elec. Y = Oxígeno básico

ANSI/NACE MR0175-2021/ISO 15156:2020 & ANSI/NACE MR0103/ISO 17495:2015

DEPARTAMENTO
Section
Département

QUALITY ASSURANCE

PARTIDA Item Poste	CANTIDAD Quantity Quantité	DESCRIPCION Description Description	OBSERVACIONES Remarks Observations (*)	COLADA N.º Heat No N.º Coudée	RESISTENCIA T.Strength Resist Rupt N/mm2	LIMITE ELAST. Y.Strength 0.2 % N/mm2	ALARGAM. Elongation Lo/50mm4el %	ESTRICCION Red. Area Striction %	RESILIENCIA Impact test Résilience Joules	PENET. 50/163 CHARPY V 10x10mm			DUREZA Hardness Dureté HBW	
1 1-M---FF721AAA	60	WN 1 150LB XS/80 RF A350LF2	05Y315 NE	M2AV22	519	319	37,20	78,99	86	73	75	78	-50	146 149
16 6-I---FF723AAA	271	WN 6 300LB STD/40 RF A350LF2	20M322 NE	006A23	523	328	36,93	71,20	86	84	73	81	-50	143 144
16 6-I---FF723AAA	137	WN 6 300LB STD/40 RF A350LF2	17M303 NE	05HC23	511	320	35,61	74,31	78	89	84	84	-50	142 146
55	→ 1	WN 3 300LB XXS RF A350LF2	15N226 NE	18EE22	506	318	40,48	68,45	39	45	34	39	-50	140 141

COLADA N.º Heat No Ladle: L Product: P		COMPOSICION QUIMICA - STEEL MAKER'S LADLE ANALYSIS - ANALYSE CHIMIQUE																Origin of Steel
		C %	Si %	Mn %	P %	S %	Cr %	Ni %	Mo %	Nb %	V %	Cu %	Al %	Ti %	Ca %	B %	CEq %	
M2AV22	L	0,185	0,230	1,080	0,007	0,003	0,140	0,120	0,040	0,001	0,003	0,160	0,029	0,002	0,002	0,0001	0,42	Italy
006A23	L	0,190	0,198	1,203	0,011	0,002	0,066	0,061	0,016	0,001	0,002	0,091	0,032	0,001	0,002	0,0002	0,42	Germany
05HC23	L	0,184	0,227	1,199	0,009	0,008	0,073	0,067	0,013	0,001	0,002	0,092	0,023	0,001	0,002	0,0003	0,41	Germany
18EE22	L	0,182	0,240	1,073	0,010	0,006	0,054	0,074	0,030	0,003	0,000	0,149	0,022	0,001	0,001	0,0001	0,39	Italy

- Las dimensiones y la condición superficial se hallaron satisfactorias.
- Dimension and surface condition were found acceptable.
- Les dimensions et états de surface sont satisfaisants.

- Los materiales citados cumplen las normas aplicables.
- Manufacturing requirements are satisfied.
- Les normes applicables sont respectées.

EL INSPECTOR
Works Inspector - L'InspecteurULMA FORJA, S.COOP.
Dpto. de Garantía de calidad
Quality Assurance Dept.(*) OBSERVACIONES:
Remarks
ObservationsALL FLANGES MANUFACTURED IN ULMA, SPAIN.
N.º NORMALIZED ABOVE 900°C AND COOLED IN AIR.

A. ASTIGARRAGA/QA MANAGER



**MANNESMANN
PRECISION TUBES**
A Mannesmann Group Company

Inspection Certificate

Page 1 of:

2 Pages

acc to EN 10204/3.1

Certificate no.:

9220350

Purchaser: Webco Industries, Inc
74063 Sand Springs OK
Manufacturer: Mannesmann Precision Tubes Netherlands B.V.
NL-Helmond
Product: Seamless cold drawn low-carbon steel heat exchanger and condenser tubes
Specification: (S)A 179 / (S)A 450 / NACE MR0103-05 / NACE MR0175
Steelgrade: A 179 acc. to norm: A179 Edition: 2021
SA 179 SA179 2021
Marking: On tubes / On tags

Your order no.: 10075464

Our order no.: 3400033

Manufacturer's mark: MPT-HE

Process: Basic oxygen steel

Stamp of the mill's inspector: (Q-MPT NL)

Steelmarks: (S)A 179 + N

Shipping no.: 4400608

Our shipping date: 01-06-2022

Extent of the delivery:

Item	Numbers	Dimension	Heat no	Sample no.
30	405	1,000" OD x 0,109" MW x 26'0"	3209,64 m 5293 kg 323090	1-2

Shipping marks:

PO : 10075464
Item : 00003
Mat : A32010001090B
Quantity : 405pcs
Tag Nr. : PO# A22-13312 T-6
ASTM/ASME A/SA 179 SMLS
Grade 1010
OD: 1,0000" Inches
Wall: 0.1090 inches MW Wall
Melting Western Europe
Hot finished tube fabrication in Germany
Cold drawn in The Netherlands
Max 1 heat per bundle – Max 1 heat per box

	C	Mn	P	S	Cr	Heat no
Requirements:	0,06-0,18	0,27-0,63	≤0,035	≤0,035		
Heat analysis (%)	0,15	0,51	0,011	0,001	0,04	323090

	Mo	V	Cu	Ni	Sn	Heat no
Requirements						
Heat analysis (%)	0,01	0,001	0,02	0,03	0,001	323090

Heat treatment: Normalized at 920 °C

Remarks: It is certified that the products have been tested in accordance to purchase specifications and found satisfactory

Helmond(NL.) : 30-06-2022

Mannesmann Precision Tubes - NL
Inspector
B. van Lier

ANTHONY CARDWELL
10/24/2022



**MANNESMANN
PRECISION TUBES**
A Member of the ThyssenKrupp Group

Test results

Page 2 of:

2 Pages

Certificate no.:

9220350

1. Visual inspection and control of dimensions: OK
2. Eddy current test acc. to: E309: OK
3. Flattening test: OK
Flaring test: OK
4. Hardness test: OK

Mechanical data	Dimensions of the test tube mm	Hardness HRB
Requirements:		Max 72
1	25,40 x 2,95	88
2		67

Helmond: 30-06-2022

Mannesmann Precision Tubes - NL
Inspector
B. van Lier