
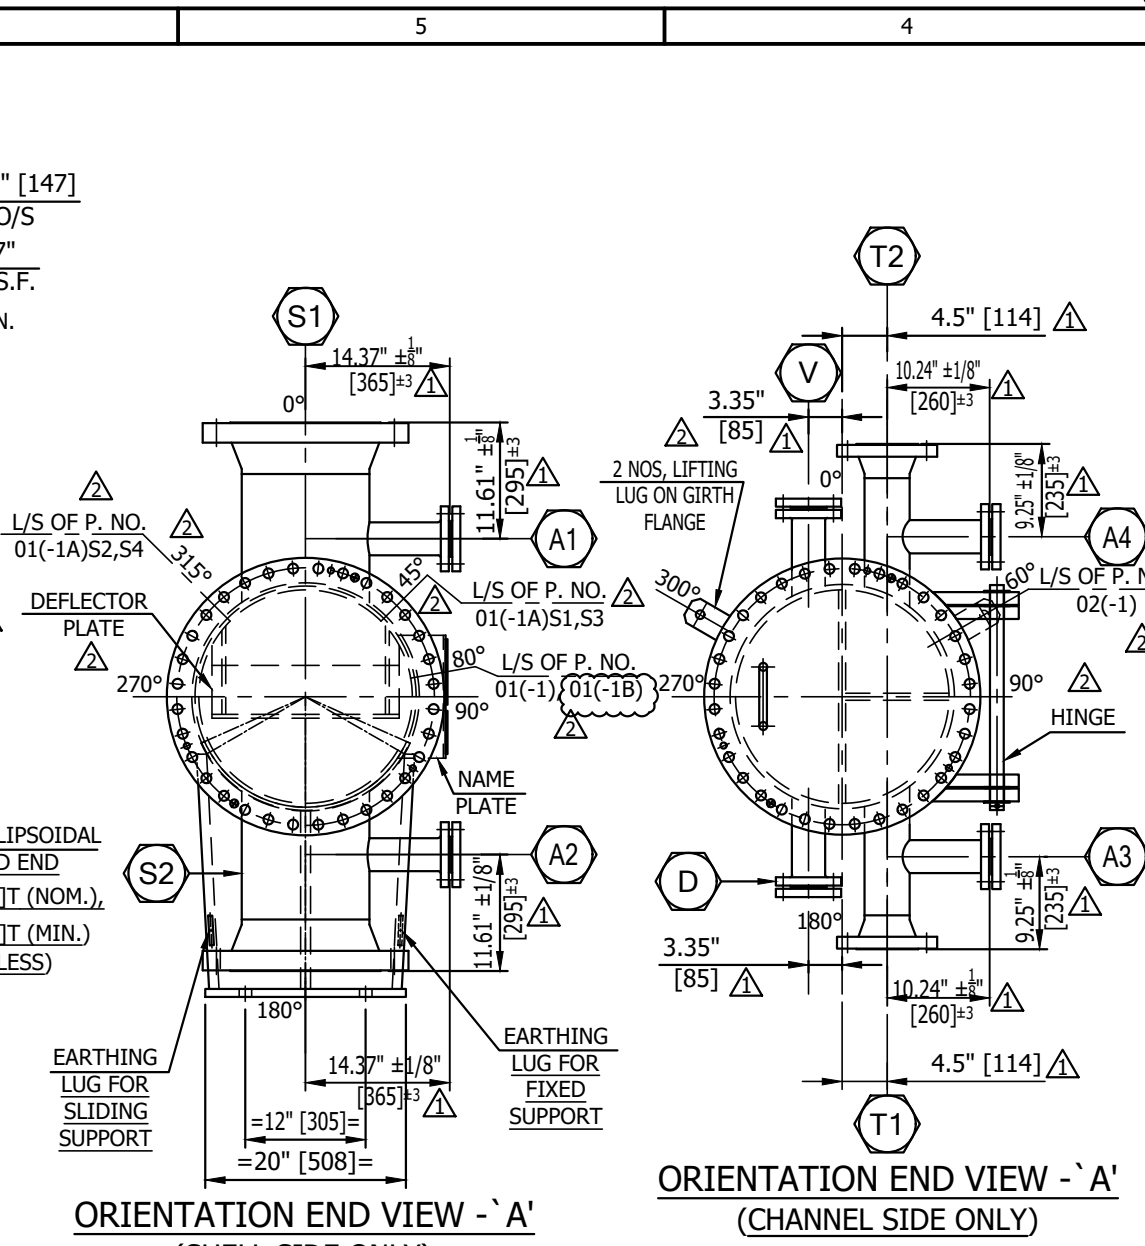
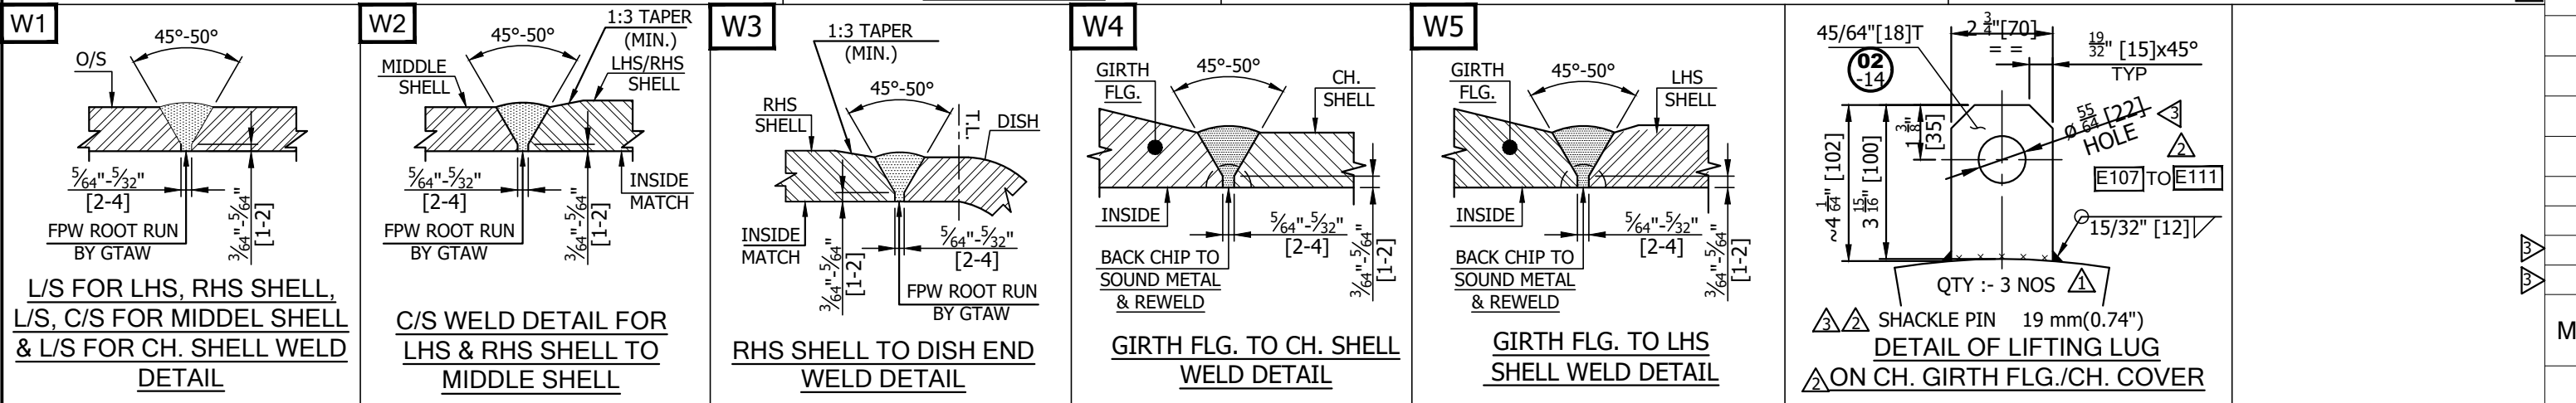
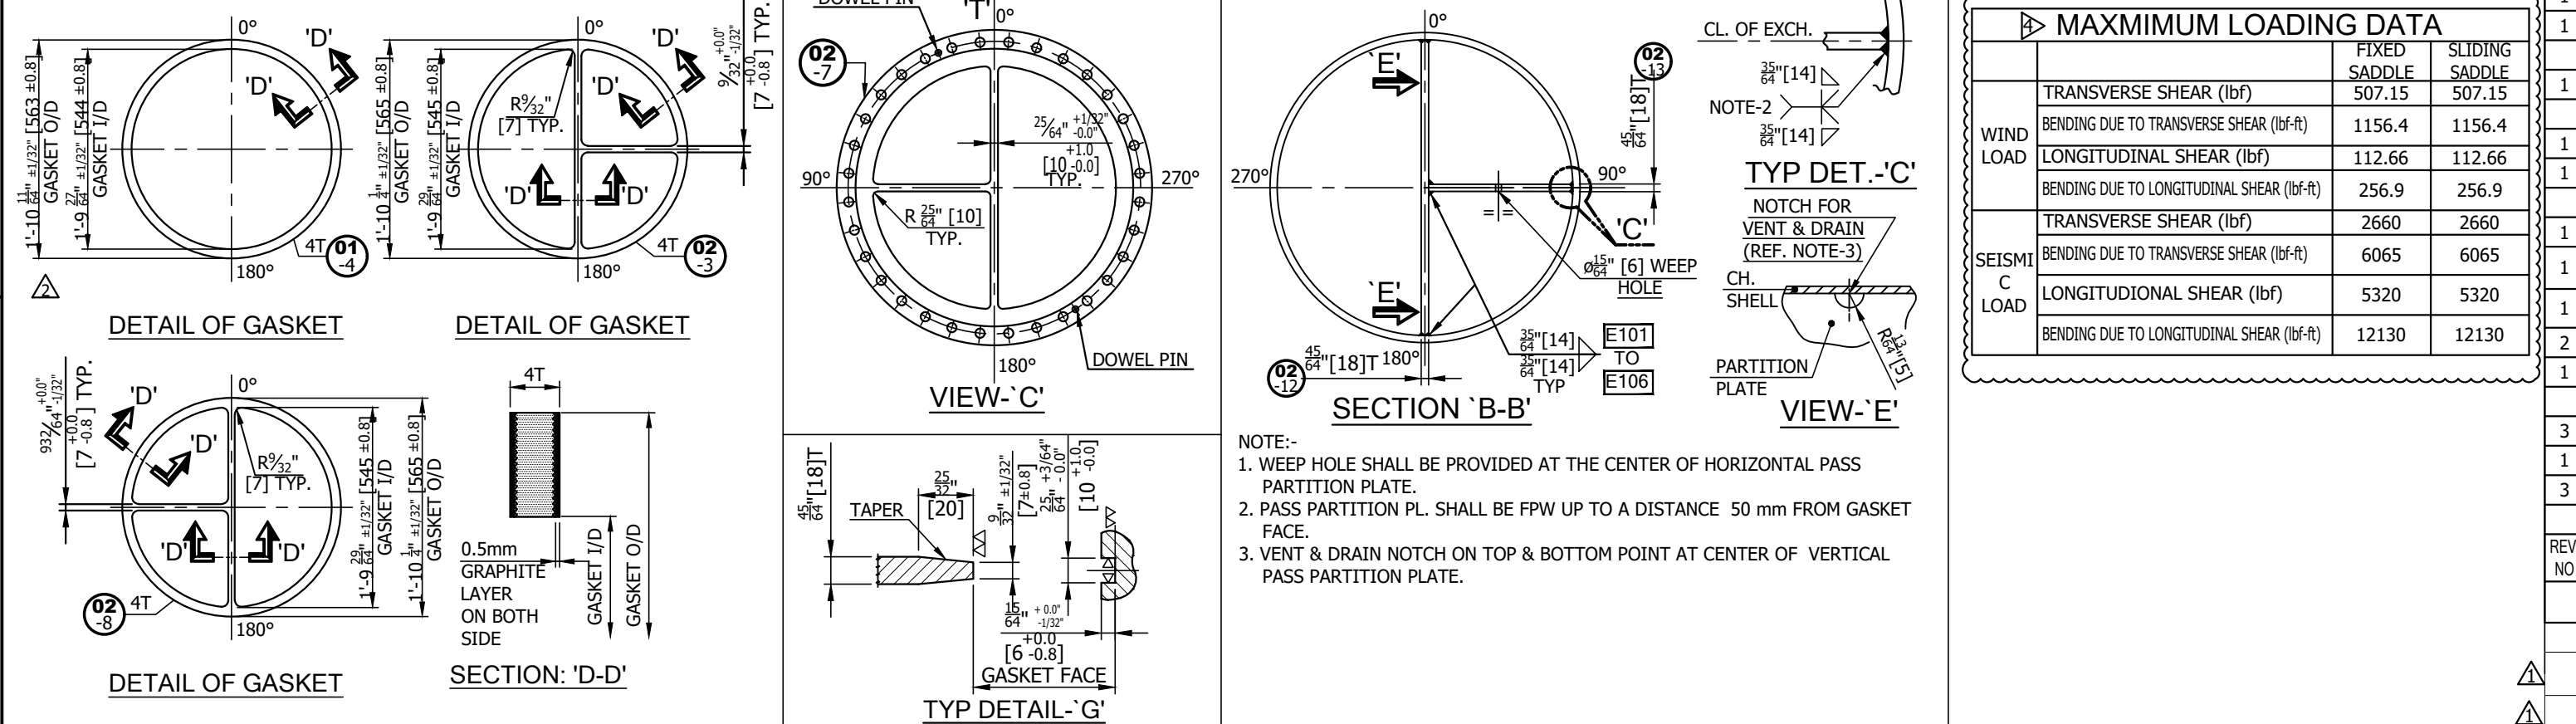
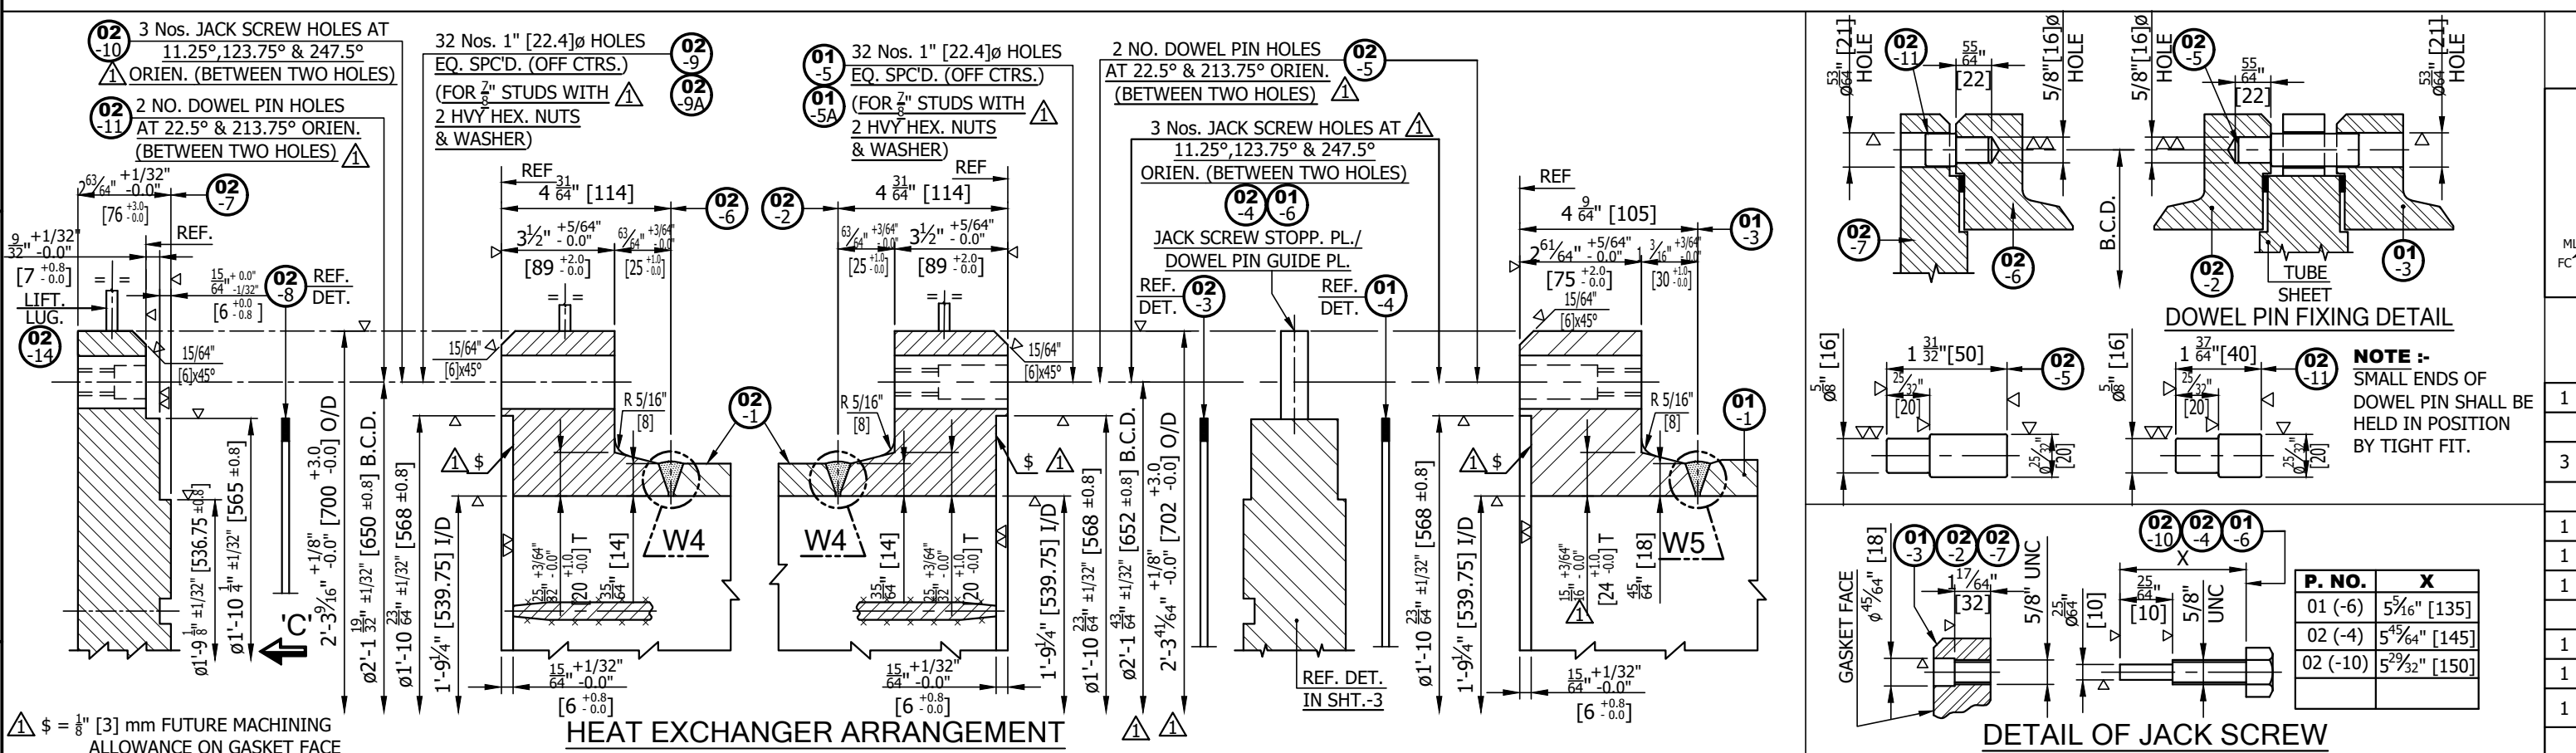


THIS DRAWING MUST NOT WITHOUT OUR CONSENT BE SHOWN TO ANY PERSON OUTSIDE THE RECIPIENT EMPLOY OR BE COPIED OR USED FOR THE PURPOSE OF MANUFACTURING ANY ARTICLE SHOWN IN THE DRAWING AND THE COPYRIGHT IN THE DRAWING SHALL BE AND REMAIN OUR SOLE PROPERTY. THIS DRAWING TOGETHER WITH ANY COPIES MADE BY THE RECIPIENT SHALL BE RETURNED ON DEMAND TO US.

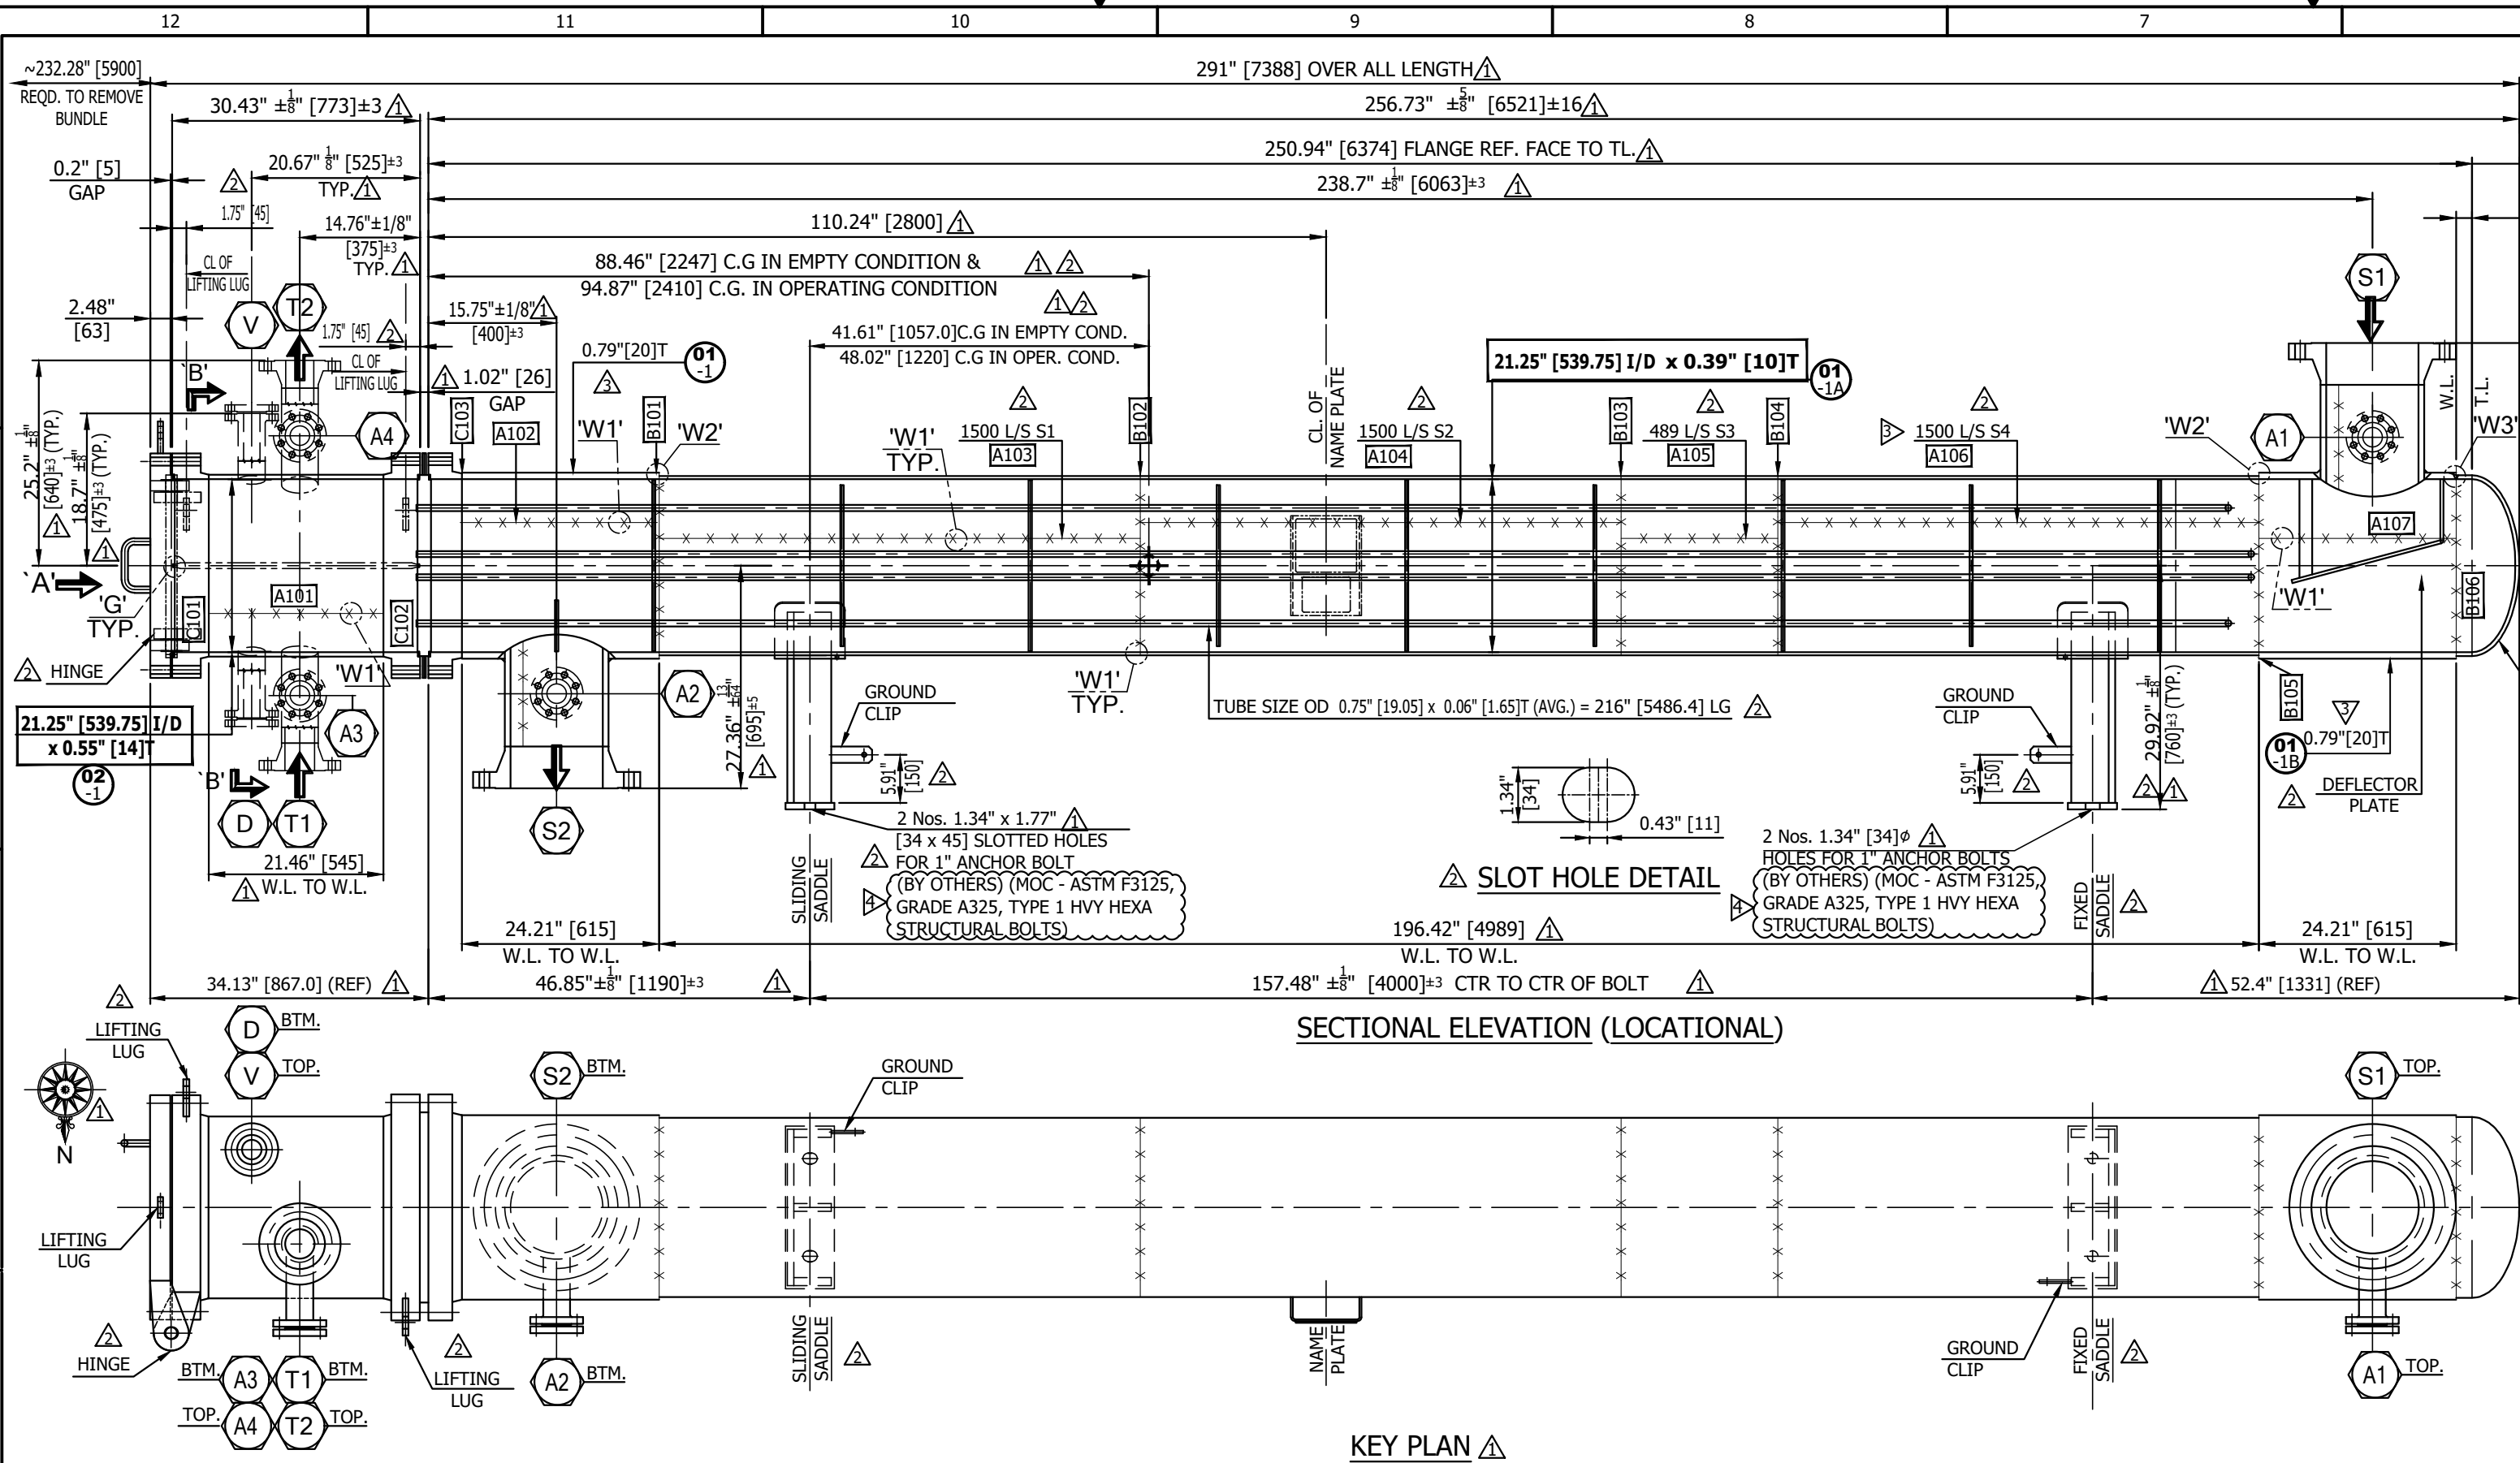

CLIENT ACCEPTED POINT

- 1) AFTER WELD 16 mm GAP BETWEEN NOZZLE V & D NOZZLE WELD TO PARTITION PLATE.
- 2) AFTER WELD 29 mm GAP BETWEEN NOZZLE T1 & T2 NOZZLE WELD TO PARTITION PLATE.
- 3) CH. COVER HINGE ORIENTATION & DETAIL.
- 4) CONN. S1 DEFLECTOR PLATE DETAIL.

BOLT TORQUE IN HYDRO TEST CONDITION		
BOLT SIZE	JOINT	BOLT TORQUE (lb-in)
7/8"	CHANNEL FLANGE TO CHANNEL COVER	4094.58
7/8"	CHANNEL FLANGE TO SHELL FLANGE	3222.48

NOZZLE LOADING DATA		FOUNDATION AT BASE	
NOZZLE MARK	SIZE (NPS/IN)	WIND FORCE (lb)	SEISMIC FORCE (lb)
S1, S2	12 (300)	3060	3840
T1, T4	4 (100)	1080	1360

REV.	NO.	DESCRIPTION	QTY/ITEM	MATERIAL	SIZE	WEIGHT (kg)	REMARK
1	-14	LIFTING LUG	3	SA 516 GR 70	18T x 70W x 102 LG (REF. DETAIL)	3	
1	-13	PARTITION PLATE	1	SA 516 GR 70	18T x 258W x 761 LG (FINISH SIZE)	28	
1	-12	PARTITION PLATE	1	SA 516 GR 70	18T x 537W x 761 LG (FINISH SIZE)	58	
1	-11	DOWEL PIN	2	SS 304	Ø20 x 40 L (FINISH SIZE)	0.2	
1	-10	JACK SCREW	3	SS 304	5/8" UNC x 150 LG (REF. DETAIL)	0.7	
1	-9A	WASHER	64+8	ASTM F436 TYPE-1	6T x 44 O/D x 24 I/D	3	
1	-9	STUD WITH 2HVY HEX NUTS	32+4	SA 193 GR B7M/SA 194 GR 2HM	7/8" UNC x 240 LG (FULL THRD)	32	
1	-8	GASKET (LHS)	1+2	@@	4T x AS PER DRG	-	
1	-7	CHANNEL COVER	1	SA 266 GR 2	AS PER DRG	209	
1	-6	CH. GIRTH FLG. COVER SIDE	1	SA 266 GR 2	AS PER DRG	106	
1	-5	DOWEL PIN	2	SS 304	Ø20 x 50 LG (FINISH SIZE)	0.2	
1	-4	JACK SCREW	3	SS 304	5/8" UNC x 145 LG (REF. DETAIL)	0.7	
1	-3	GASKET (RHS)	1+2	@@	4T x AS PER DRG.	-	
1	-2	CH. GIRTH FLG. (RHS)	1	SA 266 GR 2	AS PER DRG.	94	
1	-1	CHANNEL SHELL	1	SA 516 GR 70	14T x 545W x 1740 DEV. LG.	104	
02	01	MAIN SHELL ASSLY.	1	SS 304	5/8" UNC x 135 L (REF. DETAIL)	0.7	
1	-5A	WASHER	64+8	ASTM F436 TYPE-1	6T x 44 O/D x 24 I/D	3	
1	-5	STUD WITH 2HVY HEX NUTS	32+4	SA 193 GR B7M/SA 194 GR 2HM	7/8" UNC x 275 LG (FULL THRD)	38	
2	-4	GASKET	1+2	@@	4T x AS PER DRG.	-	
1	-3	SHELL GIRTH FLANGE	1	SA 965 F 316L	AS PER DRAWING	83	
2	-2	DISHED END	1	SA 240 GR 316L	12T (NOM) x 755 B.DIA	42	
3	-1B	RHS SHELL	1	SA 240 GR 316L	20T x 615W x 1759 DEV.L	170	
1	-1A	MIDDLE SHELL	1	SA 240 GR 316L	10T x 498W x 1727 DEV.L	691	
3	-1	LHS SHELL	1	SA 240 GR 316L	20T x 615W x 1759 DEV.L	170	

REV.	NO.	DESCRIPTION	QTY/ITEM	MATERIAL	SIZE	WEIGHT (kg)	REMARK
A4	1	2" I/O (50.8 I/O)	16.67	-	300	LWN	RF
A3	1	2" I/O (50.8 I/O)	16.67	-	300	LWN	RF
A2	1	2" I/O (50.8 I/O)	16.67	-	300	LWN	RF
A1	1	2" I/O (50.8 I/O)	16.67	-	300	LWN	RF
D	1	2" I/O (50.8 I/O)	16.67	-	300	LWN	RF
V	1	2" I/O (50.8 I/O)	16.67	-	300	LWN	RF
T2	1	4 (100)	13.49	160	300	WN	RF
T1	1	4 (100)	13.49	160	300	WN	RF
S2	1	12 (300)	20	-	300	WN	RF
S1	1	12 (300)	20	-	300	WN	RF
MARK	QTY/ITEM	SIZE NPS (DN)	THK	SCH	CLASS	TYPE	FACE
							PIPE
							ASME B16.5 FLANGE
							NOZZLES AND CONNECTIONS



CONSTRUCTION DATA		
1	CONSTRUCTION CODE- ASME SECT. VIII DIV-1, ED. 2019 + ADD. 2020	YES
2	ASME CERTIFICATION MARK WITH 'U' DESIGNATOR	YES
3	NATIONAL BOARD REGISTRATION	NA
4	ADDITIONAL COMPLIANCE	AEU (H)
5	TYPE	21.25 x 216
6	TEMA SIZE	inch
7	FLUID CIRCULATED	AMINE REGEN OVHD
8	NUMBER OF PASSES	1
9	DESIGN PRESSURE (INTERNAL)	psi (g) [kg/cm²(g)]
10	DESIGN PRESSURE (EXTERNAL)	psi (g) [kg/cm²(g)]
11	DESIGN TEMPERATURE (INTERNAL)	°F [°C]
12	DESIGN TEMPERATURE (EXTERNAL)	°F [°C]
13	OPERATING TEMPERATURE (IN/OUT)	°F [°C]
14	OPERATING PRESSURE (INLET)	psi (a) [kg/cm²(a)]
15	MINIMUM DESIGN METAL TEMP. (MDMT)	°F [°C]
16	SERVICE	SOUR (NON LETHAL)
17	FIELD/SHOP HYDRO TEST PRESSURE (AS PER UG-99/UG-99C)	psi (g) [kg/cm²(g)]
18	MAWP CALCULATED	psi (g) [kg/cm²(g)]
19	COMPONENT LIMITING MAWP	psi (g) [kg/cm²(g)]
20	COMPONENT LIMITING MAP	psi (g) [kg/cm²(g)]
21	HYDRO TEST MEDIUM AT TEST TEMPERATURE	°F [°C]
22	CORROSION ALLOWANCE	inch (mm)
23	JOINT EFFICIENCY	1
24	RADIOGRAPHY	100%
25	WIND DESIGN CODE	ASCE-7-16
26	BASIC WIND SPEED	Mph [km/hr]
27	SEISMIC DESIGN CODE	ASCE-7-16
28	POST FORMING HEAT TREATMENT	EXEMPTED AS PER UHA-44
29	POST WELD HEAT TREATMENT	EXEMPTED AS PER UCS-56
30	FLUID DENSITY (IN / OUT) (LIQ.)	lb/ft³ [kg/m³]
31	INSULATION (TYPE/THK) (BY OTHERS)	inch (mm)
32	FIRE PROOFING FOR SUPPORT	inch (mm)
33	HEAT EXCHANGED	MM BTU/hr
34	IMPACT TEST REQUIREMENT	EXEMPTED AS PER UHA-51 (SEE NOTE-M12)
35	APPLICABLE UG-22 LOADINGS	ft² [m²]
36	SURFACE AREA/SHELL, AREA/UNIT(EFFECTIVE)	ft² [m²]
37	PRESSURE DROP (ALLOWABLE/CALCULATED)	psi (g) [kg/cm²(g)]
38	INSPECTION BY	LLOYD'S REGISTER VERIFICATION LTD. / AP
39	PAINTING	AS PER APPROVED PAINTING PROCEDURE & A8K-MP-000-300520-A
40	WEIGHT	lbs / (kg)
41	WEIGHT (BUNDLE/IMPACT FACTOR)	lbs / (kg)
42	WEIGHT (FULL OF WATER)	lbs / (kg)
43	TUBE TO TUBE SHEET JOINT	EXPANDED
44	VOLUME	ft³ [m³]

SHELL SIDE : WET H2S SERVICE		
MATERIAL OF CONSTRUCTION		
SHELL / DISHED END	FLANGE	SA 240 GR 316L / SA 240 GR 316L
GIRTH FLANGE	STUDS/NUTS	SA 193 GR B7M/SA 194 GR 2HM
	GASKET	@@
	NECK	SA 240 GR 316L
	FLANGE	SA 182 F 316L
	STUDS/NUTS	SA 193 GR B7M/SA 194 GR 2HM
	GASKET	SPWID SS 304L
	TUBE(SHEATHLESS)	SA 789 UNS 32205
	TUBE TO TUBE SHEET JOINT	EXPANDED
	PARTITION PLATE	SA 516 GR 70
	BAFFLES / TUBE SUPPORT / SEAL STRIP	SA 240 GR 316L / SA 240 GR 316L
	TIE ROD / SPACER	SS 316 L / SA 213 TP 316 L
	WEAR PLATE / SADDLE SUPPORT	SA 240 GR 316L / SA 516 GR 70
	ANCHOR BOLTS	ASTM F3125, GRADE A325, TYPE 1 HVY HEXA STRUCTURAL BOLTS
	@@ 4T(31+0.5x2) SS 316L GROOVED METAL GASKET WITH GRAPHITE LAYER ON BOTH SIDES (KAMPROFILE)	
EN207121-ANUP-9V3-00029	H-2570-TRANS-2021	1 OF 1 TRANSPORTATION DRAWING
EN207121-ANUP-9V3-00028	H-2570-FAD-2021	4 OF 4 NAME PLATE & GENERAL NOTES DETAIL
	DELETED	
EN207121-ANUP-9V3-00027	H-2570-FAD-2021	3 OF 4 TUBE BUNDLE ASSEMBLY AND DETAIL
EN207121-ANUP-9V3-00020	H-2570-FAD-2021	2 OF 4 NOZZLE AND SADDLE DETAIL
	CLIENT DOCUMENT NO.	DRG. NO. SHT. NO. DESCRIPTION



REV.	NO.	DATE	DESCRIPTION	BY	CHKD.	APPD.
4	20-07-22		REVISED AS PER CLIENT COMMENTS AS MARKED & ISSUED FOR APPROVAL	SBL	PPG	BMP
3	28-03-22		REVISED AS PER CLIENT COMMENTS AS MARKED & ISSUED FOR APPROVAL	SBL	KRK	BMP
2	22-12-21		PARTIAL BAFFLE, DEFLECTOR BAFFLE & CH. COVER HINGE ADDED & OTHERS CHANGES AS MARK	SBP	DMP	DKB
1	05-10-21		REVISED AS PER CLIENT COMMENTS ISSUED FOR APPROVAL	SBP	DMP	DKB
0	16-08-21		ISSUED FOR APPROVAL	SBP	JPM/DMP	DKB

WORLD ENERGY PARAMOUNT		
CLIENT		
EQUIPMENT OWNER	AIR PRODUCTS LLC	AIR PRODUCTS MANUFACTURING LLC
CONTRACT NO.		
THE ANUP ENGINEERING LTD. AHMEDABAD		
EQUIPMENT OWNER- AIR PRODUCTS MANUFACTURING LLC	AP DRAWING NO. : EN207121-ANUP-9V3-00026	
P.O.NO. : 4505487159	P.R.NO. : -	
DRN.	SBP	
CHD.	JPM/DMP	
APPD.	DKB	
DATE	07-08-2021	
SCALE	1 : 18	
MFR'S SERIAL NO.		
DRG. NO	H-2570-FAD-2021	
SHEET NO.	1 OF 4	
REV.	1	
QTY	ONE	

THIS DRAWING MUST NOT WITHOUT OUR CONSENT BE SHOWN TO ANY PERSON OUTSIDE THE RECIPIENT EMPLOY OR BE COPIED OR USED FOR THE PURPOSE OF MANUFACTURING ANY ARTICLE SHOWN IN THE DRAWING AND THE COPYRIGHT IN THE DRAWING SHALL BE AND REMAIN OUR SOLE PROPERTY. THIS DRAWING TOGETHER WITH ANY COPIES MADE BY THE RECIPIENT SHALL BE RETURNED ON DEMAND TO US.

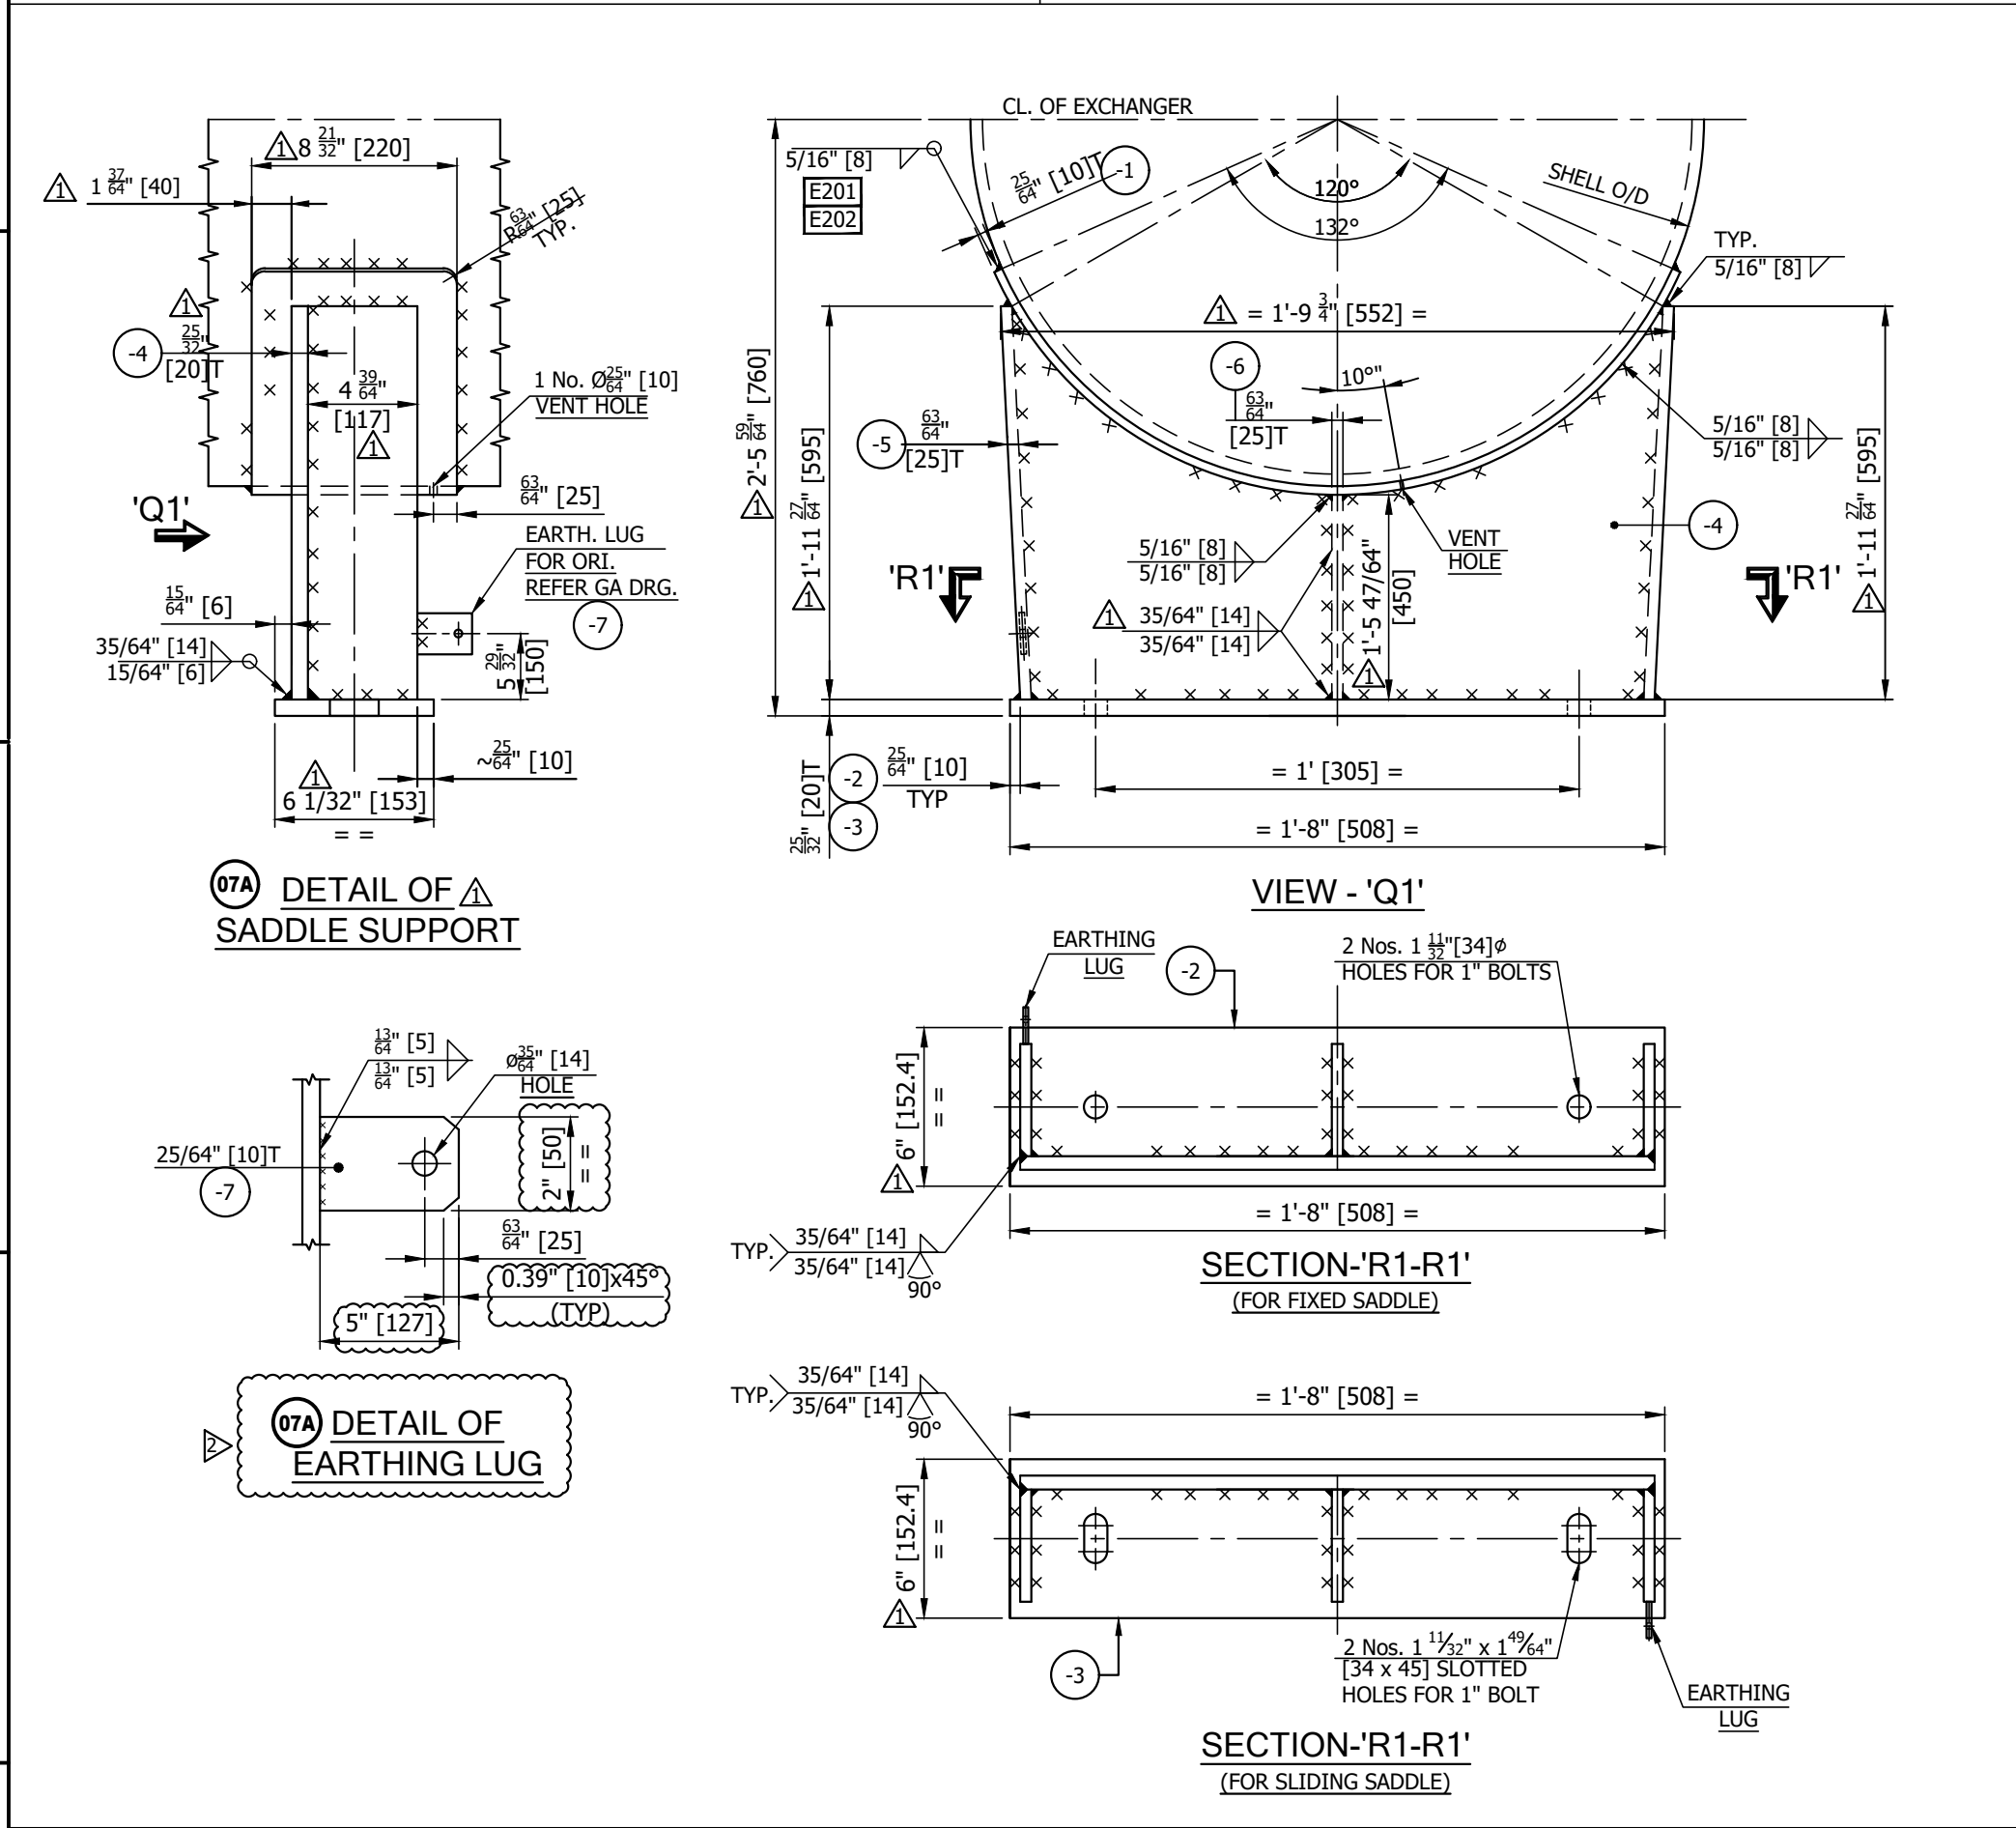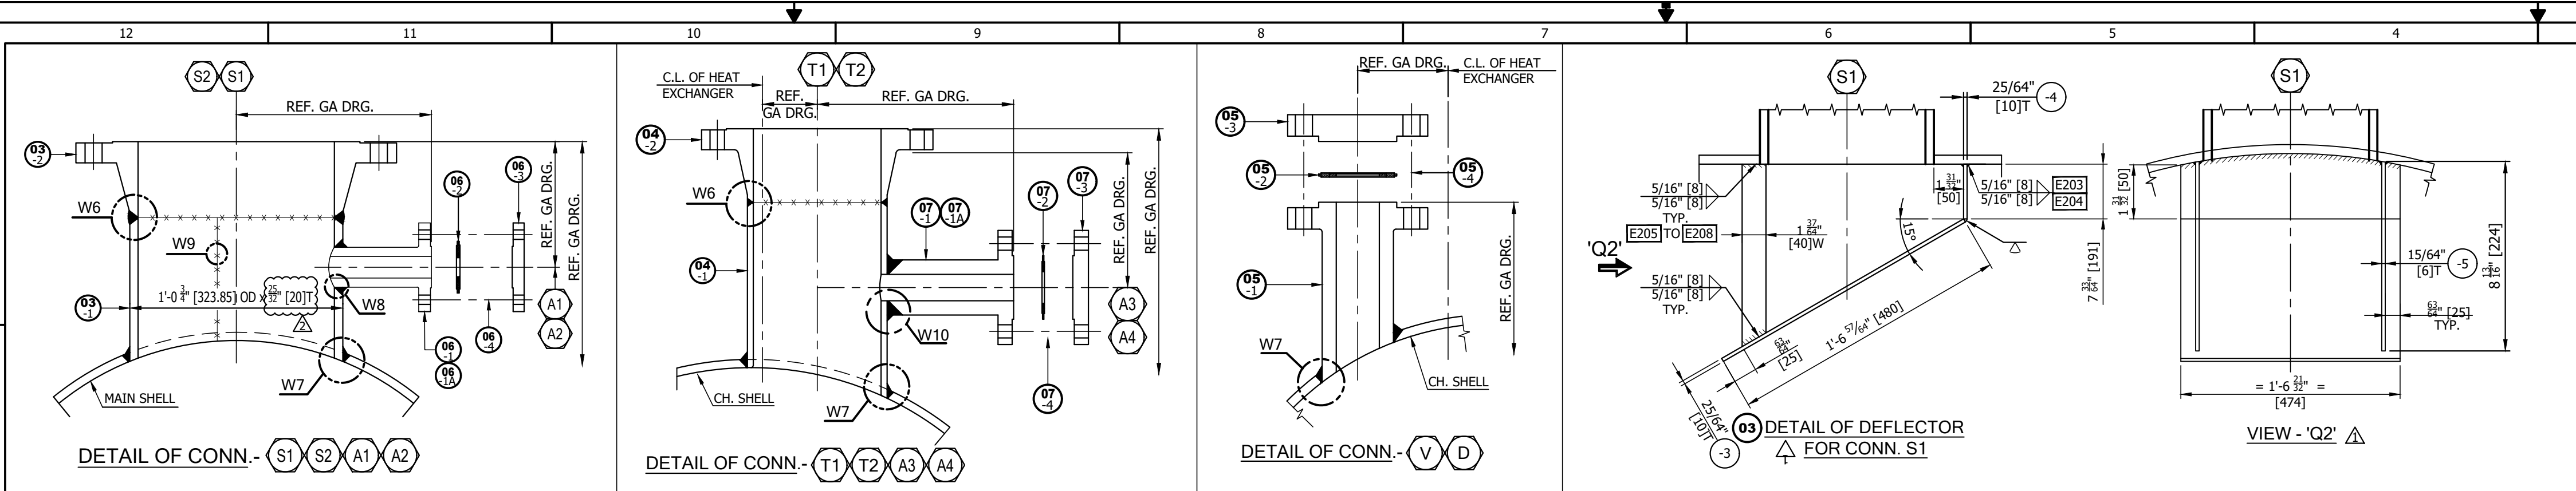


NOZZLES WELD JOINT NUMBER					
MARK	NOZZ. FAB. PIPE L/S	FAB. PIPE/NOZZ. PIPE TO FLANGE	FAB. PIPE/NOZZ. PIPE/LWN TO MAIN SHELL/CH. SHELL/ FAB. PIPE/NOZZ. PIPE	R-PAD TO SHELL/ CH. SHELL	REMARK
S1	A201	C201	D201	-	
S2	A202	C202	D202	-	
T1	-	C203	D203	-	
T2	-	C204	D204	-	
V	-	-	D205	-	
D	-	-	D206	-	
A1	-	-	D207	-	
A2	-	-	D208	-	
A3	-	-	D209	-	
A4	-	-	D210	-	

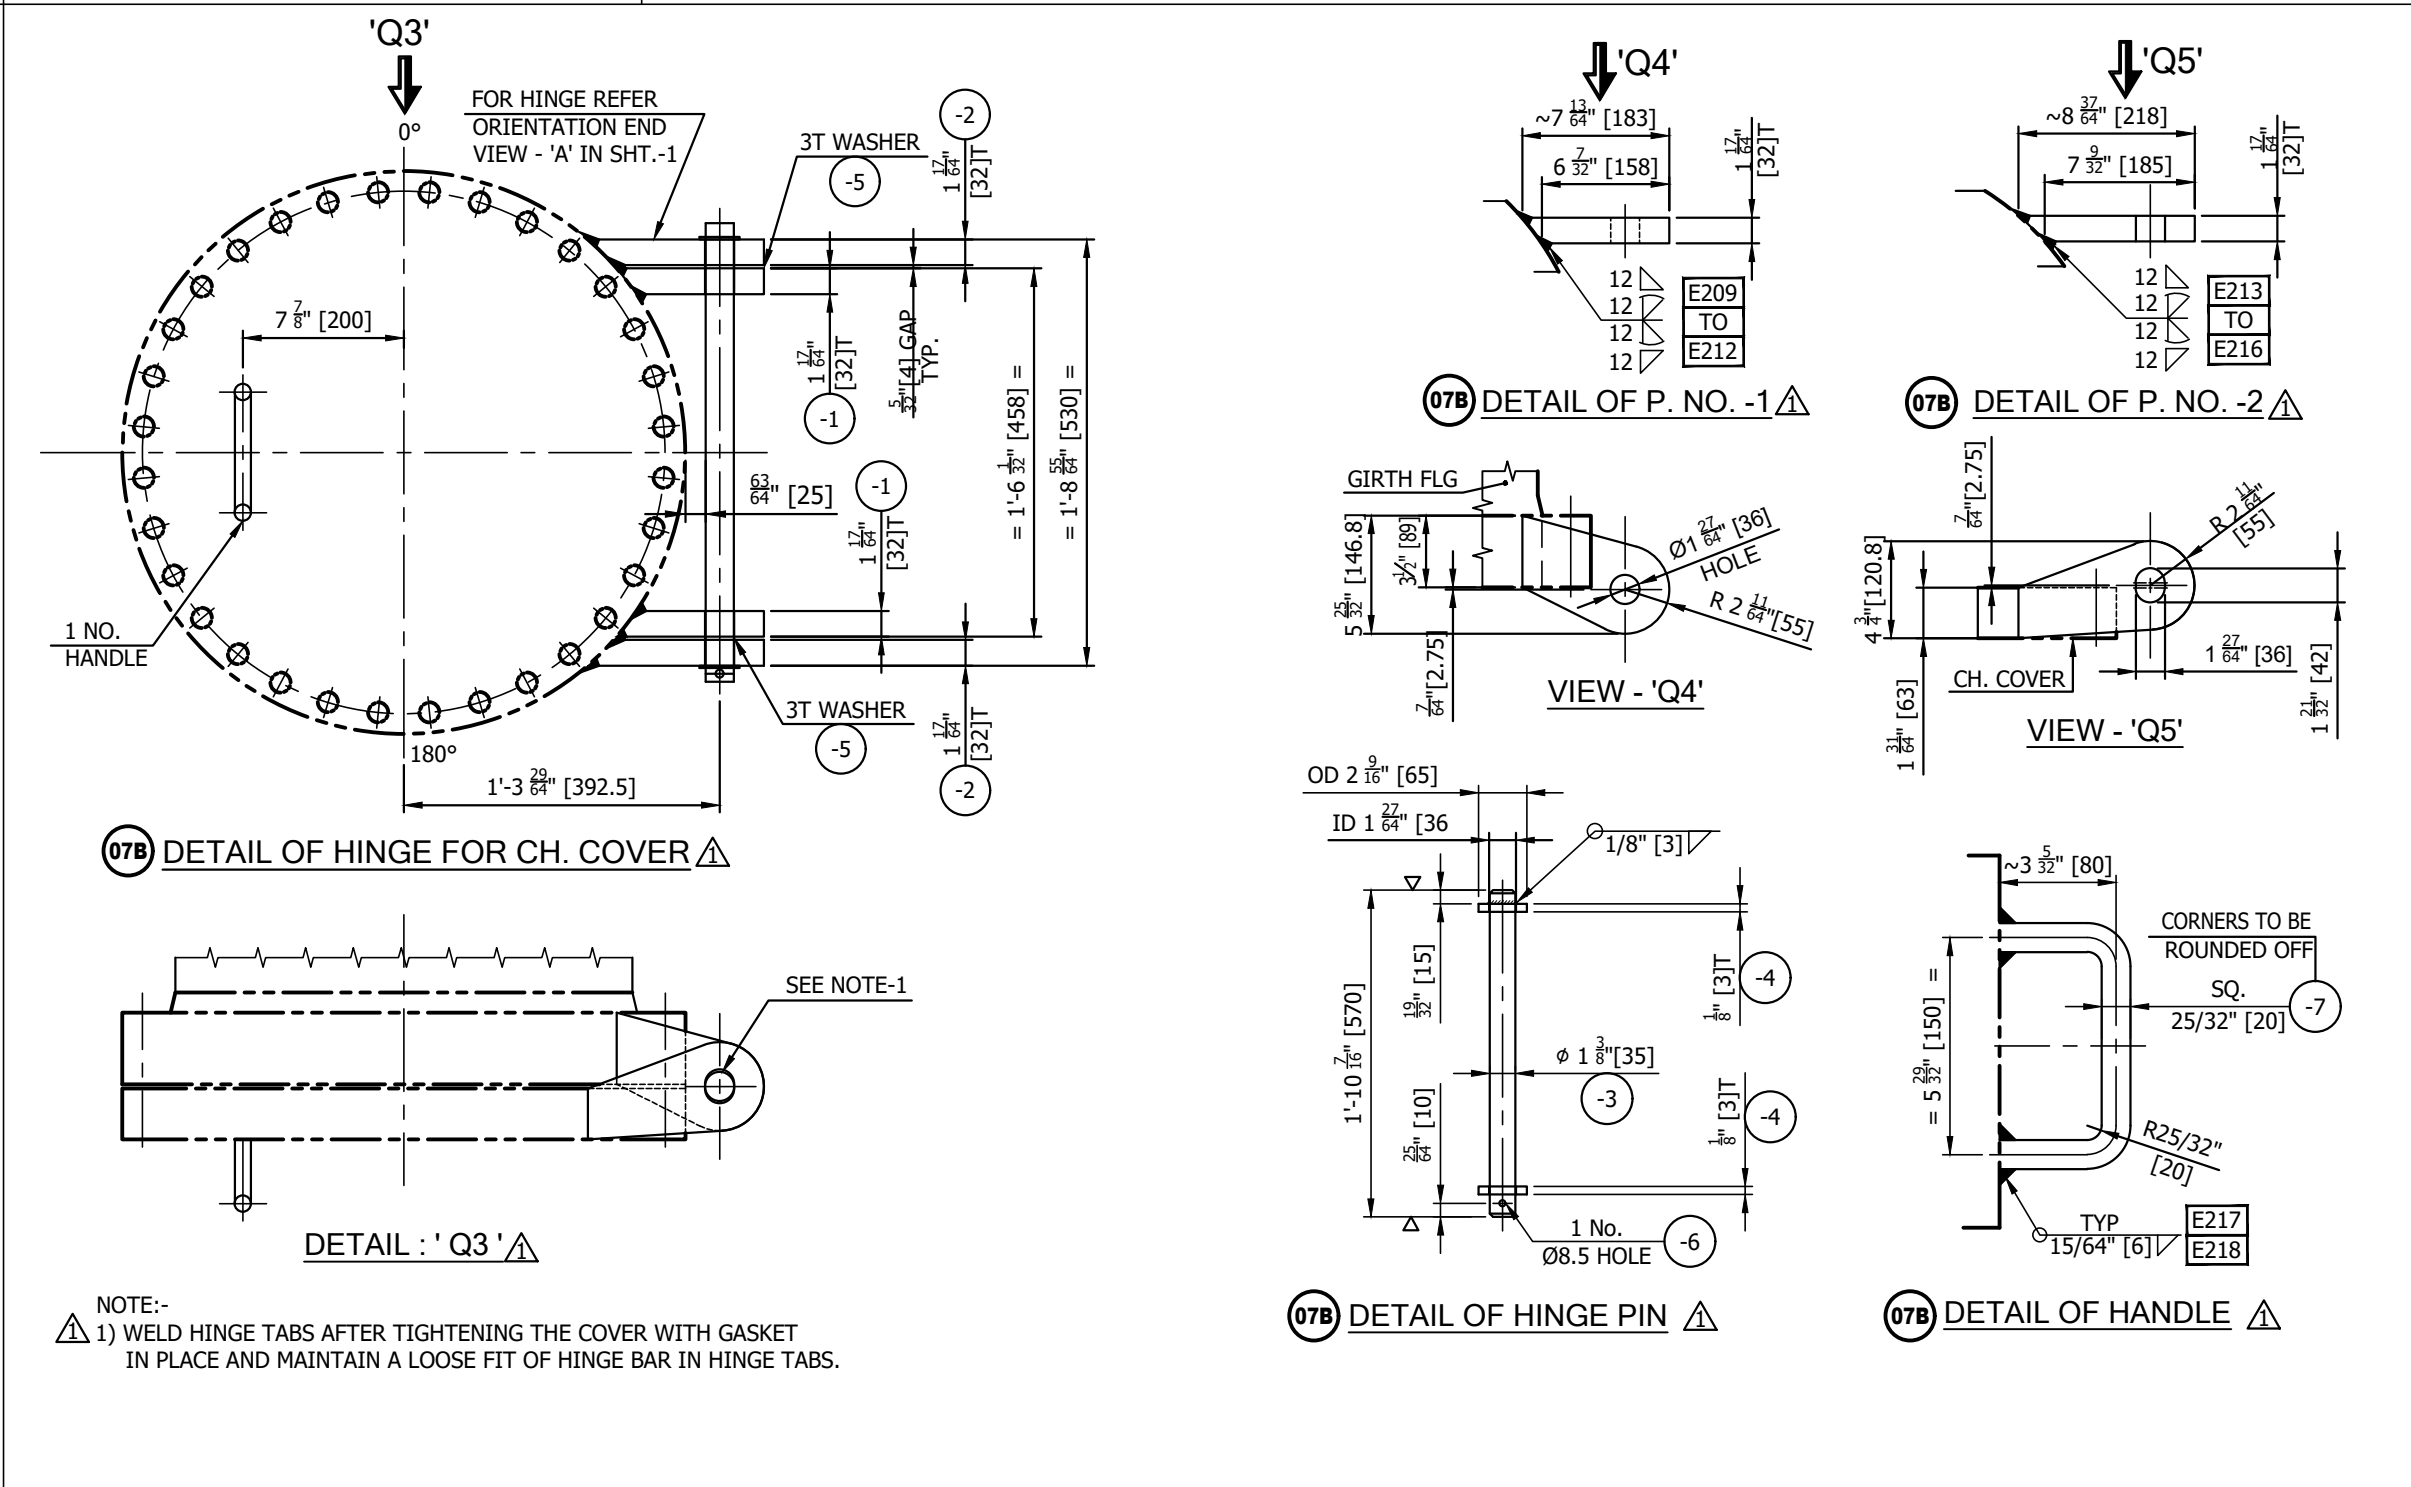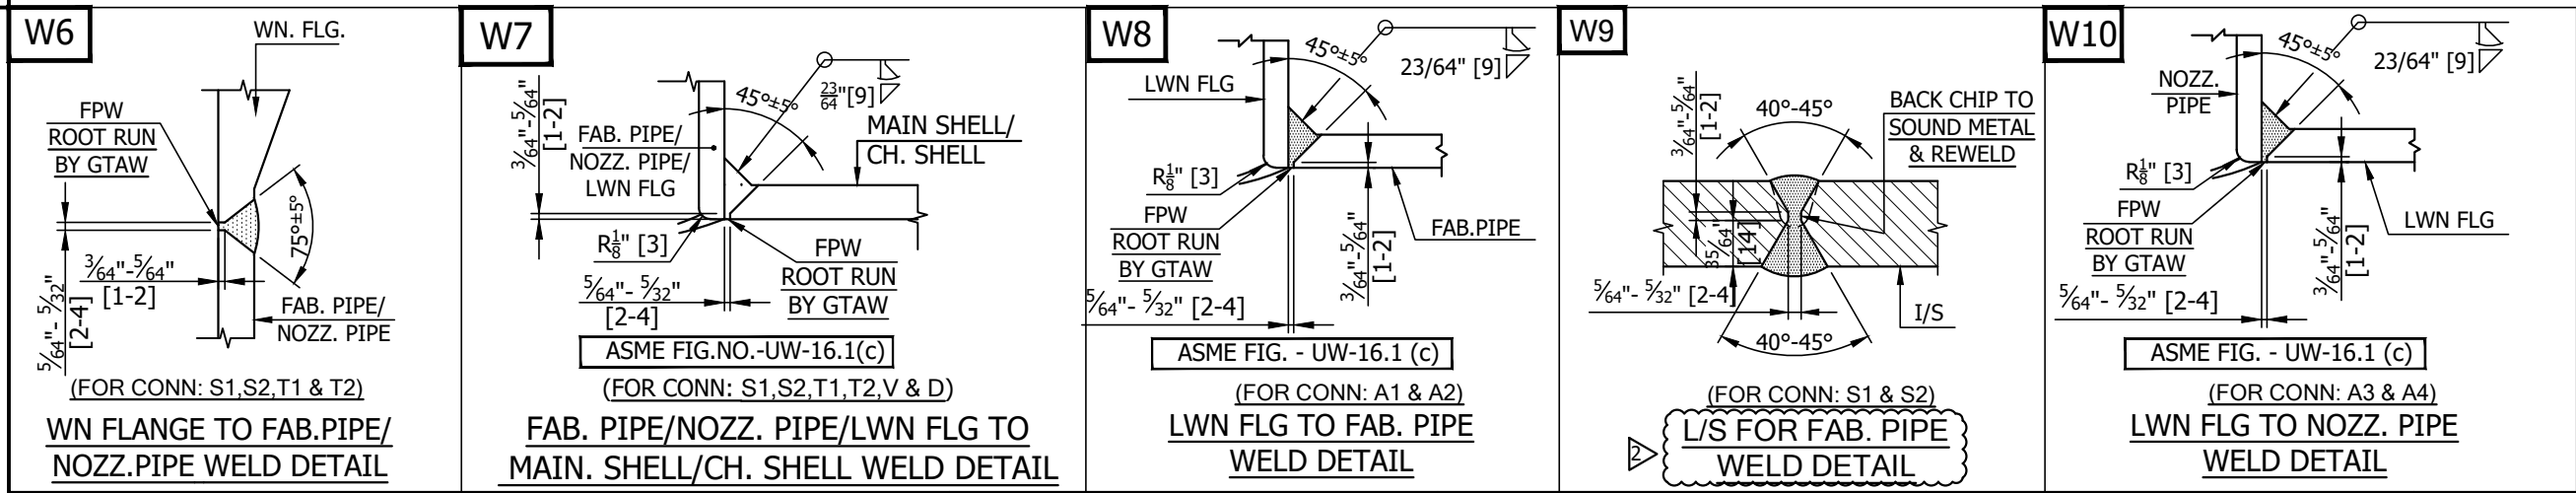

** 4.5T SS 316L SPIRAL WOUND GASKET WITH GRAPHITE FILLER WITH 3.2T SS 316L INNER RING & OUTER RING, (DIMENSIONS AS PER ASME B 16.20)					
1	WELD JOINT NO. - E201 TO E218				
2			SUB-TOTAL OF WEIGHT (KG)	628	
2	-7 HANDLE	1	SA 516 GR 70	SQ.20 x 310 DEV. L	1
2	-6 SPLIT PIN	1	SS	ø8 x 75 L	-
2	-5 WASHER	2	CS	3T x 65 O/D x 36 I/D	-
2	-4 WASHER	2	CS	3T x 65 O/D x 36 I/D	-
2	-3 PIN FOR HINGE	1	IS 2062	ø35 x 570 L (FINISH SIZE)	4
2	-2 HINGE PLATE ON COVER	2	SA 516 GR 70	32T x AS PER DRG.	10
2	-1 HINGE PLATE ON FLG.	2	SA 516 GR 70	32T x AS PER DRG.	9
2	07B CH. COVER HINGE ASSLY.				
2	-7 EARTHING LUG	2	SS 304	10T x 50W x 127 LG	1
1	-6 RIB PLATE	2	SA 516 GR 70	25T x 117W x 450 LG	21
1	-5 SIDE RIB PLATE	4	SA 516 GR 70	25T x 117W x 595 LG	55
1	-4 SUPPORT PLATE	2	SA 516 GR 70	20T x 552W x 595 LG	81
1	-3 BASE PLATE (SLIDING SUPP.)	1	SA 516 GR 70	20T x 153W x 508 LG	12
1	-2 BASE PLATE (FIXED SUPP.)	1	SA 516 GR 70	20T x 153W x 508 LG	12
1	-1 PAD PLATE	2	SA 240 GR 316L	10T x 220W x 660 DEV.L	23
2	07A SADDLE SUPPORT ASSLY.				
-4	STUD WITH 2HVV HEX NUT	16+2	SA 193 GR B7M/ SA 194 GR 2HM	5/8" UNC X 105 LG (FULL THRD.)	5
-3	BLIND FLANGE	2	SA 105	DN 50 x ASME 300 CL BL RF	7
-2	GASKET	2+4	**	DN 50 x ASME 300 CL B16.20	-
-1A	FLANGE	1	SA 105	50.8 ID x 16.67T x ASME 300 CL LWN RF x 222 LG	9
-1	FLANGE	1	SA 105	50.8 ID x 16.67T x ASME 300 CL LWN RF x 222 LG	9
07	CONN A3 & A4 ASSLY				
-4	STUD WITH 2HVV HEX NUT	16+2	SA 193 GR B7M/ SA 194 GR 2HM	5/8" UNC x 105 LG (FULL THRD.)	5
-3	BLIND FLANGE	2	SA 182 F 316L	DN 50 x ASME 300 CL BL RF	7
-2	GASKET	2+4	**	DN 50 x ASME 300 CL B16.20	-
-1A	FLANGE	-A2	1 SA 182 F 316L	50.8 ID x 16.67T x ASME 300 CL LWN RF x 250 LG	10
-1	FLANGE	-A1	1 SA 182 F 316L	50.8 ID x 16.67T x ASME 300 CL LWN RF x 250 LG	10
06	CONN A1 & A2 ASSLY				
-4	STUD WITH 2HVV HEX NUT	16+2	SA 193 GR B7M/ SA 194 GR 2HM	5/8" UNC x 105 LG (FULL THRD.)	4
-3	BLIND FLANGE	2	SA 105	DN 50 x ASME 300 CL BL RF	7
-2	GASKET	2+4	**	DN 50 x ASME 300 CL B16.20	-
-1A	FLANGE	2	SA 105	50.8 ID x 16.67T x ASME 300 CL LWN RF x 265 LG	20
05	CONN V & D ASSLY				
-2	FLANGE	2	SA 105	DN 100 x ASME 300 CL WN RF (BORE-ø87.32)	22
-1	NOZZLE PIPE	2	SA 106 GR B	DN 100 x 13.49T x 370 LG	21
04	CONN T1 & T2 ASSLY				
2	-5 DEFLECTOR STIFF.	-S1	2 SA 240 GR 316L	10T x 40 W x 224 LG.	2
2	-4 DEFLECTOR BAFFLE PLATE -S1	1	SA 240 GR 316L	10T x 191 W x 474 L (REF. DETAIL)	7
2	-3 DEFLECTOR BAFFLE PLATE -S1	1	SA 240 GR 316L	10T x 474 W x 480 L	18
2	-2 FLANGE	2	SA 182 F 316L	DN 300 x ASME 300 CL WN RF (BORE-ø263.32)	124
2	-1 FAB. PIPE	2	SA 240 GR 316L	20T x 375W x 955 DEV. L	112
03	CONN S1 & S2 ASSLY				
REV. PART NO.	DESCRIPTION	QTY/ITEM	MATERIAL	SIZE	WEIGHT (kg)
1	DEFLECTOR STIFF.	-S1	2 SA 240 GR 316L	10T x 40 W x 224 LG.	2
1	DEFLECTOR BAFFLE PLATE -S1	1	SA 240 GR 316L	10T x 191 W x 474 L (REF. DETAIL)	7
1	DEFLECTOR BAFFLE PLATE -S1	1	SA 240 GR 316L	10T x 474 W x 480 L	18
1	FLANGE	2	SA 182 F 316L	DN 300 x ASME 300 CL WN RF (BORE-ø263.32)	124
1	FAB. PIPE	2	SA 240 GR 316L	20T x 375W x 955 DEV. L	112


2	28-03-22	REVISED AS PER CLIENT COMMENTS AS MARKED /A/ & ISSUED FOR APPROVAL	SBL	KRK	BMP
1	22-12-21	REVISED AS PER CLIENT COMMENTS ISSUED FOR APPROVAL	SBP	DMP	DKB
0	05-10-21	ISSUED FOR APPROVAL	SBP	DMP	DKB
REV. NO.	DATE	DESCRIPTION	BY	CHD.	APPD.
REVISIONS					
CLIENT					
WORLD ENERGY PARAMOUNT					
EQUIPMENT OWNER					
AIR PRODUCTS MANUFACTURING LLC					
CONTRACT NO.:					
THE ANUP ENGINEERING LTD. AHMEDABAD					
EQUIPMENT OWNER:- AIR PRODUCTS MANUFACTURING LLC					
AP DRAWING NO. : EN207121-ANUP-9V3-00020					
P.O.NO. : 4505487159					
DRN. SBP					
CHD. DMP					
APPD. DKB					
DATE 02-10-2021					
SCALE 1 : 18					
H-2570					
H-2570-FAD-2021					
SHEET NO. 2 OF 4					
REV. 1					
1					
ANUP JOB NO. H-2570					

THIS DRAWING MUST NOT WITHOUT OUR CONSENT BE SHOWN TO ANY PERSON OUTSIDE THE RECIPIENT EMPLOY OR BE COPIED OR USED FOR THE PURPOSE OF MANUFACTURING ANY ARTICLE SHOWN IN THE DRAWING AND THE COPYRIGHT IN THE DRAWING SHALL BE AND REMAIN OUR SOLE PROPERTY. THIS DRAWING TOGETHER WITH ANY COPIES MADE BY THE RECIPIENT SHALL BE RETURNED ON DEMAND TO US.

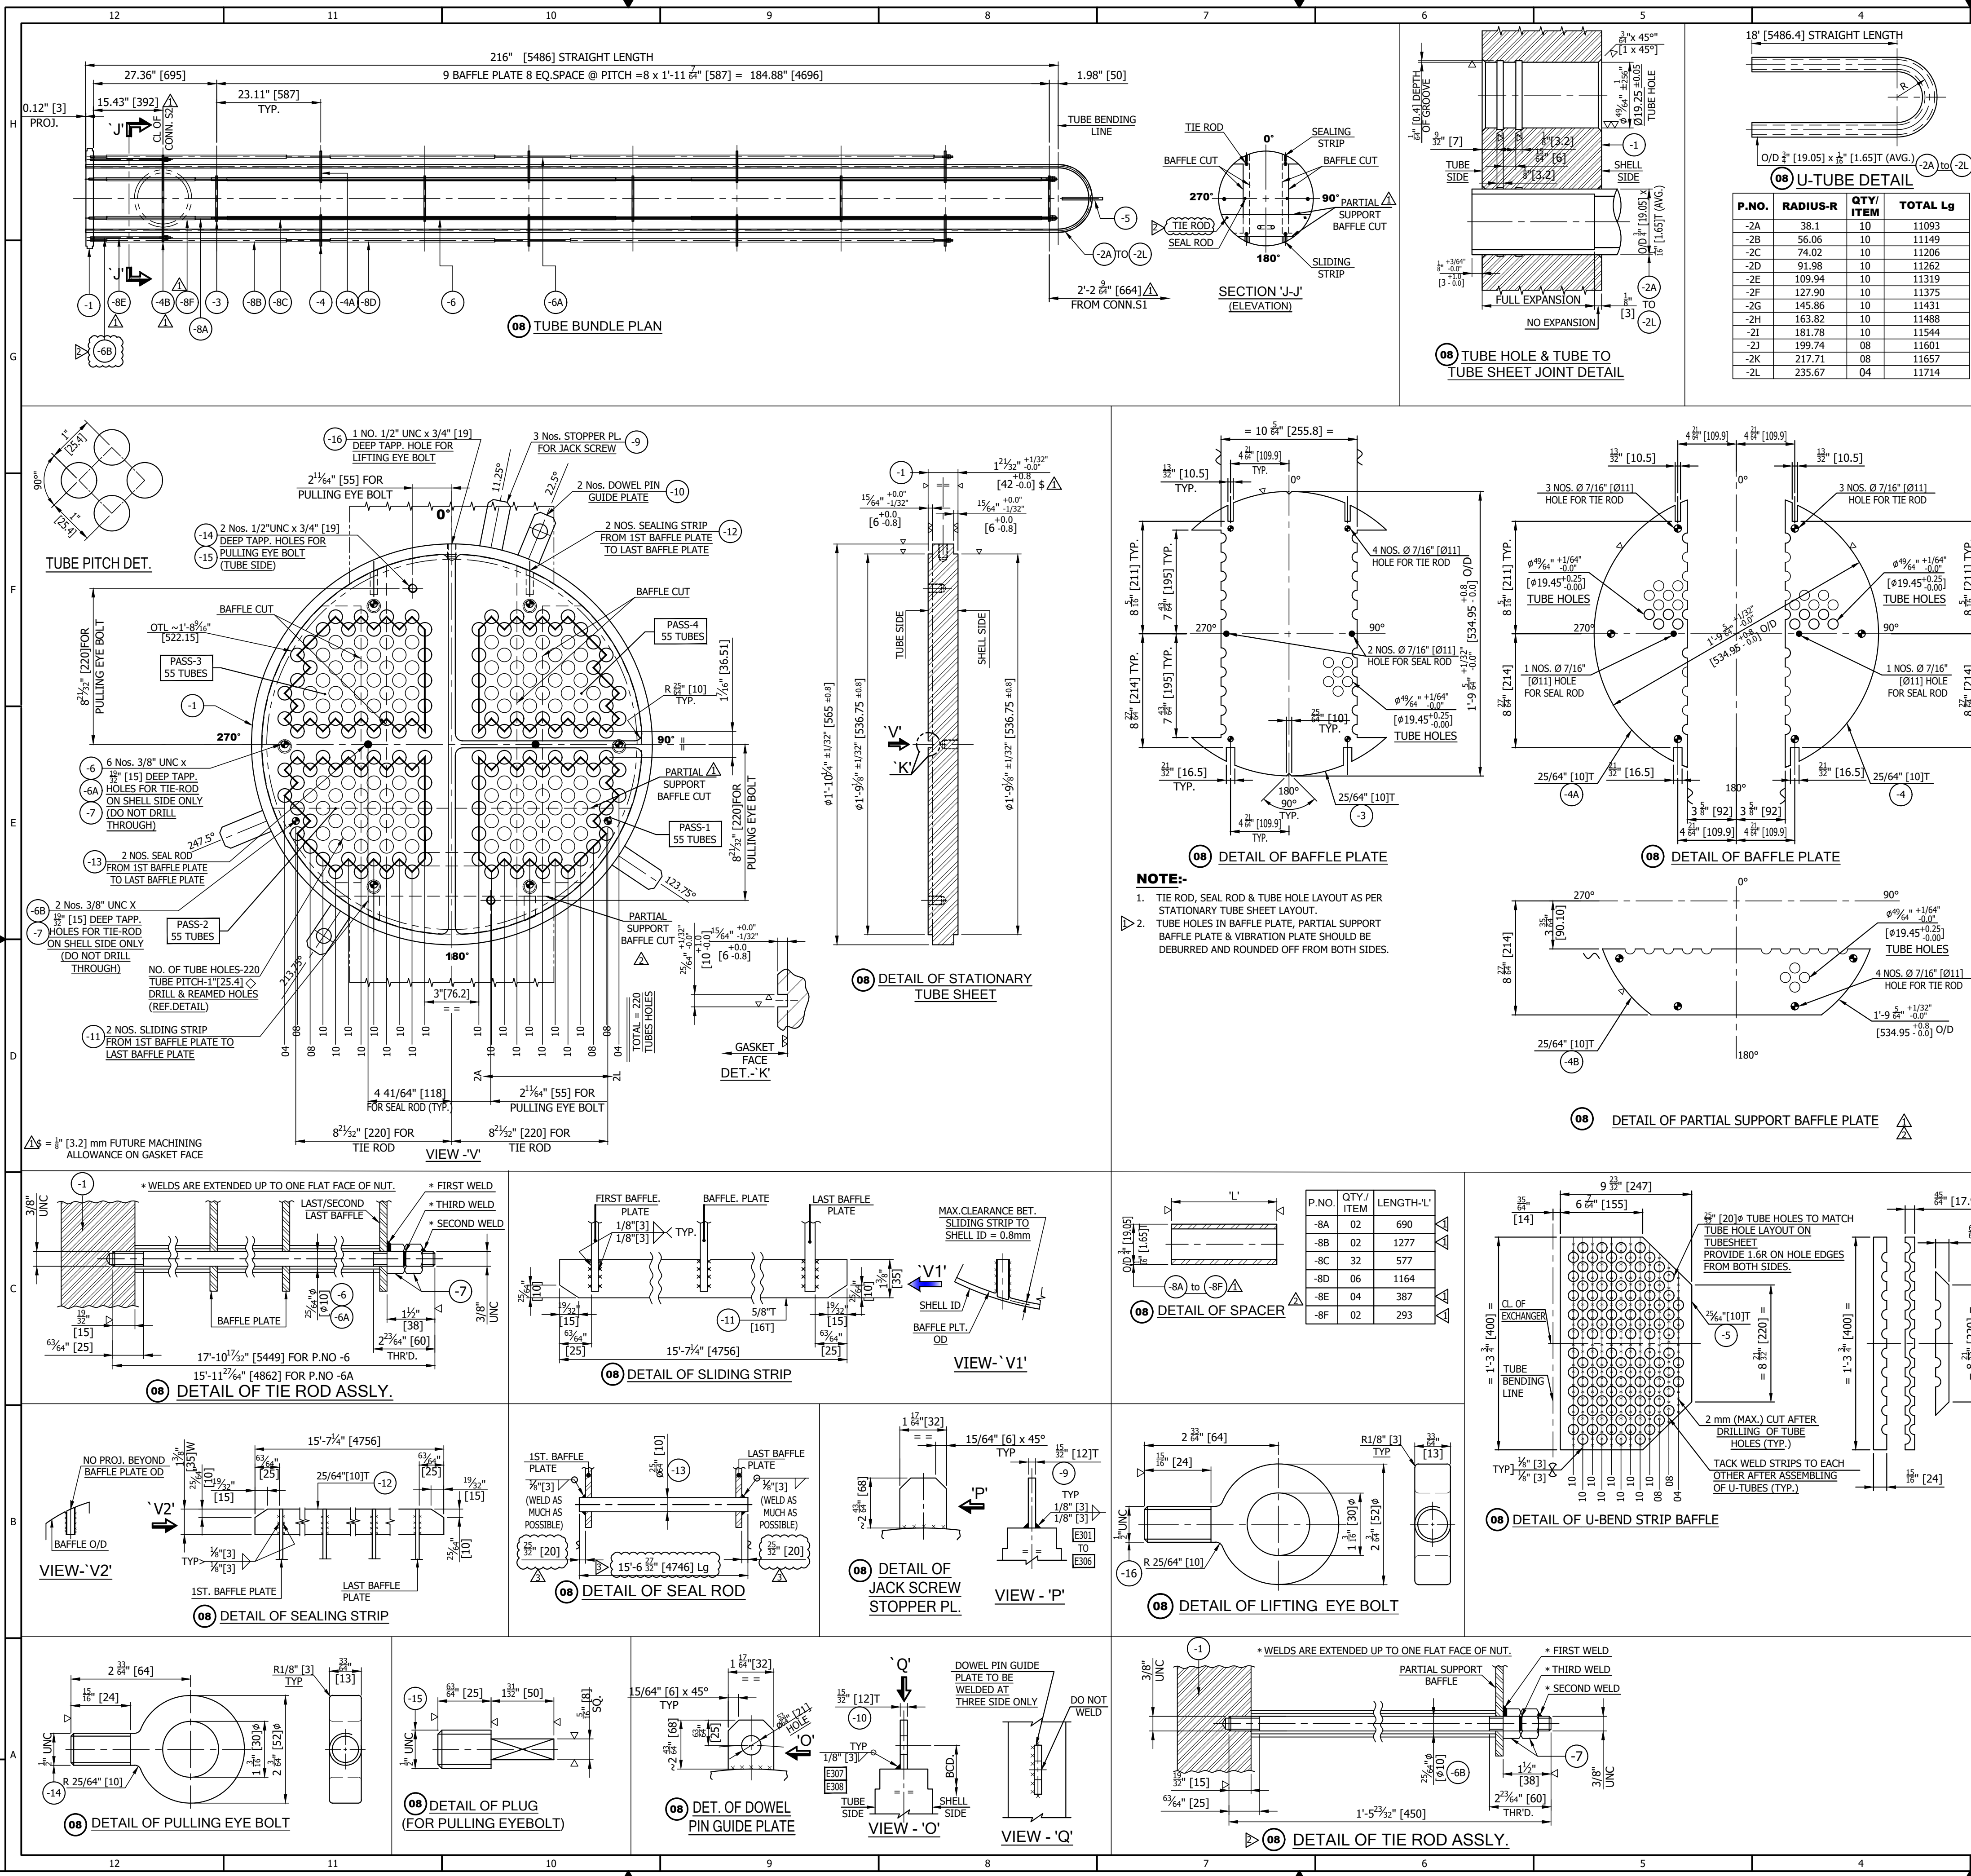

TUBESHEET LIGAMENTS (AS PER TEMA TABLE RCB-7.22M):-									
- NOMINAL LIGAMENT WIDTH :- 0.240 INCH - MINIMUM STD. LIGAMENT WIDTH :- 0.204 INCH (96% OF LIGAMENTS MUST EQUAL OR EXCEED THIS VALUE.) - MINIMUM PERMISSIBLE LIGAMENT WIDTH :- 0.120 INCH (4% OF LIGAMENTS MUST EQUAL OR EXCEED THIS VALUE.) - GASKET REACTION DIAMETER :21.850 INCH									

ORIGINAL FRAME

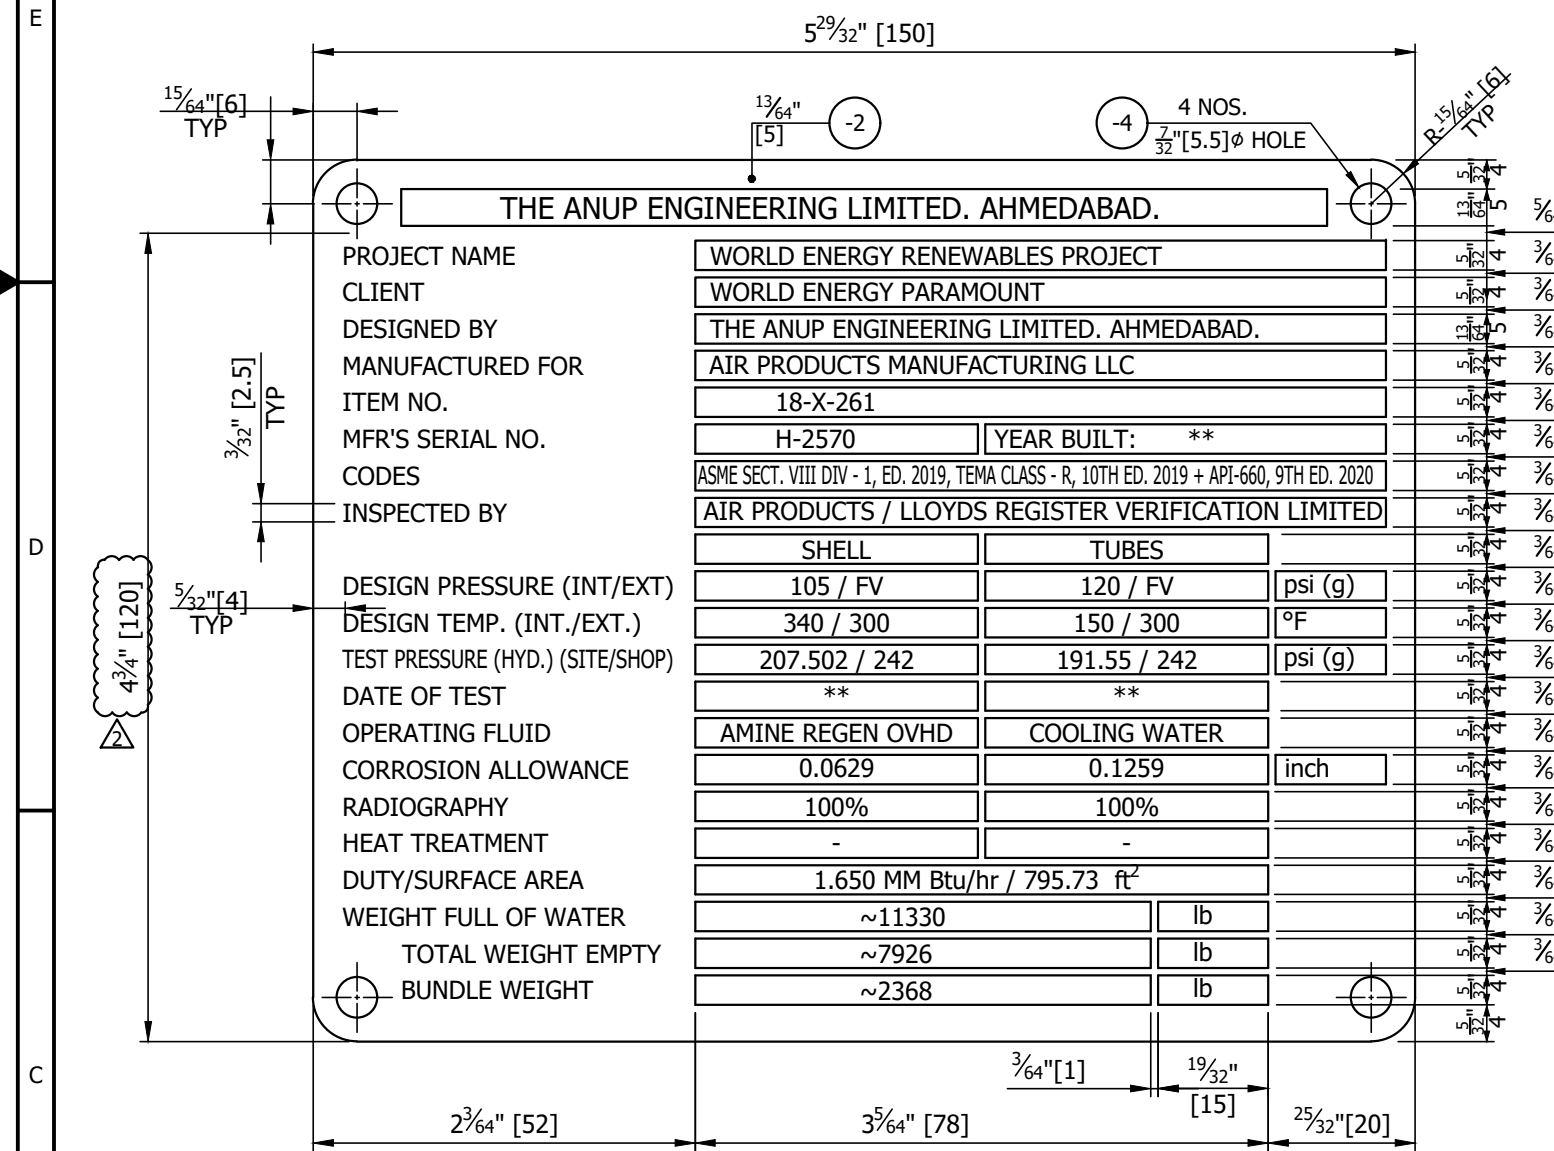

D1) MECHANICAL DESIGN CALCULATION SHALL BE AS PER ASME SEC.VIII-DIV.1 ED. 2019.

D2) FUTURE MACHINING ALLOWANCE OF 1/8" PROVIDED FOR ALL FLANGE GASKET SEATING SURFACES

MATERIAL:

M1) ALL PRESSURE PART CARBON STEEL SHALL BE FULLY KILLED CONDITION. ALL SS PARTS AND FORGINGS SHALL BE SUPPLIED IN SOLUTION ANNEALED AND PICKLED CONDITION.

M2) FOR CARBON STEEL THE CARBON CONTENT SHALL NOT EXCEED 0.23% AND THE CARBON EQUIVALENT (C.E.) SHALL BE 0.43 MAXIMUM WHERE,
 $CE = C + Mn/6 + (Cr+Mo+V)/5 + (Cu+Ni)/15$.

➤ M3) HARDNESS

- a. LAS MATERIAL SHALL NOT EXCEED 225 BHN.
- b. CS MATERIAL SHALL NOT EXCEED 200 BHN.
- c. TUBE MATERIAL SHALL NOT EXCEED **ROCKWELL HARDNESS C28**
- d. TUBESHEET MATERIAL SHALL NOT EXCEED 290 BHN.

➤ M4) MATERIAL CERTIFICATION SHALL BE AS FOLLOWS

- a. PRESSURE PARTS: EN 10204 TYPE 3.1 CERTIFICATE FOR AIR PRODUCTS APPROVED COUNTRIES AND TYPE 3.2 FOR NON APPROVED COUNTRIES.
- b. NON PRESSURE PARTS : EN 10204 TYPE 3.1 CERTIFICATE FOR AIR PRODUCTS APPROVED COUNTRIES AND TYPE 3.2 FOR NON APPROVED COUNTRIES.
- c. DELETED.

➤ M5) DELETED.

M6) ALL NOZZLE FLANGES ARE AS PER ASME B 16.5-2013 FOR SIZES DN 600 (NPS 24) & BELOW.

M7) FLANGE FACING TO BE IN ACCORDANCE WITH ASME B 16.5 SURFACE FINISH: ROUGHNESS Ra 3.2 TO 6.3 μm (Ra 125 TO 250 μinch).

M8) DIMENSIONS OF GASKET FOR STD. NOZZLE FLANGES SHALL BE AS PER ASME B16.20-2017.

M9) SPARE QUANTITY

- a. MANDATORY SPARE
 - i. GASKET: 200%
 - ii. FASTENERS: 10 % (MIN. 2)

M10) MATERIAL SHALL MEET THE REQUIREMENT OF TPS NO. LISTED BELOW.

M11) PAINT SYSTEM AS PER APPROVED PAINTING PROCEDURE & DOCUMENT NO. A8KM-PP-000-500520-A.
M12) CHARPY V NOTCH IMPACT TEST EXEMPTED AS PER UHA-51 FOR SHELL SIDE AND UCS 66(a) FOR CHANELL PLATES, UCS-66(c) FOR STANDARD FORGINGS AND UCS 66 NOTE(c) FOR BOLT MATERIAL. HOWEVER, TS SHALL BE IMPACT TESTED AS PER ASTM A 923 B AND SHALL MEET THE CHARPY VALUE OF >54J AT -40°C.

F1) ALL DIMENSIONS ARE IN (mm) UNLESS NOTED OTHERWISE. DIMENSIONS TOLERANCE SHALL BE AS PER API 660 AND TEMSA CLASS R

F2) ALL THICKNESSES SPECIFIED ON THE DRAWING ARE MINIMUM AFTER FORMING AND MACHINING.

F3) ROLLING OF PLATES SHALL BE IN LONGITUDINAL DIRECTION OF PLATES.

F4) ALL SHARP EDGES AND CORNERS SHALL BE ROUNDED OFF TO SMOOTH RADIUS.

F5) RAW MATERIAL IDENTIFICATION SHALL BE CARRIED OUT AS PER APPROVED QAP.

F6) WELDING TO BE DONE AS PER THE APPROVED WELDING PROCEDURE AND WELD TEST PLAN.

F7) ALL FLANGE FACES & OTHER MACHINED SURFACES SHALL BE GREASED OR PROTECTED WITH RUST PREVENTIVE COATING.

F8) NOZZLES SHALL BE LOCATED SO THAT THE NOZZLE, NOZZLE TO VESSEL WELD, AND NOZZLE REINFORCEMENT ARE AT LEAST 50 MM FROM ALL PRESSURE CONTAINING SHELL AND HEAD WELDS.

F9) CIRCUMFERENTIAL ATTACHMENTS SHALL HAVE A CLEARANCE OF AT LEAST ONE INCH (25MM) FROM WELDS AND OTHER CIRCUMFERENTIAL ATTACHMENTS.

F10) ALL VESSEL SEAMS SHALL BE LOCATED TO CLEAR ALL EXTERNAL AND INTERNAL PERMANENT ATTACHMENTS, THE DISTANCE FROM THE EDGE OF THE ATTACHMENT WELD TO THE EDGE OF MAIN WELD SHALL BE AT LEAST 50MM OR TWICE THE THICKNESS OF THE PRESSURE PART, WHICHEVER IS GREATER.

F11) ALL BOLT HOLES OF THE NOZZLE FLANGE SHALL STRADDLE CENTERLINE OF THE EQUIPMENT.

F12) ALL ATTACHMENTS DIRECTLY WELDED TO PRESSURE PARTS OF EQUIPMENT SHALL BE OF SAME MATERIAL AS THAT OF PRESSURE PART.

F13) THE MAX. $\pm$ DEVIATIONS FROM TRUE CIRCLE (E) MEASURED FROM A SEGMENTAL CIRCULAR TEMPLATE AS SHOWN BELOW.

F14) WELDING SHALL BE IN ACCORDANCE WITH THE SPECIFICATION A8KM-PP-000-50550-A

F14) WELDING SHALL BE IN ACCORDANCE WITH THE SPECIFICATION A8KM-PP-000-50550-A
"WELDING / NDE REQUIREMENTS FOR EQUIPMENT".

F15) EXTERNAL NOZZLE PROJECTION ARE FROM THE VESSEL CENTER LINE TO THE GASKET FACE OF FLANGE.

F16) ALL WELDS, INCLUDING TACK AND FIT UP WELDS, SHALL BE DONE WITH APPROVED PROCEDURES,
MATERIALS AND CERTIFIED WELDERS / WELDING OPERATORS.

F17) THE FILLER METAL SHALL BE IN ACCORDANCE WITH PARAGRAPH 5.2.3, A8KM-PP-000-500530-A

- 11) ALL PRESSURE BEARING BUTT WELD JOINTS ON SHELL SIDE AND TUBE SIDE SHALL BE 100% RADIOGRAPHED AS PER UW-11(a).
- 12) 100% MT/PT SHALL BE PERFORMED FOR ALL WELDS.
- 13) DELETED.
- 14) DELETED.
- 15) WELDS JOINING NON-PRESSURE CONTAINING COMPONENTS TO PRESSURE CONTAINING COMPONENTS SHALL BE 100% LIQUID PENETRANT OR MAGNETIC PARTICLE EXAMINED (AFTER PWHT, WHEN PWHT IS REQUIRED). THIS APPLIES TO PERMANENT AND NON-PERMANENT (E.G., LIFTING LUGS, TRUNIONS, ETC.) ATTACHMENTS ON THE INSIDE AND OUTSIDE OF THE VESSEL.
- 16) WHEN TEMPORARY ATTACHMENTS ARE REMOVED, THE AREA SHALL BE GROUND FLUSH WITH THE SURROUNDING SHELL SURFACE AND LIQUID PENETRANT OR MAGNETIC PARTICLE EXAMINED.
- 17) LEAK TEST SHALL BE PERFORMED BEFORE CODE TESTING AS PER CLAUSE 3.13.1, SPEC-ENG-DOC002

HYDRO TEST

H1) PRESSURE TESTING SHALL BE COMPLETED BEFORE PRIMERS, PAINT, OR OTHER COATINGS ARE APPLIED.

H2) THE WATER USED FOR HYDROSTATIC TESTING FOR AUSTENITIC STAINLESS STEEL VESSELS SHALL BE CONDENSATE , DEMINERALIZED, OR POTABLE WITH A SOLUBLE CHLORIDE CONTENT OF LESS THAN 50 PARTS PER MILLION (PPM) BY VOLUME.

H3) THE WELDS OF WELDED ATTACHMENTS PROVIDED WITH VENT HOLES SHALL BE LEAK TESTED USING 15PSIG (1 KG/CM2 (G)) PNEUMATIC PRESSURE AND A BUBBLE FORMING SOLUTION PRIOR TO POSTWELD HEAT TREATMENT AND FINAL HYDROSTATIC TEST.

H4) THE VESSEL SHALL BE DRAINED AND THOROUGHLY DRIED IMMEDIATELY UPON THE COMPLETION OF PRESSURE TESTING. THE PROCEDURE FOR DRAINING THE TEST FLUID SHALL PREVENT DEVELOPMENT OF VACUUM PRESSURE WITHIN THE VESSEL OR ITS INTERNALS. THE PROCEDURE SHALL PREVENT DAMAGE TO OR DISLOCATION OF THE INTERNALS.

H5) THE HYDROSTATIC TEST PRESSURE SHALL BE HELD FOR AT LEAST 30 MINUTES.

H6) HOT AIR MAY BE USED FOR DRYING OF AUSTENITIC STAINLESS STEEL IF AND ONLY IF THE HYDROSTATIC TEST WATER HAS CHLORIDE CONTENT OF LESS THAN 1 PPM

T1) EQUIPMENT SHALL BE PURGED WITH NITROGEN AT 0.5 KG/CM2 (G) PRESSURE.
T2) EQUIPMENT ON TUBESIDE IS PWHT AND SHALL BE LABELED "TUBESIDE IS PWHT – DO NOT WELD."
T3) ADDITIONAL INDICATIONS SUCH AS NORTH/SOUTH/EAST/WEST ALONG WITH CENTER OF GRAVITY SHALL BE CLEARLY MARKED.

		WELD JOINT NO.- E401 & E402					TOTAL WEIGHT kg :		10.40	


[illegible]

Xist 8.2 14-02-2022 12:28 SN: 00290-1122621047

US Units

Amine Energy OVHD Trim Cooler : 18-X-261

Rating - Horizontal Multipass Flow TEMA AEU Shell With Double-Segmental Baffles

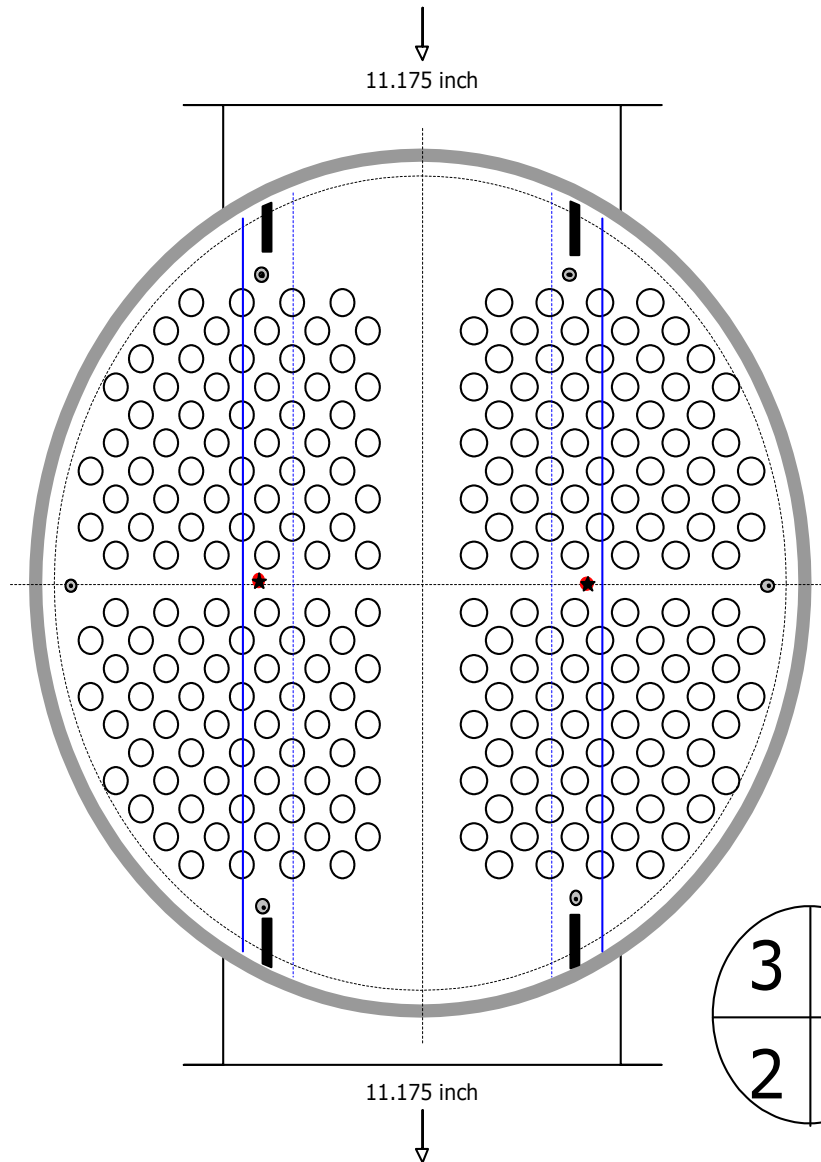

Item number	18-X-261
TEMA type	AEU
Shell ID	21.250 inch
Actual OTL	20.557 inch
Height under inlet nozzle	21.250 inch
Height under outlet nozzle	3.1673 inch
Tube type	Plain
Tube OD	0.7500 inch
Tube pitch	1.0000 inch
Tube layout angle	45 deg
Tubes	220
Tube positions available	220
Tie rods	6
Seal strip pairs	2
Passlane seal rods	2
Tube Passes	4
Parallel passlane width	0.6875 inch
Perpendicular passlane width	2.2500 inch
Baffle cut % diameter	26.3

TUBEPASS DETAILS

Pass	Rows	Tubes
1	10	55
2	10	55
3	10	55
4	10	55

SYMBOL LEGEND

- Tube
- ▲ Dummy Short Tube
- ▲ Dummy Long Tube
- Plugged Tube
- ⊙ Tie Rod
- ★ Seal Rod
- ⊗ Impingement Rod