


FOR FLANGE DETAILS SEE DWG. 12

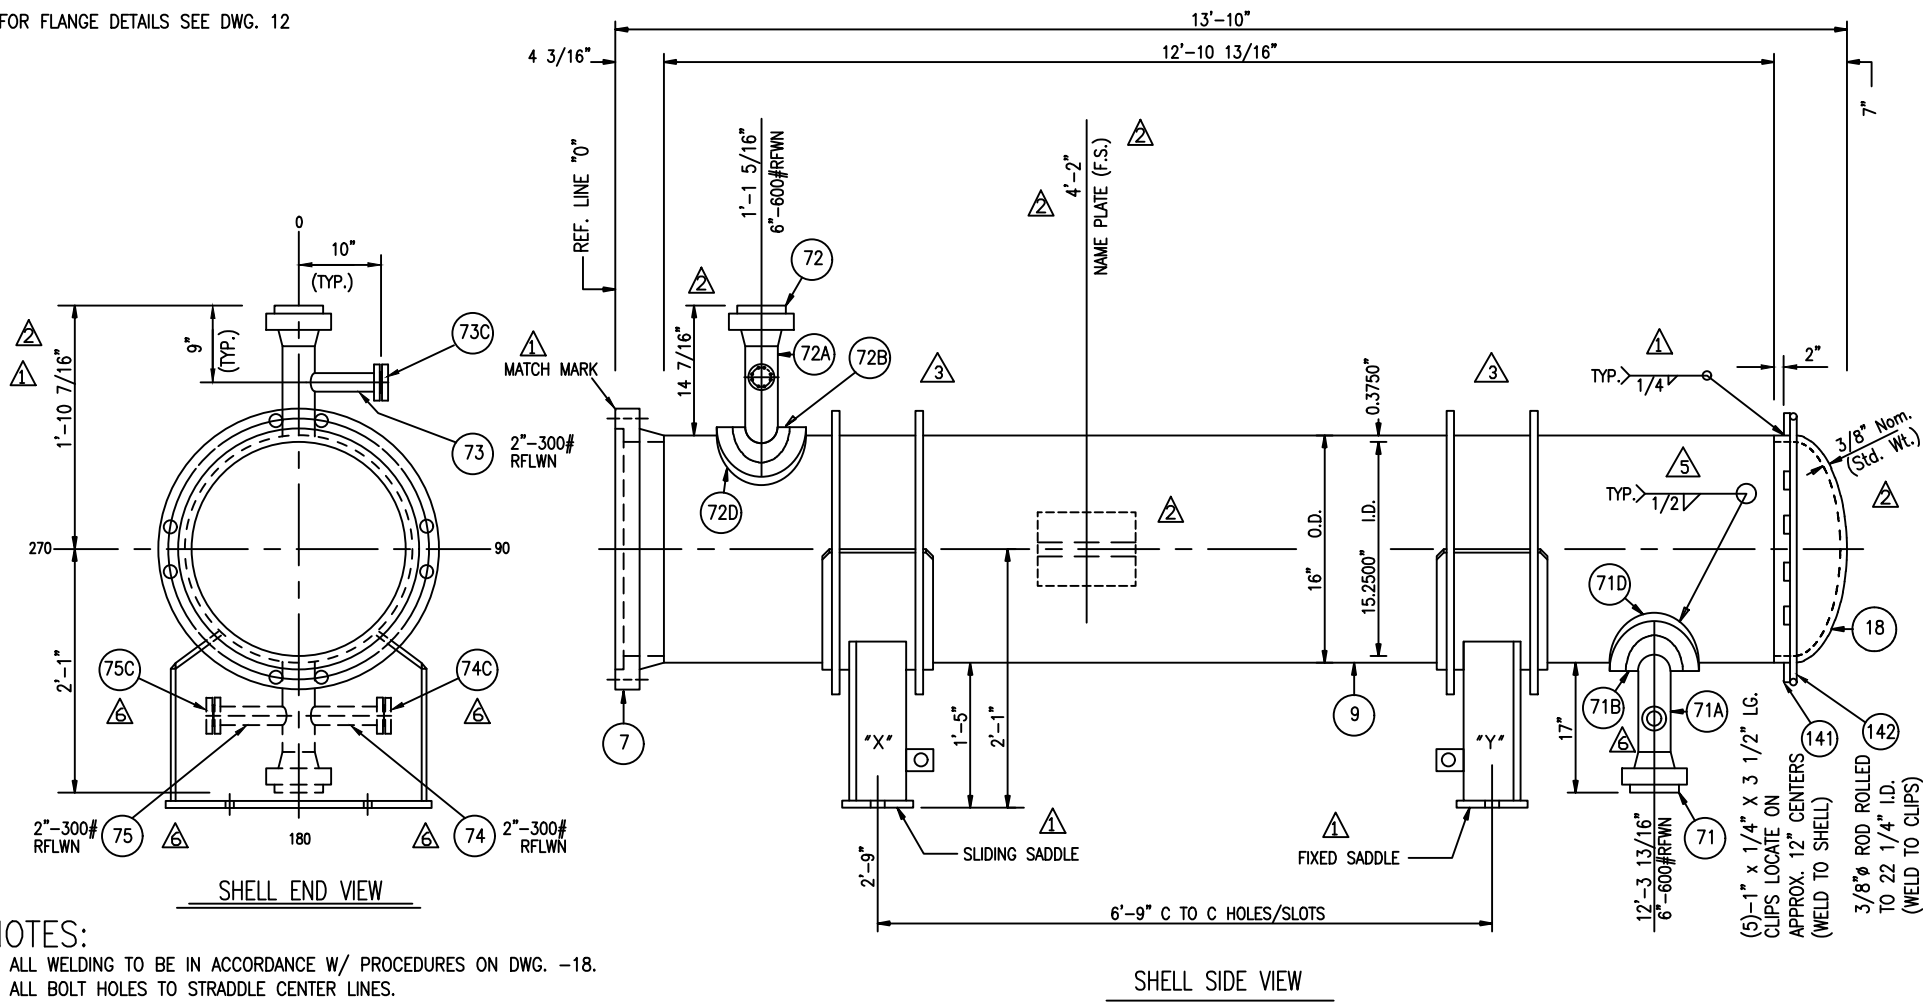

NOTES:

- 1) ALL WELDING TO BE IN ACCORDANCE W/ PROCEDURES ON DWG. -18.
2) ALL BOLT HOLES TO STRADDLE CENTER LINES.
3) FOR WELD AND BEVEL DETAILS SEE DWG. -13.
4) FOR SUPPORT DETAILS SEE DWG. -9.
5) GRIND ALL INSIDE WELDS FLUSH.
6) SPOT X-RAY PER UW-11(a)(5)(b)
- PROJECT NAME: WORLD E
EQUIPMENT OWNER: AIR P

PROJECT NAME: WORLD ENERGY RENEWABLES PROJECT
EQUIPMENT OWNER: AIR PRODUCTS MANUFACTURING LLC
SERVICE: STRIPPER FEED / DEBUTANIZER BOTTOMS EXCHANGER
LOCATION: WORLD ENERGY, PARAMOUNT, CA. USA
PRODUCT: STRIPPER FEED / DEBUTANIZER BOTTOMS EXCHANGER
ITEM NO.: 18-X-372A
AIR PRODUCTS P.O. NO.: 4505600057 / ABKM-4-402-PO-2
AP PROJECT NO.: EN-20-7120
VDR CODE NO.: BE04
SERIAL NO.: S21-13258-9
ENGINEER: EG
CUSTOMER / CLIENT: WORLD ENERGY PARAMOUNT

	4/21/23	REV. "AS BUILT" / FABSCO AS/DD	SHELL DETAILS		
	2/17/23	ADD WELD SYMBOL/FABSCO DD/DG			
	1/10/23	ADD NOZ. PAD RING/CUST. DD/DG	DWN. BY B.W.	 SHELL & TUBE, LLC	
	10/13/22	ADD SUP'T RINGS/CUST. DD/DG			
	9/20/22	REV. PER CUST. B.W./DD	DATE 5/23/22		
	8/2/2022	REV./CUST. COMMENTS GO/DD	CKD. BY <i>DiCarlo</i>		
NO.	DATE	REVISIONS			