

-----API-660-----

- 1) STENCIL THE FOLLOWING ON THE EXCHANGER IN  
3" HIGH (MIN.) WHITE BLOCK LETTERS::  
P.O. NO.: 4505600057  
ITEM NO.: 18-X-378  
SHIPPING WT.: 2,050 LBS
- 2) STUDS, NUTS AND THREADED SURFACES SHALL BE  
COATED WITH MARKAL E-Z- BREAK COMPOUND  
BEFORE ASSEMBLY.
- 3) HYDRO TEST PRESSURE SHALL BE HELD FOR A  
MINIMUM OF ONE HOUR.
- 4) PLUG SHELL INSIDE DIAMETER WITH A METAL  
TEMPLATE CONSISTING OF TWO DISCS  
(EACH HAVING A DIAMETER EQUAL TO THE  
DIAMETER OF THE BAFFLES) RIGIDLY MOUNTED  
PERPENDICULAR TO A SHAFT, AND SPACED 12"  
APART.
- 5) AT LEAST ONE SPOT RADIOGRAPH SHALL BE MADE  
OF EACH CIRCUMFERENTIAL AND LONGITUDINAL  
JOINT. SPOT RADIOGRAPHS SHALL INCLUDE EACH  
START, STOP AND BURN-THROUGH OF WELDS  
MADE BY THE AUTOMATIC SUBMERGED ARC  
PROCESS.
- 6) SPOT RADIOGRAPHS SHALL BE AT LEAST 10" LONG,  
OR SHALL BE FULL LENGTH WHERE WELDS ARE  
LESS THAN 10 INCHES LONG.
- 7) THE FLATNESS TOLERANCE (MAXIMUM DEVIATION  
FROM A PLANE) ON PERIPHERAL GASKET CONTACT  
SURFACES SHALL BE  $\pm 1/32"$ .
- 8) FLATNESS OF GASKET SURFACES SHALL BE  
MEASURED WITH A DIAL INDICATOR. PASS PLATE  
GROOVES CAN BE MEASURED WITH A STRAIGHT  
EDGE.

-----API-660 CONT.-----

- 9 WELD METAL AND HAZ. HARDNESS EXAMINATION REQUIREMENTS ARE AS FOLLOWS (AFTER PWHT, IF REQUIRED):
  - 225 BHN, MAXIMUM.
  - A 10mm BALL IS REQUIRED FOR TESTING.
  - TEST ONE LONGITUDINAL AND ONE CIRCUMFERENTIAL WELD AND EACH CONNECTION TO COMPONENT WELD OF NOZZLES 2" NPT AND LARGER.
  - IF MORE THAN ONE WELDING PROCEDURE IS USED TO PERFORM LONGITUDINAL OR CIRCUMFERENTIAL WELDS, HARDNESS READINGS SHALL BE MADE OF THE WELDS DEPOSITED BY EACH PROCEDURE.
  - HARDNESS READINGS AND LOCATIONS SHALL BE RECORDED.
  - TESTING TO BE DONE ON INSIDE SURFACE IF ACCESSIBLE.
- 10) COAT EXPOSED MACHINED SURFACES WITH AN EASILY REMOVABLE RUST PREVENTATIVE.
- 11) NOTIFY CUSTOMER TEN (10) DAYS PRIOR TO START OF FABRICATION, WITNESS OR HOLD POINTS.
- 12) MATCH MARKS SHALL BE PROVIDED TO ENSURE PROPER ALIGNMENT OF BOLTED JOINTS.
- 13) STAMP THE SERIAL No. ON O.D. OF TUBESHEETS, FLANGES AND CHANNEL COVERS.
- 14) HYDRO TEST CHARTS REQUIRED.
- 15) NOZZLE WELD PADS & SUPT. PADS SHALL BE AIR & SOAP TESTED W/15 PSI (MIN), 25 PSI (MAX) AIR PRESSURE.
- 16) SHELLSIDE HYDRO TEST SHALL BE PERFORMED WITH CHANNEL COVER REMOVED.
- 17) TUBE WALL REDUCTION SHALL BE 8% MAX.

-----STANDARD SHOP PRACTICES-----

- 1) ALL BOLT HOLES SHALL STRADDLE NATURAL CENTERLINES.
- 2) GRIND INSIDE WELDS FLUSH WITH SHELL.
- 3) GRIND INSIDE WELDS SMOOTH WITH CHANNELS.
- 4) RADIUS ALL NOZZLES 1/8" INSIDE AT CYLINDER I.D.
- 5) SEAL WELD SUPPORT SADDLES WITH 1/4"(MIN) FILLET WELD.
- 6) EXCHANGER SHALL BE CLEANED INSIDE AND OUTSIDE OF WELD SPATTER, DIRT, WELD ROD AND OTHER DEBRIS.
- 7) FOR MDMT OF +30° F. (MINIMUM), HYDRO TEST WATER TEMPERATURE SHALL NOT TO BE LESS THAN 40°F.
- 8) ALL EXTERNAL ATTACHMENTS TO BE SEAL WELDED.
- 9) HYDROSTATIC TEST, USE CLEAN WATER WITH A CORROSION INHIBITOR ADDED.  
VOLUME OF WATER SHELLSIDE = 49 GALLONS (APPROXIMATELY)  
VOLUME OF WATER TUBESIDE = 20 GALLONS (APPROXIMATELY)
- 10) ALL LIFTING DEVICE ATTACHMENT WELDS SHALL BE EXAMINED BY THE PT METHOD.
- 11) INSTALL SHIPPING COVERS ON NOZZLES W/O BLD. FLG'S.
- 12) ALL SEAL WELDED EXTERNAL NON PRESSURE ATTACHMENTS REQUIRE A 1/4" NPT VENT HOLE.
- 13) AFTER THE HYDRO TEST, THE HEAT EXCHANGER SHALL BE COMPLETELY DRAINED AND THOROUGHLY DRIED.

-----NDT REQUIREMENTS-----

- 1) SHELL: SPOT RADIOGRAPH.
- 2) CHANNEL: SPOT RADIOGRAPH.

PROJECT NAME: WORLD ENERGY RENEWABLES PROJECT  
EQUIPMENT OWNER: AIR PRODUCTS MANUFACTURING LLC  
SERVICE: **PROPANE PRODUCT COOLER**  
LOCATION: WORLD ENERGY, PARAMOUNT, CA. USA  
PRODUCT: PROPANE PRODUCT COOLER  
ITEM NO.: 18-X-378  
AIR PRODUCTS P.O. NO.: 4505600057 / A8KM-4-402-PO-2  
AP PROJECT NO.: EN-20-7120  
VDR CODE NO.: BE04  
SERIAL NO.: S21-13258-14  
ENGINEER: EG  
CUSTOMER / CLIENT: WORLD ENERGY PARAMOUNT

|     |         |                       |           |         |                                               |      |
|-----|---------|-----------------------|-----------|---------|-----------------------------------------------|------|
|     |         |                       | JOB NOTES |         |                                               |      |
|     |         |                       | DWN. BY   |         | <b>Fabsco</b><br><u>SHELL &amp; TUBE, LLC</u> |      |
|     |         |                       | B.W.      |         |                                               |      |
|     |         |                       | DATE      |         |                                               |      |
|     |         |                       | 8/11/22   |         |                                               |      |
| △   | 8/11/22 | ADDED DWG. PER FABSCO | B.W./DD   | CKD. BY | DWG. NO.                                      | REV. |
| NO. | DATE    | REVISIONS             |           | DICARLO | S21-13258-14-1B                               | 1    |

-----CUST. NOTES-----

- 1) ALL SHARP EDGES SHALL BE GROUND TO A .078" RAD. (MIN.)
- 2) THE INITIAL ROOT PASS OF DBL WELDED GROOVE JOINTS, INCLUDING ROOT TACK WELDS, SHALL BE CHIPPED, GROUND &/OR GOUGED TO SOUND METAL, AREA TO BE EITHER MPE OR DPE PRIOR TO WELDING FROM OTHER SIDE.
- 3) PRESSURE CONTAINING WELDS, INTERNAL ATTACHMENT WELDS, & SUPPORT WELDS SHALL BE CONTOURED TO PERMIT PROPER INTERPRETATION OF ANY REQ'D. UT EXAMINATION.
- 4) ALL WELDING CONSUMABLES SHALL BE OF LOW HYDROGEN TYPE. E60XX ELECTRODES SHALL NOT BE USED!
- 5) TEMPORARY ATTACHMENTS TO BE REMOVED BY MECHANICALLY OR THERMALLY CUT WITHIN 1/8" OF SURFACE. AREA TO BE GROUND FLUSH W/ SURROUNDING AREAS FOLLOWED BY MPE OR DPE. DO NOT "KNOCK OFF."
- 6) NOZ. TO CYL. WELDS, BRANCH NOZ. WELDS WHICH CAN'T BE X-RAYED SHALL BE UT.
- 7) ALL ARC STRIKES, START, STOPS SHALL BE CONFINED TO THE WELDING GROOVE OR SHALL BE REMOVED BY LIGHT GRINDING FOLLOWED BY MPT OR DPE.
- 8) HYDRO TEST WATER TEMP. AT ALL LOCATIONS SHALL BE AT LEAST 50°F. AT ALL TIMES DURING HYDROTEST.
- 9) THE USE OF HIGH NICKEL CONTENT C'STL. WELDING CONSUMABLES OR C-1/2Mo CONSUMABLES IS PROHIBITED.
- 10) ALL WELD SURFACES TO BE VISUALLY INSPECTED TO ENSURE THAT LAMINATIONS &/OR OTHER DEFECTS ARE NOT PRESENT.

-----CUST. NOTES CONT.-----

- 11) PEENING IS NOT PERMITTED FOR PURPOSE OF CLEANING WELDS.
- 12) EXCH'S. TO BE STENCILED W/ THE FOLLOWING"  
"HEIGHTH" : 2'-10"  
"WIDTH" : 1'-4"  
"LENGTH" : 17'-9"  
"WEIGHT" : 2,050#
- 13) FINISHED EXCHANGER IS TO BE WEIGHTED. TO BE WITHIN +/- 2% OR BETTER ACCURACY. A CALIBRATED WEIGHT CERTIFICATE SHALL BE PROVIDED.
- 14) THE TEMPERATURE OF THE HYDRO TEST WATER & THE EXCHANGER SHALL BE EQUALIZED PRIOR TO HYDROTEST.
- 15) STAMPING TO BE DONE WITH "LOW STRESS" STAMPS.
- 16) LIFTING POINTS & CENTER OF GRAVITY SHALL BE MARKED ON EXCHANGER.
- 17) THE ENTIRE SURFACE OF FORGINGS INCLUDING WELD BEVEL SHALL BE EXAMINED BY MT AFTER FINISH MACHINING & PRIOR TO WELDING.
- 18) EXCHANGER SHALL BE IN A MANNER WHICH KEEPS NOZZLES FROM TOUCHING THE TRUCK BEDS AND/OR SURFACES AT OFF-LOADING AREA AT JOBSITE.
- 19) PRIOR TO WELDING, JOINTS SHALL BE VISUALLY INSPECTED FOR CLEANLINESS, CONDITION OF TACK WELDS IF PRESENT, PREHEAT IF SPECIFIED, AND FILLER METAL TO BE USED.
- 20) REQUIRED PREHEAT TEMPERATURE SHALL ALSO APPLY TO THERMAL CUTTING AND TACK WELDING.
- 21) PREHEAT ALL JOINT TO A MINIMUM OF 125° F. WHEN MOISTURE REMOVAL IS REQUIRED.

-----CUST. NOTES CONT.-----

- 22) FOR SET ON NOZZLES, THE BASE METAL ADJACENT TO AUX. NOZZLE OPENINGS ON MAIN NOZZLES SHALL BE THOROUGHLY U.T. & M.P.E. TO ENSURE THAT THERE ARE NO FLAWS. (ETC. LAMINATIONS)
- 23) WELDS FROM EACH WELD PROCEDURE, WELDER/WELDING OPERATOR SHALL BE SPOT RADIOGRAPHED IF ACCESSIBLE.
- 24) NON PRESSURE PARTS TO PRESSURE CONTAINING COMPONENT WELDS SHALL BE 100% M.P.E. OR D.P.E.
- 25) RADIOGRAPH OF WELDS IN PIPE EQ/OR SMALLER THAN 3" NPS, MAY BE DONE BY THE ELLIPTICAL PROJECTION TECHNIQUE. AT LEAST TWO SEPARATE EXPOSURES ARE REQ'D. AT 90° APART.
- △ 26) ALL WELDING SHALL BE IN ACCORDANCE WITH ASME SECT. IX & PROJECT SPECIFICATIONS  
A8KM-PP-000-500550-A, A8KM-PP-000-500532-A, 4WEQ-1051, 3-11-10, 4-11-11.
- △ 27) ALL SHELL & HEAD JOINTS SHALL BE BACK WELDED JOINTS, WHERE POSSIBLE.
- △ 28) ALL LONG & CIRC SEAMS, NOZZLE ATTACHMENT WELDS SHALL BE FULL PENETRATION WELDED AS SHOWN ON DWG. -13.
- △ 29) FOR OFFSET NOZZLES, THE MIN. THROAT DIMENSIONS SHALL BE MAINTAINED.
- △ 30) NON-PRESSURE ATTACHMENT WELDS TO PRESSURE PARTS ON SHELL SIDE (IN FLAMMABLE SERVICE) SHALL BE FULL PENETRATION WELDS.

PROJECT NAME: WORLD ENERGY RENEWABLES PROJECT  
EQUIPMENT OWNER: AIR PRODUCTS MANUFACTURING LLC  
SERVICE: **PROPANE PRODUCT COOLER**  
LOCATION: WORLD ENERGY, PARAMOUNT, CA. USA  
PRODUCT: PROPANE PRODUCT COOLER  
ITEM NO.: 18-X-378  
AIR PRODUCTS P.O. NO.: 4505600057 / A8KM-4-402-PO-2  
AP PROJECT NO: EN-20-7120  
VDR CODE NO.: BE04  
SERIAL NO.: S21-13258-14  
ENGINEER: EG  
CUSTOMER / CLIENT: WORLD ENERGY PARAMOUNT

|     |          |                         |                   |                              |      |
|-----|----------|-------------------------|-------------------|------------------------------|------|
|     |          |                         | JOB NOTES (CONT.) |                              |      |
|     |          |                         | DWN. BY           | <b>Fabsco</b>                |      |
|     |          |                         | B.W.              |                              |      |
|     |          |                         | DATE              | <b>SHELL &amp; TUBE, LLC</b> |      |
|     |          |                         | 8/15/22           |                              |      |
|     |          |                         | CKD. BY           | DWG. NO.                     | REV. |
|     |          |                         | <b>DiCarlo</b>    | S21-13258-14-1C              | 2    |
| NO. | DATE     | REVISIONS               |                   |                              |      |
| △   | 10/25/22 | ADDED NOTES/CUST. DD/DG |                   |                              |      |
| △   | 8/15/22  | ADDED DWG./FABSCO BW/DD |                   |                              |      |

- 1) MACHINE ALL COVER SURFACES TO 250 RMS  
EXCEPT GASKET FACES TO BE 125 RMS.
- 2) ALL COVER PASS PLATE GROOVE WIDTHS TO  
BE 1/2" WIDE.
- 3) ALL COVER PASS PLATE GROOVE JUNCTIONS  
TO BE NOTCHED 3/8" AT 45 Deg.




⊗ THK. INCLUDES 1/8" FUTURE  
MACHINING ALLOWANCE


NOTES:

- 1) ALL WELDING TO BE IN ACCORDANCE W/ PROCEDURES ON DWG. -18.
  - 2) ALL BOLT HOLES TO STRADDLE CENTER LINES.
  - 3) FOR WELD AND BEVEL DETAILS SEE DWG. -13.
  - 4) GRIND ALL INSIDE WELDS SMOOTH.
  - 5) SPOT RADIOGRAPHY.
- PROJECT NAME: WORLD  
EQUIPMENT OWNER: AIR  
SERVICE: PROPANE

PROJECT NAME: WORLD ENERGY RENEWABLES PROJECT  
EQUIPMENT OWNER: AIR PRODUCTS MANUFACTURING LLC  
SERVICE: *PROPANE PRODUCT COOLER*  
LOCATION: WORLD ENERGY, PARAMOUNT, CA. USA  
PRODUCT: PROPANE PRODUCT COOLER  
ITEM NO.: 18-X-378  
AIR PRODUCTS P.O. NO.: 4505600057 / A8KM-4-402-PO-2  
AP PROJECT NO.: EN-20-7120  
VDR CODE NO.: BE04  
SERIAL NO.: S21-13258-14  
ENGINEER: EG  
CUSTOMER / CLIENT: WORLD ENERGY PARAMOUNT

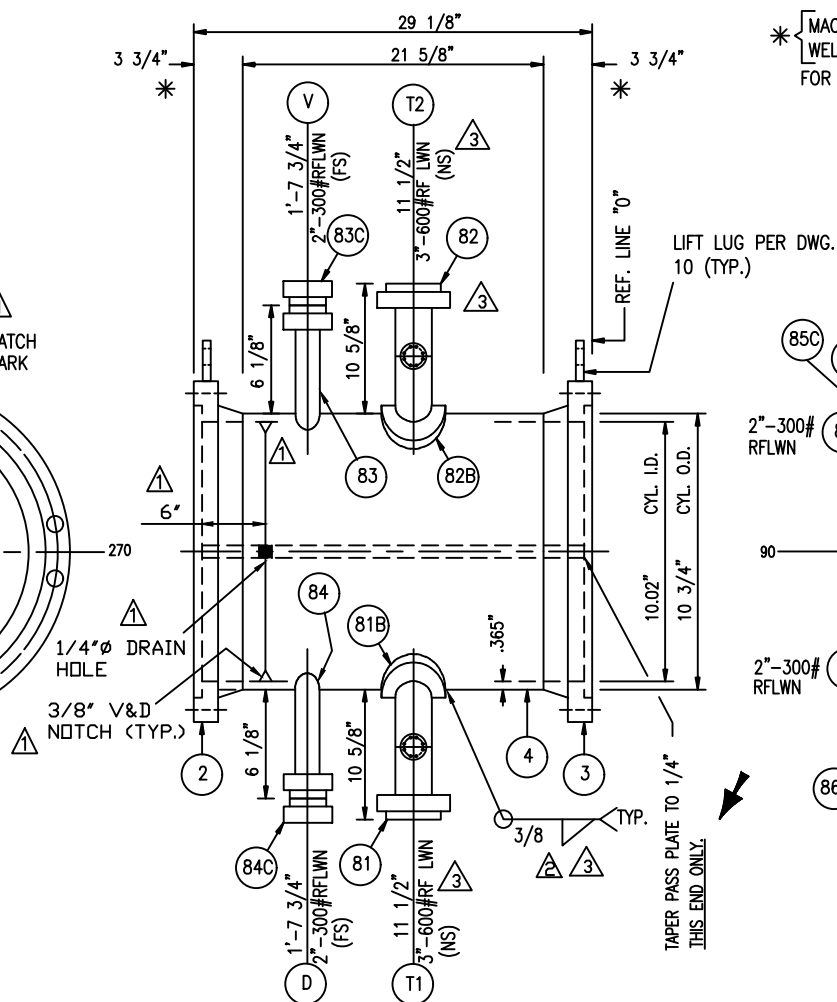


CHANNEL SIDE VIEW

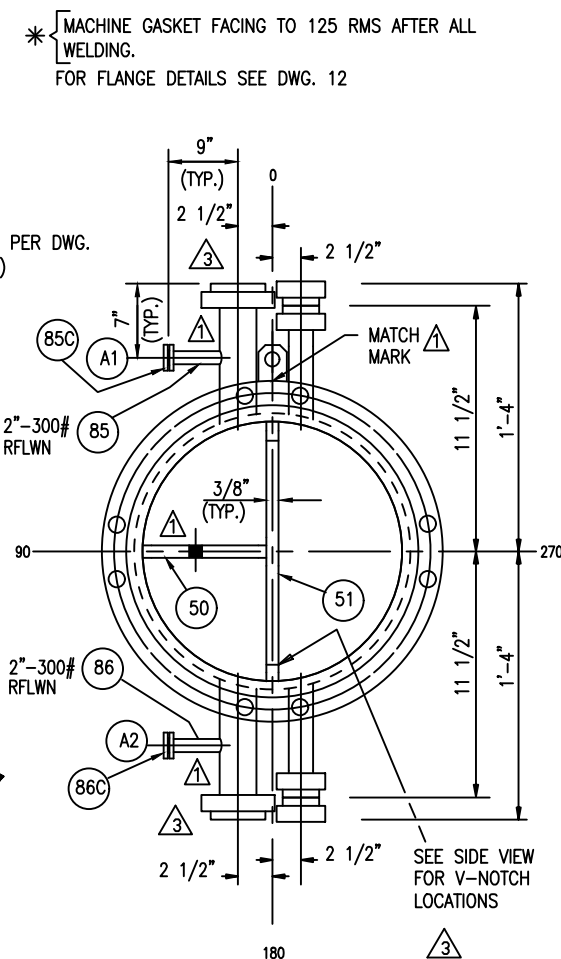

CHANNEL END VIEW

|     |          |                               |                           |   |          |
|-----|----------|-------------------------------|---------------------------|---|----------|
|     |          |                               | FRONT CHANNEL DETAILS     |   |          |
|     |          |                               | DWN. BY<br>B. W.          | <div style="text-align: center;">  <p><b>Fabsco</b><br/><b>SHELL &amp; TUBE, LLC</b></p> </div> |          |
|     |          |                               | DATE<br>6/8/22            |   |          |
| 3   | 10/25/22 | REV. PER CUST. COMMENTS DD/DG | CKD. BY<br><i>DiCarlo</i> | DWG.NO.   | REV<br>3 |
| 2   | 10/10/22 | REV./WRC107 ANALYSIS EMG      |                           |   |          |
| 1   | 8/11/22  | REV. PER CUST. B.W./DD        |                           |   |          |
| NO. | DATE     | REVISIONS                     |                           |   |          |

FOR FLANGE DETAILS SEE DWG. 12

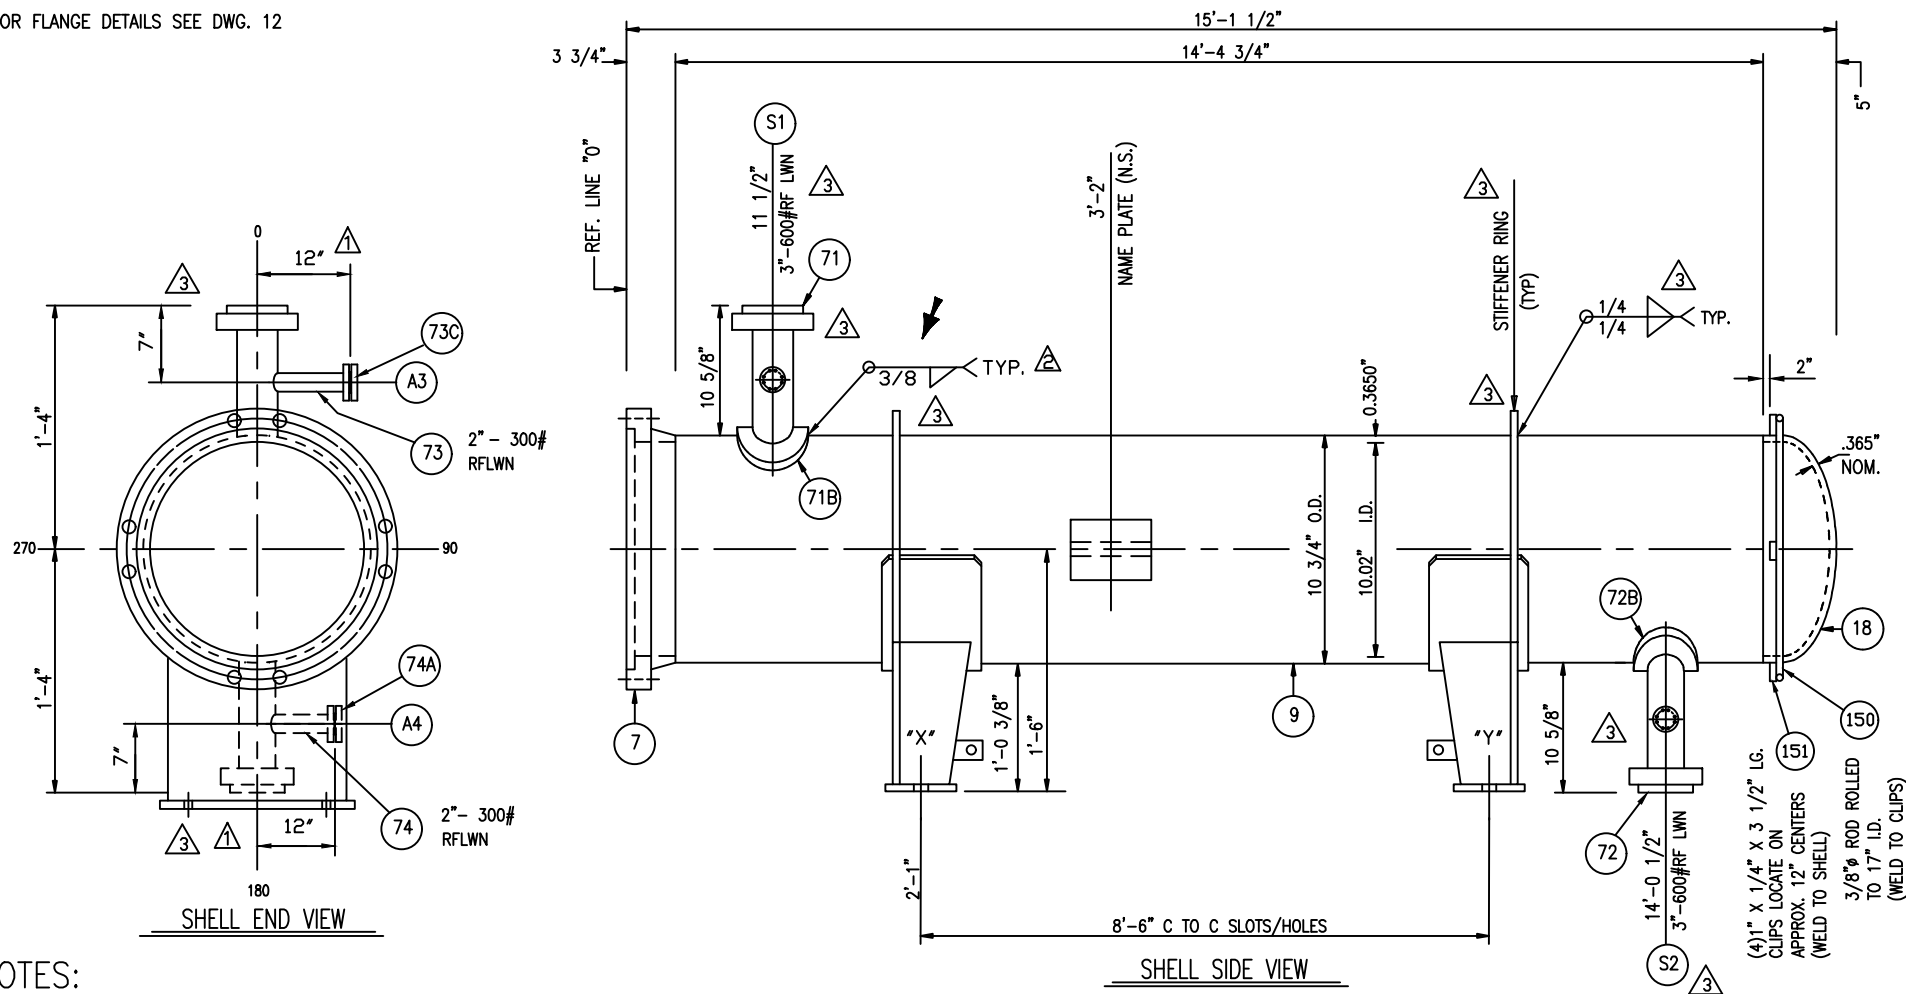


NOTES:

- 1) ALL WELDING TO BE IN ACCORDANCE W/ PROCEDURES ON DWG. -16.
  - 2) ALL BOLT HOLES TO STRADDLE CENTER LINES.
  - 3) FOR WELD AND BEVEL DETAILS SEE DWG. -13.
  - 4) FOR SUPPORT DETAILS SEE DWG. -9.
  - 5) GRIND ALL INSIDE WELDS FLUSH.
  - 6) SPOT RADIOGRAPHY.
- PROJECT NAME: WORLD  
EQUIPMENT OWNER: AIR  
SERVICE: *PROPANE*  
LOCATION: NORTHERN ENCL

PROJECT NAME: WORLD ENERGY RENEWABLES PROJECT  
EQUIPMENT OWNER: AIR PRODUCTS MANUFACTURING LLC  
SERVICE: **PROPANE PRODUCT COOLER**  
LOCATION: WORLD ENERGY, PARAMOUNT, CA. USA  
PRODUCT: PROPANE PRODUCT COOLER  
ITEM NO.: 18-X-378  
AIR PRODUCTS P.O. NO.: 4505600057 / A8KM-4-402-PO-2  
AP PROJECT NO.: EN-20-7120  
VDR CODE NO.: BE04  
SERIAL NO.: S21-13258-14  
ENGINEER: EG  
CUSTOMER / CLIENT: WORLD ENERGY PARAMOUNT

|     |          |                               |                           |                                                                                          |           |  |
|-----|----------|-------------------------------|---------------------------|------------------------------------------------------------------------------------------|-----------|--|
|     |          |                               | SHELL DETAILS             |                                                                                          |           |  |
|     |          |                               | DWN. BY<br>B.W.           | <div style="text-align: center;"> <b>Fabsco</b><br/> <u>SHELL &amp; TUBE, LLC</u> </div> |           |  |
| ③   | 10/25/22 | REV. PER CUST. COMMENTS DD/DG | DATE<br>6/8/22            |                                                                                          |           |  |
| ③   | 10/10/22 | REV./WRC107 ANALYSIS EMG      |                           |                                                                                          |           |  |
| ③   | 8/10/22  | REV. PER CUST. B.W./DD        | CKD. BY<br><i>DiCarlo</i> | DWG.NO.<br>S21-13258-14-3                                                                | REV.<br>3 |  |
| NO. | DATE     | REVISIONS                     |                           |                                                                                          |           |  |

DRILL & TAP 3/4" DEEP FOR 4- 1/2" DIA. (13-THD.)  
TIE RODS ON SHELL SIDE OF  
# 19 TUBESHEET. DO NOT DRILL THRU!!  
(SEE TUBE LAYOUT FOR LOCATIONS.)

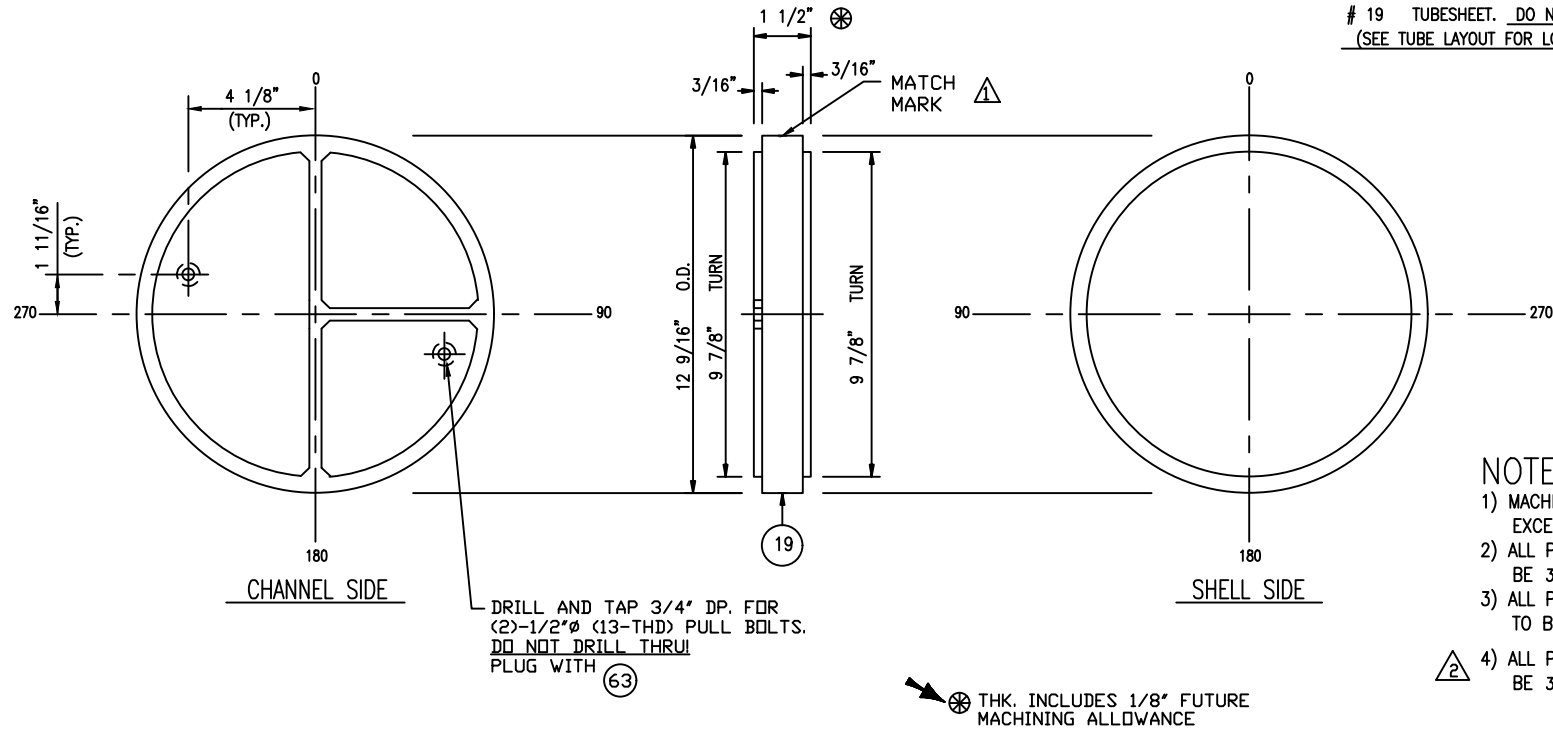


### NOTES:

- 1) MACHINE ALL SURFACES TO 250 RMS EXCEPT GASKET FACES TO BE 125 RMS.
- 2) ALL PASS PLATE GROOVE WIDTHS TO BE 3/8" WIDE.
- 3) ALL PASS PLATE GROOVE JUNCTIONS TO BE NOTCHED 3/8" AT 45 Deg.
- 4) ALL PASS PLATE GROOVE DEPTH IS TO BE 3/16" DEEP.

SEE DWG. -4A FOR SEAL WELD  
& TUBE HOLE GROOVING DETAIL


PROJECT NAME: WORLD ENERGY RENEWABLES PROJECT  
EQUIPMENT OWNER: AIR PRODUCTS MANUFACTURING LLC  
SERVICE: **PROPANE PRODUCT COOLER**  
LOCATION: WORLD ENERGY, PARAMOUNT, CA. USA  
PRODUCT: PROPANE PRODUCT COOLER  
ITEM NO.: 18-X-378  
AIR PRODUCTS P.O. NO.: 4505600057 / A8KM-4-402-PO-2  
AP PROJECT NO.: EN-20-7120  
VDR CODE NO.: BE04  
SERIAL NO.: S21-13258-14  
ENGINEER: EG  
CUSTOMER / CLIENT: WORLD ENERGY PARAMOUNT

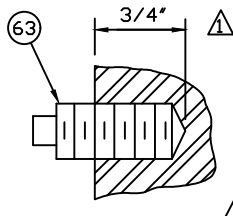

**SQUARE HEAD EYEBOLT PLUG DETAIL**

(65) EYEBOLT (TO SHIP LOOSE W/ EXCHANGER)

| TUBESHEET DETAILS |  |         |                |
|-------------------|--|---------|----------------|
|                   |  | DWN. BY | <b>Fabsco</b>  |
|                   |  | B.W.    |                |
|                   |  | DATE    | 6/8/22         |
|                   |  | CKD. BY |                |
|                   |  | DiCarlo | S21-13258-14-4 |
|                   |  | DWG.NO. |                |
|                   |  | REV.    | 2              |
|                   |  |         |                |

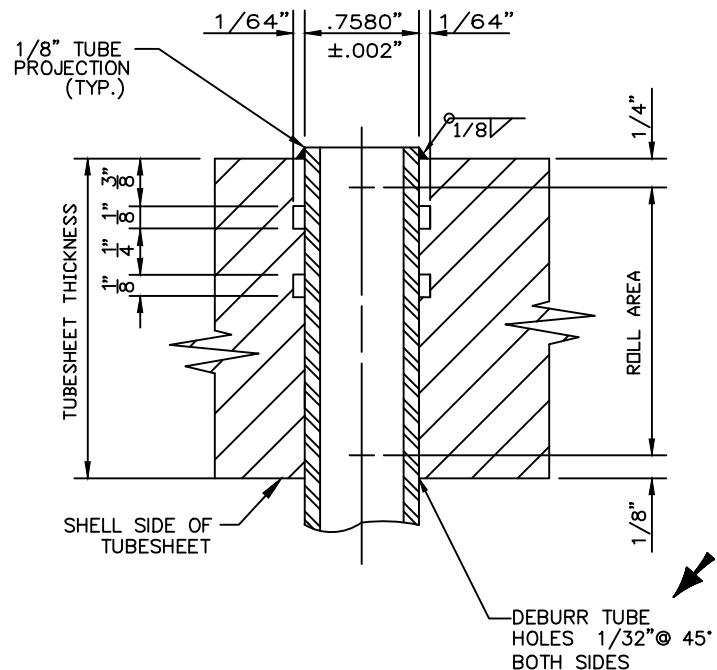



# TUBE TO TUBESHEET SEAL WELD AND FABRICATION SEQUENCE

\*\*\*\*\*

1. DRILL, REAM AND RING GROOVE TUBE HOLES PER DETAIL ABOVE.
2. CLEAN AREAS TO BE WELDED AND ROLLED WITH DEGREASER.
3. INSTALL TUBES IN BUNDLE AND SET PROJECTIONS.
4. FUSION WELD USING GTAW PROCESS USING WPS: T-234.
5. LIQUID PENETRANT EXAMINE ALL WELDS AND THEN CLEAN THEM WITH DEGREASER. REPAIR ANY DEFECTIVE WELDS AND RECHECK.
6. TUBE-TO-T'SHT. WELDS SHALL BE AIR & SOAP TESTED PRIOR TO FINAL ROLLING W/ 15 PSI (MAX.) AIR PRESSURE.
7. ROLL TUBES INTO TUBESHEET PER DETAIL ABOVE.
8. REPEAT STEP 5.
9. TUBE WALL REDUCTION SHALL BE 8% (MAX.)

PROJECT NAME: WORLD ENERGY RENEWABLES PROJECT  
 EQUIPMENT OWNER: AIR PRODUCTS MANUFACTURING LLC  
 SERVICE: **PROPANE PRODUCT COOLER**  
 LOCATION: WORLD ENERGY, PARAMOUNT, CA. USA  
 PRODUCT: PROPANE PRODUCT COOLER  
 ITEM NO: 18-X-378  
 AIR PRODUCTS P.O. NO: 4505600057 / A8KM-4-402-PD-2  
 AP PROJECT NO: EN-20-7120  
 VDR CODE NO: BE04  
 SERIAL NO: S21-13258-14  
 ENGINEER: EG  
 CUSTOMER / CLIENT: WORLD ENERGY PARAMOUNT

|     |         |                       |                                               |  |                                               |          |
|-----|---------|-----------------------|-----------------------------------------------|--|-----------------------------------------------|----------|
|     |         |                       | TUBE SEAL WELD<br>& TUBE HOLE GROOVING DETAIL |  |                                               |          |
|     |         |                       | DWN. BY<br>B.W.                               |  | <b>Fabsco</b><br><b>SHELL &amp; TUBE, LLC</b> |          |
|     |         |                       | DATE<br>8/10/22                               |  |                                               |          |
|     |         |                       | CKD. BY<br><i>DiCarlo</i>                     |  | DWG.NO.                                       | REV<br>1 |
| △   | 8/10/22 | ADDED DWG. PER FABSCO | B.W./DD                                       |  |                                               |          |
| NO. | DATE    | REVISIONS             |                                               |  |                                               |          |
|     |         |                       |                                               |  |                                               |          |

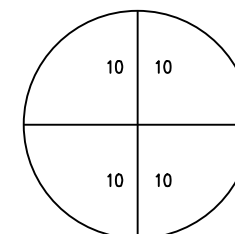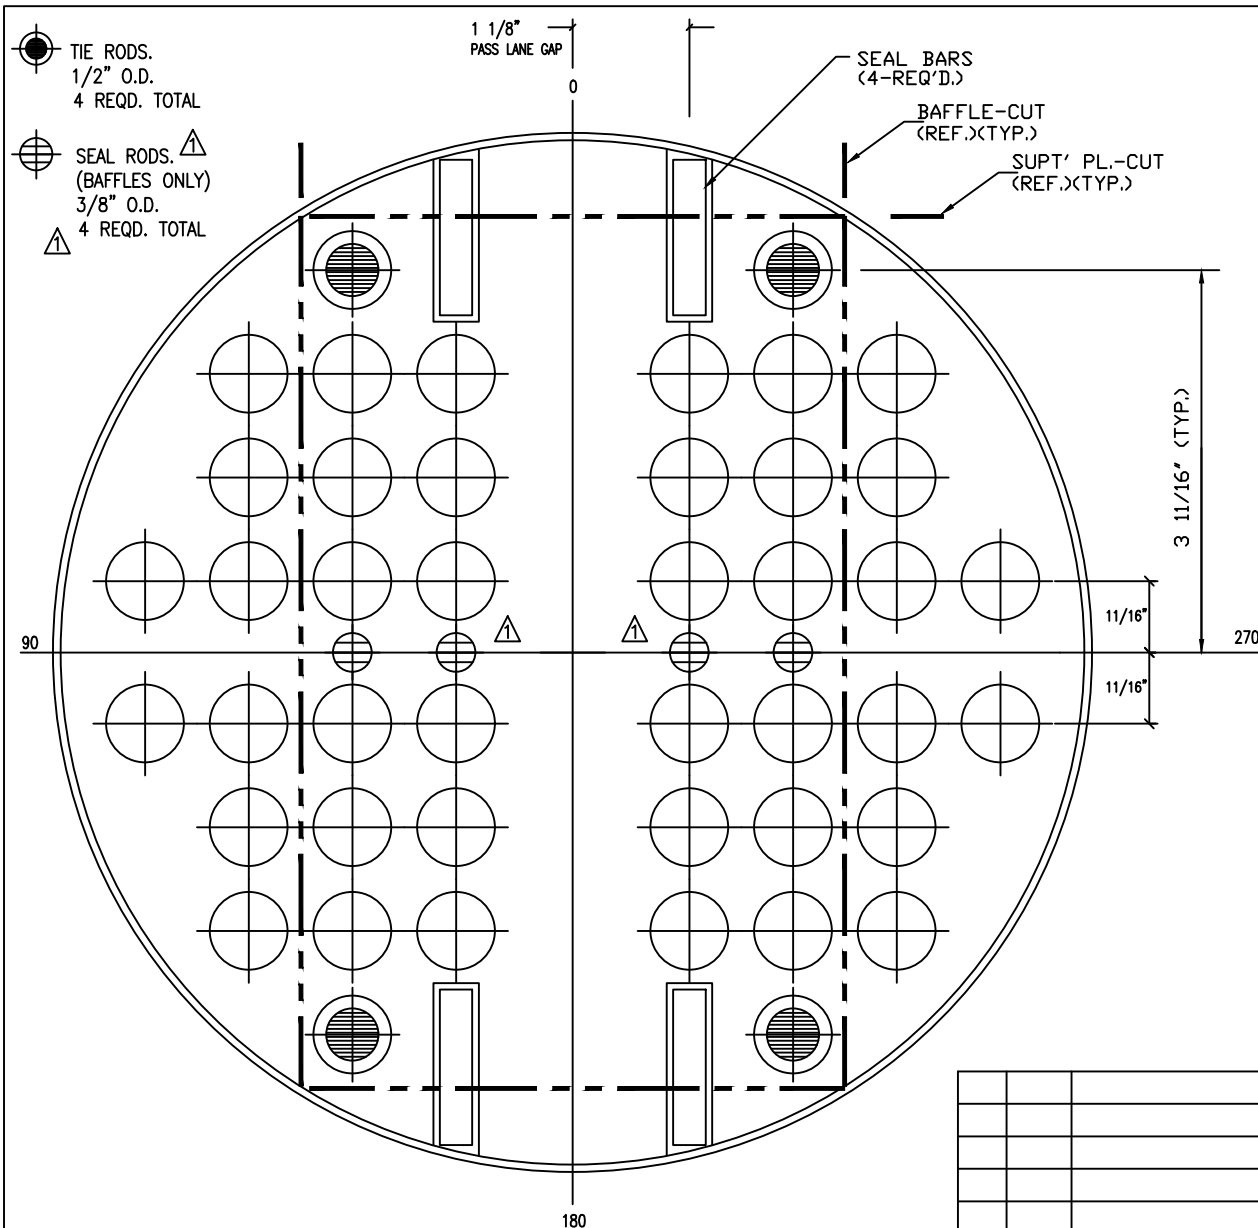

TUBE DISTRIBUTION

NOTES:


- 1) DRILL AND REAM TUBE HOLES IN TUBESHEETS TO 0.7580"  $\pm$  0.0020" DIA. FOR 20 - 3/4" O.D. U-TUBES. TOTAL HOLES = 40
- 2) TUBE PITCH = 1" SQUARE.
- 3) NUMBER OF PASSES = 4
- 4) SEE DRAWING 4A FOR TUBE GROOVING DETAILS.
- 5) BAFFLE O.D. = 9 7/8"
- 6) O.T.L. = 9 1/8"

PROJECT NAME: WORLD ENERGY RENEWABLES PROJECT  
 EQUIPMENT OWNER: AIR PRODUCTS MANUFACTURING LLC  
 SERVICE: **PROPANE PRODUCT COOLER**  
 LOCATION: WORLD ENERGY, PARAMOUNT, CA. USA  
 PRODUCT: PROPANE PRODUCT COOLER  
 ITEM NO.: 18-X-378  
 AIR PRODUCTS P.O. NO.: 4505600057 / A8KM-4-402-PO-2  
 AP PROJECT NO: EN-20-7120  
 VDR CODE NO.: BE04  
 SERIAL NO.: S21-13258-14  
 ENGINEER: EG  
 CUSTOMER / CLIENT: WORLD ENERGY PARAMOUNT

VIEW LOOKING AT SHELL SIDE OF NO. 19 TUBESHEET

|     |      |                |             |                                               |      |
|-----|------|----------------|-------------|-----------------------------------------------|------|
|     |      |                | TUBE LAYOUT |                                               |      |
|     |      |                | DWN. BY     | <b>Fabsco</b><br><b>SHELL &amp; TUBE, LLC</b> |      |
|     |      |                | B.W.        |                                               |      |
|     |      |                | DATE        |                                               |      |
|     |      |                | 6/8/22      |                                               |      |
|     |      |                | CKD. BY     | DWG.NO.                                       | REV. |
|     |      |                | DiCarlo     | S21-13258-14-5                                | 1    |
| ND. | DATE | REV. PER CUST. | B.W./DD     | REVISIONS                                     |      |
|     |      |                |             |                                               |      |

| ROW | NO.OF<br>TUBES | BEND<br>RADIUS | BEND<br>DIAMETER | BEND<br>LENGTH | STRAIGHT<br>LENGTH | CUT<br>LENGTH | DEVELOPED<br>LENGTH |
|-----|----------------|----------------|------------------|----------------|--------------------|---------------|---------------------|
| A   | 6              | 1 1/8"         | 2 1/4"           | 0'-3 9/16"     | 14'-6"             | 14'-7 1/2"    | 29'-3 9/16"         |
| B   | 6              | 2 1/8"         | 4 1/4"           | 0'-6 11/16"    | 14'-6"             | 14'-8 1/2"    | 29'-6 11/16"        |
| C   | 6              | 3 1/8"         | 6 1/4"           | 0'-9 7/8"      | 14'-6"             | 14'-9 1/2"    | 29'-9 7/8"          |
| D   | 2              | 4 1/8"         | 8 1/4"           | 1'-1"          | 14'-6"             | 14'-10 1/2"   | 30'-1"              |

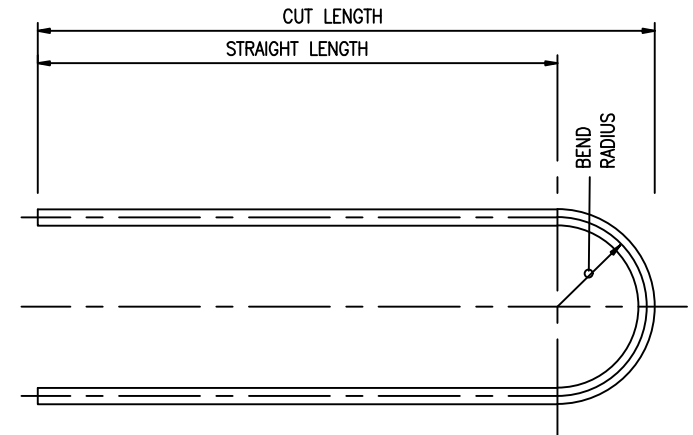

TOTAL NO. REQUIRED: 20  
 SIZE: 3/4" (.083" MIN.)  
 MATERIAL: SA-334-6 (SMLS.)



MAXIMUM OUT-OF-ROUNDNESS OF TUBES AT  
 U-BENDS NOT TO EXCEED 10%.

QUANTITIES SHOWN ARE FOR  
 ONE SET OF U-TUBES,  
 1 -SET REQ'D. TOTAL.


STRESS RELIEF ANNEAL U-BENDS PLUS 1'-0" OF STRAIGHT LGTH.  
 @ 1175° F. ± 25°F. BY ELECTRIC RESISTANCE METHOD.

PROJECT NAME: WORLD ENERGY RENEWABLES PROJECT  
 EQUIPMENT OWNER: AIR PRODUCTS MANUFACTURING LLC  
 SERVICE: **PROPANE PRODUCT COOLER**  
 LOCATION: WORLD ENERGY, PARAMOUNT, CA. USA  
 PRODUCT: PROPANE PRODUCT COOLER  
 ITEM NO.: 18-X-378  
 AIR PRODUCTS P.O. NO.: 4505600057 / A8KM-4-402-PO-2  
 AP PROJECT NO: EN-20-7120  
 VDR CODE NO.: BE04  
 SERIAL NO.: S21-13258-14  
 ENGINEER: EG  
 CUSTOMER / CLIENT: WORLD ENERGY PARAMOUNT

|     |      |           |                       |                                               |      |
|-----|------|-----------|-----------------------|-----------------------------------------------|------|
|     |      |           | TUBE BENDING SCHEDULE |                                               |      |
|     |      |           | DWN. BY               | <b>Fabsco</b><br><b>SHELL &amp; TUBE, LLC</b> |      |
|     |      |           | B.W.                  |                                               |      |
|     |      |           | DATE                  |                                               |      |
|     |      |           | 6/8/22                |                                               |      |
|     |      |           | CKD. BY               | DWG.NO.                                       | REV. |
| NO. | DATE | REVISIONS | DiCarlo               | S21-13258-14-6                                | 0    |

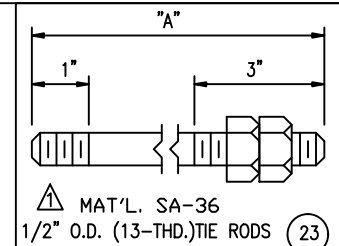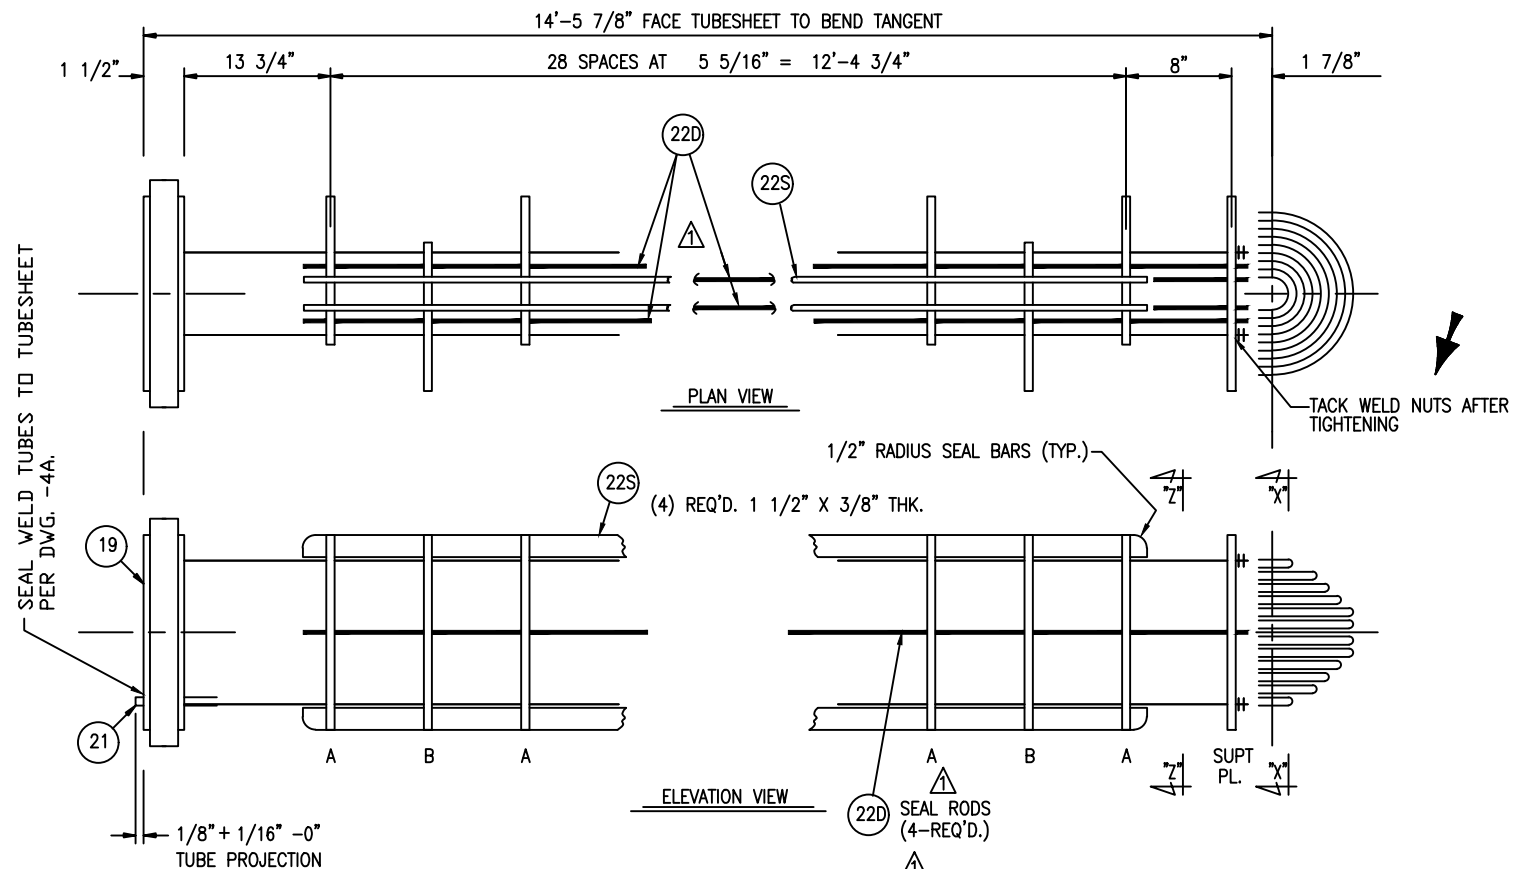

| REQ'D. | "A"    |
|--------|--------|
| (1) 4  | 14'-5" |
| (2)    |        |
| (3)    |        |

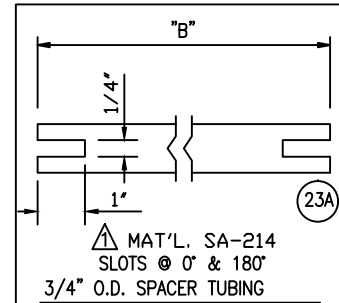


| REQ'D.  | "B"     |
|---------|---------|
| (A) 4   | 13 5/8" |
| (B) 112 | 5 1/16" |
| (C) 4   | 7 3/4"  |
| (D)     |         |
| (E)     |         |
| (F)     |         |
| (G)     |         |

# NOTES:

- 1) FOR SECTION AND VIEW DETAILS SEE DWG. 8
- 2) WELD SEAL BARS TO INTERSECTING BAFFLES ON TWO OPPOSING SIDES. TO PROJECT 1" PAST BAFFLES. RADIUS EACH END OF SEAL BAR. 1/4"(MIN.) FILLET WELD.
- 3) SEAL RODS TO PROJECT 1" PAST BAFFLES. WELD TO FIRST & LAST BAFFLE. 1/4"(MIN.) FILLET WELD.

PROJECT NAME: WORLD ENERGY RENEWABLES PROJECT  
EQUIPMENT OWNER: AIR PRODUCTS MANUFACTURING LLC  
SERVICE: **PROPANE PRODUCT COOLER**  
LOCATION: WORLD ENERGY, PARAMOUNT, CA. USA  
PRODUCT: PROPANE PRODUCT COOLER  
ITEM NO.: 18-X-378  
AIR PRODUCTS P.O. NO.: 4505600057 / A8KM-4-402-PO-2  
AP PROJECT NO.: EN-20-7120  
VDR CODE NO.: BE04  
SERIAL NO.: S21-13258-14  
ENGINEER: EG  
CUSTOMER / CLIENT: WORLD ENERGY PARAMOUNT



|     |         |                 |                    |  |                                                    |           |
|-----|---------|-----------------|--------------------|--|----------------------------------------------------|-----------|
|     |         |                 | BUNDLE DETAILS     |  |                                                    |           |
|     |         |                 | DWN. BY<br>B.W.    |  | <div>Fabsco</div> <div>SHELL &amp; TUBE, LLC</div> |           |
|     |         |                 | DATE<br>6/8/22     |  |                                                    |           |
| △   | 8/11/22 | REV. .PER CUST. | B.W./DD            |  |                                                    |           |
| NO. | DATE    | REVISIONS       |                    |  |                                                    |           |
|     |         |                 | CKD. BY<br>DiCarlo |  | DWG.NO.<br>S21-13258-14-7                          | REV.<br>1 |

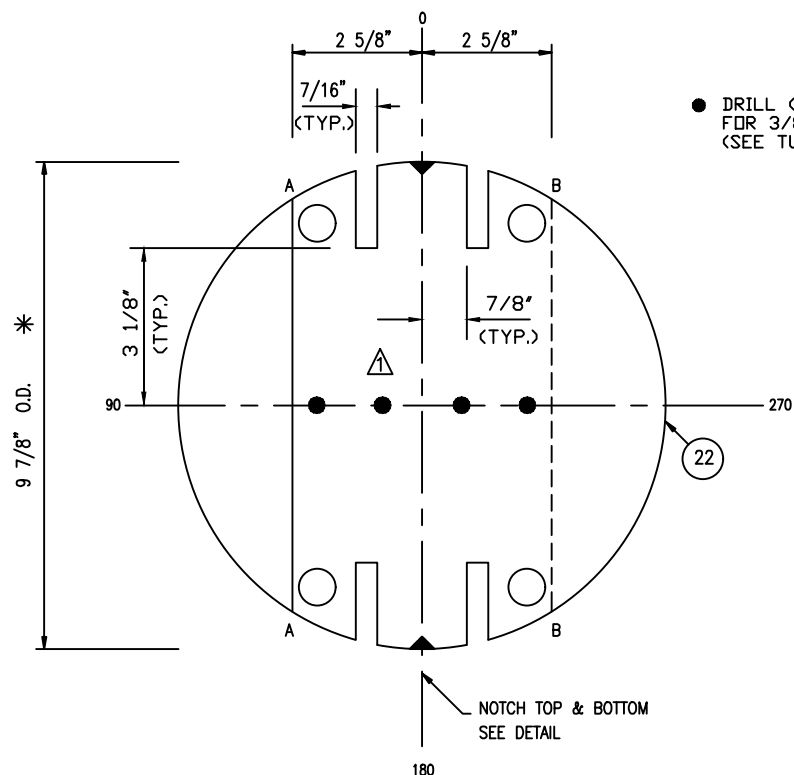

- DRILL (4) 7/16" Ø HOLES FOR 3/8" Ø SEAL RODS (SEE TUBE LAYOUT FOR LOCATION)

NOTCH TOP & BOTTOM  
SEE DETAIL

VIEW ZZ OF BAFFLES  
1/4" THK.  
15 -REQD. CUT AA  
14 -REQD. CUT BB

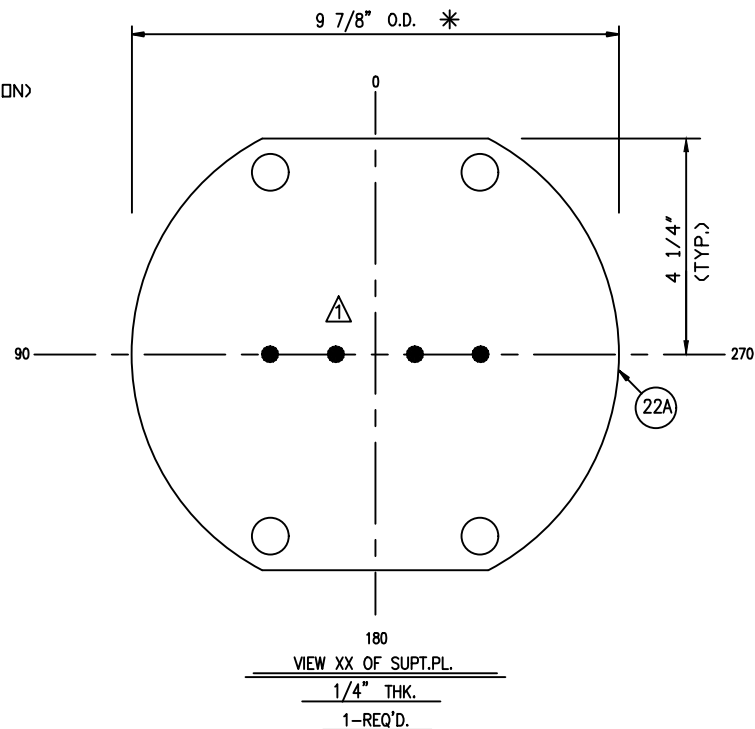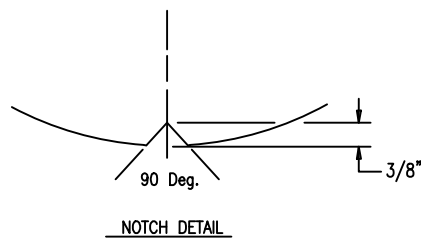

VIEW XX OF SUPT.PL.  
1/4" THK.  
1-REQ'D.


PROJECT NAME: WORLD ENERGY RENEWABLES PROJECT  
EQUIPMENT OWNER: AIR PRODUCTS MANUFACTURING LLC  
SERVICE: **PROPANE PRODUCT COOLER**  
LOCATION: WORLD ENERGY, PARAMOUNT, CA. USA  
PRODUCT: PROPANE PRODUCT COOLER  
ITEM NO.: 18-X-378  
AIR PRODUCTS P.O. NO.: 4505600057 / A8KM-4-402-PO-2  
AP PROJECT NO.: EN-20-7120  
VDR CODE NO.: BE04  
SERIAL NO.: S21-13258-14  
ENGINEER: EG  
CUSTOMER / CLIENT: WORLD ENERGY PARAMOUNT

## NOTES:

- 1) DRILL TUBE HOLES IN BAFFLES 25/32" DIA. & DEBURR.
- 2) DRILL TIE ROD HOLES 9/16" DIA.  
SEE TUBE LAYOUT FOR LOCATION.
- 3) RADIUS ALL CORNERS ON BAFFLE CUTS.
- \* 4) CHECK SHELL I.D. BEFORE MACHINING BAFFLE O.D.
- 5) MACHINE O.D. OF BAFFLES TO 250 RMS.


|    |  |  |                    |  |                                                    |           |
|----|--|--|--------------------|--|----------------------------------------------------|-----------|
|    |  |  | BAFFLE DETAILS     |  |                                                    |           |
|    |  |  | DWN. BY<br>B.W.    |  | <div>Fabsco</div> <div>SHELL &amp; TUBE, LLC</div> |           |
|    |  |  | DATE<br>6/8/22     |  |                                                    |           |
|    |  |  | CKD. BY<br>DiCarlo |  | DWG.NO.<br>S21-13258-14-8                          | REV.<br>1 |
|    |  |  |                    |  |                                                    |           |
|    |  |  |                    |  |                                                    |           |
| </ |  |  |                    |  |                                                    |           |



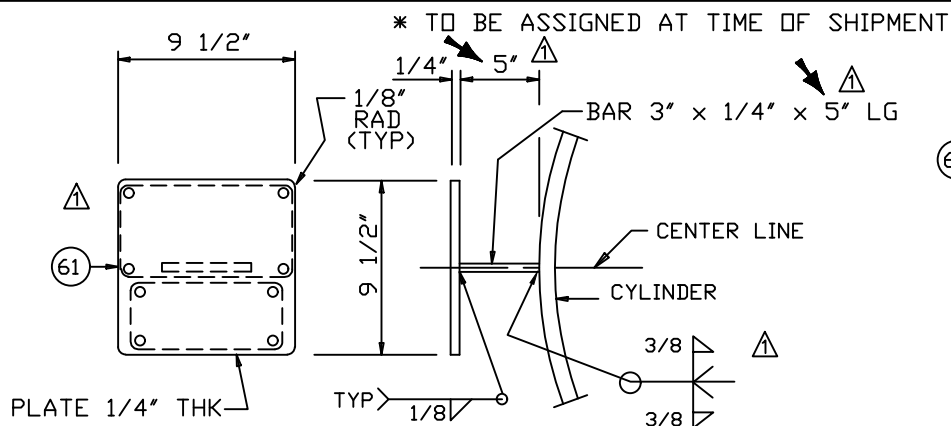

### NAME PLATE BRACKET DETAIL

(ONE) REQUIRED

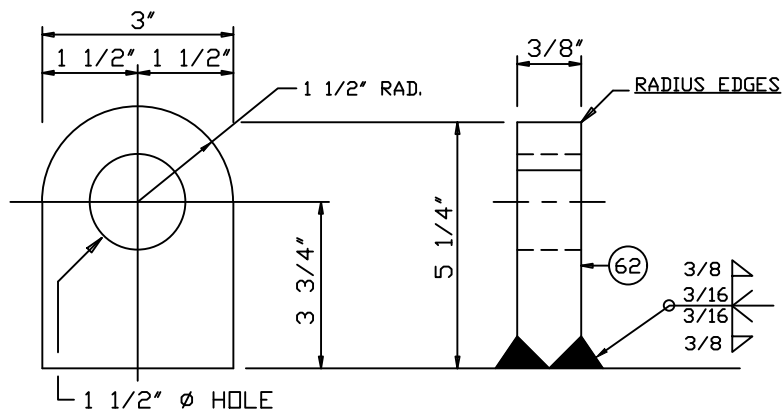

### LIFTING LUG DETAIL

3-REQUIRED

PROJECT NAME: WORLD ENERGY RENEWABLES PROJECT  
EQUIPMENT OWNER: AIR PRODUCTS MANUFACTURING LLC  
SERVICE: **PROPANE PRODUCT COOLER**  
LOCATION: WORLD ENERGY, PARAMOUNT, CA. USA  
PRODUCT: PROPANE PRODUCT COOLER  
ITEM NO.: 18-X-378  
AIR PRODUCTS P.O. NO.: 4505600057 / ABKM-4-402-PO-2  
AP PROJECT NO.: EN-20-7120  
VDR CODE NO.: HCO9  
SERIAL NO.: S21-13258-14  
ENGINEER: EG  
CUSTOMER / CLIENT: WORLD ENERGY PARAMOUNT

MATERIAL: 18-8 STN. STL.(16 GA)

ASME

U

RT-3

NAT'L BD. \*

**CERTIFIED BY**  
**FABSCO SHELL & TUBE, LLC**  
**SAPULPA, OKLAHOMA**

|       | MAWP | PSI AT | MAWT | ° F. |
|-------|------|--------|------|------|
| SHELL | 430  |        | 300  |      |
| SHELL | 15   |        | 300  |      |
| SHELL | -45  | °F. AT | 430  | PSI  |
| TUBES | 415  | PSI AT | 150  | ° F. |
| TUBES | N/A  | PSI AT | N/A  | °F.  |
| TUBES | 32   | °F. AT | 415  | PSI  |

| SERIAL NUMBER | YEAR BUILT | ITEM/TAG NUMBER |
|---------------|------------|-----------------|
| S21-13258-14  | 2023       | 18-X-378        |

P.O. NO.: 4505600057 WT.: 2050 LBS. TEST DATE:

PROPANE PRODUCT COOLER

**INFORMATION NAME PLATE**

HYDRO TEST PRESS PSIG..TUBESIDE: SHOP-576/FIELD-539

HYDRO TEST PRESS PSIG..SHELLSIDE: SHOP-721/FIELD-559


DESIGN PRESS.: SHELLSIDE=425 PSIG; TUBESIDE=330 PSIG

SECT. VIII, DIV 1, 2021 ED; API-660; TEMA "R"

|                                                                                       |         |                |                                            |                             |                                               |
|---------------------------------------------------------------------------------------|---------|----------------|--------------------------------------------|-----------------------------|-----------------------------------------------|
|                                                                                       |         |                | LIFT LUG DETAIL w/<br>NAME PLATE & BRACKET |                             |                                               |
|                                                                                       |         |                | DWN. BY<br>B.W.                            |                             | <b>Fabsco</b><br><b>SHELL &amp; TUBE, LLC</b> |
|                                                                                       |         |                | DATE<br>6/8/22                             |                             |                                               |
|  | 8/11/22 | REV. PER CUST. | B.W./DD                                    |                             |                                               |
| NO.                                                                                   | DATE    | REVISIONS      |                                            |                             |                                               |
|                                                                                       |         |                | CKD. BY<br><i>DiCarlo</i>                  | DWG. NO.<br>S21-13258-14-10 | REV.<br>1                                     |

**Fabscos**  
**SHELL & TUBE, LLC**



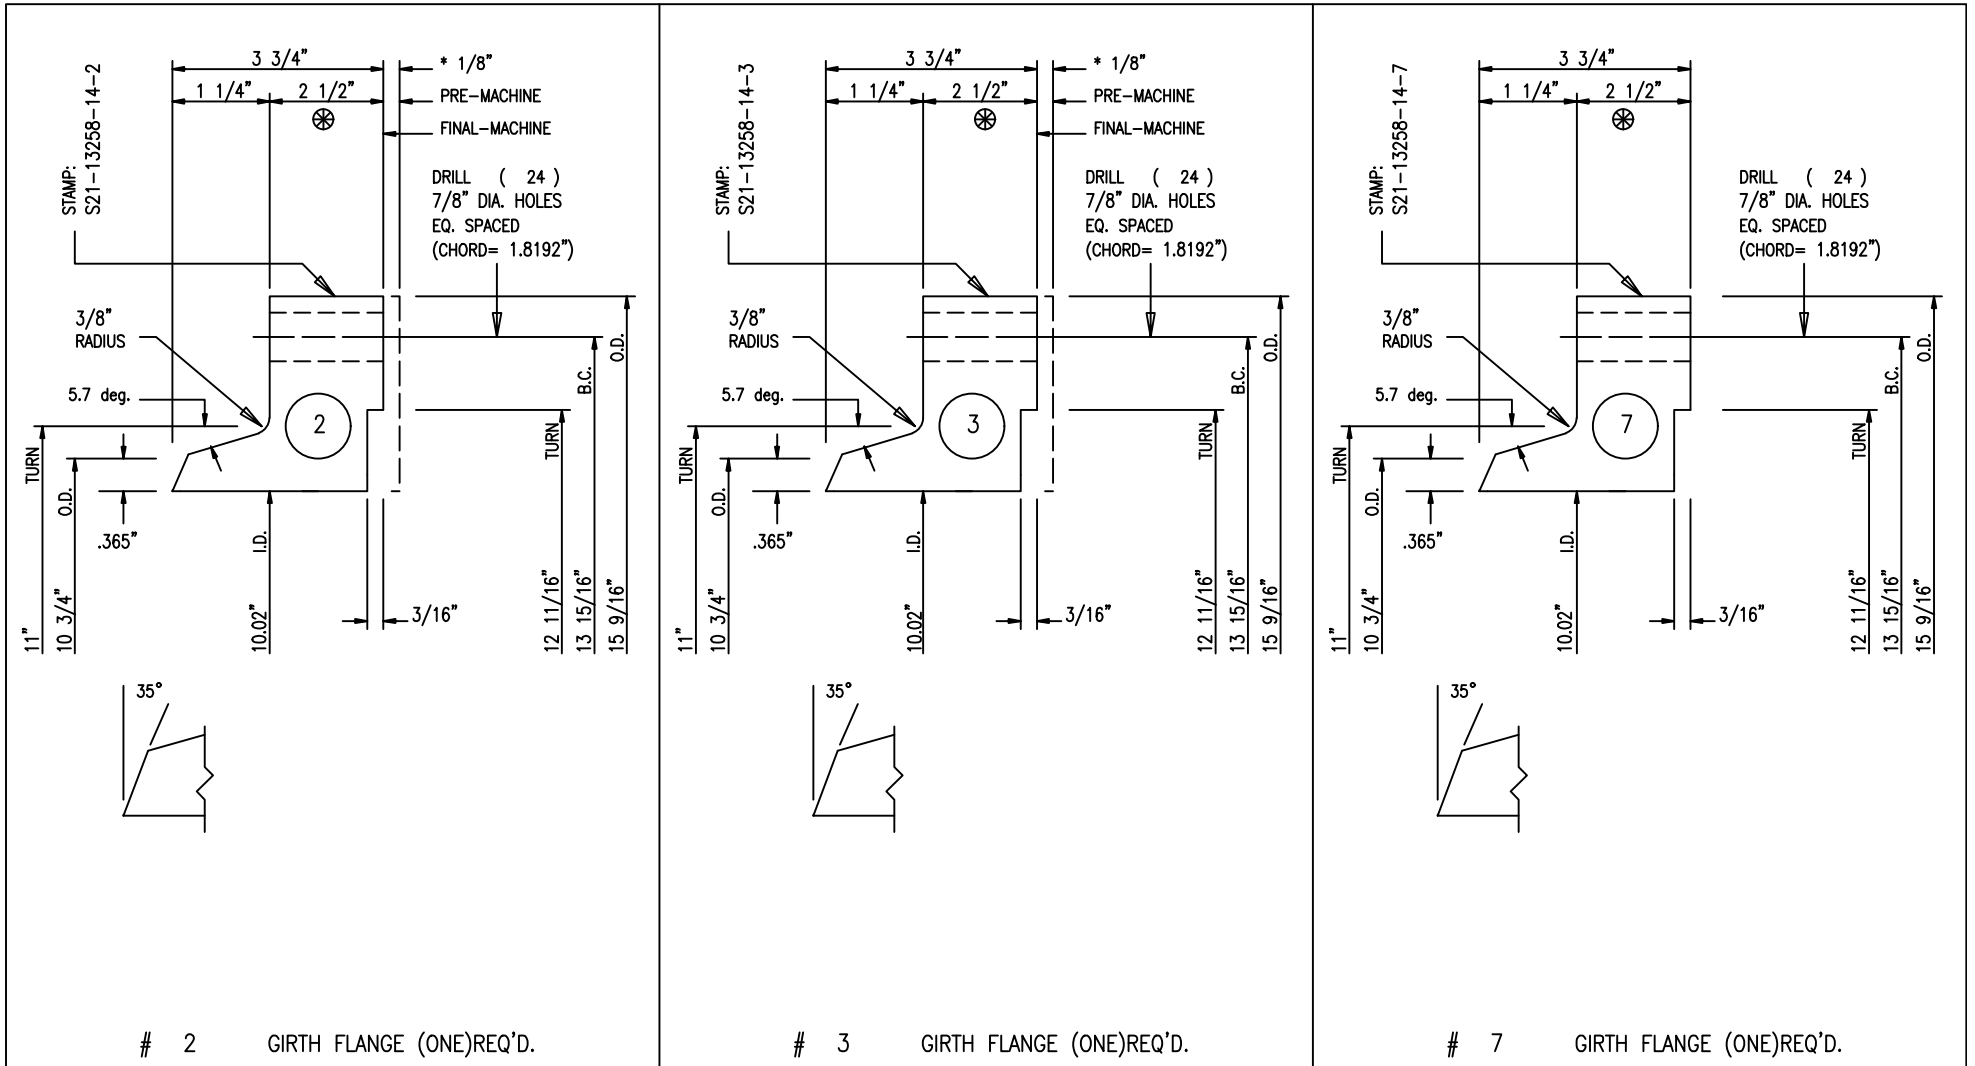

# NOTES:

- 1) MACHINE ALL SURFACES TO 250 RMS  
EXCEPT GASKET SURFACES MACHINE TO 125 RMS.
- 2) ALL BOLT HOLES TO STRADDLE NATURAL CL.
- 3) \* FINAL MACHINE FACING AFTER FINAL WELDING.

THK. INCLUDES 1/8" FUTURE  
MACHINING ALLOWANCE

PROJECT NAME: WORLD ENERGY RENEWABLES PROJECT  
EQUIPMENT OWNER: AIR PRODUCTS MANUFACTURING LLC  
SERVICE: **PROPANE PRODUCT COOLER**  
LOCATION: WORLD ENERGY, PARAMOUNT, CA. USA  
PRODUCT: PROPANE PRODUCT COOLER  
ITEM NO.: 18-X-378  
AIR PRODUCTS P.O. NO.: 4505600057 / A8KM-4-402-PO-2  
AP PROJECT NO.: EN-20-7120  
VDR CODE NO.: BE04  
SERIAL NO.: S21-13258-14  
ENGINEER: EG  
CUSTOMER / CLIENT: WORLD ENERGY PARAMOUNT

|     |      |           |
|-----|------|-----------|
| NO. | DATE | REVISIONS |
|     |      |           |
|     |      |           |
|     |      |           |
|     |      |           |
|     |      |           |

## GIRTH FLANGES

DWN. BY  
B.W.





DATE  
6/8/22

CKD. BY  
**DiCarlo**

**Fabsco**  
SHELL & TUBE, LLC

DWG.NO.  
S21-13258-14-12

REV.  
0

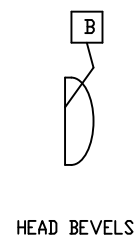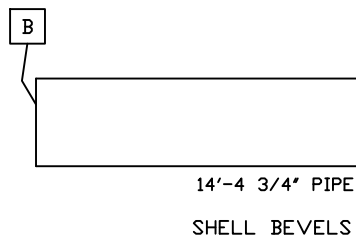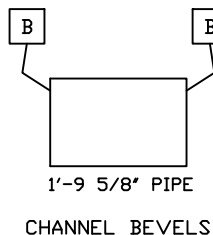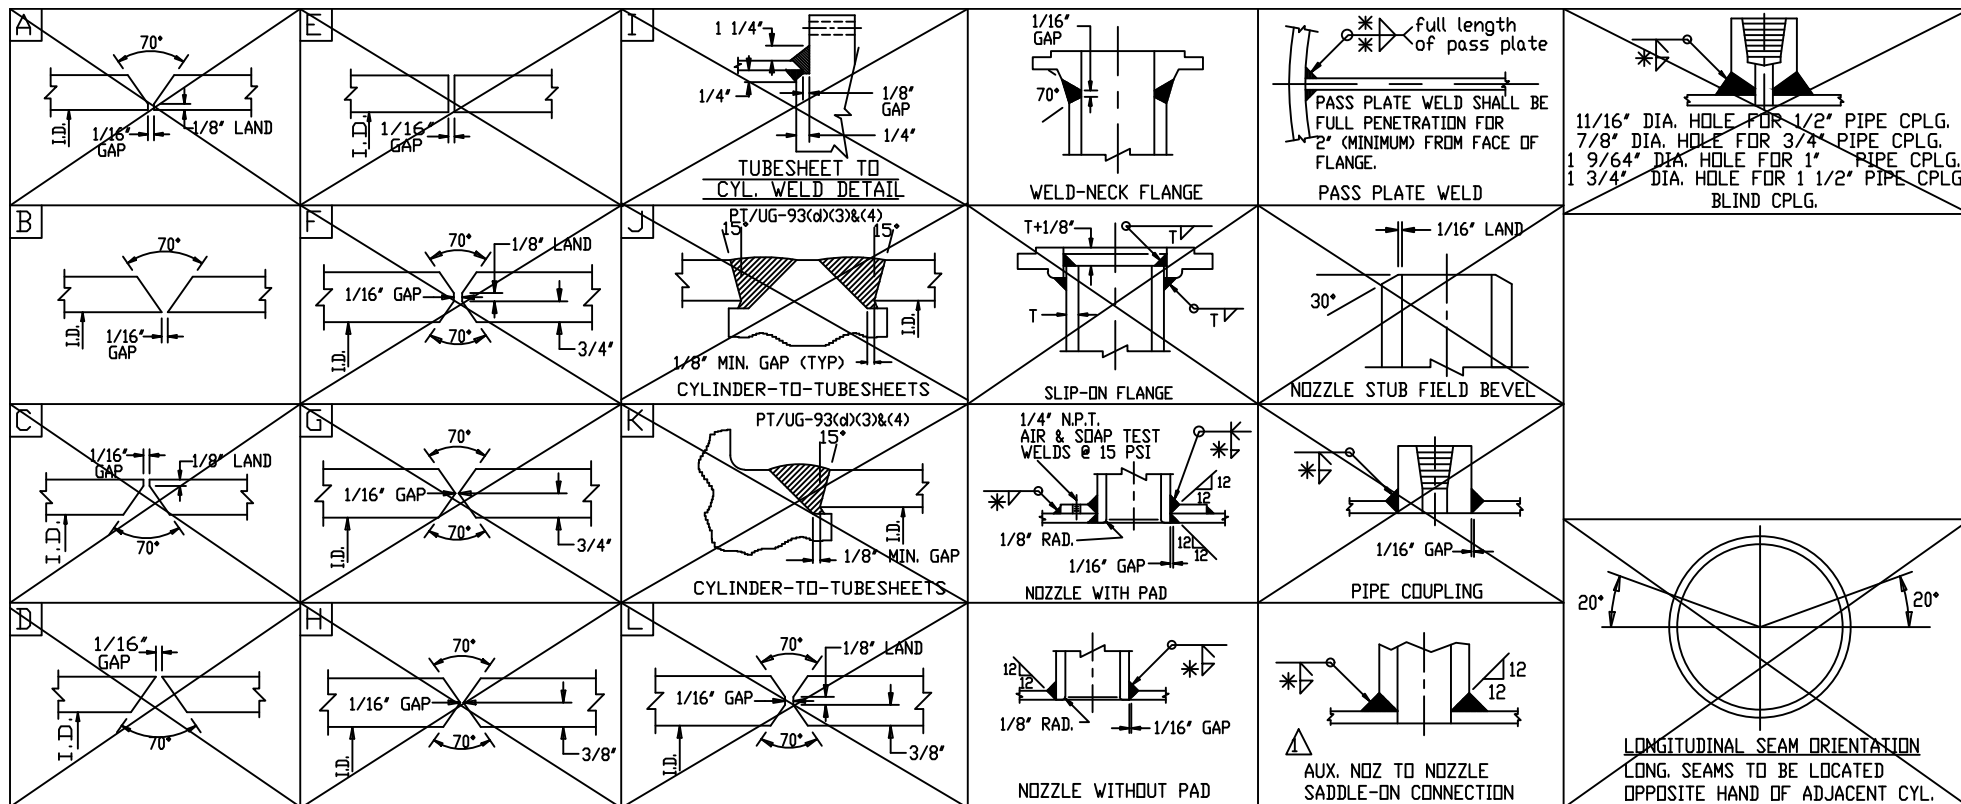

PROJECT NAME: WORLD ENERGY RENEWABLES PROJECT  
EQUIPMENT OWNER: AIR PRODUCTS MANUFACTURING LLC  
SERVICE: **PROPANE PRODUCT COOLER**  
LOCATION: WORLD ENERGY, PARAMOUNT, CA. USA  
PRODUCT: PROPANE PRODUCT COOLER  
ITEM NO.: 18-X-378  
AIR PRODUCTS P.O. NO.: 4505600057 / A8KM-4-402-PO-2  
AP PROJECT NO.: EN-20-7120  
VDR CODE NO.: BE04  
SERIAL NO.: S21-13258-14  
ENGINEER: EG  
CUSTOMER / CLIENT: WORLD ENERGY PARAMOUNT

#### GENERAL NOTES:

- ALL WELDING SHALL BE IN ACCORDANCE WITH ASME CODE (SECTION IX).
- ALL FILLET WELDS SHALL BE 3/8", UNLESS NOTED OTHERWISE ON DETAIL DRAWINGS.
- LIFTING LUGS SHALL HAVE A 3/8" CONTINUOUS FILLET WELD, UNLESS NOTED OTHERWISE.
- NOZZLE PADS SHALL BE UT OR RT 100% IF SPLIT IS WITHIN 45° OF VESSEL LONGITUDINAL AXIS.

|              |          |                         |                      |                    |                                                    |          |
|--------------|----------|-------------------------|----------------------|--------------------|----------------------------------------------------|----------|
|              |          |                         | WELD & BEVEL DETAILS |                    |                                                    |          |
|              |          |                         | DWN. BY<br>B.W.      |                    | <div>Fabsco</div> <div>SHELL &amp; TUBE, LLC</div> |          |
|              |          |                         | DATE<br>6/8/22       |                    |                                                    |          |
| <div>△</div> | 10/25/22 | REV. PER CUST. COMMENTS | DD/DG                |                    |                                                    |          |
| <div>△</div> | 8/15/22  | REV. PER CUST.          | B.W./DD              |                    |                                                    |          |
| NO.          | DATE     | REVISIONS               |                      | CKD. BY<br>DiCarlo | DWG.NO.<br>S21-13258-14-13                         | REV<br>2 |