
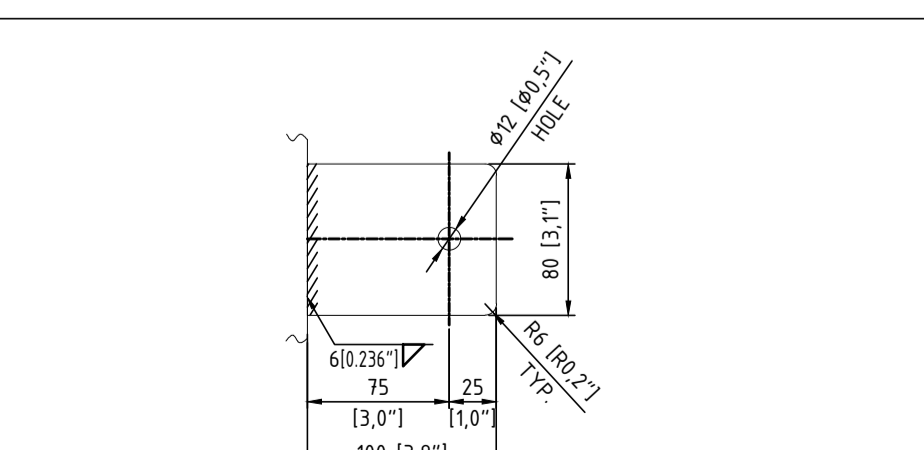
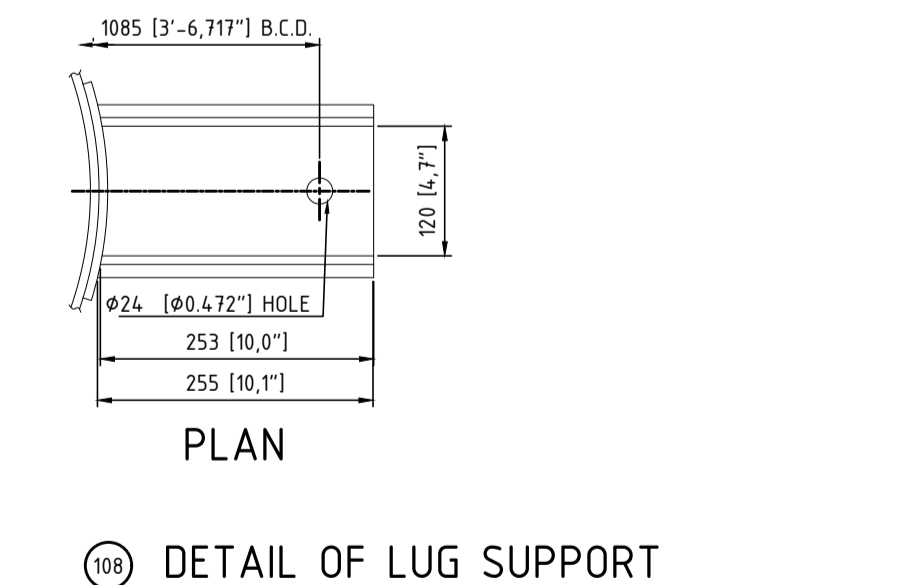
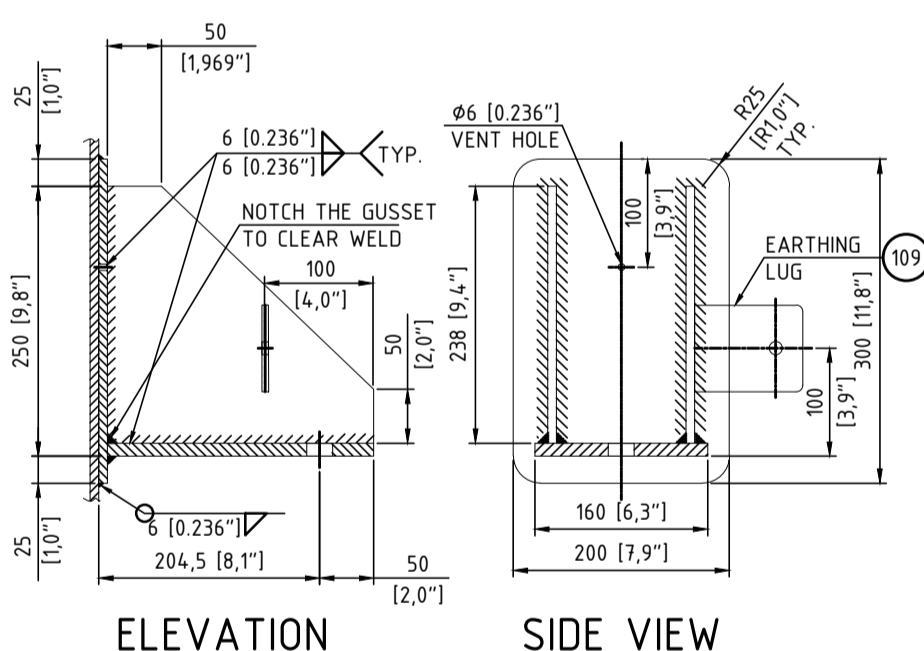
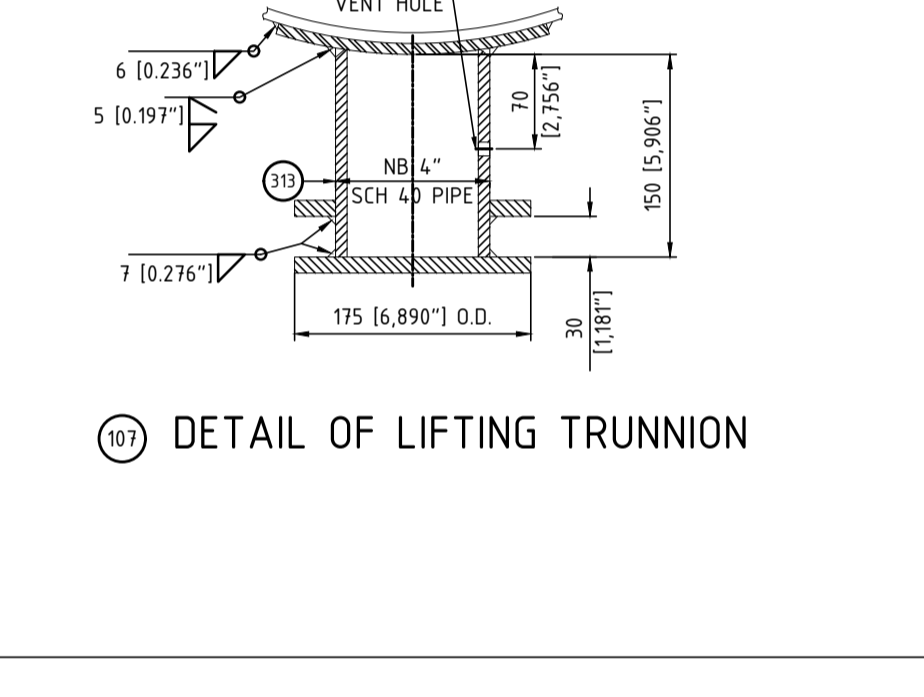
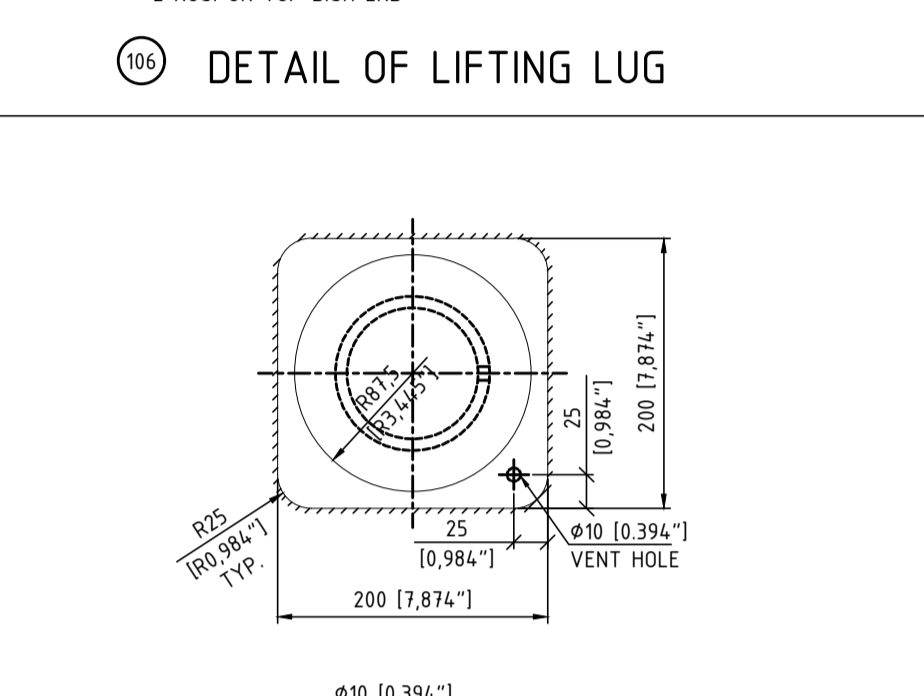
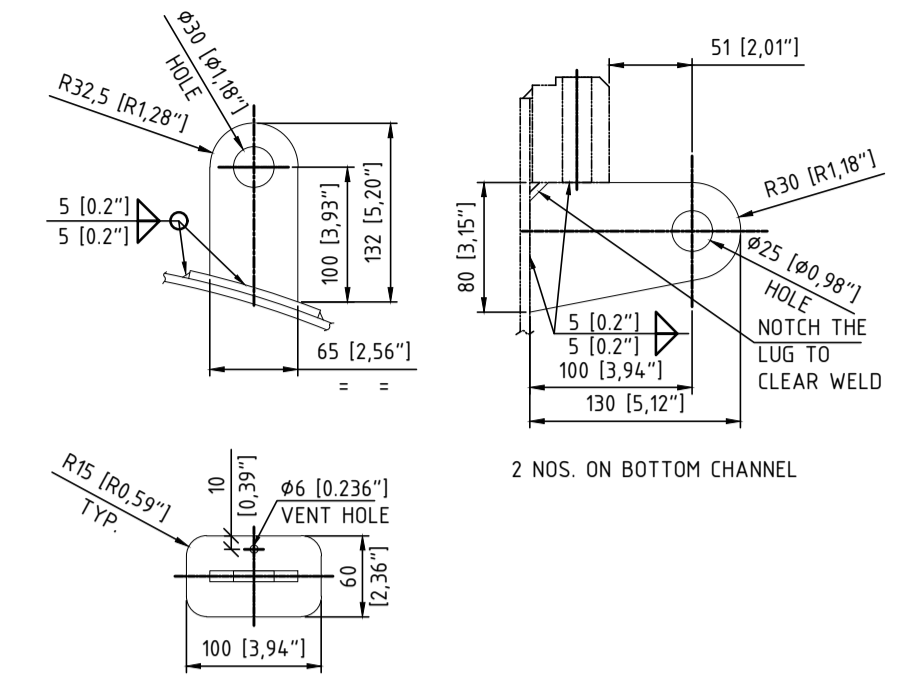
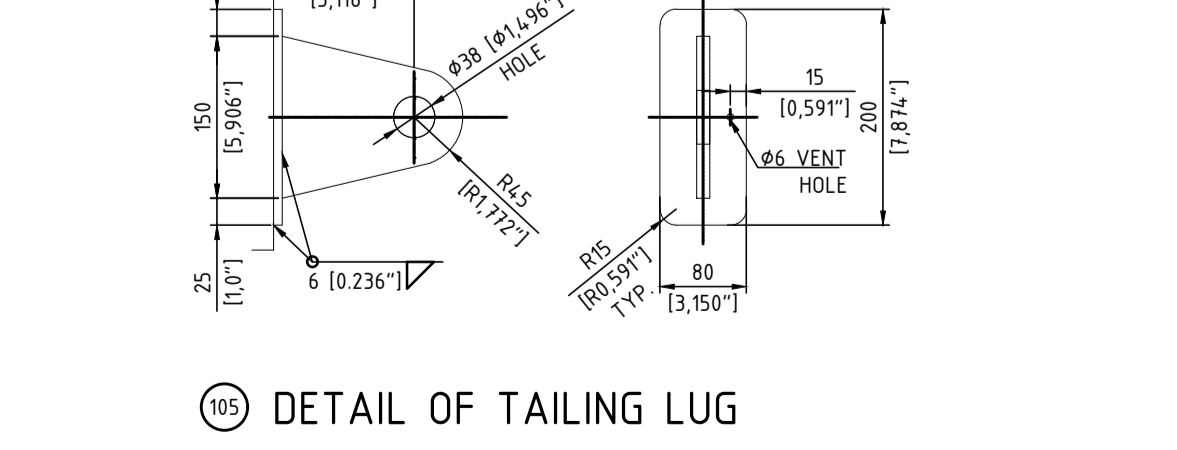
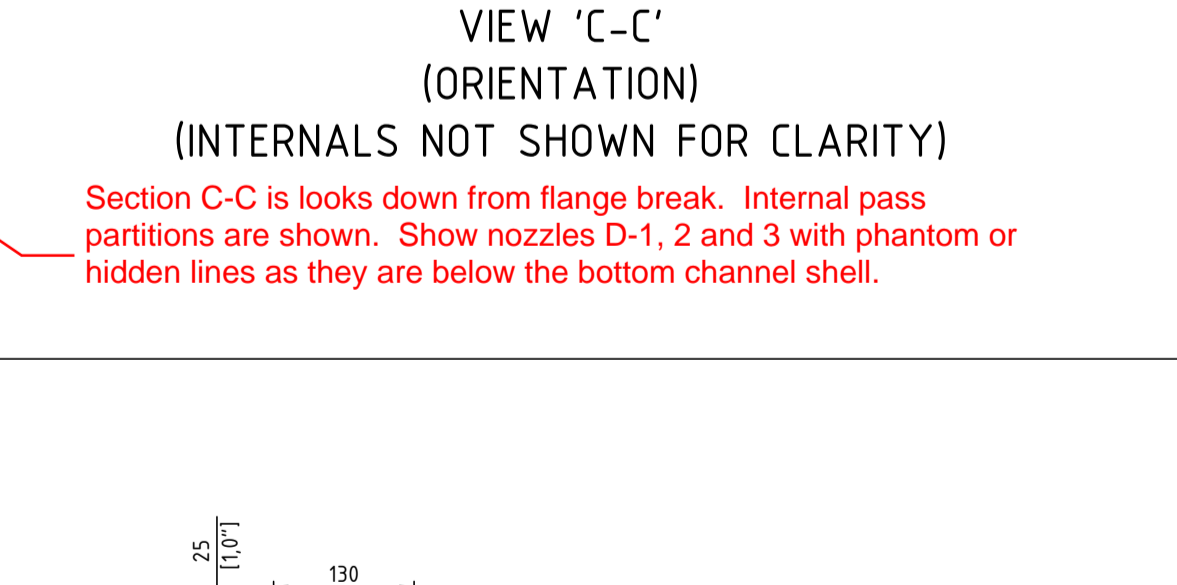
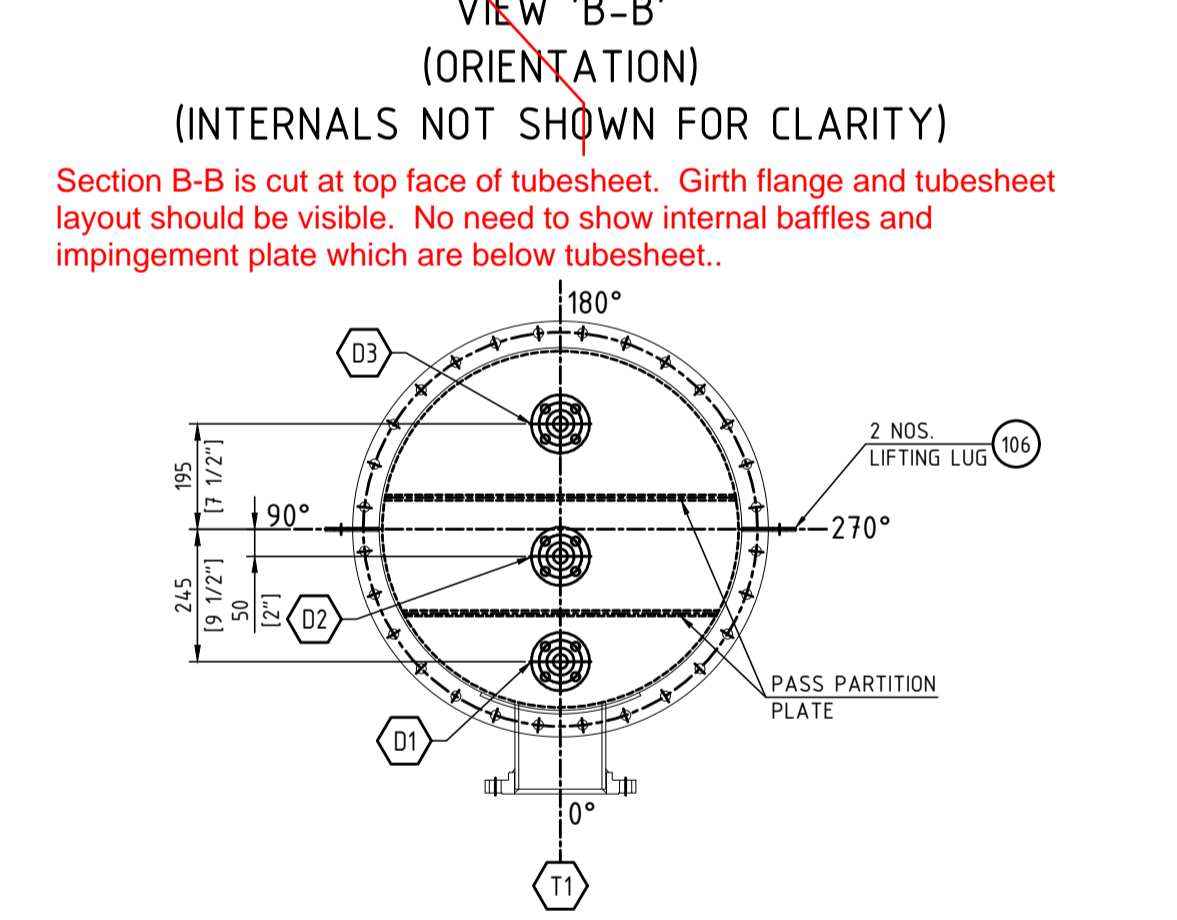
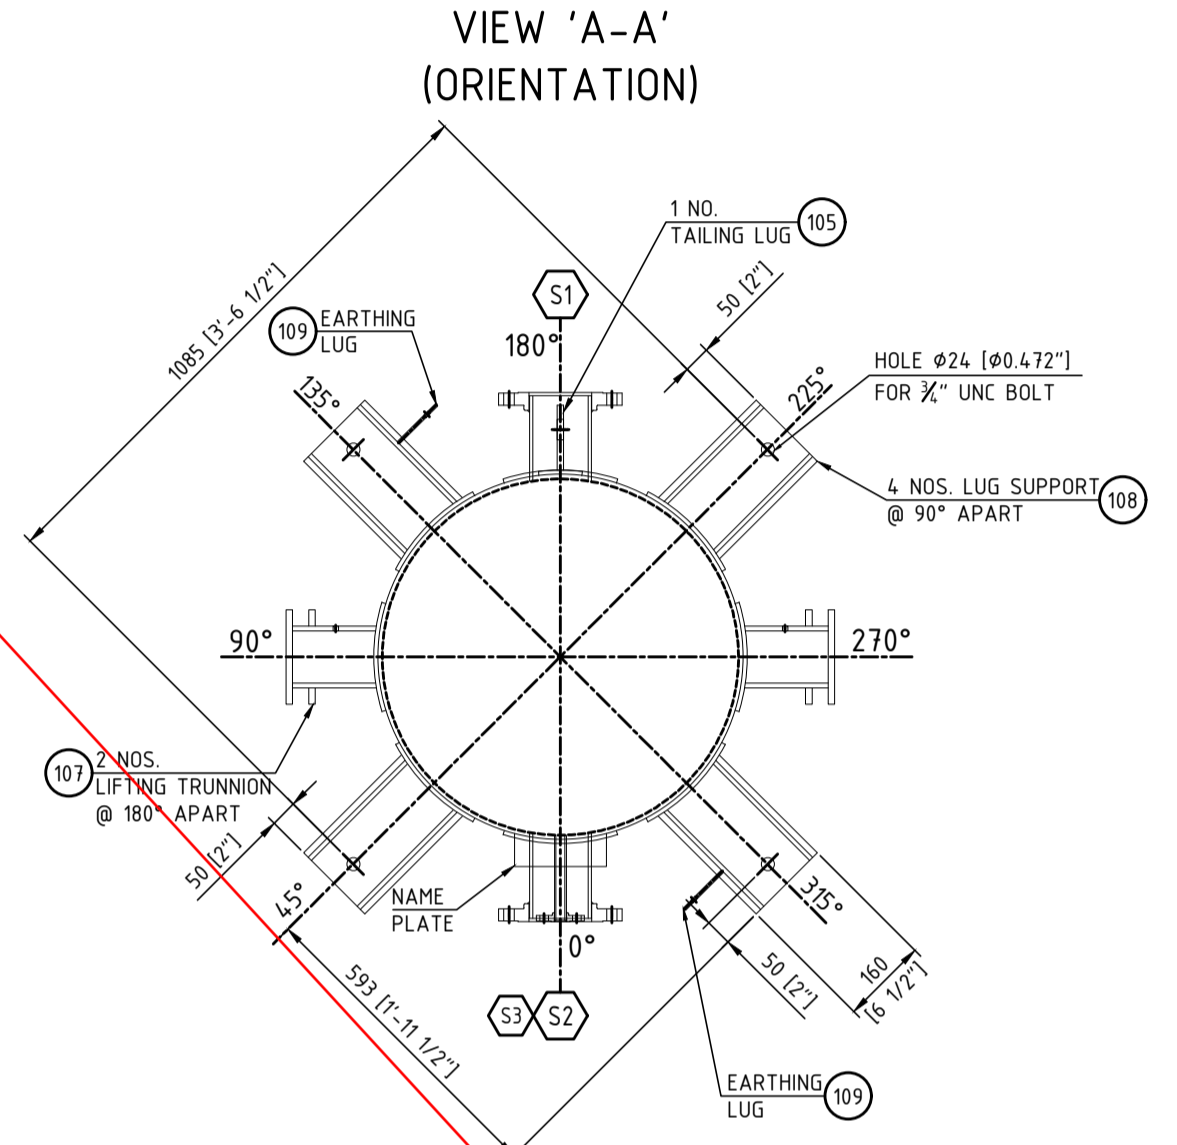
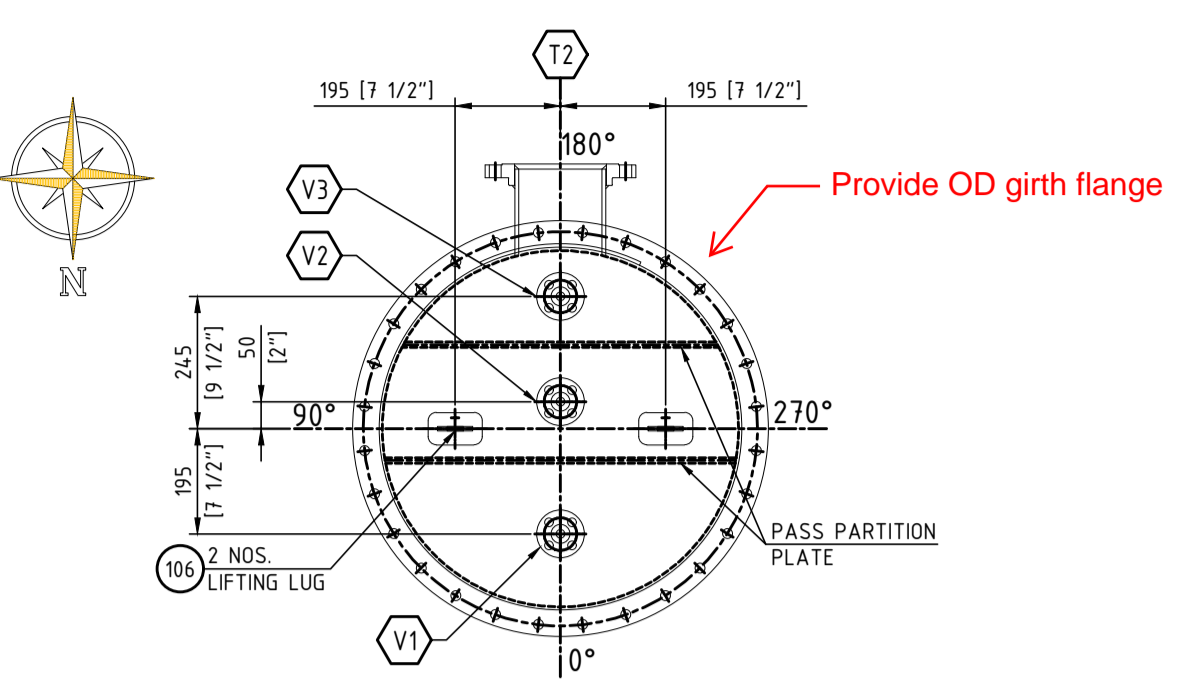


ACCORDING TO THE LAW OUR SURVEYS AND DRAWINGS ARE OUR EXCLUSIVE PROPERTY AND MAY NOT BE REPRODUCED OR COMMUNICATED TO THIRD PARTIES EVEN AFTER MODIFICATIONS WITHOUT OUR WRITTEN CONSENT.

DE CONFORMIDAD CON LA LEY, NUESTROS ESTUDIOS Y DIBUJOS SON PROPIEDAD EXCLUSIVA Y NO PUEDEN SER REPRODUCIDOS NI COMUNICADOS A TERCERAS PERSONAS SIN NUESTRA AUTORIZACION ESCRITA ANTES DE CUALQUIER MODIFICACION.

CONFORME A LA LOI NOS ETUDES ET DESINS SONT NOTRE PROPRIETE EXCLUSIVE ET NE PEUVENT ETRE REPRODUITS NI COMMUNIQUEES A DES TIERS MEME APRES DES MODIFICATIONS SANS NOTRE AUTORISATION ECRITE.

IF IN DOUBT, ASK - DO NOT SCALE!

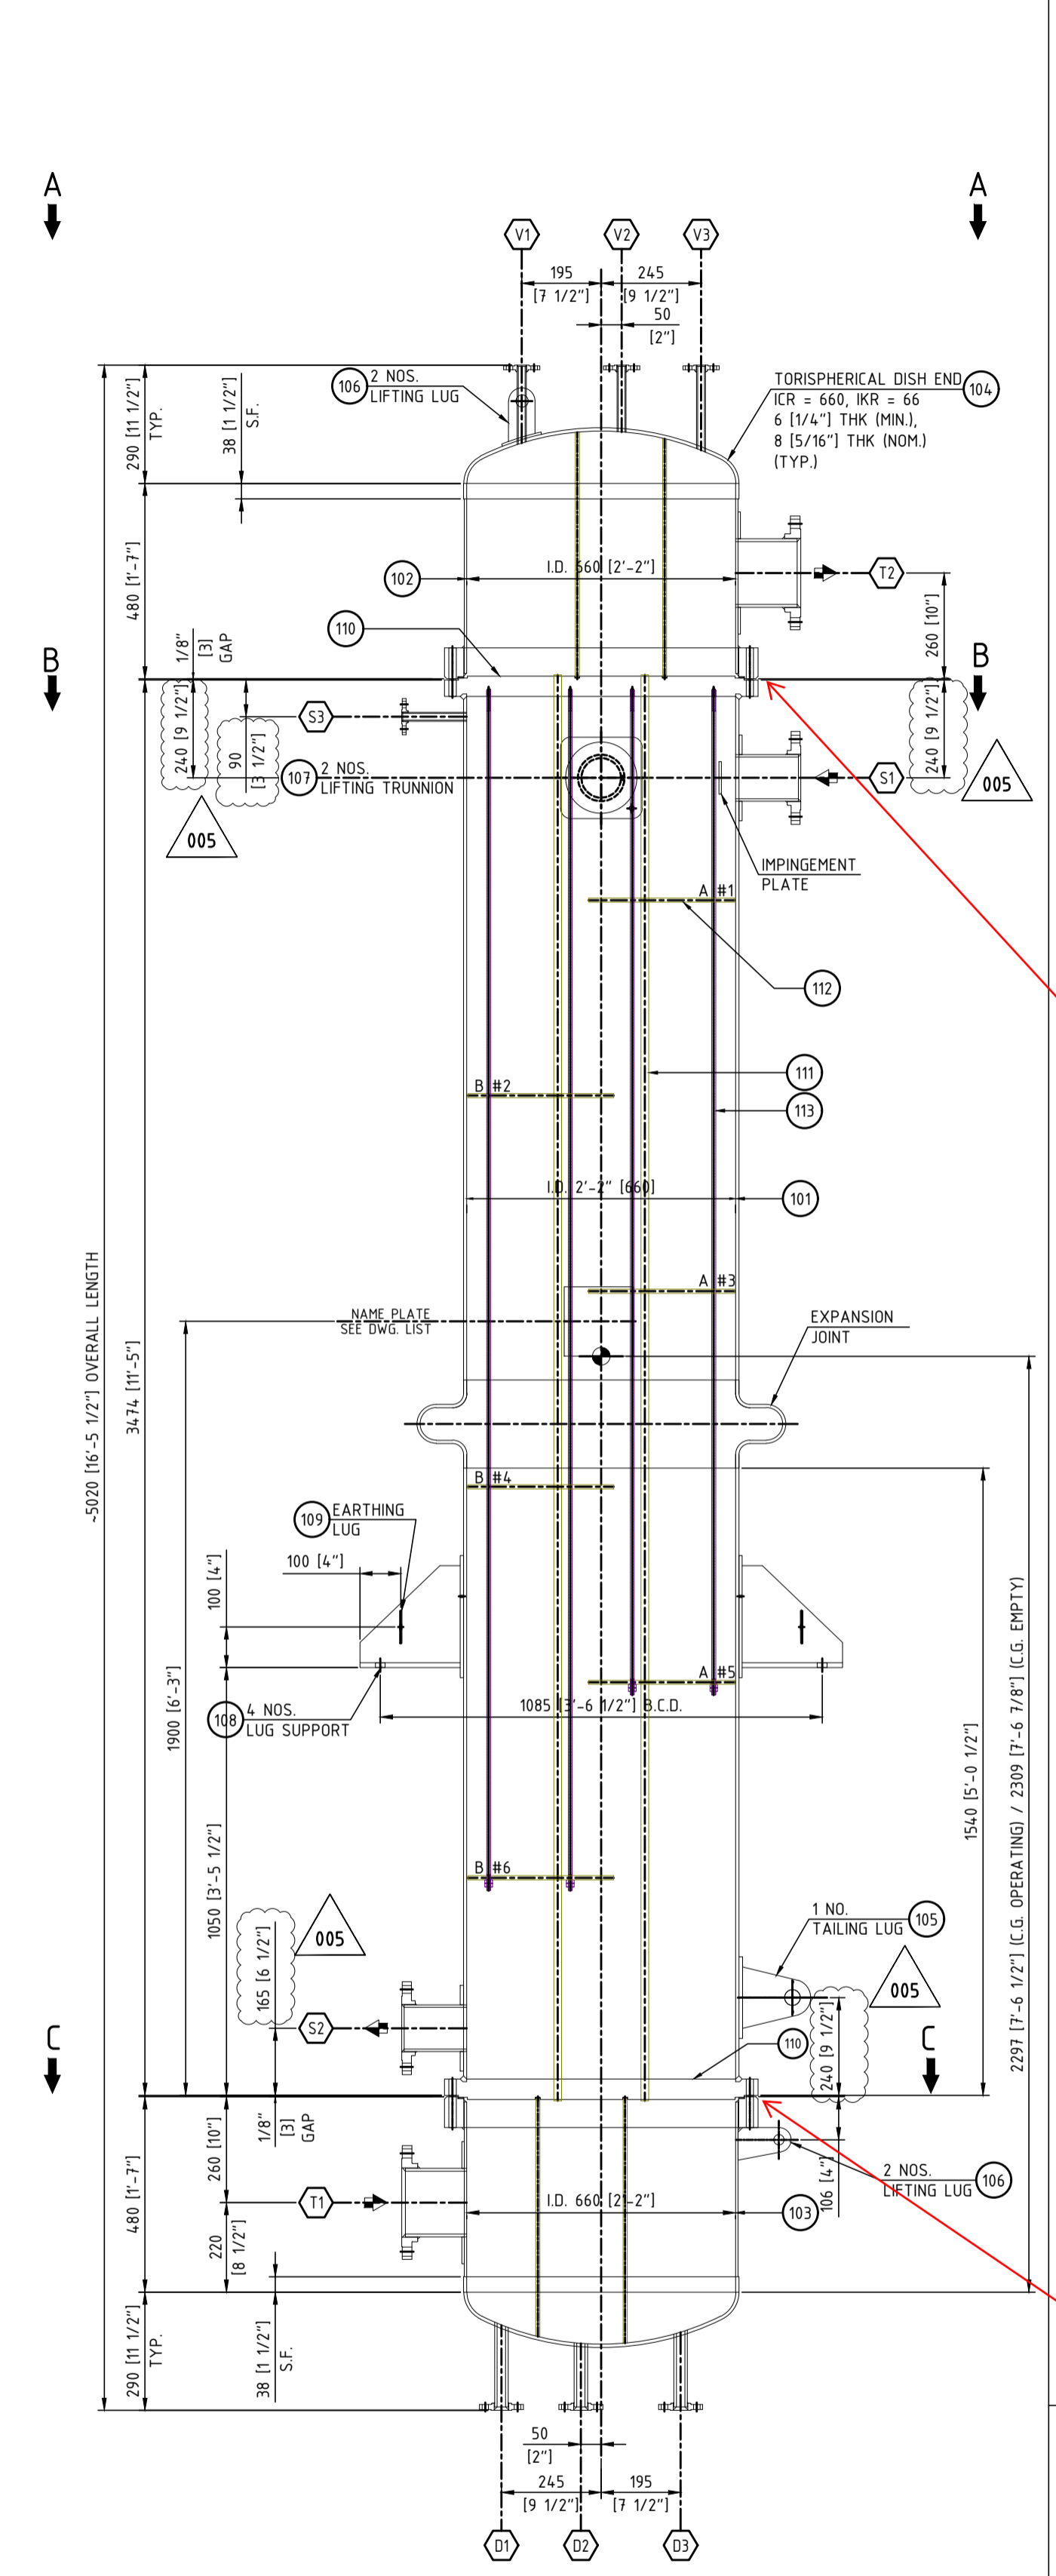

MECHANICAL DESIGN CONDITION FOR FIXED TUBESHEET EXCHANGERS

CASES	DESCRIPTION	MMT (SHELL) °C [°F]	MMT (TUBE) °C [°F]	Pshell, Bar(g) [psig]	Ptube, Bar(g) [psig]
NORMAL OPERATION	BASED ON THE PERFORMANCE ACCORD TO SPECIFIED CONDITIONS OF THIS TEMA-SHEET	175.4(34.7)	171.9(34.4)	8.0(116.03)	6(87.02)
COLD START-UP	TUBESIDE OIL INLET @ 50°C AND SHELL WITH STEAM @ 10 Bar(g)	184(363.2)	181(351.8)	8.0(116.03)	6(87.02)
INCIDENT-1	STEAM VALVE FULLY OPENED, 12 Bar(g) @ SHELL DURING NORMAL OPERATION	191(377.4)	187.8(370)	12(174.04)	6(87.02)
INCIDENT-2	STEAM OPEN TO SHELLS WITH EMPTY TUBES	175(34.7)	175(34.7)	8.0(116.03)	0(0)
INCIDENT-3	SHELL SIDE NO STEAM @ ATM, WHILE CIRCULATING OIL THROUGH TUBES	42(6.087)	48.1(118.6)	0(0)	6(87.02)

APPLICABLE STANDARDS FOR WIND & EARTHQUAKE
 WIND DESIGN - Wind Speed = 101 mph
 EARTHQUAKE DESIGN - S_{DS} = 1.077g, S_{D1} = 0.664g (ASCE 7-16)

DESCRIPTION	EDITION	TITLE
METALLIC GASKET FOR PIPE FLANGES (LATEST)	2017	ASME B16.20
STAINLESS STEEL PIPE	2018	ASME B36.19M
WELDED & SEAMLESS WROUGHT STEEL PIPE (LATEST)	2018	ASME B36.10M
FORGED FITTINGS (LATEST)	2016	ASME B16.11
BUTTWELDED FITTINGS (LATEST)	2018	ASME B16.9
NOZZLE FLANGES UP TO NPS 24 / DN 600	2013	ASME B16.5
STAINLESS STEEL TUBES	2019	ASME 789

LOADING DATA	N-m	20290
SEISMIC MOMENT	N	15700
SEISMIC SHEAR	N-m	1510
WIND MOMENT	N	2660
WIND SHEAR	N	2660

- GENERAL NOTES -
- ALL DIMENSIONS ARE IN (mm), UNLESS SPECIFIED OTHERWISE.
 - ALL BOLT HOLES SHALL STRADDLE RADIAL CENTER LINES.
 - PROJECTION OF NOZZLES ON SHELL SHALL BE FROM EQUIPMENT CL UNLESS SPECIFIED.
 - ALL FULL PENETRATION WELDS (FPW) TO BE CHIPPED BACK TO SOUND METAL ON THE SECOND SIDE AND REWELDED, OR FULL PENETRATION WELDS MAY BE ACHIEVED FROM ONE SIDE ONLY USING PROPER QUALIFIED WELDING PROCEDURE (WITH GTAW ROOT PASS)
 - ALL WELDING SURFACES TO BE THOROUGHLY CLEANED OF SCALE, RUST, OIL OR FOREIGN BODIES, BEFORE WELDING.
 - ALL SHARP CORNERS SHALL BE ROUNDED OFF TO A MINIMUM 3mm (1/8 in) RADIUS.
 - ALL REINFORCING PADS SHALL HAVE TWO NUMBER 6 mm NPT (1/4 in) VENT HOLE, PLACED IN THE LOWEST AREA OF PAD. AFTER COMPLETION OF WELDING, THE PAD SHALL BE SUBJECTED TO DRY AIR AND SOAPY WATER TEST AT 0.1 MPa(g). THESE TEST HOLE SHALL BE FILLED WITH RUST PREVENTATIVE GREASE COMPATIBLE WITH THE BASE MATERIAL PRIOR TO SHIPMENT. DO NOT PLUG THE TEST HOLE.
 - PIPES TO BE USED IN NOZZLE CONSTRUCTION SHALL BE SEAMLESS ONLY, IF FABRICATED (ABOVE NPS 10) THE LONG SEAM SHALL BE 100% RADIOGRAPHED.
 - PRESSURE RELIEF DEVICES SHALL BE PROVIDED BY THE USER & SHALL BE THEIR RESPONSIBILITY.
 - EQUIPMENT TOLERANCES SHALL BE STRINGENT OF CODE(ITEM) AND SPECIFICATION TOLERANCES ON FILLET LEG LENGTH SHALL BE ± 0.25 UNLESS SPECIFIED OTHERWISE TOLERANCE ON ROOT HEIGHT FOR WELD PREPARATION SHALL BE ± 0.25
 - ALL INTERNAL WELD OF SHELL SIDE SHALL BE GROUND FLUSH TO FACILITATE BUNDLE INSERTION. ALL EXTERNAL WELDS SHALL BE KEPT IN AS-WELDED CONDITION.
 - WATER USED FOR HYDROTEST SHALL HAVE CHLORIDE CONTENT LESS THAN 25 ppm.
 - WELDING TO BE DONE AS PER APPROVED WELDING PROCEDURE AND WELD TEST PLAN.
 - PT SHALL BE CARRIED OUT AFTER CHIP BACK IN CASE OF ACCESSIBLE WELD & AFTER ROOT PASS IN CASE OF INACCESSIBLE WELD FOR CATEGORY A, B, C & D JOINT. PT SHALL ALSO BE CARRIED OUT ON ALL ATTACHMENT WELD WITH MAIN SHELL.
 - MACHINED SURFACES, FLANGE FACES, THREADED SURFACES, AND OTHER FINISHED OR DELICATE PARTS SHALL BE WELL-GREASED AND PROTECTED AGAINST RUSTING AND DAMAGE DURING SHIPMENT.
 - IN ADDITION TO THE NDE REQUIREMENT PER CODE & SPECIFICATION, ATTACHMENT WELD FOR LIFTING LUG, TAILING LUG SHALL BE PT/MT EXAMINED.
 - ALL NOZZLE FLANGES UP TO AND INCLUDING 24" NB SHALL BE AS PER ASME B16.5.
 - ALL PRESSURE RETAINING NUTS SHALL BE OF HEAVY SERIES ONLY.
 - GASKET SEATING SURFACE OF GIRTH FLANGE & NOZZLE FLANGE SHALL HAVE SERRATED FINISH OF 3.2-6.3 μ m.
 - ANY OFFSET WITHIN THE ALLOWABLE TOLERANCE PROVIDED IN CODE SHALL BE TAPERED AT A THREE TO ONE TAPER.
 - PAINTING: SHELL SIDE INTERNAL : SURFACE PROTECTION AS PER TN0001 SHELL SIDE EXTERNAL : SURFACE PROTECTION AS PER TN0001 TUBE SIDE INTERNAL : NONE TUBE SIDE EXTERNAL : NONE TUBE-TUBESHEET JOINT : NONE

Specify tube-tubesheet joint as rolled, rolled with grooves, rolled with seal weld or strength welded. It is understood that no painting or prep of tube-tubesheet joint is required.

Provide material thicknesses or reference document where information is available.

DESIGN PARAMETERS

DESCRIPTION	UNIT	SHELL SIDE	TUBE SIDE
FLUID NAME	-	STEAM	PRODUCT 1 + BE
CAPACITY	m ³ (ft ³)	0.534 (22.391)	0.723 (25.532)
SPECIFIC GRAVITY	-	0.0045 / 0.8842	0.8842 / 0.8713
DESIGN PRESSURE (INT. / EXT.)	Bar(g) [psig]	12.0 / F.V. (174.04 / F.V.)	12.0 / F.V. (174.04 / F.V.)
MAMP (INTERNAL) / MAMP (EXTERNAL)	Bar(g) [psig]	12.0 / F.V. (174.04 / F.V.)	12.0 / F.V. (174.04 / F.V.)
HYDROSTATIC TEST PRESSURE (AT TOP) (POSITION)	Bar(g) [psig]	16.921 (245.42) (UG69910)	16.921 (245.42) (UG69910)
MAX. DESIGN TEMPERATURE (INT. / EXT.)	°C [°F]	220 / 220 (428 / 428)	220 / 220 (428 / 428)
MIN. DESIGN METAL TEMPERATURE	°C [°F]	-10 [14] AT 12 Bar g	-10 [14] AT 12 Bar g
TEST TEMPERATURE (MIN. / MAX.)	°C [°F]	0 / 48 (32 / 120)	0 / 48 (32 / 120)
CORROSION ALLOWANCE (INT. / EXT.)	mm(in)	0 / 0	0 / 0
RADIOGRAPHY / JOINT EFFICIENCY	-	NONE / 0.7	NONE / 0.7 (SEAMLESS HEAD)
PFHT	-	EXEMPTED AS PER UHA-44	EXEMPTED AS PER UHA-44
PWMT	-	EXEMPTED AS PER UHA-32	EXEMPTED AS PER UHA-32
IMPACT TEST	-	EXEMPTED AS PER UHA-51	EXEMPTED AS PER UHA-51
NO. OF PASSES	-	ONE	ONE
PAINTING	-	NA	NOTE-21
INSULATION THICKNESS / TYPE	mm(in) / -	NONE (4.0) / MINERAL WOOL	100 (4.0) / MINERAL WOOL
FIREPROOFING (BY CLIENT)	-	NONE	NONE
APPLICABLE UG-22 LOADING DATA	-	(a), (b), (c), (d), (f), (h), (j)	(a), (b), (c), (d), (f), (h), (j)
STEAM TRANSFER AREA PER SHELL	m ² (ft ²)	113.9 (GROSS), 111.1 (EFF.) [1226 (GROSS), 1196.4 (EFF.)]	113.9 (GROSS), 111.1 (EFF.) [1226 (GROSS), 1196.4 (EFF.)]
EMPTY WEIGHT [W]	kg (lb)	-2790 (6150)	-2790 (6150)
TEST WEIGHT [W]	kg (lb)	-4180 (9215)	-4180 (9215)
OPERATING WEIGHT [W]	kg (lb)	-4030 (8885)	-4030 (8885)
MANUFACTURER SERIAL NUMBER	-	ONE	ONE
INSPECTOR BY	-	ASME INSPECTOR	ASME INSPECTOR

DESCRIPTION	UNIT	SHELL SIDE	TUBE SIDE
OPERATING PRESSURE	Bar(g) [psig]	8.0 / 1.985 (116.03 / 115.8)	6.0 / 5.65 (87.02 / 81.94)
OPERATING TEMPERATURE (IN / OUT)	°C [°F]	175.5 / 175.4 (347.9 / 347.7)	50.0 / 80.0 (112 / 176)

DESCRIPTION	SHELL SIDE	TUBE SIDE
CYCLIC / LETHAL / HYDROGEN SERVICE	NO / NO / NO	NO / NO / NO
SOUR SERVICE / NACE REQUIREMENTS	NO / NO	NO / NO
EXPLOSIVE / FLAMMABLE SERVICE	NO / NO	NO / NO

MARK	PIPE SIZE	FLANGE	R.F. PAD	PROJECTION	SERVICE
S1	NB 4"	SCH 40S CL 150 SO RF	3.2-6.3 200 [8.14"] [5/16"]	4.90 [1.97"]	STEAM INLET
S2	NB 4"	SCH 40S CL 150 SO RF	3.2-6.3 200 [8.14"] [5/16"]	4.90 [1.97"]	CONDENSATE OUTLET
T1	NB 6"	SCH 40S CL 150 SO RF	3.2-6.3 300 [11.81"] [1/2"]	4.90 [1.97"]	PRODUCT 1 + BE INLET
T2	NB 6"	SCH 40S CL 150 SO RF	3.2-6.3 300 [11.81"] [1/2"]	4.90 [1.97"]	PRODUCT 1 + BE OUTLET
V1 TO V3	NB 1/2"	SCH 40S CL 150 SO RF	3.2-6.3 -	-	SEE DRG. TUBE SIDE VENT
D1 TO D3	NB 1"	SCH 40S CL 150 SO RF	3.2-6.3 -	-	SEE DRG. TUBE SIDE DRAIN
S3	NB 1/2"	SCH 40S CL 150 SO RF	3.2-6.3 -	-	4.90 [1.97"] SHELL SIDE VENT

MARK	RADIAL FORCE (FA) (N [lbf])	CIRC. FORCE (FC) (N [lbf])	LONG. FORCE (FL) (N [lbf])	CIRC. MOMENT (ML) (N-m [ft-lbf])	LONG. MOMENT (ML) (N-m [ft-lbf])	TORSIONAL MOMENT (MT) (N-m [ft-lbf])
S1	2840 (638)	2130 (479)	2840 (638)	680 (502)	1020 (752)	1280 (944)
S2	2840 (638)	2130 (479)	2840 (638)	680 (502)	1020 (752)	1280 (944)
T1	3820 (859)	2860 (643)	3820 (859)	1160 (856)	1740 (1283)	2180 (1608)
T2	3820 (859)	2860 (643)	3820 (859)	1160 (856)	1740 (1283)	2180 (1608)

TOP AND BOTTOM HEAD GASKET TYPE/MATERIAL : GARLOCK 3510 (m = 2 & y = 17.2 MPa (24.94, 64.9 psig))
 DIMENSION OF TOP AND BOTTOM HEAD GASKET : 701 O.D. x 675 I.D. x 3 THK.

POS.	NOZZLE NECKS	NOZZLE FLANGES
S1	SA-312 GR TP304	SA-182 GR F304
S2	SA-312 GR TP304	SA-182 GR F304
T1	SA-190 UNS NO. S32205	SA-182 GR F51 / SA-182 GR F60 (UNS NO. S32205)
T2	SA-190 UNS NO. S32205	SA-182 GR F51 / SA-182 GR F60 (UNS NO. S32205)
V1 TO V3	SA-190 UNS NO. S32205	SA-182 GR F51 / SA-182 GR F60 (UNS NO. S32205)
D1 TO D3	SA-190 UNS NO. S32205	SA-182 GR F51 / SA-182 GR F60 (UNS NO. S32205)
S3	SA-312 GR TP304	SA-182 GR F304

NO.	PART	QTY	SIZE	MATERIAL	REMARK
113	TIE ROD	7		SS304	
112	BAFFLE PLATE	6		SA-240 TYPE 304	
111	TUBES	544		SA-182 (UNS NO. S32205)	
110	TUBE SHEET	2		SA-240 (UNS NO. S32205)	
109	EARTHING LUG	2		SS304	
108	LUG SUPPORT	4		SA-240 TYPE 304 / SA-285 GR C / SA-240 TYPE 304 / SA-285 GR C / SA-106	
107	LIFTING TRUNNION	2		SA-240 (UNS NO. S32205) / SA-285 GR C /	
106	LIFTING LUG	4		SA-240 (UNS NO. S32205) / SA-285 GR C /	
105	TAILING LUG	1		SA-240 TYPE 304 / SA-285 GR C /	
104	CHANNEL DISH	2		SA-240	
103	BOTTOM CHANNEL SHELL	1		SA-240 (UNS NO. S32205)	
102	TOP CHANNEL SHELL	1		SA-240	
101	MAIN SHELL	1		SA-240 TYPE 304	

ITEM/SECTION NUMBER	DESCRIPTION OF MODIFICATION	DATE (dd-mm-yyyy)	BY
005	08.11.2021 UPDATED NOZZLES FOR POS.S1,S2 & S3 LIFTING TRUNNION AND TAILING LUG ELEVATION HEIGHT (MARKED 005)		PKV
004	09.09.2021 HOLD REMOVED FOR SUPPORT LUG ELEVATION HEIGHT AND ADDED EXPANSION BELLOW (MARKED 004)		PKV
003	20.07.2021 DRAWING UPDATED AS PER PROCESS COMMENTS (MARKED 003)		PKV
002	05.07.2021 UPDATED ORIENTATION AND HOLD REMOVED FOR ORIENTATION AND DRAWING UPDATED AS PER COMMENTS (MARKED 002)		PKV
001	04.05.2021 DRAWING UPDATED IMPERIAL UNITS TO METRIC AS PER PROCESS COMMENTS (MARKED 001)		PKV

DESIGNER	CHECKED	PROJ. MGR.	SCALE	DATE
desmet ballestra			A1	09.02.2021

ITEM/SECTION DESCRIPTION	PROJECT	VESEL (ASSY)
W521B.1 (19-X-751)	ORP	ORP

ITEM/SECTION DESCRIPTION	DOCUMENT NUMBER	REVISION
Sh=113.9 D=660 L tub=3500 GENERAL ARRANGEMENT	1001764.03	005