
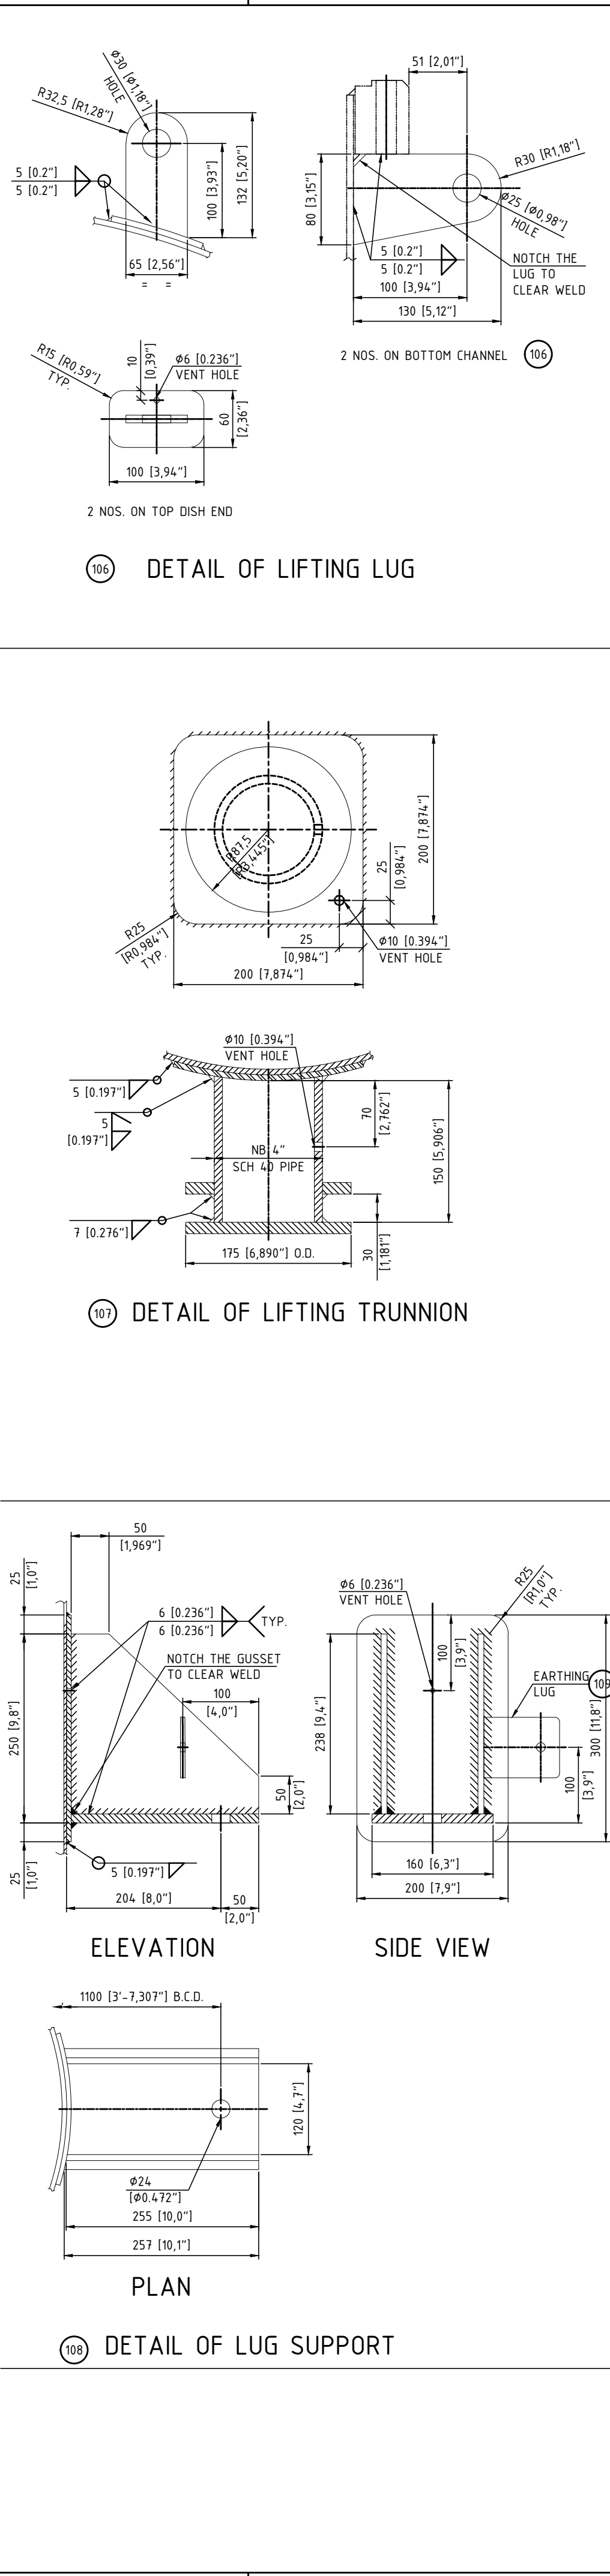
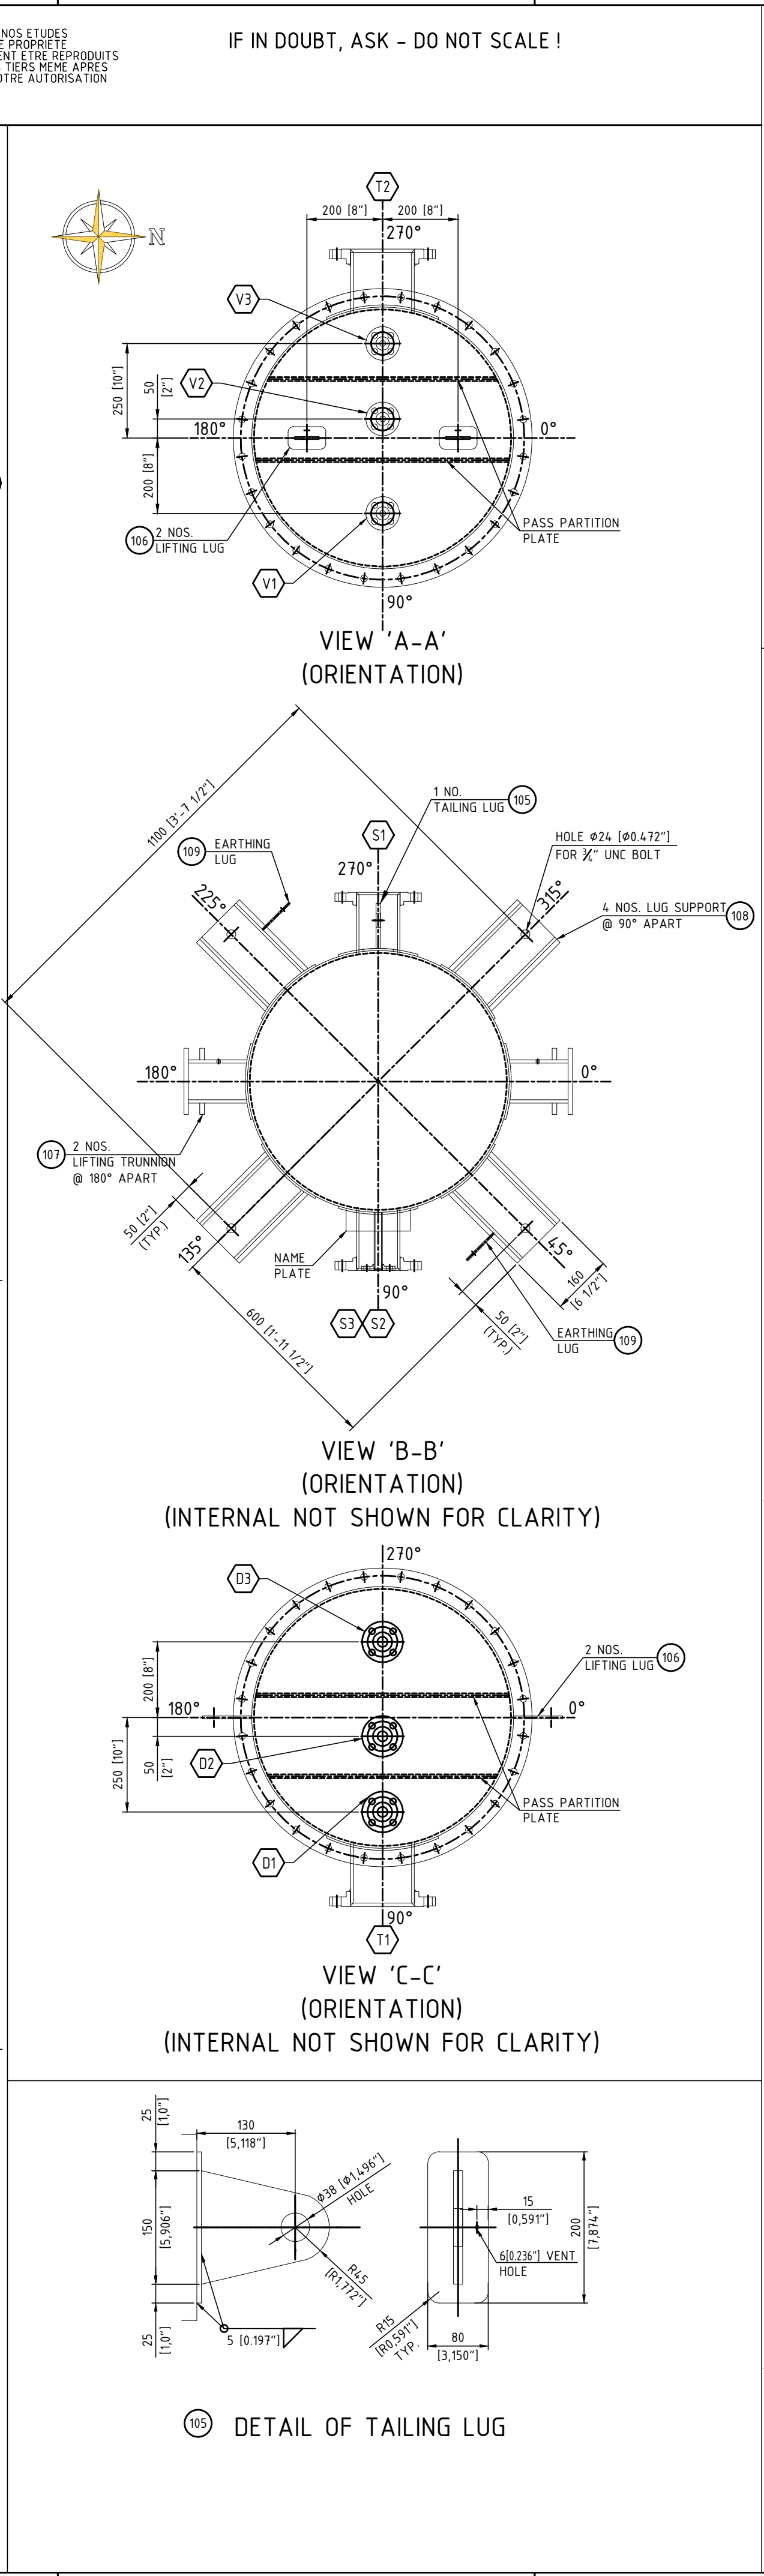


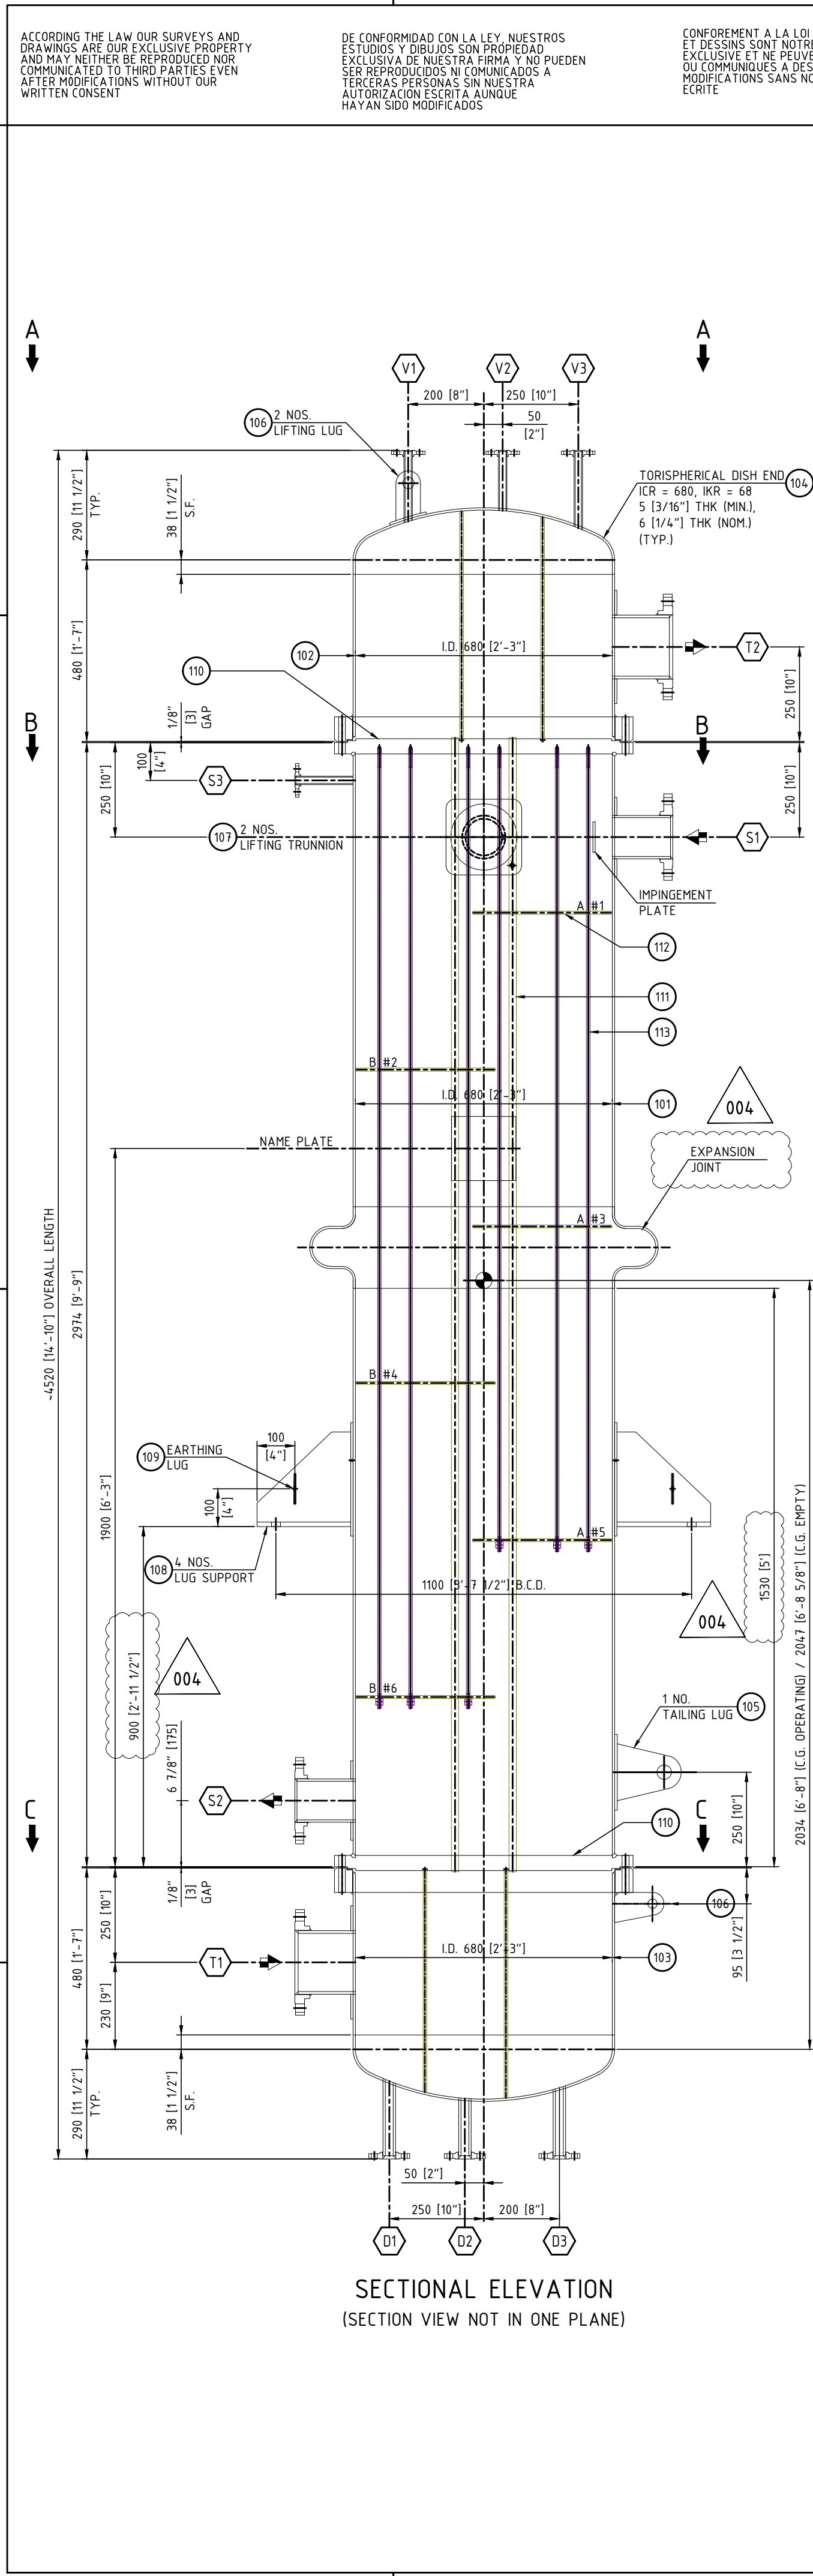

MECHANICAL DESIGN CONDITION FOR FIXED TUBESHEET EXCHANGERS				
CASES	DESCRIPTION	MMT (SHELL) °C (°F)	MMT (TUBE) °C (°F)	Pshell, Bar(g) (psi(g))
NORMAL OPERATION	BASE ON THE PERFORMANCE ACCORD. TO SPECIFIED CONDITIONS OF THIS TEMA-SHEET	175(343.7)	172(342.7)	80(116.03)
COLD START-UP	TUBESIDE OIL INLET @ 80°C AND SHELL WITH STEAM @ 10 Bar(g)	184(363.2)	181(357.8)	10(14.503)
INCIDENT-1	STEAM VALVE FULLY OPENED, 12 Bar(g) @ SHELL DURING NORMAL OPERATION	191(377.4)	187(370)	12(17.404)
INCIDENT-2	STEAM OPEN TO SHELLSIDE WITH EMPTY TUBES	175(343.7)	175(343.7)	80(116.03)
INCIDENT-3	SHELL SIDE NO STEAM @ ATM, WHILE CIRCULATING OIL THROUGH TUBES	65(149.4)	82.5(180.5)	0(0.0)

APPLICABLE STANDARDS FOR WIND & EARTHQUAKE				
WIND DESIGN --Wind Speed - 101 mph				
EARTHQUAKE DESIGN -- S _{DS} = 1.077g, S _{D1} = 0.664g (ASCE 7-16)				

APPLICABLE STANDARDS		
DESCRIPTION	EDITION	TITLE
METALLIC GASKET FOR PIPE FLANGES (LATEST)	2017	ASME B16.20
STAINLESS STEEL PIPE	2018	ASME B36.19M
WELDED & SEAMLESS WROUGHT STEEL PIPE (LATEST)	2018	ASME B36.10M
FORGED FITTINGS (LATEST)	2016	ASME B16.11
BUTTWELDED FITTINGS (LATEST)	2018	ASME B16.9
NOZZLE FLANGES UP TO NPS 24 / DN 600	2013	ASME B16.5
STAINLESS STEEL TUBES	2019	ASME 213

LOADING DATA				
SEISMIC MOMENT	N-m	15610		
SEISMIC SHEAR	N	13980		
WIND MOMENT	N-m	1110		
WIND SHEAR	N	2390		

GENERAL NOTES --


- ALL DIMENSIONS ARE IN [mm], UNLESS SPECIFIED OTHERWISE.
- ALL BOLT HOLES SHALL STRADDLE RADIAL CENTER LINES.
- PROJECTION OF NOZZLES ON SHELL SHALL BE FROM EQUIPMENT C.L. UNLESS SPECIFIED.
- ALL FULL PENETRATION WELDS (FPW) TO BE CHIPPED BACK TO SOUND METAL ON THE SECOND SIDE & REWELDED, OR FULL PENETRATION WELDS MAY BE ACHIEVED FROM ONE SIDE ONLY USING PROPER QUALIFIED WELDING PROCEDURE (WITH GTAW ROOT PASS)
- ALL WELDING SURFACES TO BE THOROUGHLY CLEANED OF SCALE, RUST, OIL OR FOREIGN BODIES. BEFORE WELDING.
- ALL SHARP CORNERS SHALL BE ROUNDED OFF TO A MINIMUM 3mm (1/8 in) RADIUS.
- ALL REINFORCING PADS SHALL HAVE TWO NUMBER 6 mm NPT (1/4 in) VENT HOLE, PLACED IN THE LOWEST AREA OF PAD. AFTER COMPLETION OF WELDING, THE PAD SHALL BE SUBJECTED TO DRY AIR AND SOAPY WATER TEST AT 0.1 MPa(g). THESE TEST HOLE SHALL BE FILLED WITH RUST PREVENTATIVE GREASE COMPATIBLE WITH THE BASE MATERIAL PRIOR TO SHIPMENT. DO NOT Plug THE TEST HOLE.
- PIPES TO BE USED IN NOZZLE CONSTRUCTION SHALL BE SEAMLESS ONLY, IF FABRICATED (ABOVE NPS 10) THE LONG SEAM SHALL BE 100% RADIOGRAPHED.
- PRESSURE RELIEF DEVICES SHALL BE PROVIDED BY THE USER & SHALL BE THEIR RESPONSIBILITY.
- EQUIPMENT TOLERANCES SHALL BE STRINGENT OF CODE(TEMA) AND SPECIFICATION. TOLERANCES ON FILLET LEG LENGTH SHALL BE 1/3 UNLESS SPECIFIED OTHERWISE TOLERANCE ON ROOT HEIGHT FOR WELD PREPARATION SHALL BE 1/3.
- ALL INTERNAL WELD OF SHELL SIDE SHALL BE GROUND FLUSH TO FACILITATE BUNDLE INSERTION. ALL EXTERNAL WELDS SHALL BE KEPT IN AS-WELDED CONDITION.
- WATER USED FOR HYDROTEST SHALL HAVE CHLORIDE CONTENT LESS THAN 25 ppm.
- WELDING TO BE DONE AS PER APPROVED WELDING PROCEDURE AND WELD TEST PLAN.
- PT SHALL BE CARRIED OUT AFTER CHIP BACK IN CASE OF ACCESSIBLE WELD & AFTER ROOT PASS IN CASE OF INACCESSIBLE WELD FOR CATEGORY A, B, C & D JOINT. PT SHALL ALSO BE CARRIED OUT ON ALL ATTACHMENT WELD WITH MAIN SHELL.
- MACHINED SURFACES, FLANGE FACES, THREADED SURFACES, AND OTHER FINISHED OR DELICATE PARTS SHALL BE WELL GREASED AND PROTECTED AGAINST RUSTING AND DAMAGE DURING SHIPMENT.
- IN ADDITION TO THE NDE REQUIREMENT PER CODE & SPECIFICATION, ATTACHMENT WELD FOR LIFTING LUG, TAILING LUG SHALL BE PT/MT EXAMINED.
- ALL NOZZLE FLANGES UP TO AND INCLUDING 24" NB SHALL BE AS PER ASME B16.5.
- ALL PRESSURE RETAINING NUTS SHALL BE OF HEAVY SERIES ONLY.
- GASKET SEATING SURFACE OF GIRTH FLANGE & NOZZLE FLANGE SHALL HAVE SERRATED FINISH OF 3.2-6.3 µm.
- ANY OFFSET WITHIN THE ALLOWABLE TOLERANCE PROVIDED IN CODE SHALL BE TAPERED AT A THREE TO ONE TAPER.
- PAINTING:
SHELL SIDE INTERNAL : SURFACE PROTECTION AS PER TNO001
SHELL SIDE EXTERNAL : SURFACE PROTECTION AS PER TNO001
TUBE SIDE INTERNAL : NONE
TUBE SIDE EXTERNAL : NONE
TUBE-TUBESHEET JOINT : NONE

DESIGN PARAMETERS									
CONSTRUCTION CODE / REGULATIONS: ASME SECTION VIII DIV.1, 2019 EDITION • TEMA 10 TH EDITION (2019)									
ASME CERTIFICATION MARK : YES WITH 'U' DESIGNATOR									
NATIONAL BOARD REGISTRATION : YES									
TEMA CLASS: C, TEMA TYPE: 80M (VI), SIZE 680 x 3000 mm									
DESCRIPTION			UNIT	SHELL SIDE		TUBE SIDE			
FLUID NAME			-	STEAM		PRODUCT 1 + BE			
CAPACITY			m ³ (ft ³)	0.580 (20.482)		0.714 (25.24)			
SPECIFIC GRAVITY			-	0.0047 / 0.8915		0.8712 / 0.8573			
DESIGN PRESSURE [INT. / EXT.]			Bar(g) [psi(g)]	12.0 / F.V. (174.04 / F.V.)		6.0 / F.V. (87.02 / F.V.)			
MAWP (INTERNAL) / MAWP (EXTERNAL)			Bar(g) [psi(g)]	12.0 / F.V. (174.04 / F.V.)		6.0 / F.V. (87.02 / F.V.)			
HYDROSTATIC TEST PRESSURE (AT TOP) [POSITION]			Bar(g) [psi(g)]	16.735 (242.72) (UG99)(b)		8.361 (121.35) (UG99)(b)			
MAX. DESIGN TEMPERATURE [INT. / EXT.]			°C (°F)	220 / 220 (428 / 428)		220 / 220 (428 / 428)			
MIN. DESIGN TEMP. TEMPERATURE			°C (°F)	-10 (14) AT 12 Bar g		-10 (14) AT 6 Bar g			
TEST TEMPERATURE [MIN. / MAX.]			°C (°F)	0 / 48 (32 / 120)		0 / 48 (32 / 120)			
CORROSION ALLOWANCE [INT. / EXT.]			mm(in)	0 / 0		0 / 0			
RADIOGRAPHY / JOINT EFFICIENCY			-	NONE / 0.7		NONE / 0.7 (SEAMLESS HEAD)			
PFHT			-	EXEMPTED AS PER UHA-44		EXEMPTED AS PER UHA-44			
PWIT			-	EXEMPTED AS PER UHA-32		EXEMPTED AS PER UHA-32			
IMPACT TEST			-	EXEMPTED AS PER UHA-51		EXEMPTED AS PER UHA-51			
NO. OF PASSES			-	ONE		FIVE			
PAINTING			-	NA		NOTE-21			
INSULATION THICKNESS / TYPE			mm(in) / -	100 (4.0) / MINERAL WOOL		100 (4.0) / MINERAL WOOL			
FRIBROPROOFING (BY LUG)			-	NONE		NONE			
APPLICABLE UG-22 LOADING DATA			-	(a), (b), (c), (d), (f), (h), (i)		EXEMPTED AS PER UHA-44			
HEAT TRANSFER AREA PER SHELL			m ² (ft ²)	1022 (GROSS), 99.2 (EFF.)		1100 (GROSS), 1068 (EFF.)			
EMPTY WEIGHT [W]			kg (lb)	-2420 (5335)		-			
TEST WEIGHT [W]			kg (lb)	-3750 (8267)		-			
OPERATING WEIGHT [W]			kg (lb)	-3590 (7915)		-			
MANUFACTURER SERIAL NUMBER			-	--		-			
INSPECTION BY			-	ASME INSPECTOR		-			

OPERATING PARAMETERS				
DESCRIPTION		UNIT	SHELL SIDE	TUBE SIDE
OPERATING PRESSURE		Bar(g) [psi(g)]	8.0 / 7.993 (116.03 / 115.9)	2.80 / 2.55 (40.61 / 36.98)
OPERATING TEMPERATURE [IN / OUT]		°C (°F)	175.5 / 175.4 (347.9 / 347.7)	84.2 / 105.0 (193.6 / 221)

SERVICE RESTRICTIONS				
DESCRIPTION		SHELL SIDE	TUBE SIDE	
CYCLIC / LETHAL / HYDROGEN SERVICE		NO / NO / NO	NO / NO / NO	
SOUR SERVICE / NACE REQUIREMENTS		NO / NO	NO / NO	
EXPLOSIVE / FLAMMABLE SERVICE		NO / NO	NO / NO	

NOZZLE PARAMETERS										
MARK	PIPE SIZE		FLANGE			R.F. PAD		PROJECTION	SERVICE	
	NOMINA L DIA	SCH / THK	CLASS	TYPE	FACE	FINISH Ra µm	O.D. (mm) [in]			THK. (mm) [in]
S1	NB 4"	SCH 40S	CL 150	SO	RF	3.2-6.3	210 (8 1/4")	6.35 (1/4")	500 (19 3/4")	STEAM INLET
S2	NB 4"	SCH 40S	CL 150	SO	RF	3.2-6.3	210 (8 1/4")	6.35 (1/4")	500 (19 3/4")	CONDENSATE OUTLET
T1	NB 6"	SCH 40S	CL 150	SO	RF	3.2-6.3	300 (11 13/16")	6.35 (1/4")	500 (19 3/4")	PRODUCT 1 + BE INLET
T2	NB 6"	SCH 40S	CL 150	SO	RF	3.2-6.3	300 (11 13/16")	6.35 (1/4")	500 (19 3/4")	PRODUCT 1 + BE OUTLET
V1 TO V3	NB 1/2"	SCH 40S	CL 150	SO	RF	3.2-6.3	-	-	SEE ORG.	TUBE SIDE VENT
D1 TO D3	NB 1"	SCH 40S	CL 150	SO	RF	3.2-6.3	-	-	SEE ORG.	TUBE SIDE DRAIN
S3	NB 1/2"	SCH 40S	CL 150	SO	RF	3.2-6.3	-	-	500 (19 3/4")	SHELL SIDE VENT

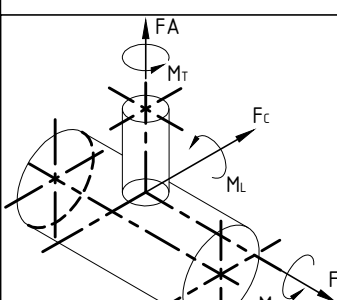

PIPING NOZZLE LOADS TABLE						
MARK	RADIAL FORCE (F _R) [N (lbf)]	CIRC. FORCE (F _C) [N (lbf)]	LONG. FORCE (F _L) [N (lbf)]	CIRC. MOMENT (M _C) [N-m (ft-lbf)]	LONG. MOMENT (M _L) [N-m (ft-lbf)]	TORSIONAL MOMENT (M _T) [N-m (ft-lbf)]
S1	2840 (638)	2190 (479)	2840 (638)	680 (1502)	1020 (1752)	1280 (1943)
S2	2840 (638)	2190 (479)	2840 (638)	680 (1502)	1020 (1752)	1280 (1943)
T1	3820 (859)	2860 (643)	3820 (859)	1160 (1856)	1740 (1283)	2180 (1608)
T2	3820 (859)	2860 (643)	3820 (859)	1160 (1856)	1740 (1283)	2180 (1608)

TOP AND BOTTOM HEAD GASKET TYPE/MATERIAL : GARLOCK 3510 (m = 2 & y = 17.2 MPa (2494.649 psi)) , DIMENSION OF TOP AND BOTTOM HEAD GASKET: 721 O.D. x 695 I.D. x 3 THK.

NOZZLE MATERIAL OF CONSTRUCTION		
POS. NO.	NOZZLE NECKS	NOZZLE FLANGES
S1	SA-312 GR TP304	SA-182 GR F304
S2	SA-312 GR TP304	SA-182 GR F304
T1	SA-312 GR TP304	SA-182 GR F304
T2	SA-312 GR TP304	SA-182 GR F304
V1 TO V3	SA-312 GR TP304	SA-182 GR F304
D1 TO D3	SA-312 GR TP304	SA-182 GR F304
S3	SA-312 GR TP304	SA-182 GR F304

113	TIE ROD	11	-	SS 304	
112	BAFFLE PLATE	6	-	SA-240 TYPE 304	
111	TUBES	569	-	SA-213 GR TP 304L (SEAMLESS)	
110	TUBE SHEET	2	-	SA-240 TYPE 304	
109	EARTHING LUG	2	-	SS 304	
108	LUG SUPPORT	4	-	SA-240 TYPE 304 / SA-285 GR C	
107	LIFTING TRUNNION	2	-	SA-240 TYPE 304 / SA-285 GR C / SA-106 GR B	
106	LIFTING LUG	4	-	SA-240 TYPE 304 / SA-285 GR C	
105	TAILING LUG	1	-	SA-240 TYPE 304 / SA-285 GR C	
104	CHANNEL DISH	2	-	SA-240 TYPE 304	
103	BOTTOM CHANNEL SHELL	1	-	SA-240 TYPE 304	
102	TOP CHANNEL SHELL	1	-		
101	MAIN SHELL	1	-		
PART NO.	PART	QTY	SIZE	MATERIAL	REMARK

BILL OF MATERIAL (FOR ONE EQUIPMENT)					
004	09.09.2021	HOLD REMOVED FOR SUPPORT LUG ELEVATION HEIGHT AND ADDED EXPANSION BELLOW (MARKED 004)			PKV
003	20.07.2021	DRAWING UPDATED AS PER PROCESS COMMENTS (MARKED 003)			PKV
002	05.07.2021	UPDATED ORIENTATION AND HOLD REMOVED FOR ORIENTATION AND DRAWING UPDATED AS PER COMMENTS (MARKED 002)			PKV
001	04.05.2021	DRAWING UPDATED IMPERIAL UNITS TO METRIC AS PER PROCESS COMMENTS (MARKED 001)			PKV
REV	DATE (dd-mm-yyyy)	DESCRIPTION OF MODIFICATION	NBR OF MOD	BY	

	DESMET BALLESTRA	DRAWN BY -	PROJ. -	CHKD BY -	DATE (dd-mm-yyyy) -
ITEM/SECTION NUMBER	621B.1 (19-X-752)	CHECKED BY -	PROJ.M -	SCALE -	09.02.2021
ITEM/SECTION DESCRIPTION	OIL / STEAM HEAT EXCHANGER	DOCUMENT	VESEL (ASSY)		
Sh=102.2 D=680 Ltub=3000			DOCUMENT NUMBER	REVISION	
GENERAL ARRANGEMENT			100176782	004	