



PROJECT - WORPAR
ITEM NBR - 681B1.1
eB NBR - 100207381.000
DATE - 01.09.2021

Values on the name plate to be shown in Imperial unit
Also please refer to the main GA drawing for the comment on
discrepancies on design/working pressure values

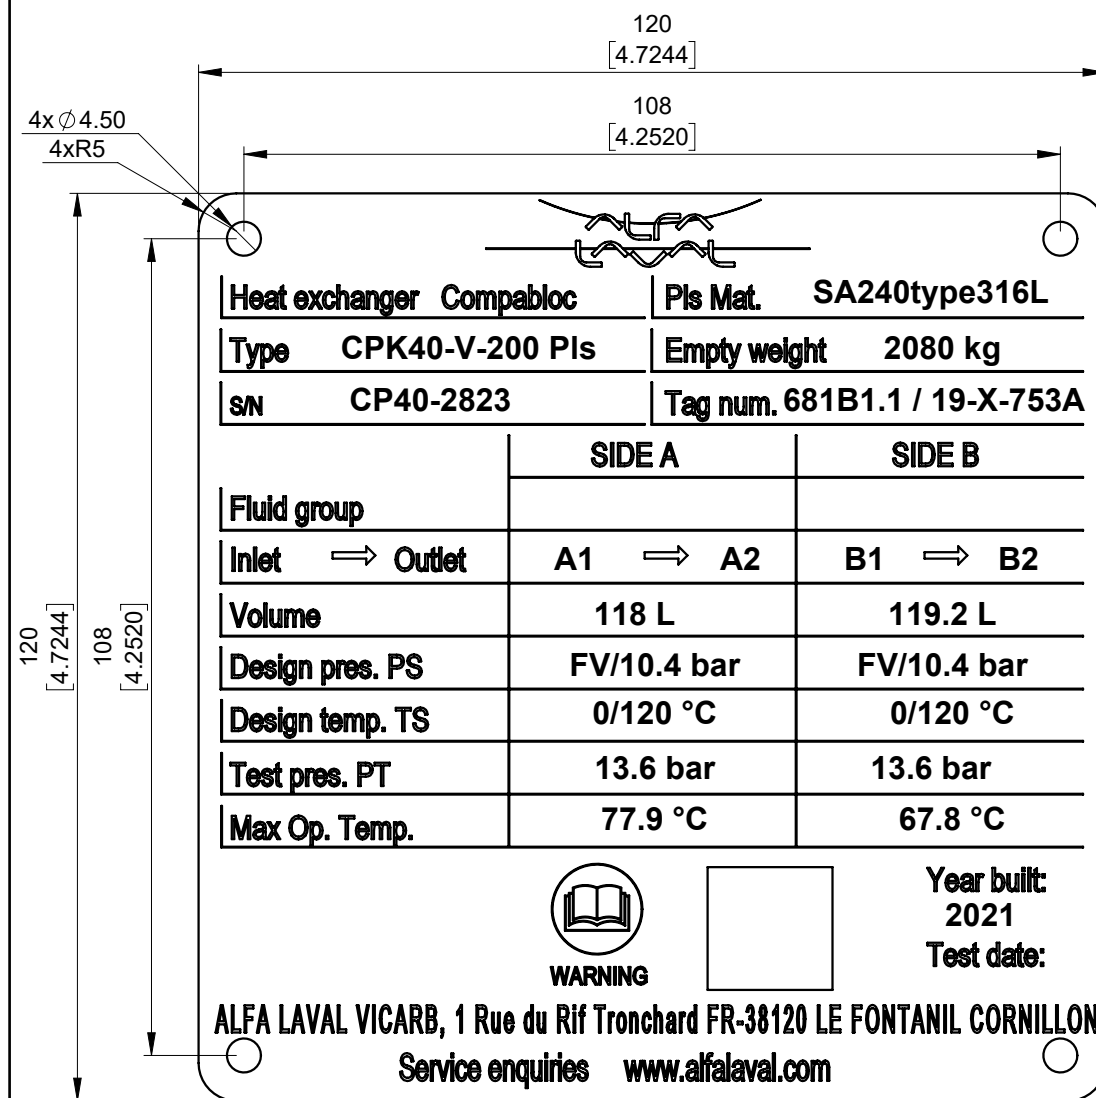

21 Plaque Alfa Laval
Alfa Laval plate

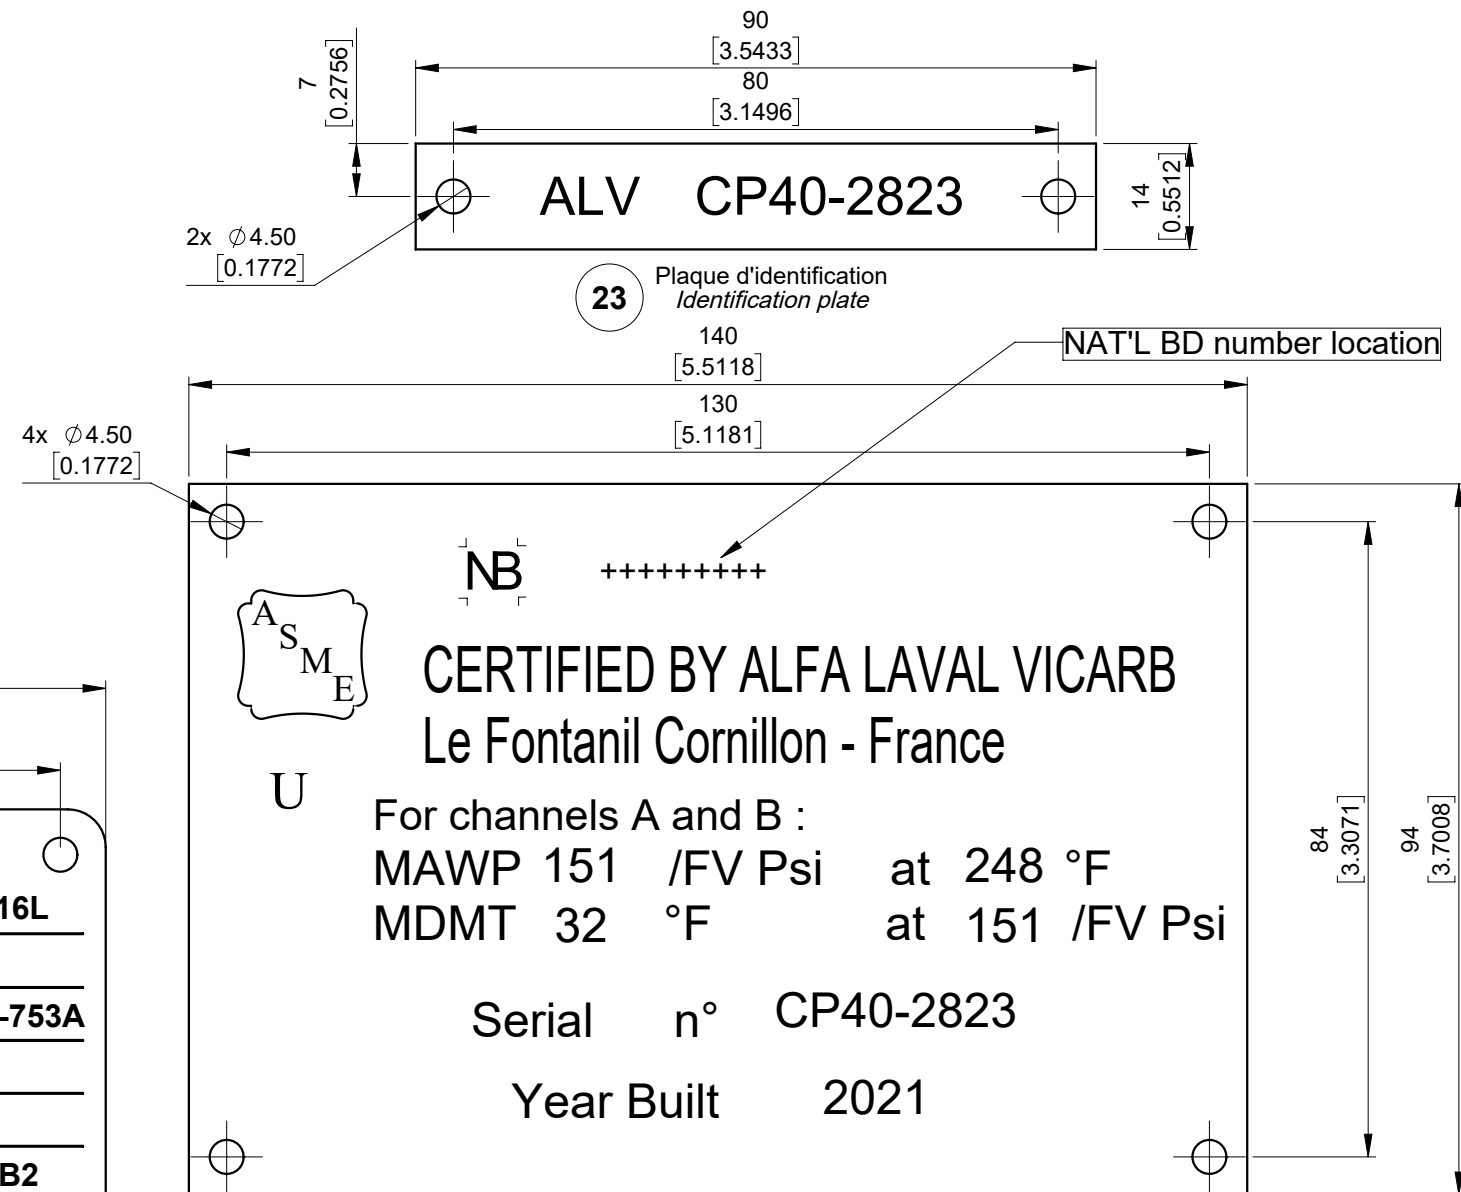

22 Plaque ASME
ASME-U plate

QCM. Review:		AI. Review:		Approved by D.E.:		
00	19/07/2021	NRL	TSZ	SBU	-	FIRST ISSUE
INDICE REVIEW	DATE DATE	NOM AUTHOR	VERIFIE CHECKED	APPROUVE APPROVED	-	REVIEW SUBJECT
PLAQUE DE FIRME CPK40-V-200 Plaques NAME PLATES CPK40-V-200 Plates						CLIENT CUSTOMER DESMET Cde CLIENT CUSTOMER ORDER - Cde ALFA LAVAL ALFA LAVAL ORDER CP2021-24561
NO. SERIE CP40-2823		SERIAL NO. CP40-2823		ECHELLE 1:1 SCALE		A3
REPERE 681B1.1 / 19-X-753A		ITEM or TAG 681B1.1 / 19-X-753A		DWG-CP21-24561-02		00