


PROJECT - WORPAR
ITEM NBR - 681B2.1
eB NBR - 100207383.000
DATE - 01.09.2021


Values on the name plate to be shown in Imperial unit
Also please refer to the main GA drawing for the comment on
discrepancies on design/working pressure values

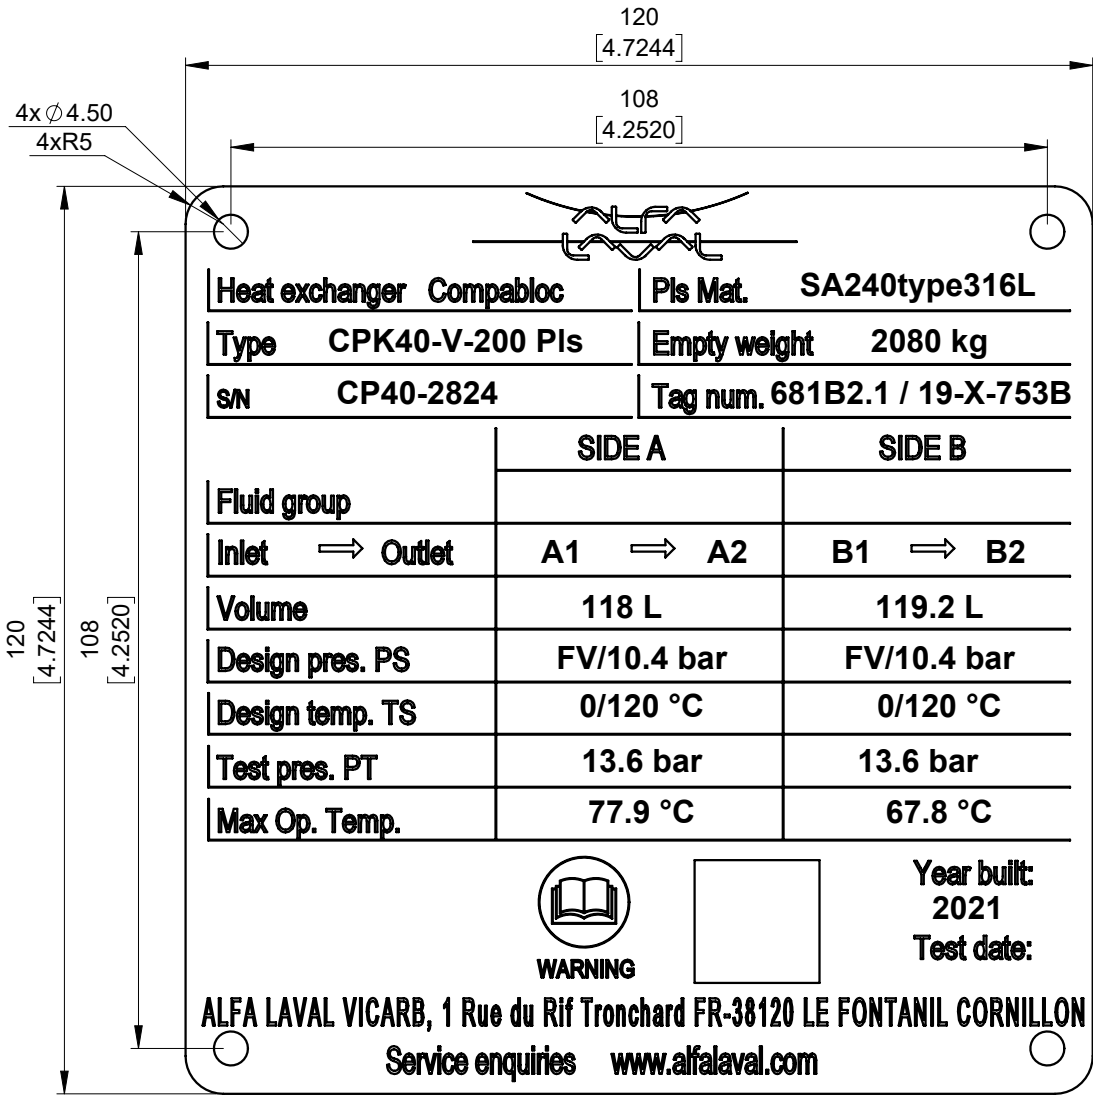

Plaque Alfa Laval
Alfa Laval plate

21

Ce document et son contenu sont la propriété d'Alfa Laval, il ne doit ni être copié, ni reproduit, ni transmis ou
divulgué à des tiers sans le consentement d'Alfa Laval.
This document and its contents are the property of Alfa Laval and must not be copied, reproduced,
transmitted, or disclosed to any third party without the consent of Alfa Laval.

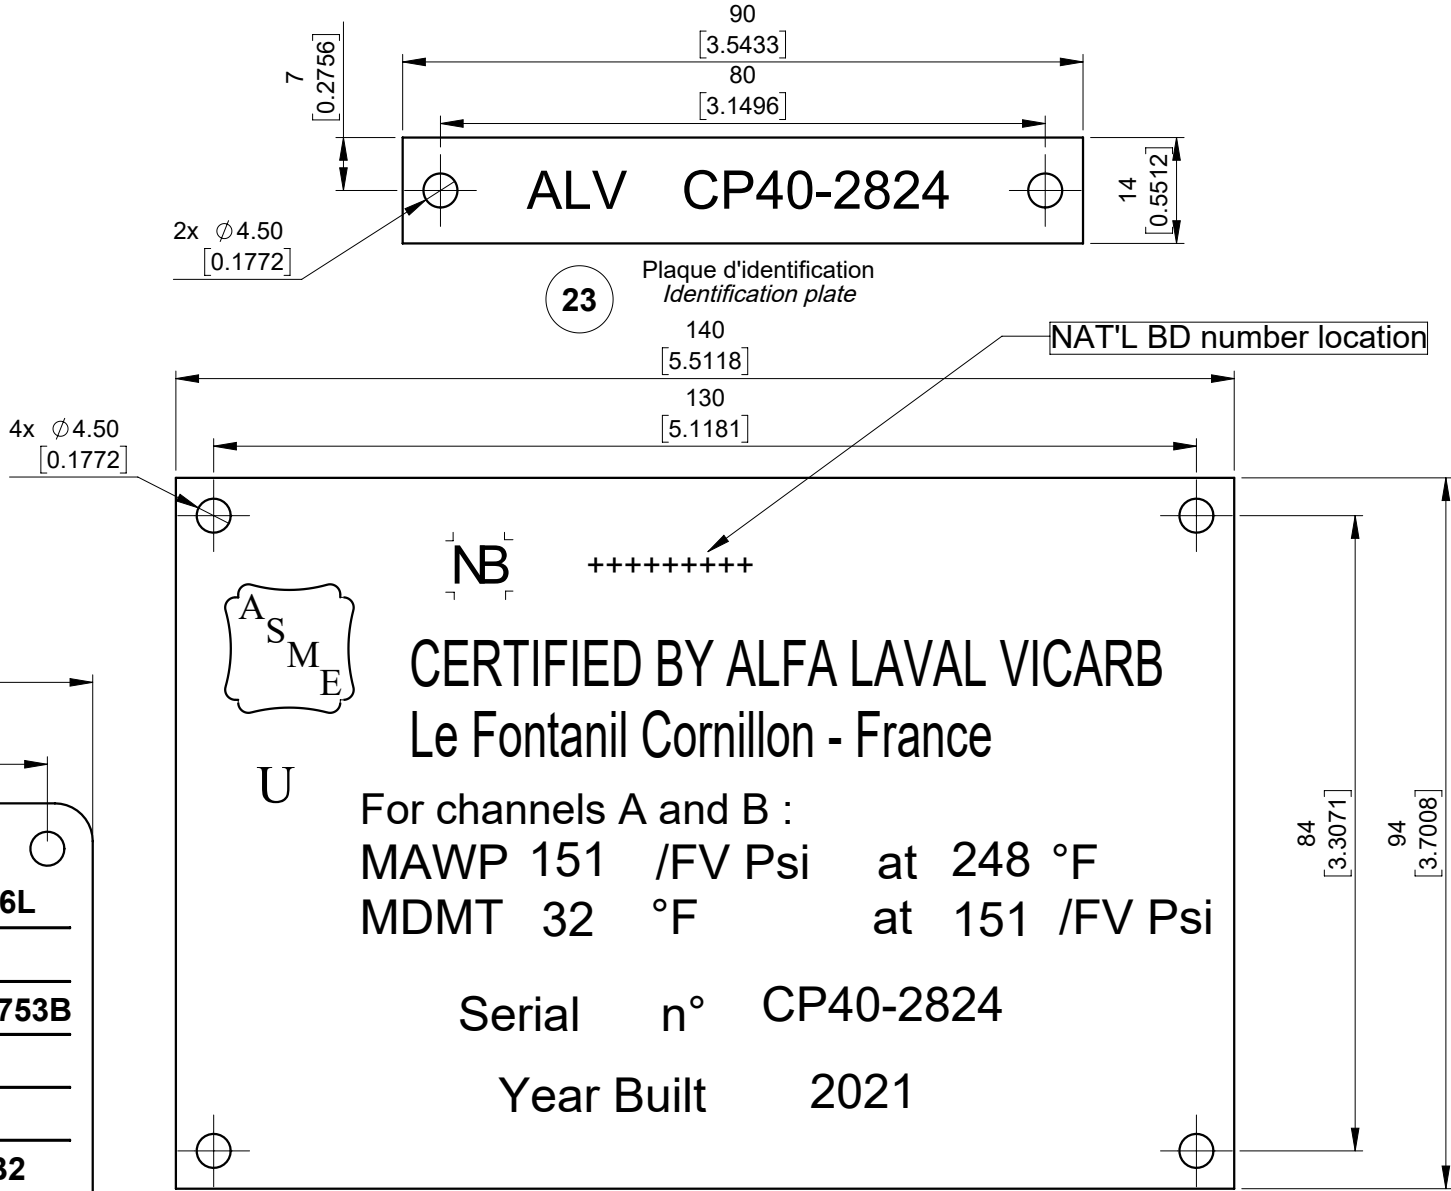

22

Plaque ASME
ASME-U plate

QCM. Review:		AI. Review:		Approved by D.E.:	
00	20/07/2021	NRL	TSZ	SBU	-
INDICE REVIEW	DATE DATE	NOM AUTHOR	VERIFIE CHECKED	APPROUVE APPROVED	-
PLAQUE DE FIRME CPK40-V-200 Plaques NAME PLATES CPK40-V-200 Plates					CLIENT CUSTOMER DESMET Cde CLIENT CUSTOMER ORDER - Cde ALFA LAVAL ALFA LAVAL ORDER CP2021-24562
NO. SERIE CP40-2824		SERIAL NO.		ECHELLE 1:1	A3
REPERE 681B2.1 / 19-X-753B		ITEM or TAG		DWG-CP21-24562-02 00	