


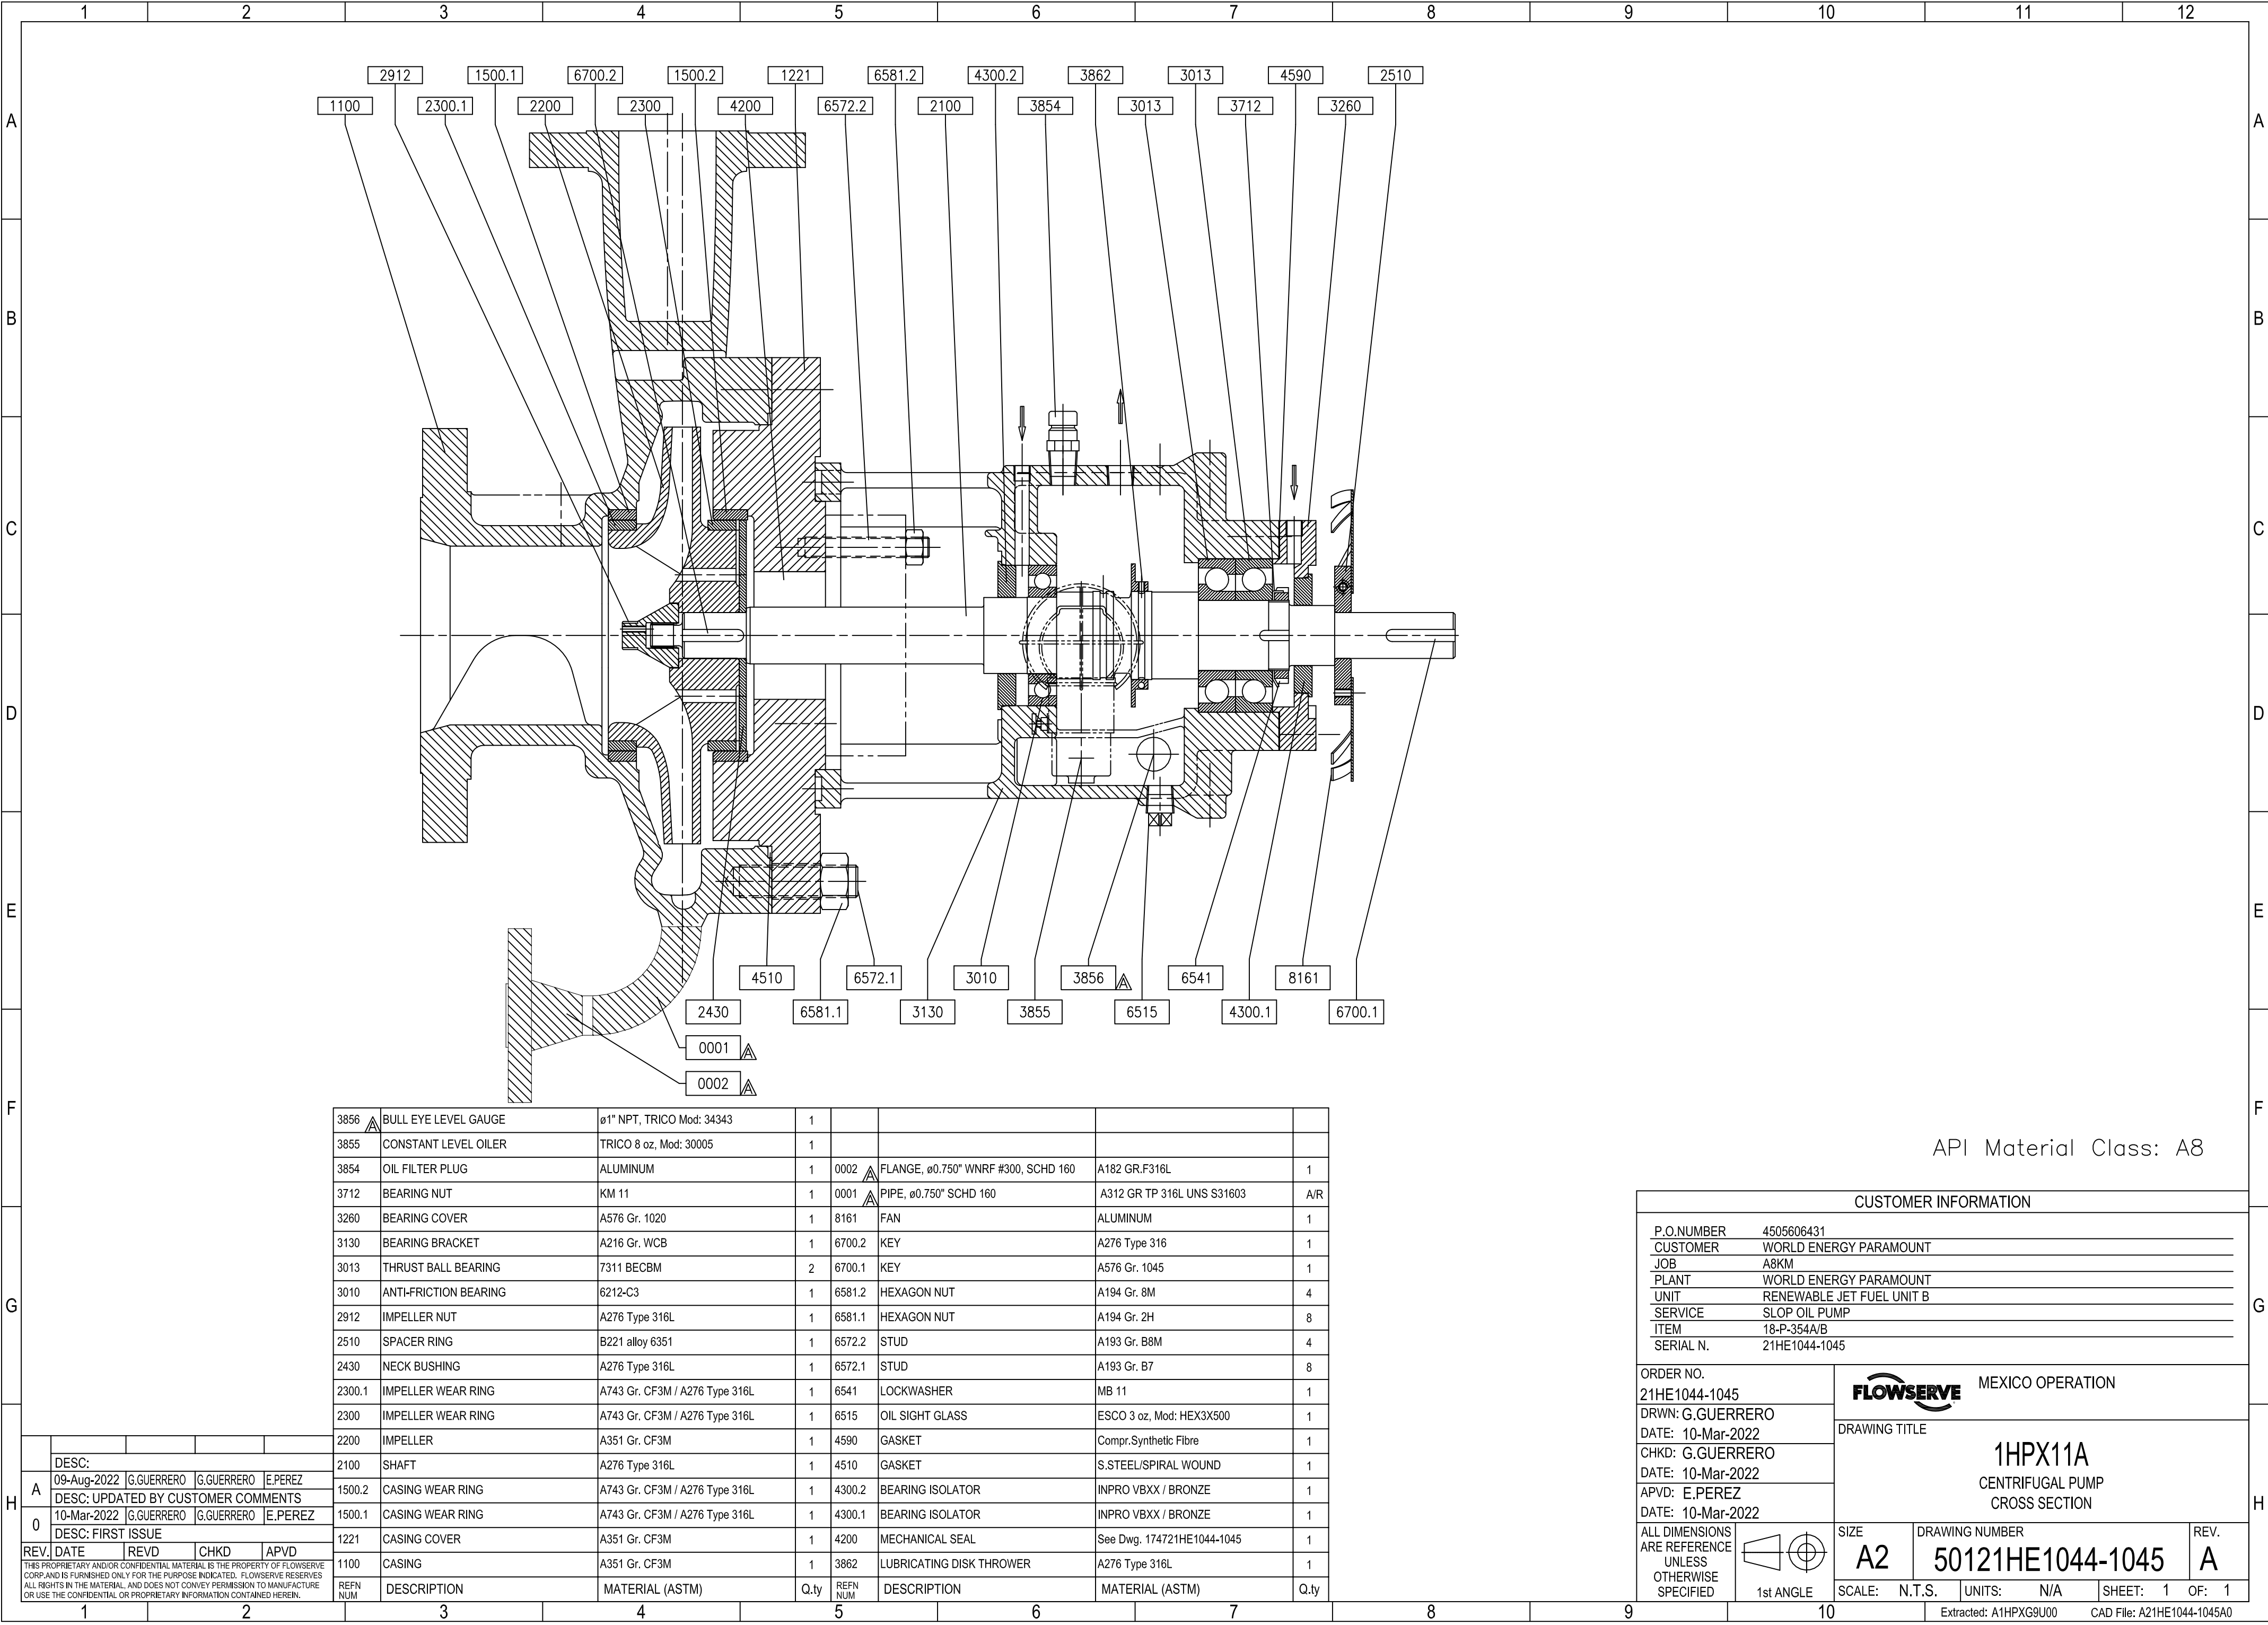

3856	▲ BULL EYE LEVEL GAUGE	ø1" NPT, TRICO Mod: 34343	1				
3855	CONSTANT LEVEL OILER	TRICO 8 oz, Mod: 30005	1				
3854	OIL FILTER PLUG	ALUMINUM	1	0002 ▲	FLANGE, ø0.750" WNR# #300, SCHD 160	A182 GR.F316L	1
3712	BEARING NUT	KM 11	1	0001 ▲	PIPE, ø0.750" SCHD 160	A312 GR TP 316L UNS S31603	A/R
3260	BEARING COVER	A576 Gr. 1020	1	8161	FAN	ALUMINUM	1
3130	BEARING BRACKET	A216 Gr. WCB	1	6700.2	KEY	A276 Type 316	1
3013	THRUST BALL BEARING	7311 BECBM	2	6700.1	KEY	A576 Gr. 1045	1
3010	ANTI-FRICTION BEARING	6212-C3	1	6581.2	HEXAGON NUT	A194 Gr. 8M	4
2912	IMPELLER NUT	A276 Type 316L	1	6581.1	HEXAGON NUT	A194 Gr. 2H	8
2510	SPACER RING	B221 alloy 6351	1	6572.2	STUD	A193 Gr. B8M	4
2430	NECK BUSHING	A276 Type 316L	1	6572.1	STUD	A193 Gr. B7	8
2300.1	IMPELLER WEAR RING	A743 Gr. CF3M / A276 Type 316L	1	6541	LOCKWASHER	MB 11	1
2300	IMPELLER WEAR RING	A743 Gr. CF3M / A276 Type 316L	1	6515	OIL SIGHT GLASS	ESCO 3 oz, Mod: HEX3X500	1
2200	IMPELLER	A351 Gr. CF3M	1	4590	GASKET	Compr.Synthetic Fibre	1
2100	SHAFT	A276 Type 316L	1	4510	GASKET	S.STEEL/SPIRAL WOUND	1
1500.2	CASING WEAR RING	A743 Gr. CF3M / A276 Type 316L	1	4300.2	BEARING ISOLATOR	INPRO VBXX / BRONZE	1
1500.1	CASING WEAR RING	A743 Gr. CF3M / A276 Type 316L	1	4300.1	BEARING ISOLATOR	INPRO VBXX / BRONZE	1
1221	CASING COVER	A351 Gr. CF3M	1	4200	MECHANICAL SEAL	See Dwg. 174721HE1044-1045	1
1100	CASING	A351 Gr. CF3M	1	3862	LUBRICATING DISK THROWER	A276 Type 316L	1
REFN	DESCRIPTION	MATERIAL (ASTM)	Q.ty	REFN	DESCRIPTION	MATERIAL (ASTM)	Q.ty

CUSTOMER INFORMATION			
P.O.NUMBER	4505606431		
CUSTOMER	WORLD ENERGY PARAMOUNT		
JOB	A8KM		
PLANT	WORLD ENERGY PARAMOUNT		
UNIT	RENEWABLE JET FUEL UNIT B		
SERVICE	SLOP OIL PUMP		
ITEM	18-P-354A/B		
SERIAL N.	21HE1044-1045		
ORDER NO.	21HE1044-1045		
DRWN: G.GUERRERO	DATE: 10-Mar-2022		
CHKD: G.GUERRERO	DATE: 10-Mar-2022		
APVD: E.PEREZ	DATE: 10-Mar-2022		
ALL DIMENSIONS ARE REFERENCE UNLESS OTHERWISE SPECIFIED	1st ANGLE	SIZE	DRAWING NUMBER
A2	50121HE1044-1045	SCALE: N.T.S.	UNITS: N/A
SHEET: 1	OF: 1		