


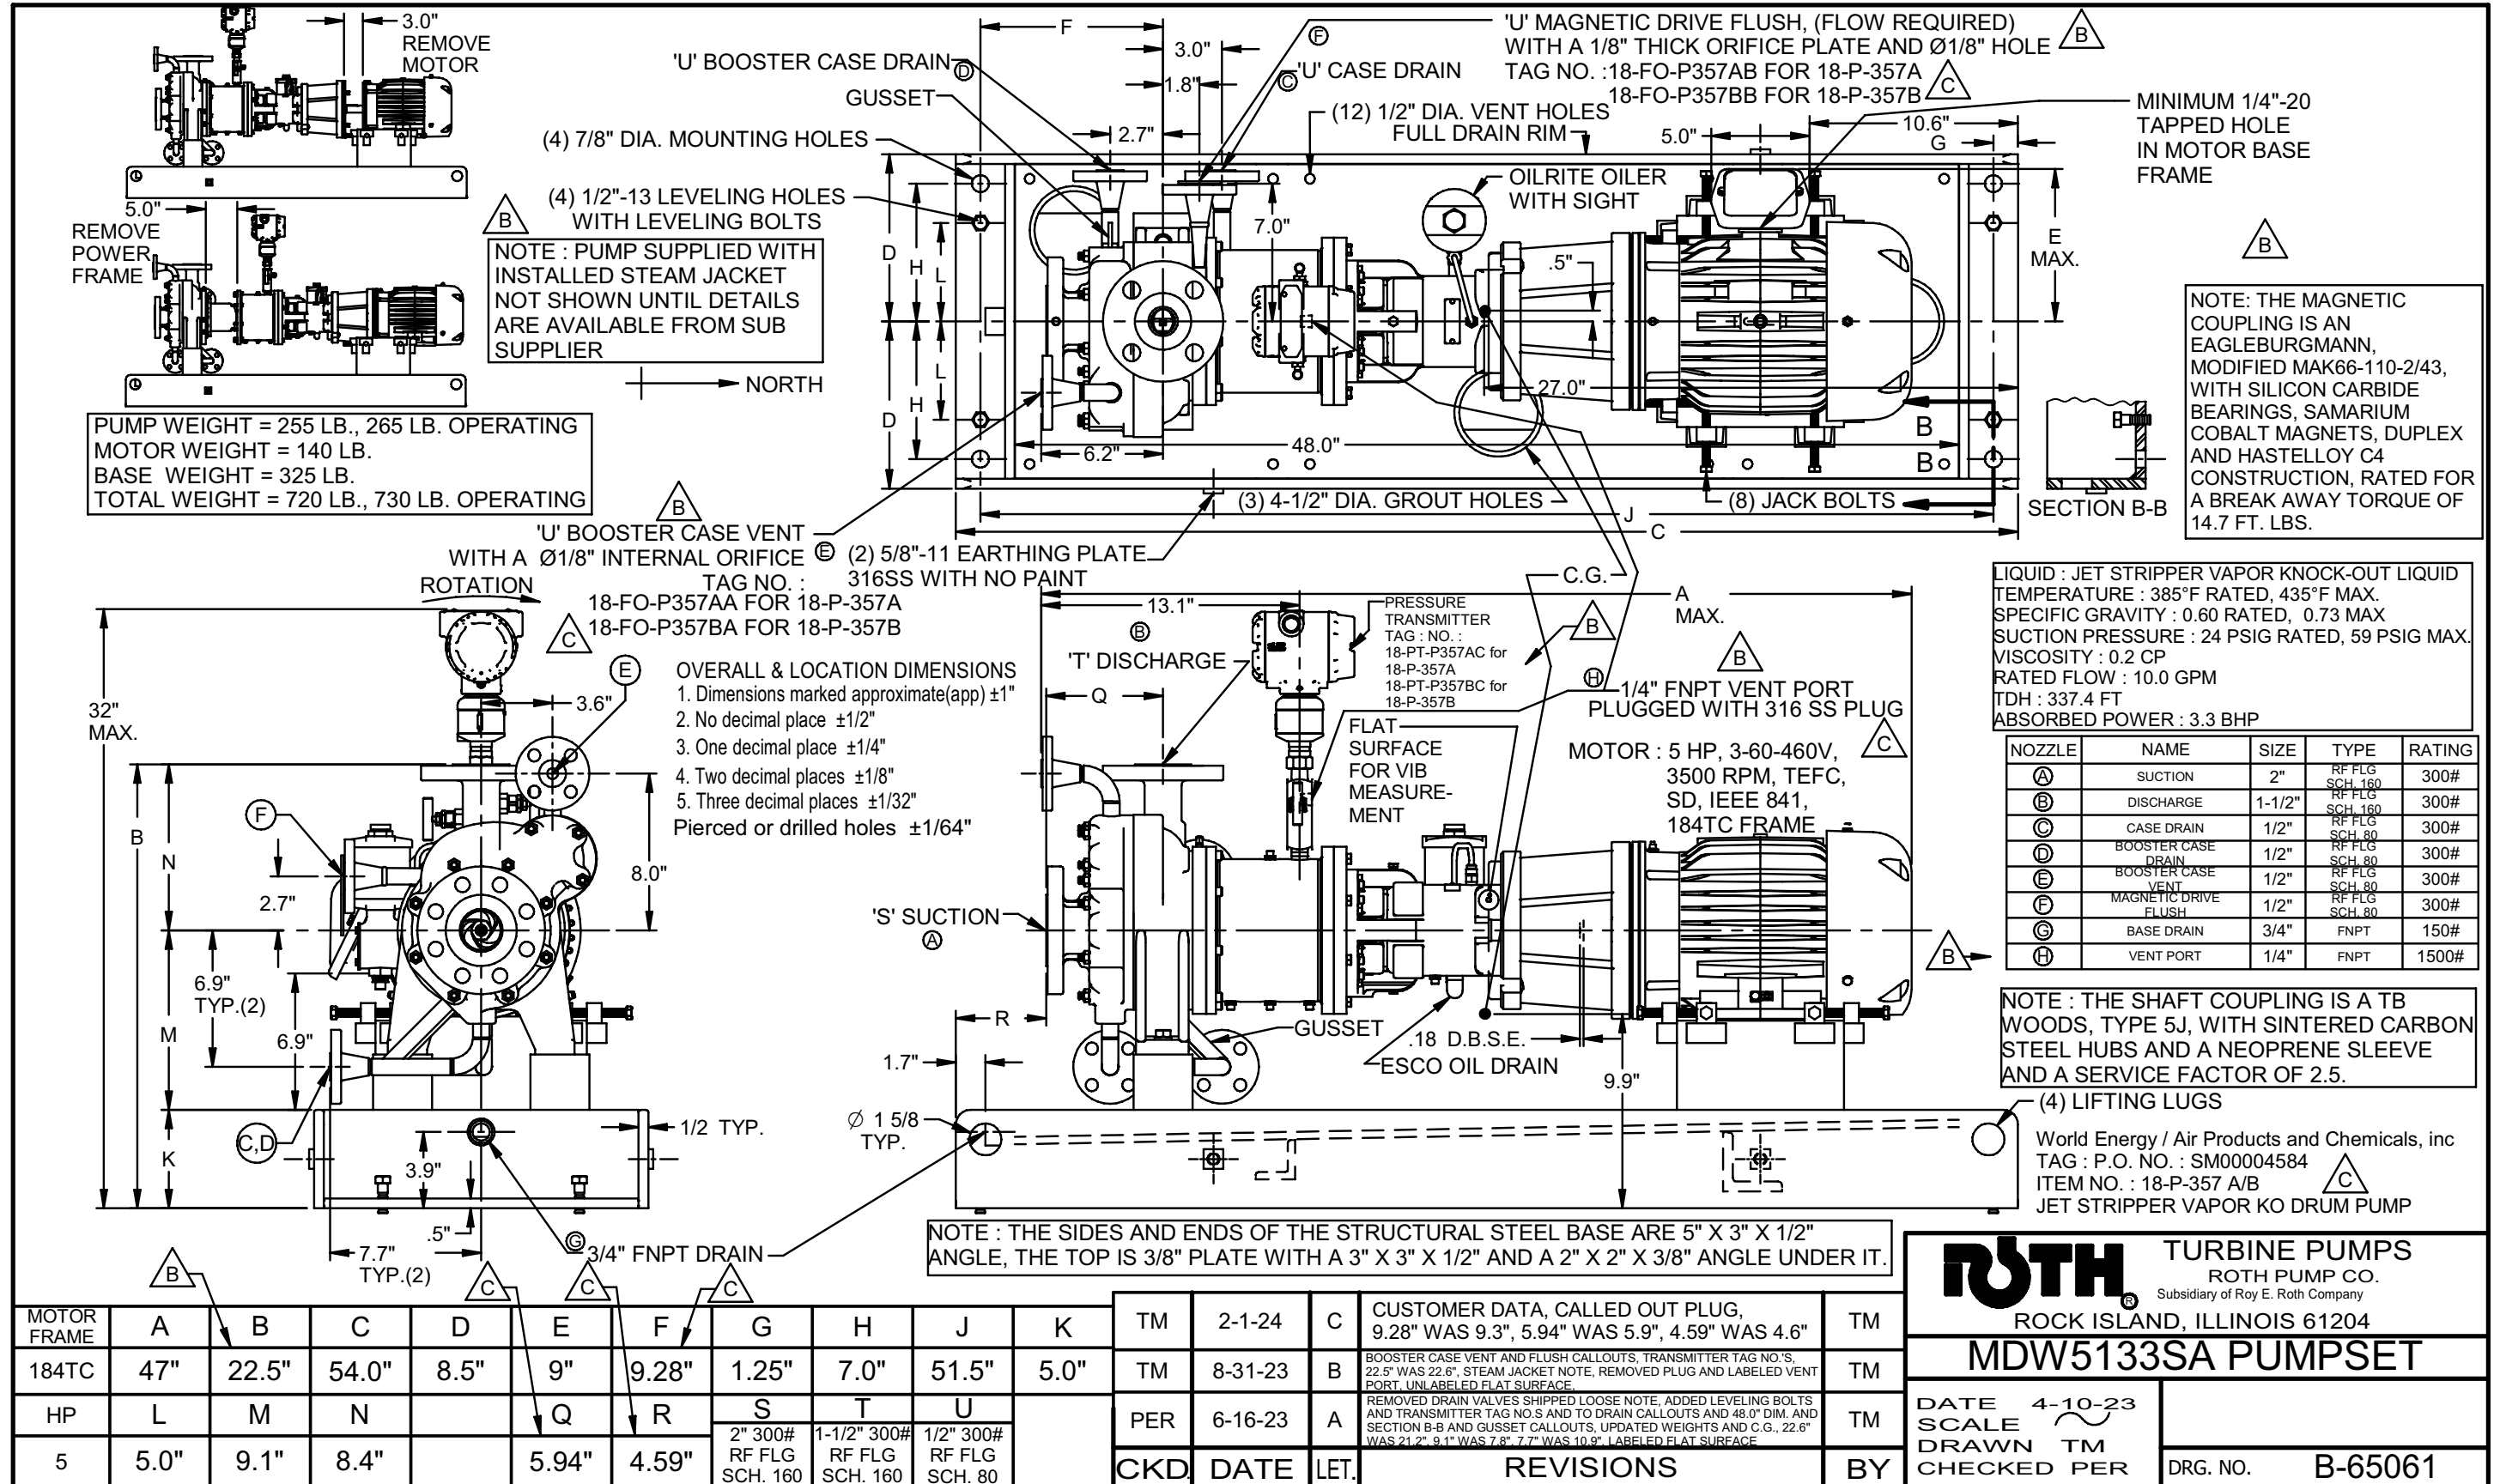

TURBINE PUMPS
ROTH PUMP CO.
 Subsidiary of Roy E. Roth Company
 ROCK ISLAND, ILLINOIS 61204

MDW5133SA PUMPSET

DATE 4-10-23
 SCALE
 DRAWN TM
 CHECKED PER

DRG. NO. B-65061