

\*\* H 1376 001 (MACHINED GLAND PLATE ASS'Y)

\*\*\* 3196 STX BIG BORE, TAPER BORE VPE, TAPER BORE AXIAL RIBS

**TAG # 19-P-053 A/B**



(A)

EQUIPMENT REFERENCE		CUSTOMER INFORMATION:	
UNIT BY:	Griswold Pump	CUSTOMER:	
EQUIPMENT TYPE:		P.O.NO.	
<input checked="" type="checkbox"/> PUMP <input type="checkbox"/> AGITATOR		END USER:	
<input type="checkbox"/> COMPRESSOR <input type="checkbox"/> OTHER		LOCATION:	
MODEL / SIZE GRISWOLD 811 S 3x1.5-8 (AB)		REQ.NO.	
SERIAL NO.		INSTALLED AT:	

SERVICE DATA										
FLUID    WATER, WASTE					BARRIER FLUID    NOT APP.					
SEAL PRESSURE    5.9 PSIG			SUCT.PRESS.    0.0 PSIG			VISC.AT P.T.    1.0 CP				
TEMPERATURE    100-165 DEG F			DISCH.PRESS. 19.5 PSIG			V.P.AT P.T.				
SHAFT SPEED    1,750 RPM			SP.GR.    1.00			HAZARD CODE				
REFE <div>Variable Speed</div>			DRAWN	DATE	CHK'D	APP'D	SCALE	INST CODE		
E.P.#2270-9702			LFK	021897	DSC	MGK	2:1			
			FILE REFERENCE		CAT	DRAWING No.				ISSUE
			MG-01		D	H-SP-38062-2				B
CAD ENGINEERED										

SEAL SIZE:	Ø 1.375
SEAL TYPE:	T-5611-Q BIG BORE VERSION

ALL DIMENSIONS ARE IN INCHES	
IN.	M.M.
.001	.025
.002	.05
.040	1.02
.375	9.52
.562	14.27
.625	15.87
1.017	25.83
1.228	31.19
1.353	34.37
1.375	34.93
1.446	36.72
1.937	49.20
2.000	50.80
2.062	53.37
2.125	53.97
2.875	73.02
3.023	76.78
3.268	83.00
3.500	88.90
4.062	103.17
5.375	136.52

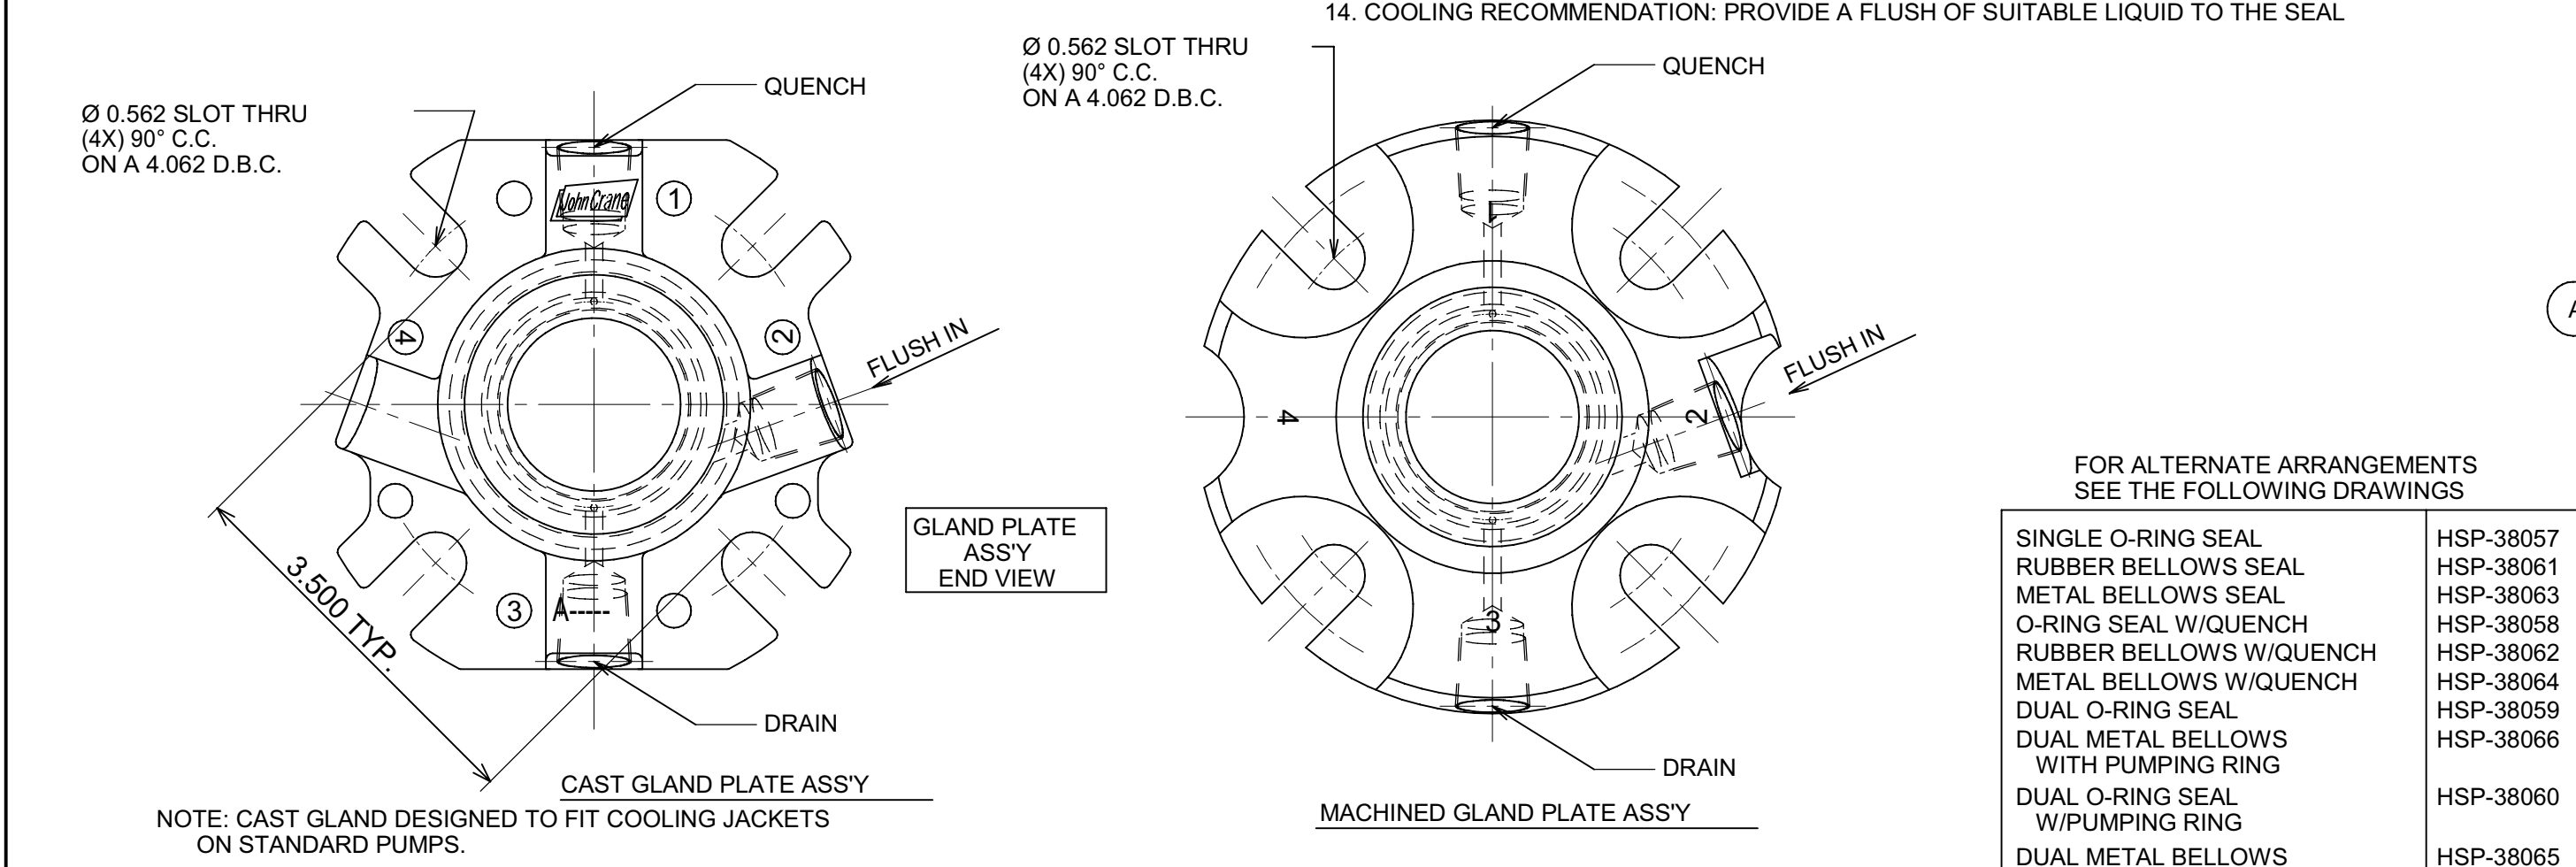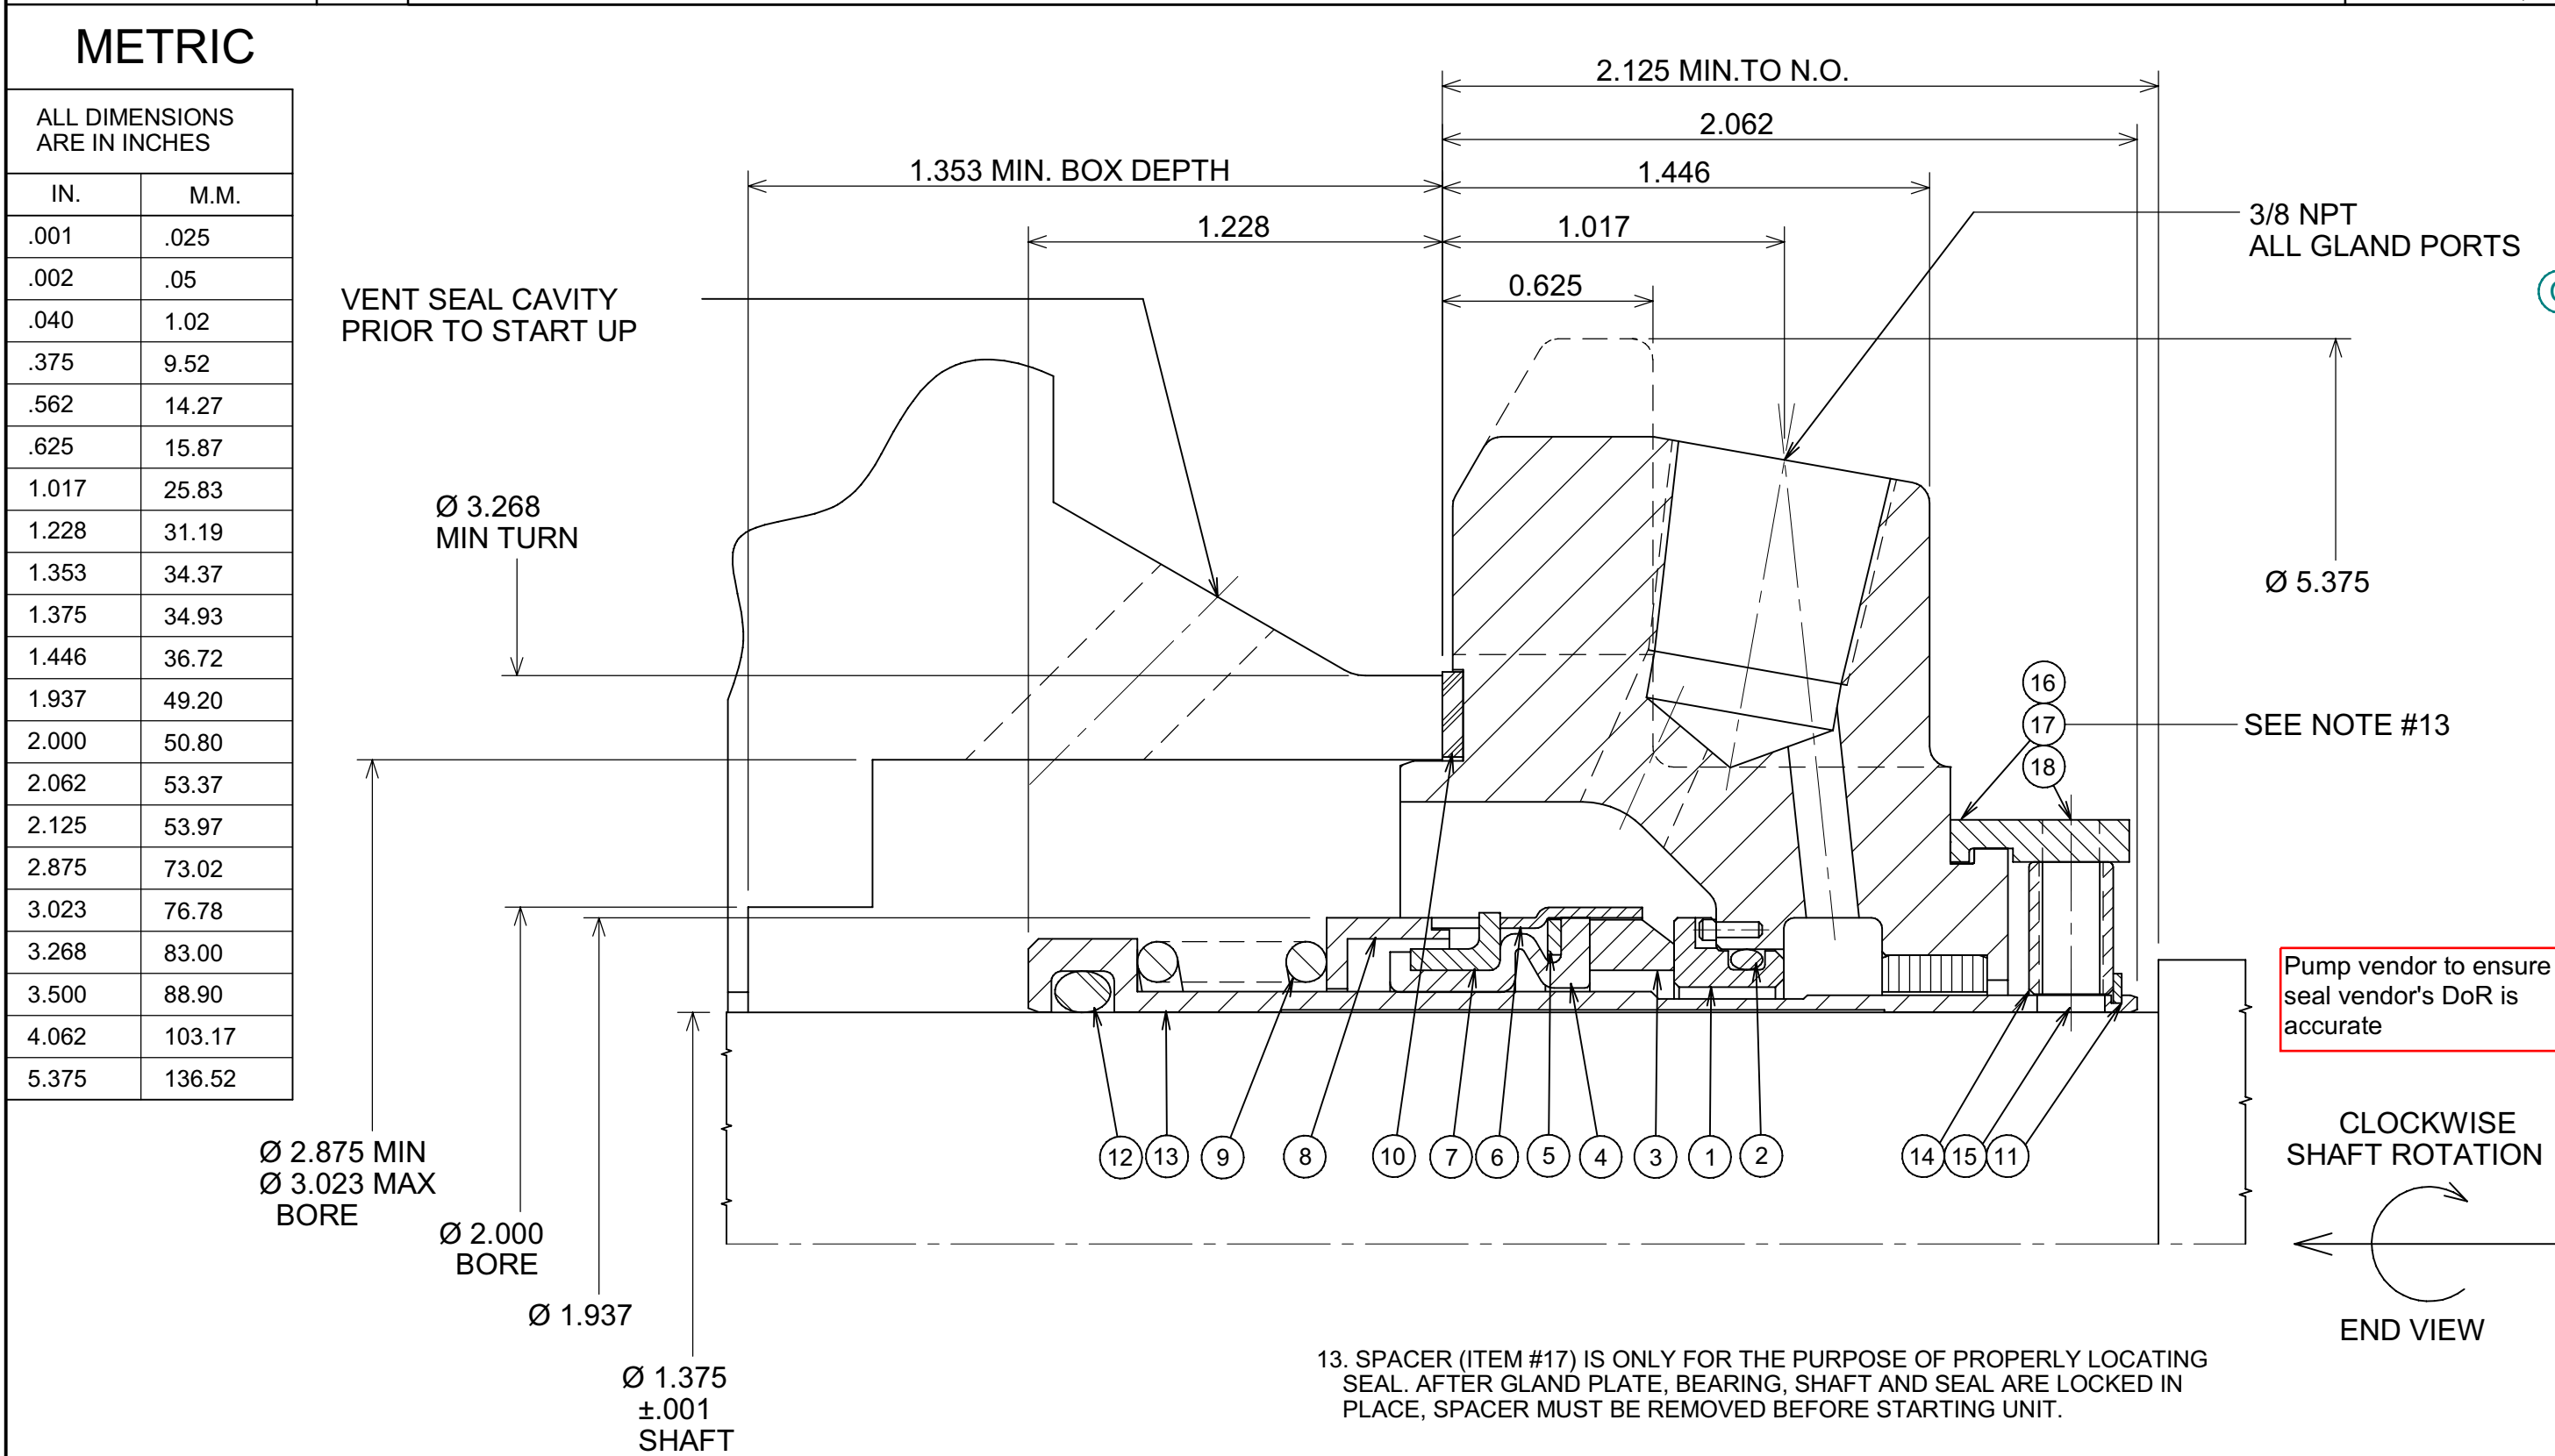

THE FOLLOWING NOTES ARE IMPORTANT AND MUST BE OBSERVED FOR CORRECT SEAL INSTALLATION AND OPERATION

1. REMOVE ALL SHARP EDGES ON SHAFT AND/OR SLEEVE BEFORE INSTALLATION OF SEAL.
  2. SURFACE OF SHAFT OR SLEEVE ON WHICH SEAL IS INSTALLED MUST BE MACHINED TO RA 63 FINISH OR BETTER.
  3. LUBRICATE SHAFT/SLEEVE & SEAL WEDGE TO ASSIST INSTALLATION OF SEAL WITH COMPATIBLE LUBRICANT.
  4. LUBRICATE MATING RING (SEAT), SEALING MEMBER AND HOUSING TO ASSIST INSTALLATION. SUITABLE
  5. LIQUID MUST BE CIRCULATED AROUND PRIMARY RING (SEAL FACE)/THROUGH MATING RING (SEAT) (AT NOT LESS THAN ) IN ORDER TO REMOVE HEAT GENERATED, OR FAILURE MAY OCCUR.
  6. WHEN SHAFT IS SLEEVED THROUGH STUFFING BOX, SLEEVE MUST BE LIQUID TIGHT THROUGH BORE.
  7. SHAFT OR SLEEVE MUST BE CORROSION RESISTANT MATERIAL WITH A HARDNESS OF 125 BRINELL MINIMUM & BE MACHINED TO DIMENSIONS & TOLERANCES STATED.
  8. END OF SEAL CHAMBER & AXIS OF SHAFT MUST BE AT 90° TO EACH OTHER WITHIN F.I.M. .002
  9. BEFORE COMPLETING SEAL INSTALLATION WIPE LAPPED SURFACES OF MATING RING (SEAT) & PRIMARY RING (SEAL FACE) PERFECTLY CLEAN.
  10. ALL SHOULDERS OVER WHICH SEAL MUST PASS WHEN FITTING, TO BE PREPARED AS DIAGRAM BELOW.

THIS CONFIDENTIAL DESIGN IS OWNED BY JOHN CRANE AND MAY NOT BE USED EXCEPT IN CONFIDENCE AND FOR THE BENEFIT OF JOHN CRANE. ALL RIGHTS ARE RESERVED.  
THIS MEDIUM ( PRINT, MAGNETIC TAPE ETC.) IS SUBJECT TO RETURN ON DEMAND ALONG WITH ALL COPIES AND ALL IMPROVEMENTS, DESIGNS AND PROPERTY DERIVED THEREFROM.