




SERIAL NUMBER(S):

P00060313

P00060314

PUMP DATA:		MOTOR DATA:		NOTES:
MODEL	SLM-AVO-3X1X1.5X6-09E03	MFG	TECO-	COUPLING: REXNORD OMEGA ES4R
SIZE	3 X 1.5 X 6		WESTINGHOUSE	
SUCT. FLG.	3.0", 150# RF	HP	15	PT-100 TEMPERATURE PROBE
DISCH. FLG.	1.5", 150# RF	RPM	3500	PMP-25 POWER MONITOR
DRAIN CONN.	1/2", 150# RF	ENCL	TEFC	DOUBLE ISOLATION SHELL
		FRAME	254T	EQUIPPED WITH CDS SYSTEM
		PH/HZ	3/60	
		VOLTS	460	

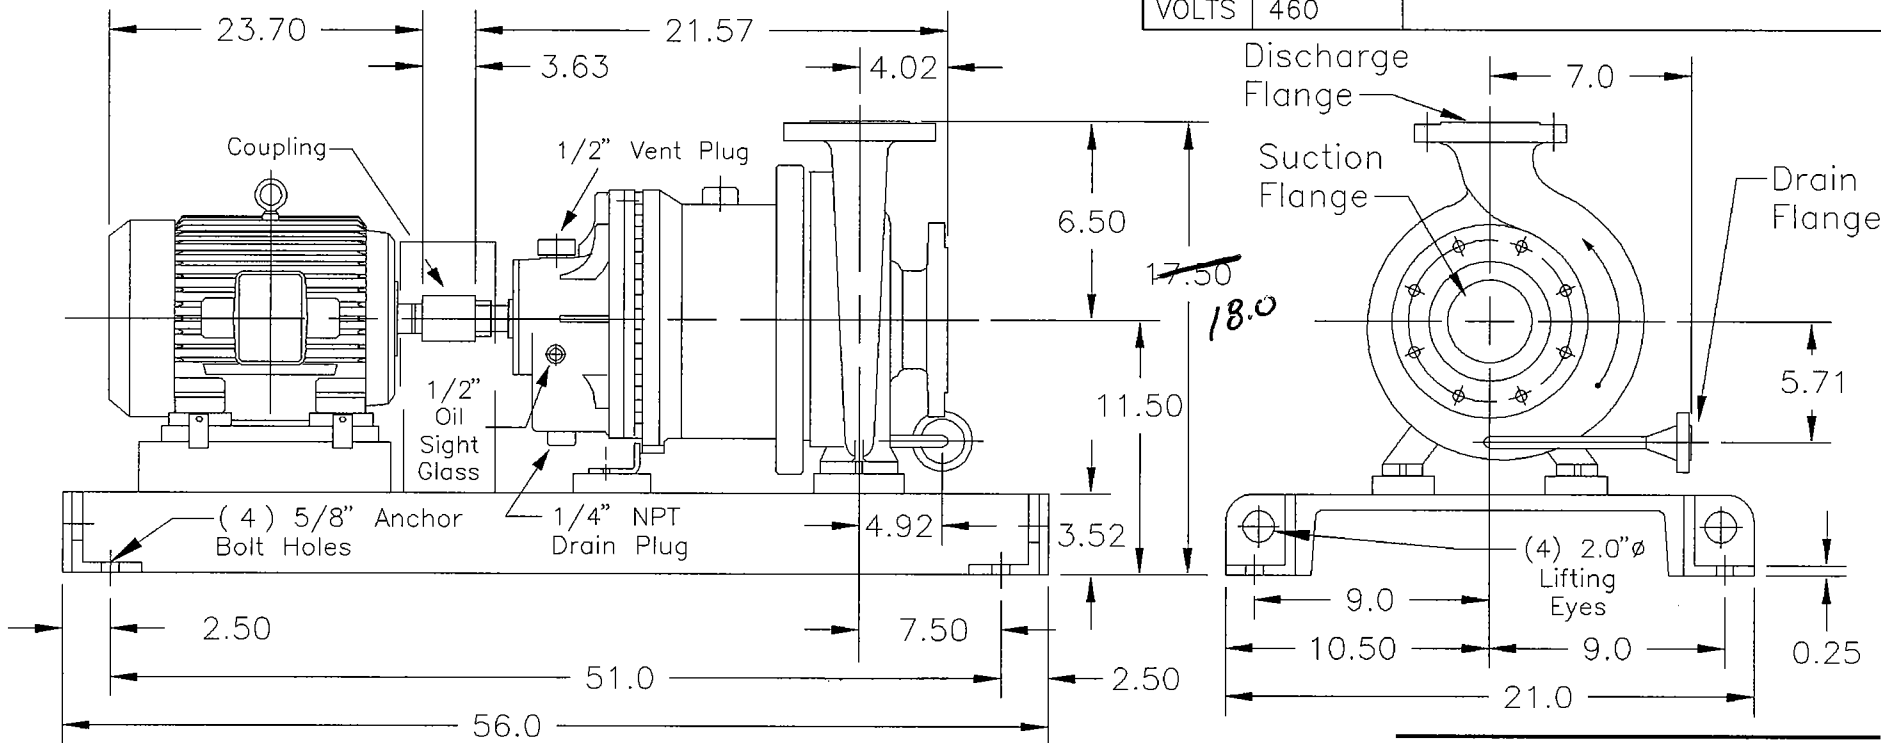

ALL DIMENSIONS ± 1/8" UNLESS OTHERWISE NOTED.

CERTIFIED CORRECT:

DATE: 3-20-06

BY:

QBT

REV.	DATE	COMMENTS

PUMP UNIT DRAWING

CUSTOMER	DEGUSSA CORPORATION
ENG. CONTR.	
PROJECT NO.	C0150.10002
P.O. NO.	4500164995
ITEM NO.	3036.00
KU JOB NO.	06-007
EST. WEIGHT	780 lbs
DWG.CODE NO:	
DRAWING NO.	06-007-3036.Dwg
DATE	18-MAR-2006