



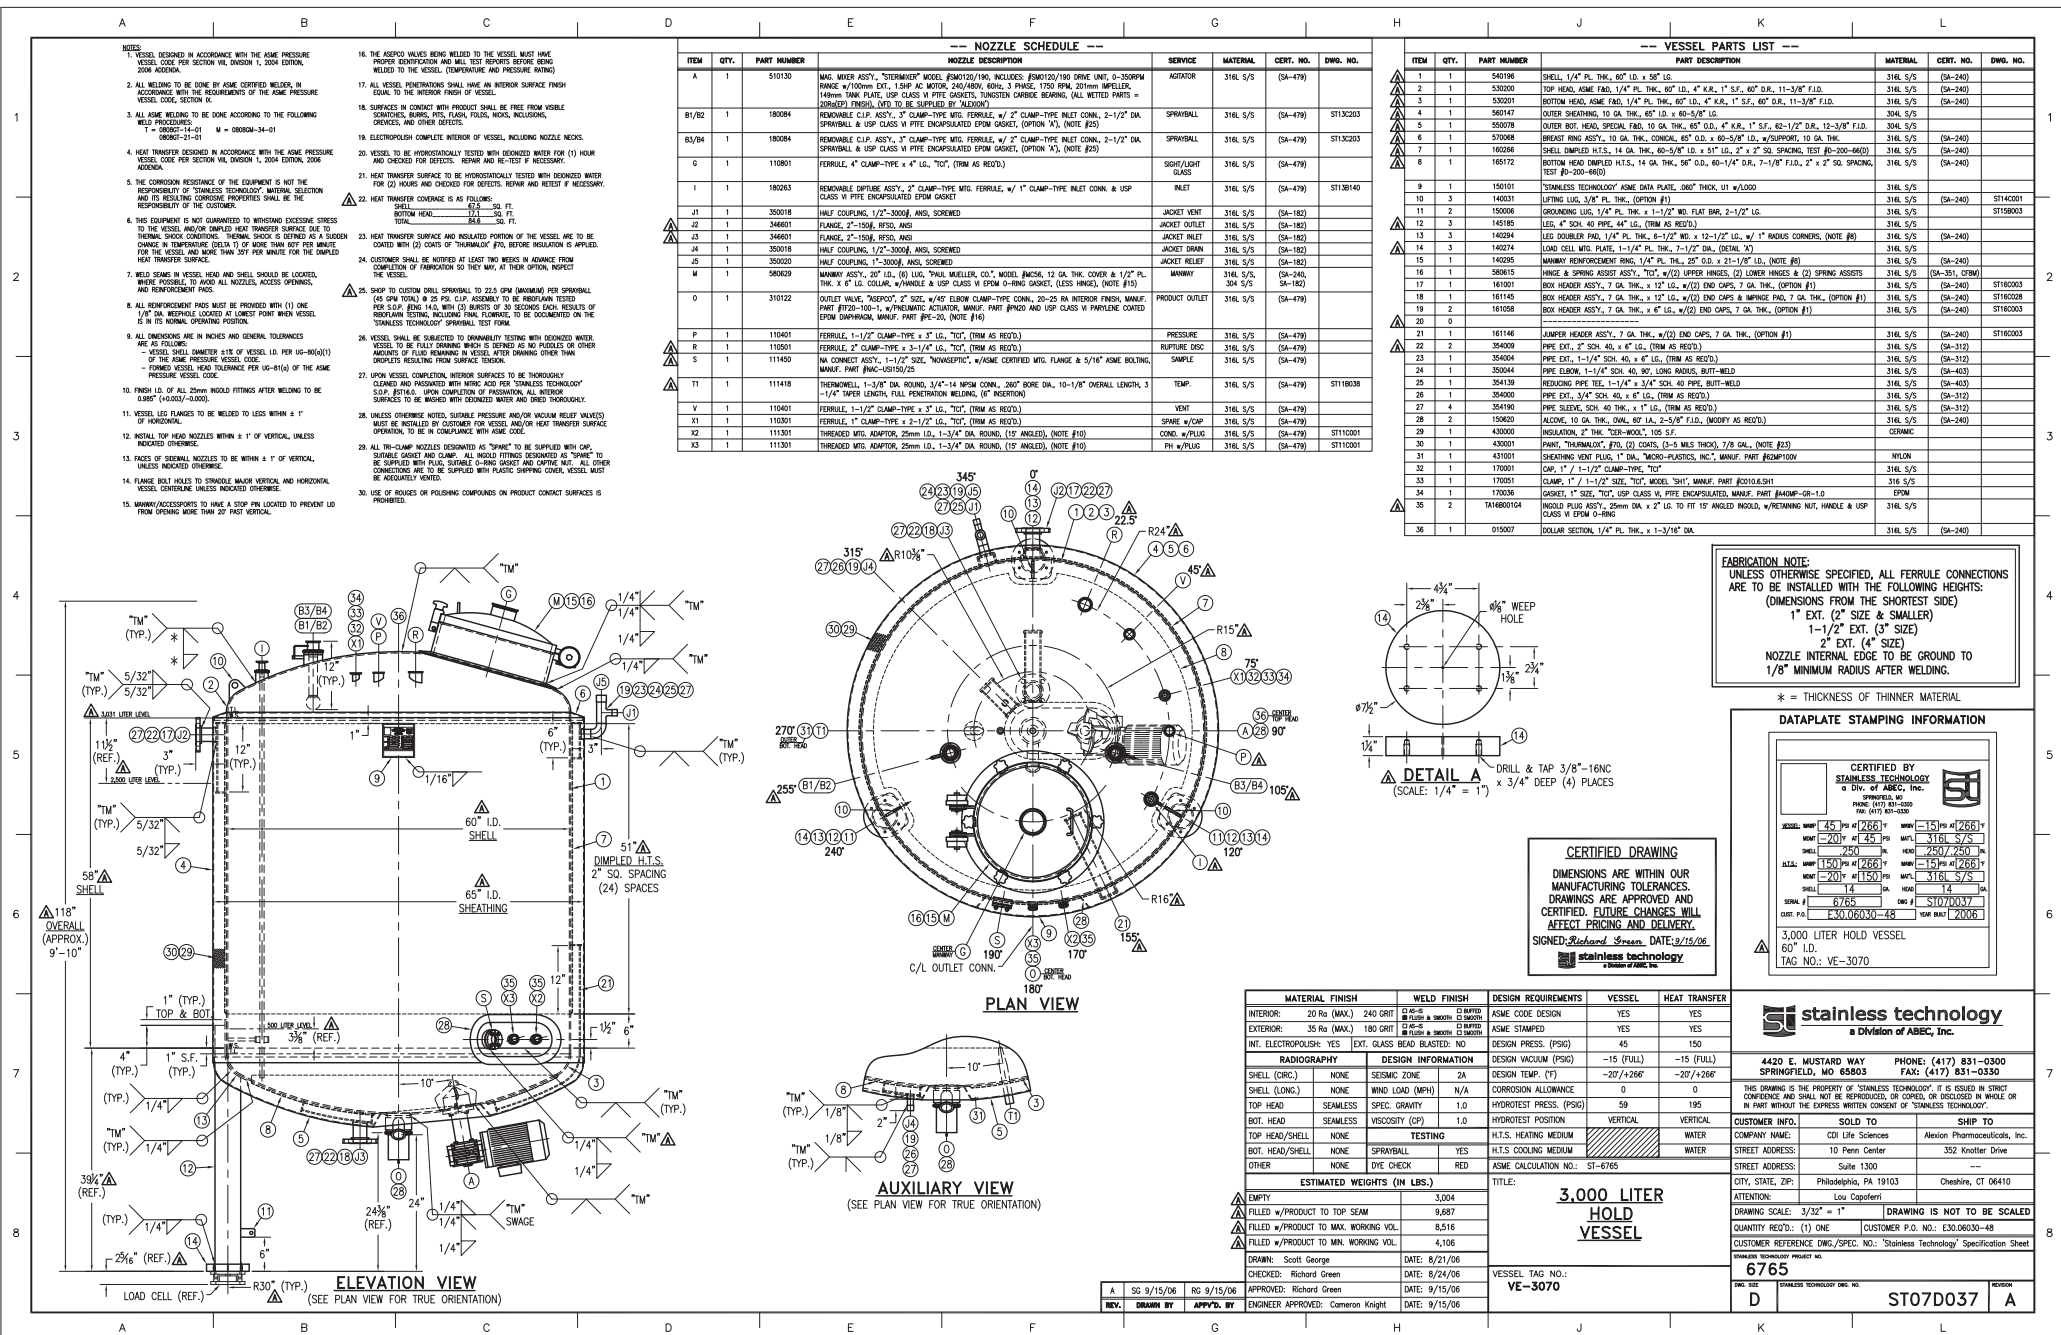

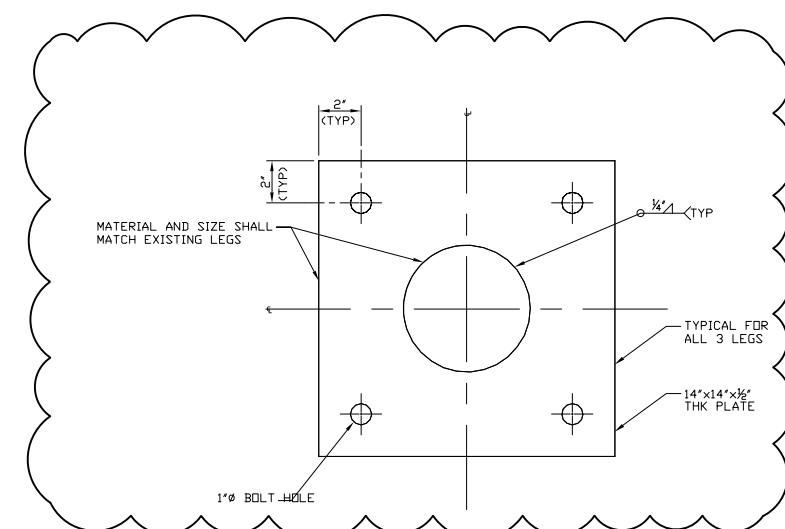

O	02/16/2021	ISSUED FOR CONSTRUCTION	CAL
A	02/17/2021	PRELIMINARY	CAL
SYNL	DATE	DESCRIPTION OF REVISION	NAME



Drew Marine.

400 CAPTAIN NEVILLE DRIVE
WATERBURY, CT 06705

DREW MARINE

EQUIPMENT GA

V-105 LEG MODIFICATION

CAD DRAWING NAME	DESIGNED	DRAWN	CHECKED	APPROVED
V-105 LEG DETAIL	NAME	CAL	---	---
	DATE	02/17/21	02/17/21	---

SCALE

NONE

JOB NO.

DRAWING NO.

V-105

ISSUE

A

SHEET NO.

1 of 1