

Certified *AS BUILT Drawing | Comm# 882239 | BN 2-24 | Cert drawing by: | Date: 6·3·22

verbindlich für Kommissions-Nr.:
binding for comission-no.: 882239


Copyright: This drawing is cur property and patented for us according to the law of copyright and associated rights !

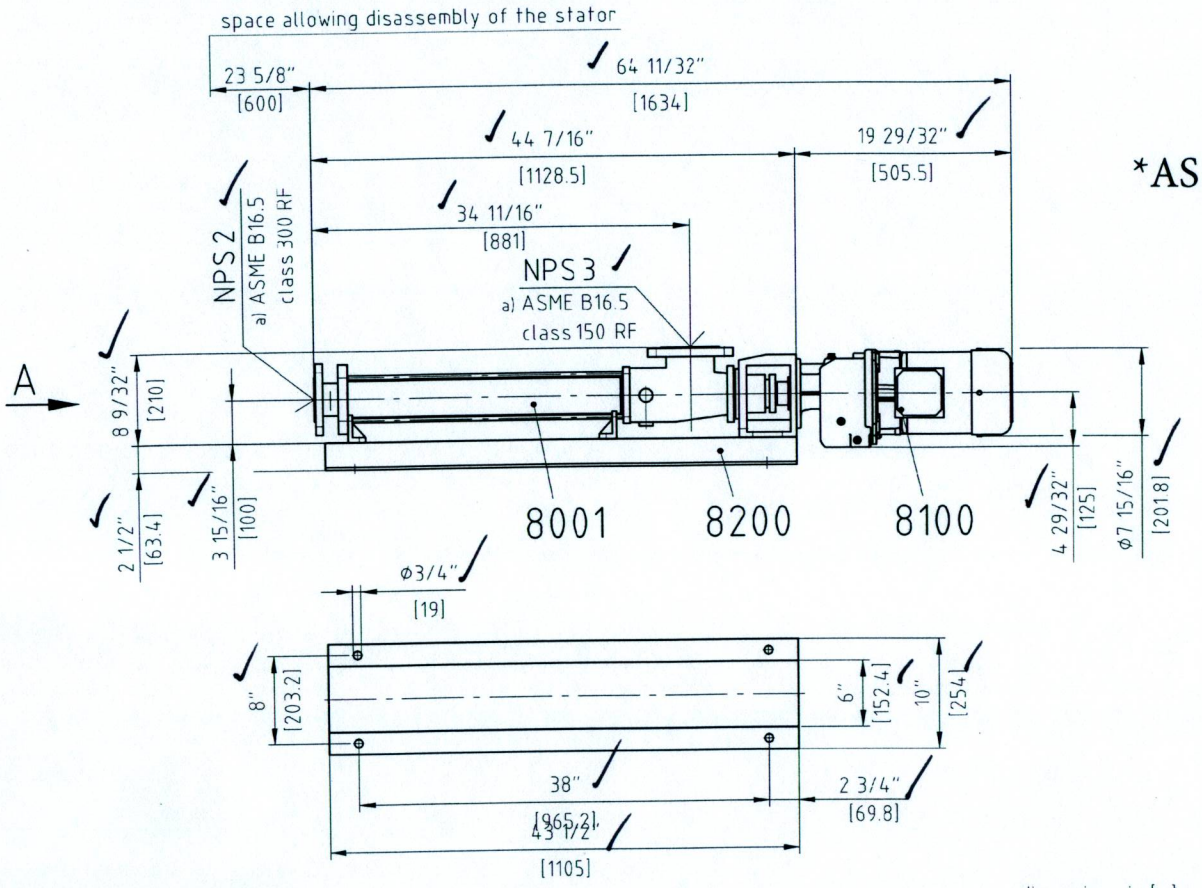


*AS BUILT

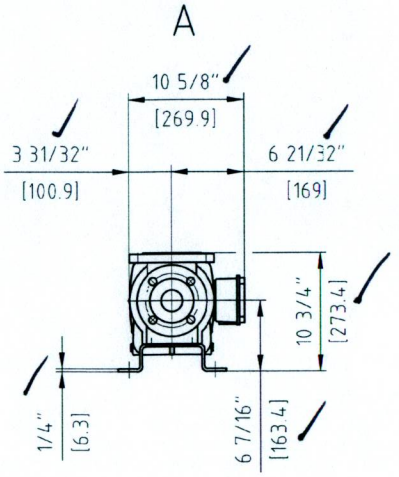


a) drilled acc. to

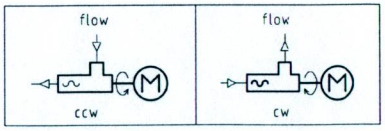


dimensions in [...] are in millimeter

| Quant. | Denomination | Item | Material | Note | Weight / kg |
|---|---|---|---|---|---|
| 1 | baseplate | 8200 | | Var.: 801-200/0020-D-100 | 19 |
| 1 | drive: Nord SK22F-100LP | 8100 | | | 47 |
| 1 | pump: BN 2-24 | 8001 | | | 39 |

| | | Name | Day | Scale | Weight | Denomination |
|---|---|---|---|---|---|---|
| 2021 | Drawn | msk | 15.07. | 1:15 | 105 kg | dimensional drawing |
| | Checked | lsh | 15.07. | EDP-No. 207441.dwg | | Drawing-no. 262-C18/0020-D-711A4 |

**SEEPEX.**
**ALL THINGS FLOW**

General tolerances for dimensions without specified tolerances acc. to DIN ISO 2768-v